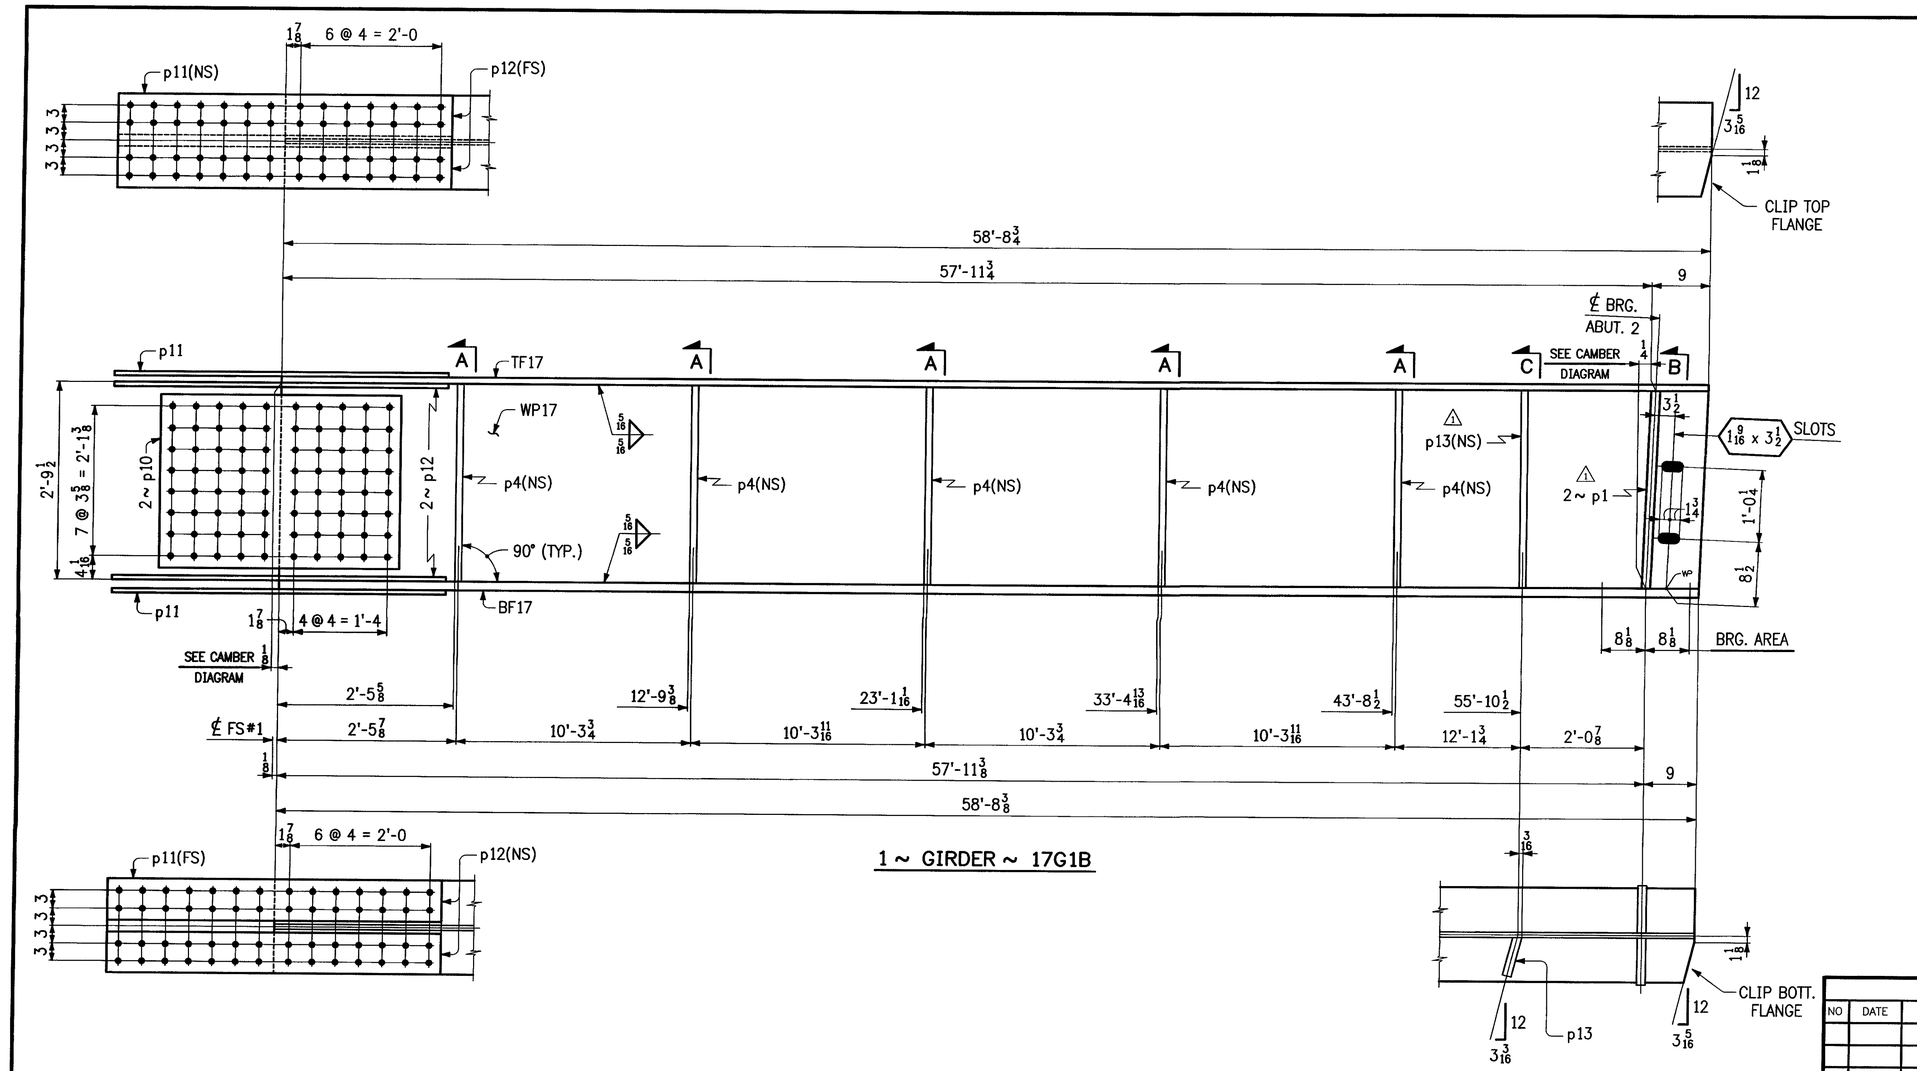

1 ~ GIRDER ~ 17G1B

BILL OF MATERIAL

SHIP MARK	QTY	PIECE MARK	DESCRIPTION	LENGTH FT	LENGTH IN	REMARKS	PAGE / LINE
17G1B	1		GIRDER				
	1	WP17	PL 5/8 x 33 1/2	58	8 3/4	(CVN)	1 / 2
	1	TF17	PL 1 x 16	58	8 3/4	(CVN)	1 / 7
	1	BF17	PL 1 1/2 x 16	58	8 3/8	(CVN)	1 / 11
	2	p10	PL 1/2 x 29 3/8	3	4	(CVN)	1 / 13
	2	p11	PL 1 1/2 x 16	4	8	(CVN)	1 / 14
	4	p12	PL 1 1/2 x 7	4	8	(CVN)	1 / 14
1	2	p1	PL 1 x 8	2	9 1/2	(CVN)	1 / 8
1	1	p13	PL 1/2 x 7	2	9 1/2	(CVN)	1 / 13
	5	p4	PL 1/2 x 7	2	9 1/2	(CVN)	1 / 13
	2		7/8ø MB	0	3	A307, W/NUT	4 / 2
	4		7/8ø MB	0	5 1/2	A307, W/NUT	4 / 3
	4		7/8ø MB	0	6	A307, W/NUT	4 / 4
	10		7/8ø WASHER			A307	4 / 5

RECEIVED
CK'D BY JEL OK'D BY KMH
JUL 22 2009
RESUBMIT ___ APPROVED ✓
BY KMH DATE 7/21/09

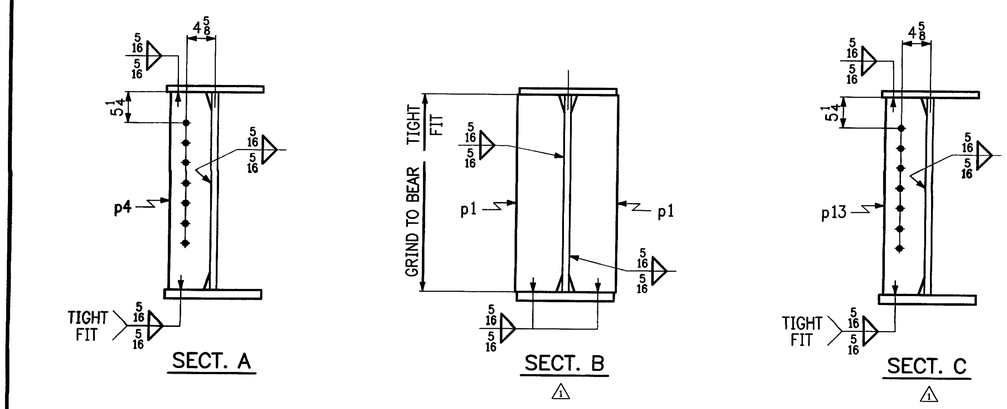

NOTES:

1. FOR GIRDER STANDARDS, SEE SHT. NO. 11.
2. FOR CAMBER DIAGRAM, SEE SHT. NO. 6.
2. FOR GENERAL NOTES, SEE SHT. NO. GN1.

REVISIONS			PRINT RECORD		
NO	DATE	DESCRIPTION	DATE	QTY	ISSUED
			7-16	5P	Appr.
1	7-14-09	ADDED BRG STIFFS & CONN PL'S @ ABUT, ADDED SECTS B & C,			

MEGQUIER & JONES INC.

STRUCTURAL STEEL SINCE 1895
1156 BROADWAY
SOUTH PORTLAND, MAINE 04106

PAINT: SSPC-SP10	HOLES U N 15/16ø	WELD U N	Q C. REVIEW
PROJECT: TH NO.1 OVER THE GIHON RIVER PROJECT NO. BHO 1448 (29) BRIDGE NO. 5 TOWN OF JOHNSON, VERMONT			DATE: 6-8-09 DRAWN BY: RLK
DESCRIPTION: GIRDER ~ 17G1B			CHK'D BY: GDC
ARCH: N/A	ENGR: VERMONT AGENCY OF TRANSPORTATION		JOB NO: J-81
CUSTOMER: S.D. IRELAND CONCRETE CONSTRUCTION CORP.			SHT NO: 17

998-9

G1B-998

Sheet 17 - Plotted 07/16/2009 @ 09:33 (HSUNER)