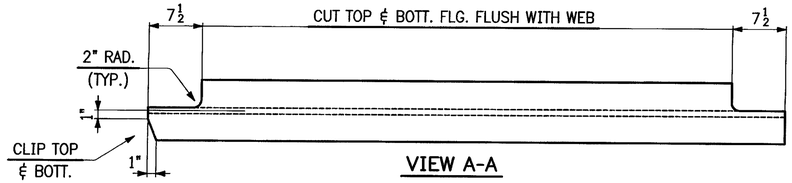

VIEW A-A

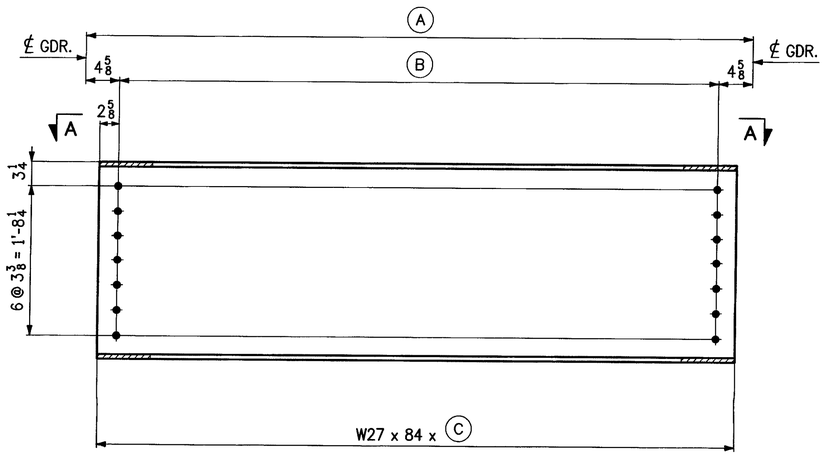

DIAPHRAGM MARK	QUANTITY	A	B	C
D4	1	7'-10 1/16	7'-0 13/16	7'-6 1/16
D5	1	7'-9 15/16	7'-0 11/16	7'-5 15/16
D6	1	7'-9 3/4	7'-0 1/2	7'-5 3/4
D7	1	7'-9 5/8	7'-0 3/8	7'-5 5/8

BILL OF MATERIAL

SHIP MARK	QTY	PIECE MARK	DESCRIPTION	LENGTH FT	LENGTH IN	REMARKS	PAGE LINE
			DIAPHRAGMS				
D4	1		W27 x 84	7	6 1/16		3/12
D5	1		W27 x 84	7	5 15/16		3/12
D6	1		W27 x 84	7	5 3/4		3/12
D7	1		W27 x 84	7	5 5/8		3/12

RECEIVED
CK'D BY JCL OK'D BY KMH
JUL 23 20..
RESUBMIT ___ APPROVED ✓
BY KMH DATE 7/21/09

REVISIONS			PRINT RECORD		
NO	DATE	DESCRIPTION	DATE	QTY	ISSUED
			7-16	5p	Appr.

MEGQUIER & JONES INC.

STRUCTURAL STEEL SINCE 1895

1156 BROADWAY
SOUTH PORTLAND, MAINE 04106

PAINT	HOLES U N 15/16 ø	WELD U N	Q C REVIEW
PROJECT: TH NO.1 OVER THE GIHON RIVER PROJECT NO. BHO 1448 (29) BRIDGE NO. 5 TOWN OF JOHNSON, VERMONT			DATE 7-14-09 / DRAWN BY WCG
DESCRIPTION: DIAPHRAGMS			CHK'D BY GDC
ARCH N/A	ENGR VERMONT AGENCY OF TRANSPORTATION		JOB NO J-81
CUSTOMER S.D. IRELAND CONCRETE CONSTRUCTION CORP.			SHT NO 24

998-12

DPHS-998B

Sheet 24 - Plotted 07/16/2009 @ 09 34 (HEATHER)