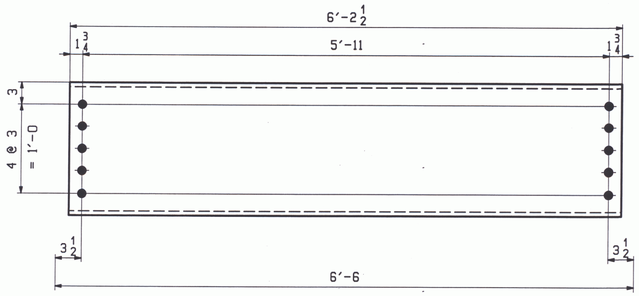

12 ~ DIAPHRAGMS - 3D1

ABM INFO		SHIP	BILL OF MATERIAL					JOB NO.	DRAWING NO.	REV.
								424	3	
PAGE	LINE	MARK	QTY	MARK	MATERIAL	LENGTH FT	LENGTH INCHES	REMARKS	WT	PROCUREMENT NOTES
					DIAPHRAGMS					
1	J	3D1	12		MC 18x42.7	6	2 1/2		265	
									~~12~~ 3x80	

RECEIVED
OK'D BY _____ OK'D BY MJM
SEP 23 2009
PROCUREMENT COMPLETE ✓
BY DATE 10/13/09

REV.	DATE	REMARKS	DWN	CHK	APVL	SHOP
0					SEP 21 2009	

MATERIAL:	SURFACE PREP. & PAINT:	HOLES:	SHOP BOLTS:
M270-50W	SEE DWG GN1	15/16" Ø	NONE

DESCRIPTION: DIAPHRAGMS

CASCO BAY STEEL STRUCTURES, INC.
75 SPRING HILL ROAD SACO, MAINE 04072
PHONE (207) 282-7360 FAX. (207) 282-1179
TENSOR 2012

STRUCTURE:	DRAWN:	DATE:
BRIDGE NO. 15 ON TOWN HIGHWAY NO. 3 (MINOR COLLECTOR) COUNTY OF RUTLAND	JTB	09/08
	CHKD: JCF	DATE: 09/16

LOCATION:	TOWN OF CLARENDON, VERMONT	JOB NO.	DWG NO.
PROJ NO.	BHO 1443 (39)	424	3
CUSTOMER:	VERMONT A.O.T.		REV. △

JTB Fri Sep 18 10:46:14 EDT 2009 /users/jobs/252/3 1.Rev0