THIS DOCUMENT MUST NOT BE COPIED OR MODIFIED WITHOUT PERMISSION OF JEFFORDS STEEL & ENGINEERING. VIOLATORS WILL BE PROSECUTED UNDER PENALTY OF LAW.CHARGES FOR CORRECTIVE WORK WILL NOT BE HONORED UNLESS PREVIOUS APPROVAL IS OBTAINED FROM JEFFORDS STEEL AND ENGINEERING COMPANY.

BILL OF MATERIAL

QTY	MARK	MATERIAL	LENGTH FEET	LENGTH INCHES	REMARKS	WGHT
ONE	12EPS	BR 1/4x8	2	0		13
ONE	AA12	∠2x2x1/4	2	6		
ONE	AB12	∠1 3/4x1 3/4x1/4	2	0		

A529/A572/A992 GR.50

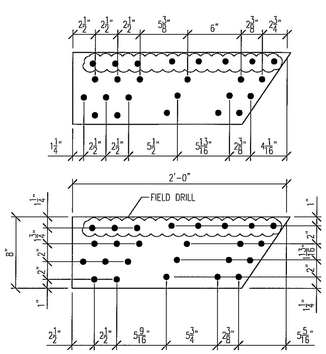

ONE~12EPS

MATCH EXISTING PIECE MRK'D "END POST"

SHOP NOTE:
-EASE ALL SHARP EDGES
-DRILL ALL HLS

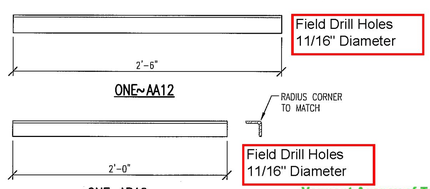

ONE~AA12

ONE~AB12

Vermont Agency of Transportation
RECEIVED
CK'D BY RJ OK'D BY KMH
10:47 am, May 05, 2010
RESUBMIT ____ APPROVED X
BY KMH DATE 5-5-2010

project: ALPINE CONSTRUCTION
10 BROAD ST
SCHUYLERVILLE, NY 12871
customer: TUNBRIDGE BRIDGE
3 BEST AVENUE
MECHANICVILLE, NY 12118

Jeffords
STEEL AND ENGINEERING COMPANY
P.O. BOX 40-4398 ROUTE #22
PLATTSBURGH,N.Y 12901
518-561-4061

JOB NO: 4022-1000
DATE: 3-11-10
DRAWN BY: ARH
CHECKED BY: MCB

12

HOLES: 11/16ø U.N.O.
SURFACE PREP: N/A
PAINT: N/A
ELECTRODES: E70XX (LOW HYDROGEN)
STD COPE: 1/2" min.

revision			print record		
#	date	description			
1	3-26	ADDED DIMS	2	SHOP	3-19
			2	SHOP	3-26

Z:\Eng09\Proj. 09\Alpine Const\4022 Tunbridge\CAD Dwg\InHouse\-1000 HESC ANGLES 3-5-10.dwg, 4/28/2010 10:58:49 PM, Kyocera KM-8030 KX