THIS DOCUMENT MUST NOT BE COPIED OR MODIFIED WITHOUT PERMISSION OF JEFFORDS STEEL & ENGINEERING. VIOLATORS WILL BE PROSECUTED UNDER PENALTY OF LAW.CHANGES FOR CORRECTIVE WORK WILL NOT BE HONORED UNLESS PREVIOUS APPROVAL IS OBTAINED FROM JEFFORDS STEEL AND ENGINEERING COMPANY.

BILL OF MATERIAL

QTY	MARK	MATERIAL	LENGTH FEET	LENGTH INCHES	REMARKS	WGHT
6	13SP	BR 1/4x6	1	6 5/8		45

A529/A572/A992 GR.50

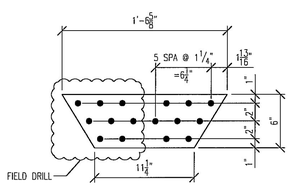

6~13SP

SHOP NOTE:
-EASE ALL SHARP EDGES
-DRILL ALL HLS

Vermont Agency of Transportation
RECEIVED
CK'D BY RJ OK'D BY KMH
10:47 am, May 05, 2010
RESUBMIT X APPROVED
BY KMH DATE 5-5-2010

project: ALPINE CONSTRUCTION
10 BROAD ST
SCHUYLERVILLE, NY 12871
customer: TUNBRIDGE BRIDGE
3 BEST AVENUE
MECHANICVILLE, NY 12118

Jeffords
STEEL AND ENGINEERING COMPANY
P.O. BOX 46-4395 ROUTE #22
PLATTSBURGH,N Y 12901
518-561-4061

JOB NO: 4022-1000
DATE: 3-11-10
DRAWN BY: ARH
CHECKED BY: MCB

13

HOLES: 11/16ø
SURFACE PREP: N/A
PAINT: N/A
ELECTRODES: E70XX (LOW HYDROGEN)
STD COPE: 1/2" min.

revision #	date	description	print record		
1	3-26	ADDED DIMS	2	SHOP	3-19
			2	SHOP	3-26