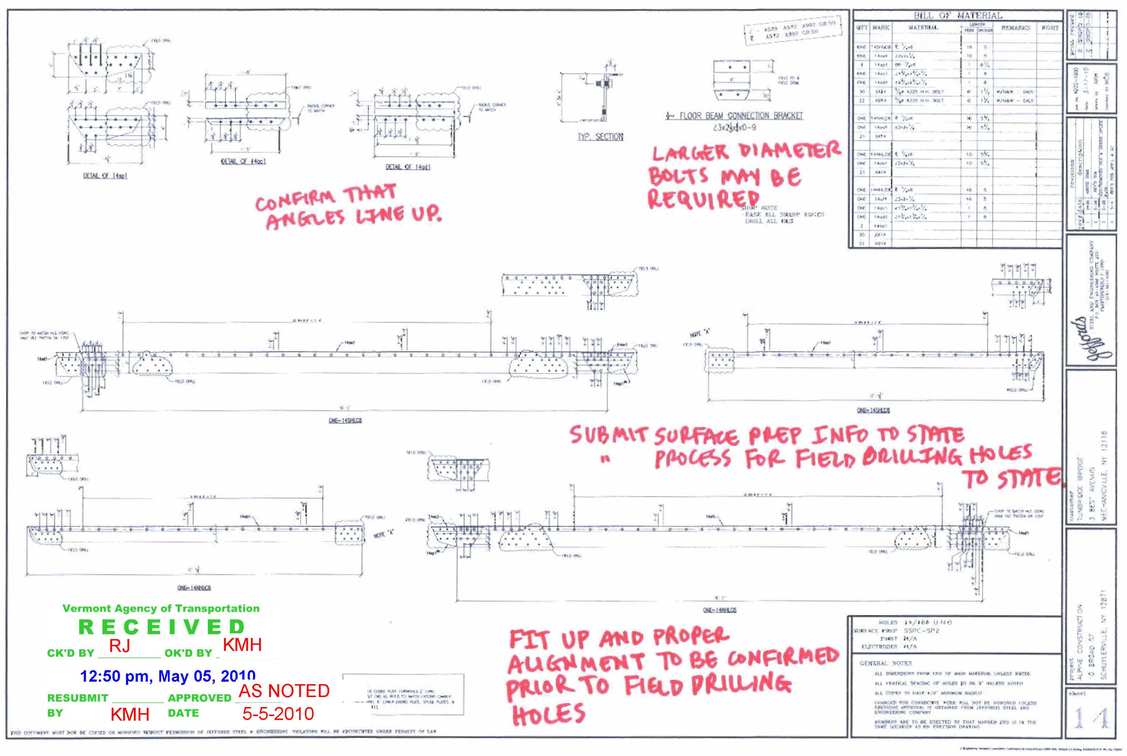

Vermont Agency of Transportation

RECEIVED

CK'D BY RJ OK'D BY KMH

12:50 pm, May 05, 2010

RESUBMIT _____ APPROVED AS NOTED

BY KMH DATE 5-5-2010