NOTES:

1. ALL HOLES ARE 15/16" DIA.
2. MATERIALS: M270Gr50W
3. FASTENERS: 7/8" A325 TYPE 3
4. PAINT: NONE.
5. DIMENSION ARE IN FEET & INCHES.
6. GENERAL NOTES: SEE DRAWING GN1

BILL OF MATERIAL

REV. NO:	SHIP MARK	PIECE MARK	QTY.	TYPE OF MATERIAL	SIZE OF MATERIAL	GRADE	LENGTH	FINISH	NOTES	WEIGHT

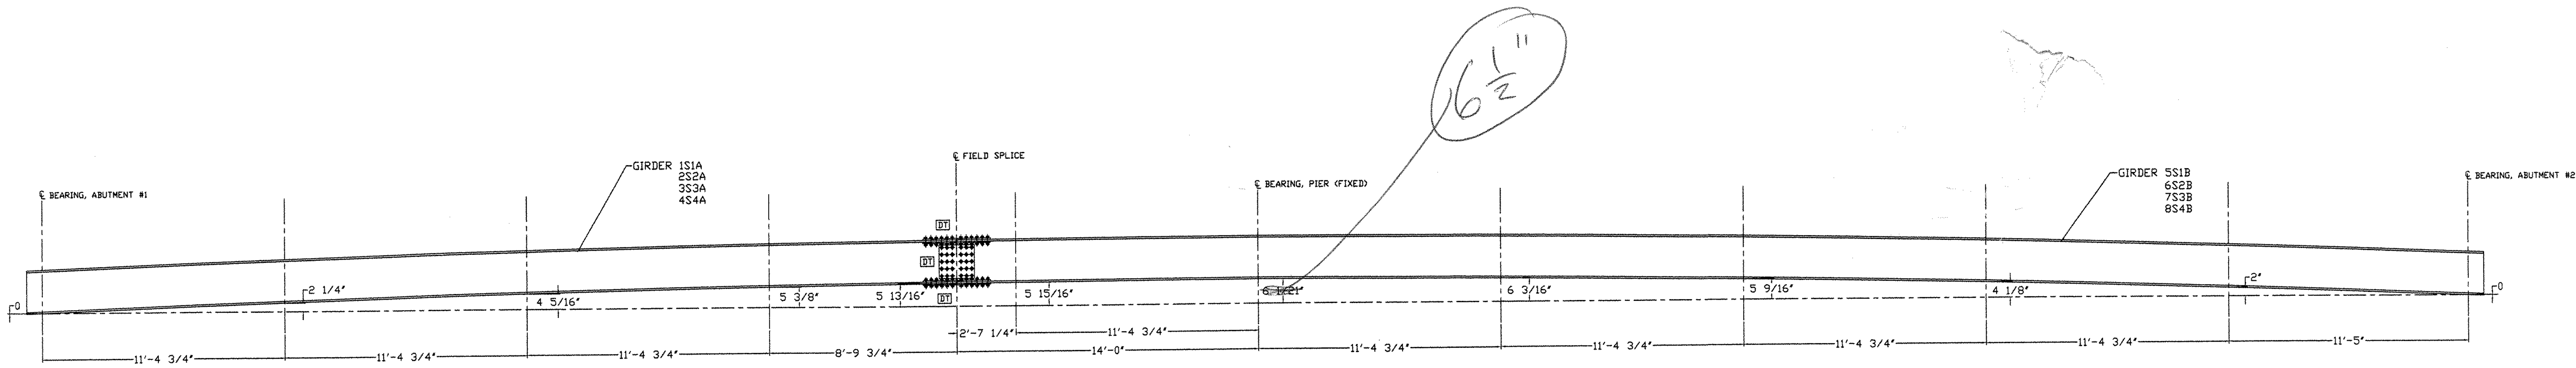

ELEVATION DIMENSIONS ARE AT ORDINATE SHOWN

AS CORRECTED ✓
REVISE AND RESUBMIT
UNACCEPTABLE
...cking is only for conformance with the design concept of the ...ject and compliance with the information given in the Contract ...uments. The Engineer assumes no liability for errors or ...issions that may be contained herein. The Contractor, by ...nting and submitting these documents, verifies their ...uracy as stipulated on the Contractor's Shop Drawing Stamp.
...BBS AND KING
7/22/04 BCA

ITEM NO: 506.50

REVISIONS		
NO.	DATE	DESCRIPTION
	7/14/04	FOR APPROVAL

FRANK W. WHITCOMB CONSTRUCTION CORP.
CONTRACT: BHO 1442 (32) VT ADT

CHURCH STREET (TH 5) OVER WILLIAMS RIVER
BRIDGE NO. 11
CHESTER, VT

TITLE:
BLOCKING DIAGRAM

DRAWN BY 7/8/04 DANA BACON	SHOP ORDER 5025	DWG. NO. 10
CKD BY JH 7/15/04	BLOCK NO.	SHEET NO. 1 OF 1

FABRICATOR
EASTERN BRIDGE LLC
RURAL RTE 2, BOX 302
CLAREMONT, NH 03743
603-542-5202

03855