ABM INFO		SHOP BILL							JOB NO. 361	DRG. NO. 54
PAGE	LINE	NO.	DESCRIPTION	FT	IN	ASSEM. MARK	SHIPPING MARK	REMARKS	WEIGHT	
		1	W8x10	16	6 3/8		SS11			
		1	Do	16	6 3/8		SS12			
		1	Do	16	6 3/8		SS13			
		1	Do	16	6 3/8		SS14			
		1	W8x10	16	8 7/8		SS81			
		1	Do	16	8 7/8		SS82			
		1	Do	16	8 7/8		SS83			
		1	Do	16	8 7/8		SS84			
		1	W8x10	15	7 1/4		SS21			
							SS22			
							SS23			
							SS24			
							SS31			
							SS32			
							SS33			
							SS34			
							SS41			
							SS42			
							SS43			
							SS44			
							SS51			
							SS52			
							SS53			
							SS54			
							SS61			
							SS62			
							SS63			
							SS64			
							SS71			
							SS72			
							SS73			
		1	W8x10	15	7 1/4		SS74			
		16	L 7x4x3/8		3		SK1			
		144	3/4" ø A325-TC-Bolts		1 3/4			FIELD *NEW. GALV.		
			264 1/2" Shear Conn.		1 3/4	Shop				
			PAY ITEM 506.50							

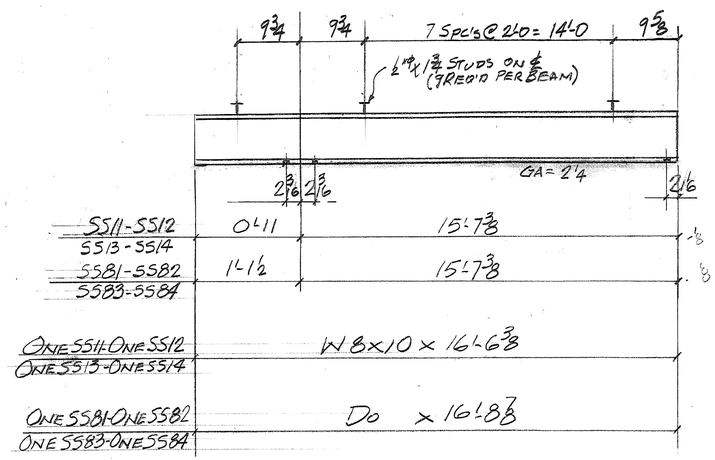

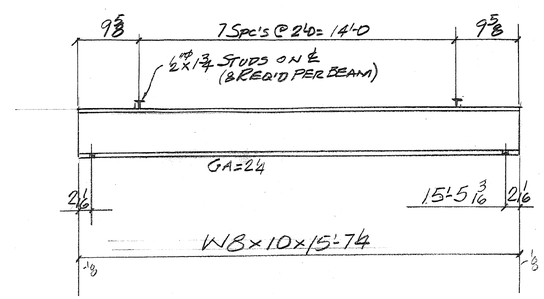

SIDEWALK STRINGERS - SS21 - SS22 - SS23 - SS24
SS31 - SS32 - SS33 - SS34
SS41 - SS42 - SS43 - SS44
SS51 - SS52 - SS53 - SS54
SS61 - SS62 - SS63 - SS64
SS71 - SS72 - SS73 - SS74

SHOP DRAWINGS ARE REVIEWED UNLESS NOTED OTHERWISE
NO EXCEPTION TAKEN ✓
REVISE AS NOTED
RESUBMISSION NOT REQ'D
REVISE AS NOTED
RESUBMISSION REQ'D
REJECTED
Stamp
DATE 4/23/08
SIGNATURE Michael Clendt
REVIEW BY S... OF ASCERTAINING DESIGN CONTRACT DIMENSIONS, FABRICATION METHODS, COORDINATION OF SUB-TRADES, DETAIL DESIGN OF COMPONENTS AND ERRORS OR OMISSIONS ON SHOP DRAWINGS. PURPOSE ... WITH ... RESPONSIBLE FOR CONSTRUCTION

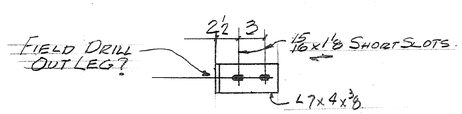

SK1 - 16 - Req'd

G.C. TO VERIFY ALL HOLE LOCATIONS

Per Blow & Cote, Inc., all circled dimensions have been verified and they have released to fabricate using these dimensions. If all verification of existing holes for W27 and existing plates and angles can be verified prior to fabrication Casco Bay Steel Structures will shop drill. If not, Blow & Cote will field drill these holes.

REV.	REMARKS	DATE	DWN	CHK	APP	Q.A.	NO.	DIA.	LGT	TYPE	WASHER
	OUT FOR APPROVAL	3/19/08									
	OUT FOR APPROVAL	5/17/08									
	ISSUED TO SHOP										
	FIELD & OFFICE										
1	Added Studs	4-15-08	JPF								

PROJECT NO. BHF-0302(3)S STATE PROJECT NO.

MATERIAL: AASHTO M270-Gr50 ELECTRODES: — HOLES: 13/16" U.N. SHOP BOLTS: —

SURFACE PREP. & PAINT:

Sherwin Williams - Corothane I Galvapac
One Pack Zinc Primer 3.5 to 4 mils DFT

DESCRIPTION: Sidewalk Stringers

JOB: Improvements Bridge No. 41 on TH No. 2 Richford, VT.

CUSTOMER: Blow & Cote Inc.

	DRAWN BY	DATE
	JPF	3-08
	CHKD BY	
	APPROV BY	
	Q.A.	
	JOB NO. 361	DRG. NO. 54
	REV. △	

CASCO BAY STEEL STRUCTURES, INC.
75 SPRING HILL ROAD SACO, MAINE 04072
PHONE (207) 282-7360 FAX. (207) 282-1179

1" = 1'-0