STATE OF VERMONT
AGENCY OF TRANSPORTATION

PROPOSED IMPROVEMENT
TOWN OF WATERBURY
COUNTY OF WASHINGTON
COMMUTER PARK-AND-RIDE LOT

THIS PROJECT IS LOCATED ON THE NORTH SIDE OF LINCOLN STREET IN THE TOWN OF WATERBURY, PAST PERRY HILL ROAD ON THE LEFT.

WORK TO BE PERFORMED UNDER THIS PROJECT INCLUDES RECONSTRUCTION OF THE EXISTING PARK-AND-RIDE LOT, STABALIZING OF EASTERN SLOPE WITH STONE FILL, A BUS SHELTER, PAVEMENT MARKINGS, LIGHTING AND OTHER APPURTENANCES.

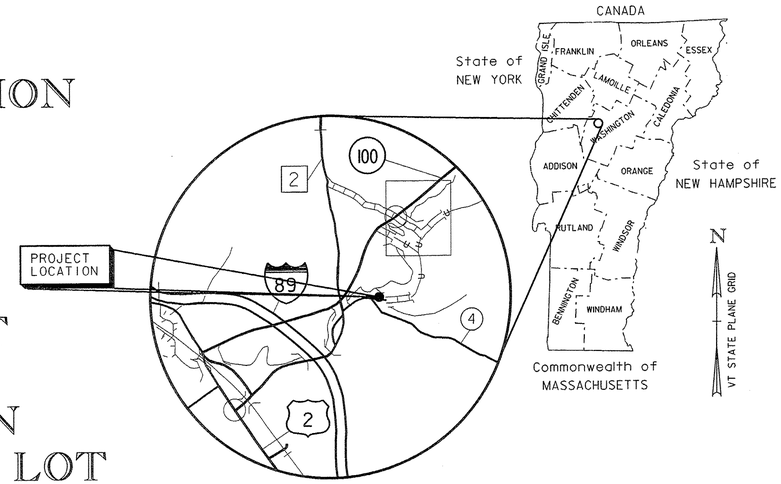

LOCATION MAP
1"=2000' @ FULL SIZE
(APPROXIMATE)

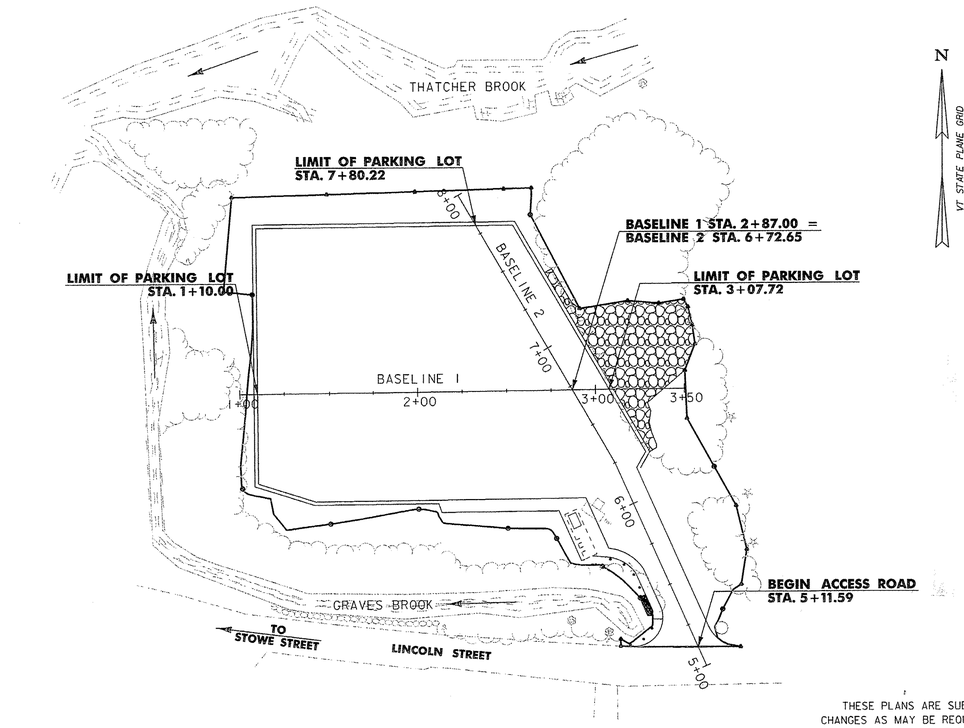

INDEX OF SHEETS

1	TITLE SHEET
2	TYPICAL SECTION
3-4	QUANTITY SHEETS
5	EARTHWORKS SHEET
6	SURVEY TIES
7	LAYOUT PLAN AND GENERAL NOTES
8-9	BASELINE PROFILES
10	CONSTRUCTION APPROACH SIGNING
11	SIGNING & PAVEMENT MARKING PLAN
12	SIDE ROAD SIGNING
13	SIGN DETAILS
14-15	TRAFFIC SIGN SUMMARY SHEETS
16	LIGHTING, LANDSCAPING & UTILITY PLAN
17-19	LIGHTING DETAILS
20	LANDSCAPING DETAILS
21	MISCELLANEOUS DETAILS
22-23	BUS SHELTER DETAILS
24	EPSC EXISTING CONDITIONS SITE PLAN
25	EPSC CONSTRUCTION SITE PLAN
26	EPSC FINAL CONDITIONS SITE PLAN
27-29	EPSC DETAILS
30-32	BASELINE CROSS SECTIONS

INDEX OF STANDARDS

B-5	06-01-94
D-20	03-03-03
E-100	01-02-04
E-101	05-30-03
E-102	06-30-03
E-106	03-01-04
E-107	06-30-03
E-107A	06-08-09
E-110	08-08-95
E-121	08-08-95
E-132	08-18-95
E-143	06-15-04
E-144	03-29-99
E-164	06-08-09
E-173	08-09-95
E-175	06-08-09
E-180A	08-09-95
E-180B	08-09-95
E-191	02-01-99
E-192	10-12-00
E-193	08-18-95
G-4	06-01-94
J-2	06-01-94

CONVENTIONAL SYMBOLS

TOWN LINE
FENCE LINE
STONE WALL
TRAVELED WAY
GUARD RAIL
RAILROAD
SURVEY LINE
CULVERT
POWER POLE
TELEPHONE POLE
LIGHT POLE/LUMINAIRE
TREES
CONTROL OF ACCESS
PROPERTY LINE
R.O.W. TAKING LINE
TOP OF CUT
TOE OF SLOPE
CLEAR ZONE (CZ)
SILT FENCE
WETLANDS

SURVEYED BY : VERMONT SURVEY AND ENGINEERING, INC.
SURVEYED DATE : 3/02

DATUM
VERTICAL NAVD 88
HORIZONTAL NAD 83 (1996)

0 40 80
SCALE IN FEET

RECORD PLANS

CONTRACTOR: J. HUTCHINS, INC.- RICHMOND, VT
RESIDENT ENGINEER: TOM MANCINI
CONSTRUCTION BEGAN: MARCH 17, 2010
CONSTRUCTION COMPLETE: JULY 21, 2010
RECORD PLANS BY: TOM MANCINI & DARREN CONNOLLY

I HEREBY CERTIFY THAT ALL THE CONSTUCTION REQUIRED BY THIS SET OF DRAWINGS HAS BEEN ACCOMPLISHED AS INDICATED HEREIN.

BY _____ RESIDENT ENGINEER
DATE 2/25/12

NOTE: Any further information concerning final quantities, amounts or other details relative to this project may be found at Central Files in the electronic archives.

THESE PLANS ARE SUBJECT TO SUCH ENGINEERING CHANGES AS MAY BE REQUIRED BY THE FEDERAL HIGHWAY ADMINISTRATION OR THE DIRECTOR OF PROGRAM DEVELOPMENT.

CONSTRUCTION IS TO BE CARRIED ON IN ACCORDANCE WITH THESE PLANS AND THE STANDARD SPECIFICATIONS FOR CONSTRUCTION DATED 2006, AS APPROVED BY THE FEDERAL HIGHWAY ADMINISTRATION ON JUNE 15, 2006 FOR USE ON THIS PROJECT, INCLUDING ALL SUBSEQUENT REVISIONS AND SUCH REVISED SPECIFICATIONS AND SPECIAL PROVISIONS AS ARE INCORPORATED IN THESE PLANS.

DIRECTOR OF PROGRAM DEVELOPMENT
APPROVED _____ DATE 11-16-09

PROJECT MANAGER : WAYNE L. DAVIS

PROJECT NAME: WATERBURY
PROJECT NUMBER: CMG PARK(11)S RE-ADVERTISED

SHEET 1 OF 32 SHEETS