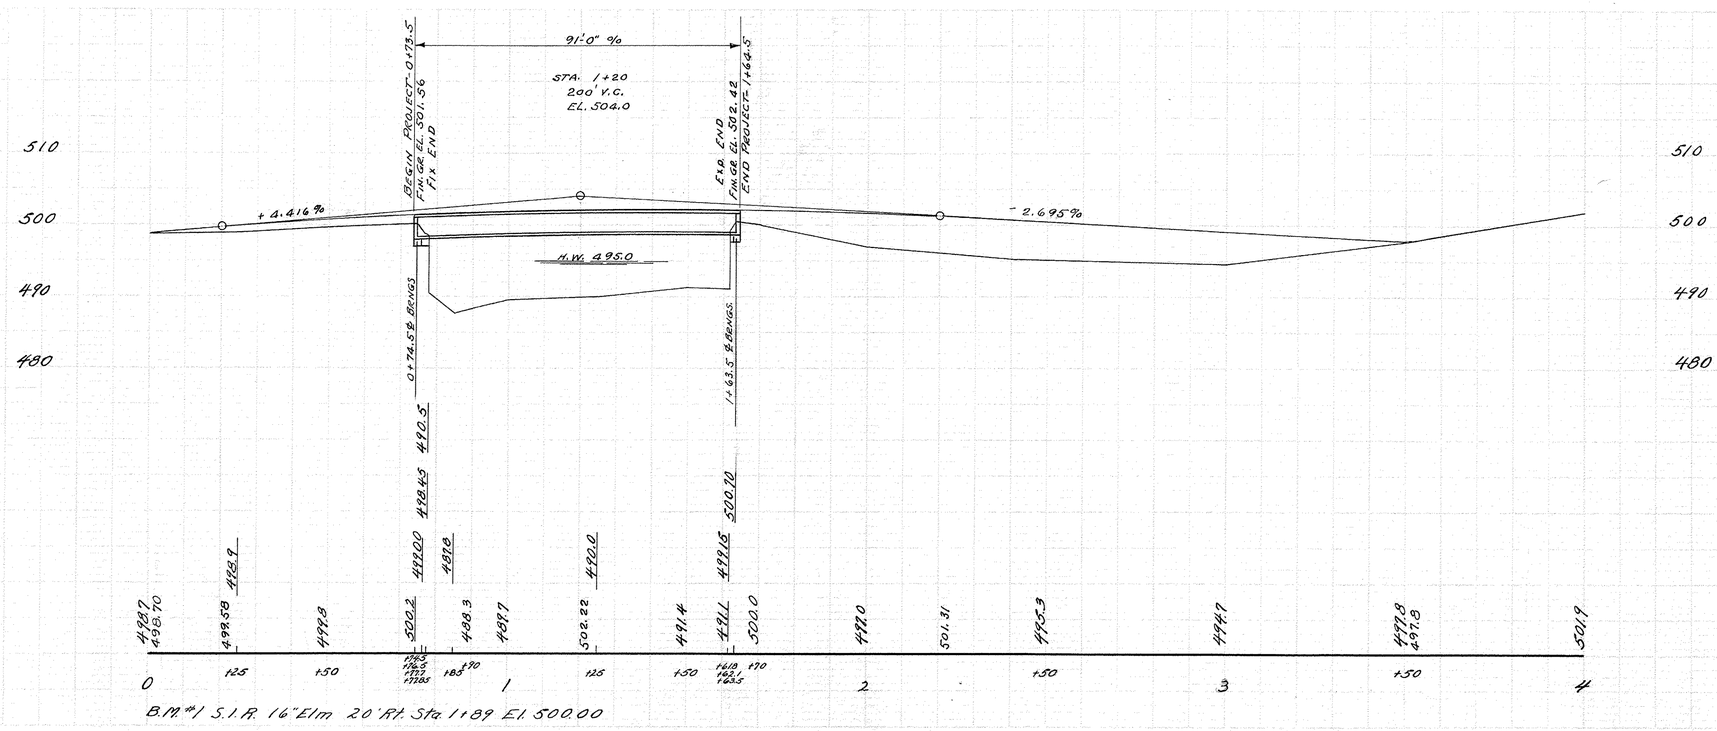

VENEER PLANT BRIDGE
HANCOCK, VT.

ST. FL. 5-C

SHEET 2 OF 6 SHEET