






60
51


60
5




1 3/4
4-12-04












S & WOOLENS
CLSX 5390
CLSX 5591



























2 3/4"
05-21-93
05-30-98
08-10-2000
6 3/4"
4-13 04




5-20-96
I 91 44N
#57 RT


57
5-20-96
I 91 44N
#57 RT

1 1/2"

4-13-04

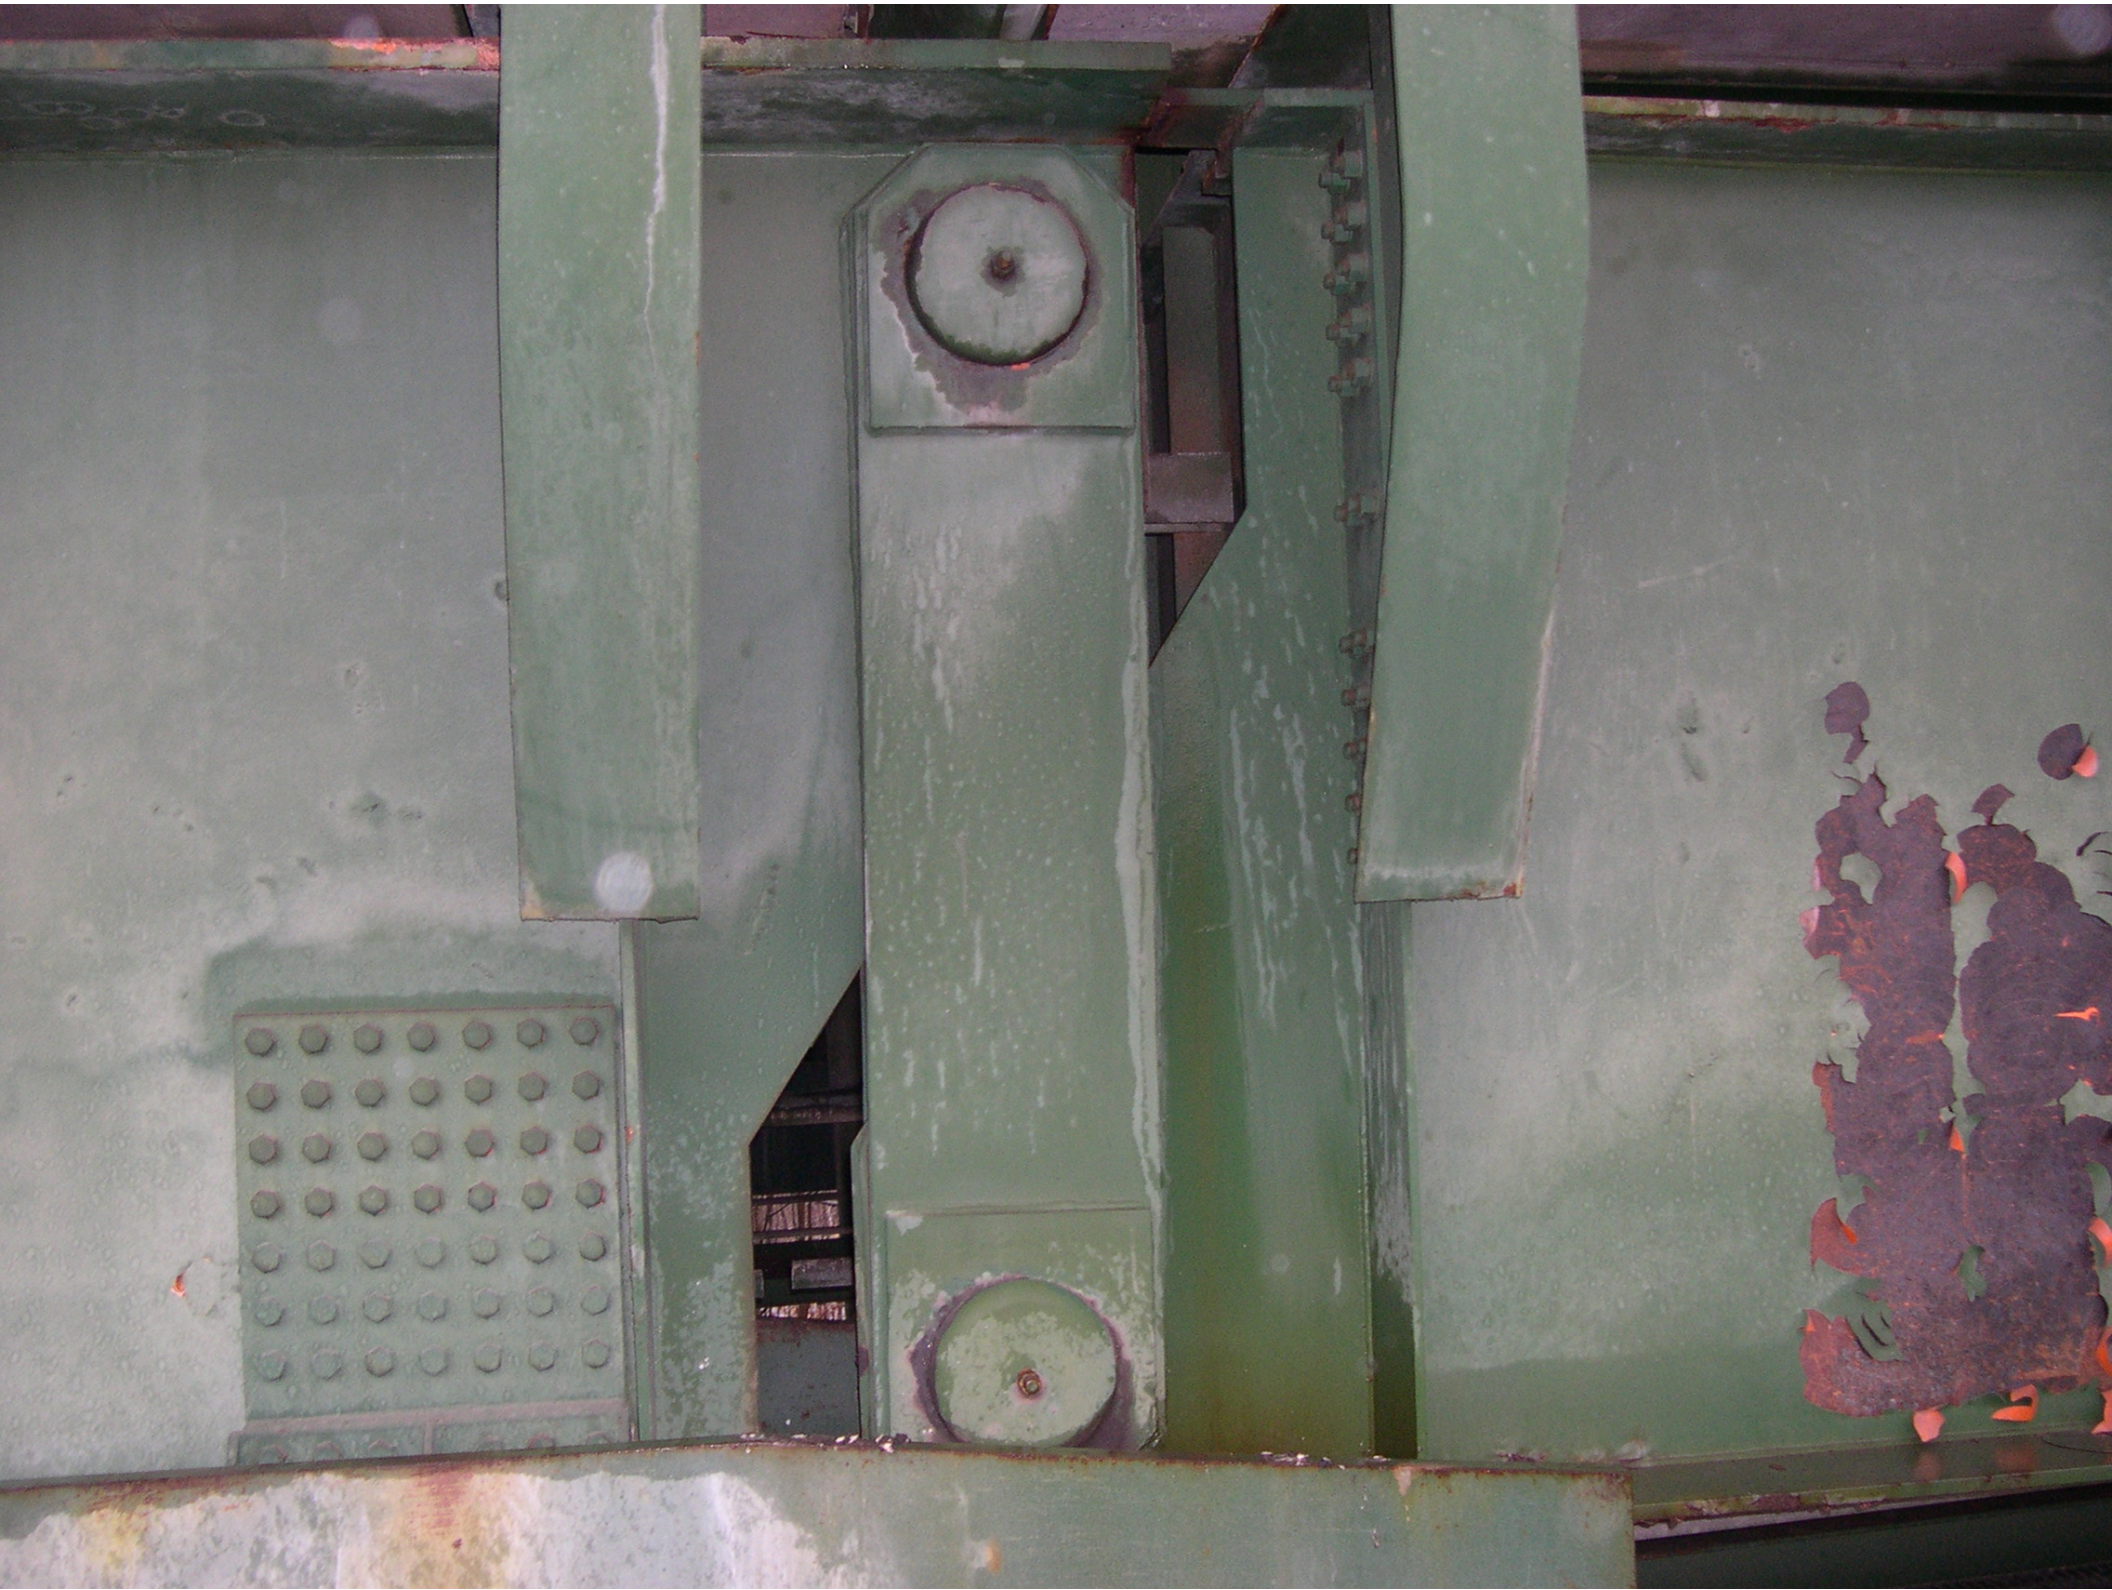








25,000 GIFTS & WOOLENS