


PARKING LOT

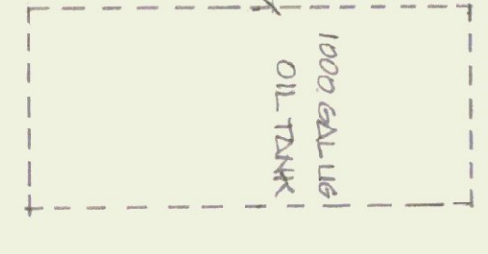

STATE OF VERMONT STATE BUILDINGS DIVISION DEPARTMENT OF ADMINISTRATION VERMONT		VERMONT	
BENNINGTON STATE AIRPORT		Hangar Building	
BENNINGTON	DESIGNED BY:	DWG. NO.	OF
DATE: 8-10-77	DRAWN BY: CGH	APPROVED BY:	