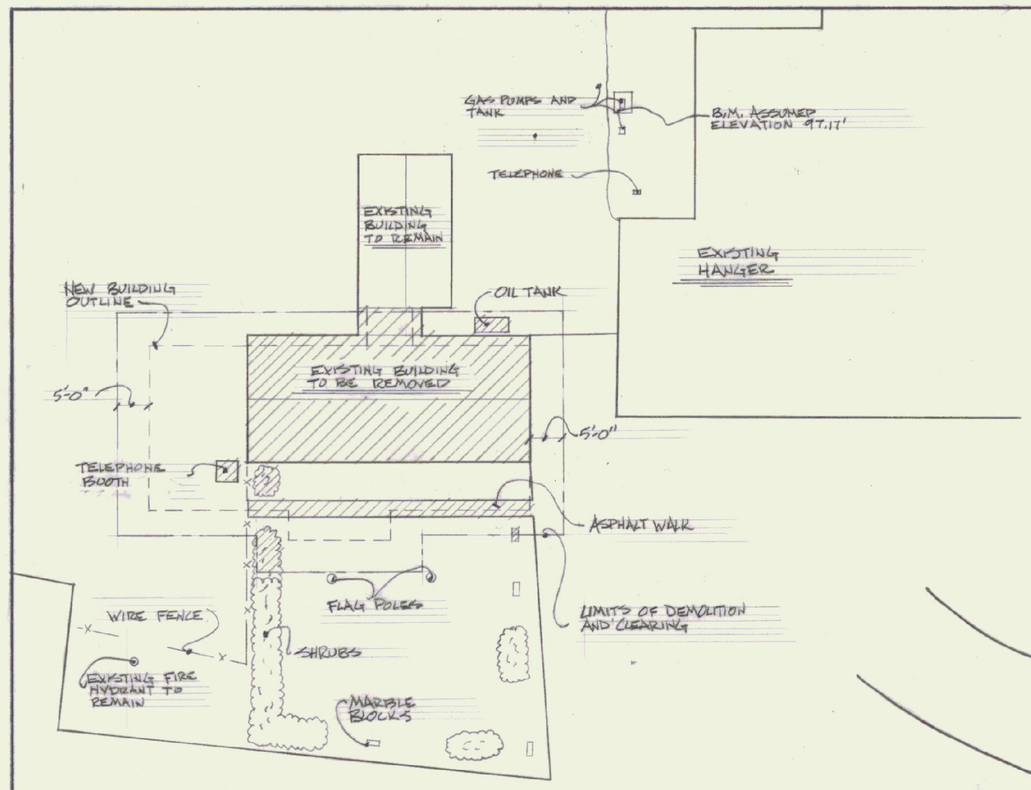

SITE PLAN AS EXISTING 1/16"=1'-0"

SCHEMATIC SITE PLAN 1/16"=1'-0"

NOTE: SITE DEVELOPMENT, LANDSCAPING AND FINISH GRADING ARE NOT IN CONTRACT. SEE SPECIFICATIONS FOR SCOPE OF SITE WORK.

LEGEND

- CONIFEROUS TREE
- ORNAMENTAL DECIDOUS TREE
- SHRUBS AND MULCH
- HEDGE
- POST AND BEAM FENCE
- PAVING
- GRASS
- WATER
- SANITARY
- ELECTRIC
- DEMOLITION & CLEARING
- ROUGH GRADING

REVISION DATE △ - "AS BUILTS"

NORTH (ASSUMED)

REGISTERED ARCHITECT CHARLES W. STORM No. 1131 STATE OF VERMONT

STATE OF VERMONT
DIVISION OF STATE BUILDINGS
AGENCY OF ADMINISTRATION
MONTPELIER, VERMONT

SITE PLANS
SPRINGFIELD STATE AIRPORT TERMINAL
SPRINGFIELD VERMONT

DATE:	SCALE:	REVISIONS:	DWG. NO.
AUG. 28 1981	1/16"=1'-0"	5/22/84 S. MULHERN	S-1
DRAWN BY: HANSON	APPROVED BY: C.W.S.		1 OF 9