


ENCROACHMENT - GARY RAPPANOTTI, U.S. OF SPRINGFIELD, VT
 FOUND NO CONVEYANCES TO THE STATE OF VERMONT IN
 THE SPRINGFIELD LAND RECORDS

PROJECT AIR 03-1044
 SHORTENED RUNWAY 11-28 TO 3000'

SPRINGFIELD
 WEATHERSFIELD

AIRCRAFT HAZARD BEACONS

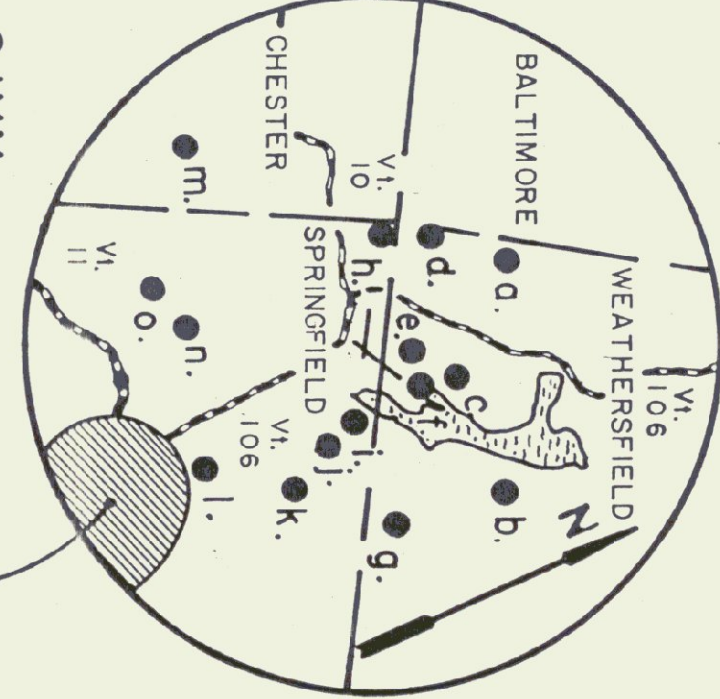

- a. ILL & IMM
 - b. ITT
 - c. IQQ, IRR, & ISS
 - d. IJJ & IKK
 - e. INN, IOO, & IPP
- This beacon is in the right-of-way of
 Springfield Town Highway No. 8
 IFF, IGG, IHH, & IBBB (no beacon of this location
 presently)
 IFF, IGG, IHH, & IBBB

REVISIONS	DATE
1	11/18/88
2	11/18/88
3	9-3-92

SPRINGFIELD STATE AIRPORT
 PROPERTY MAP
 DATE: 11/79
 DRAWN BY: SAS

914 21415