





SITE PLAN
1" = 20'

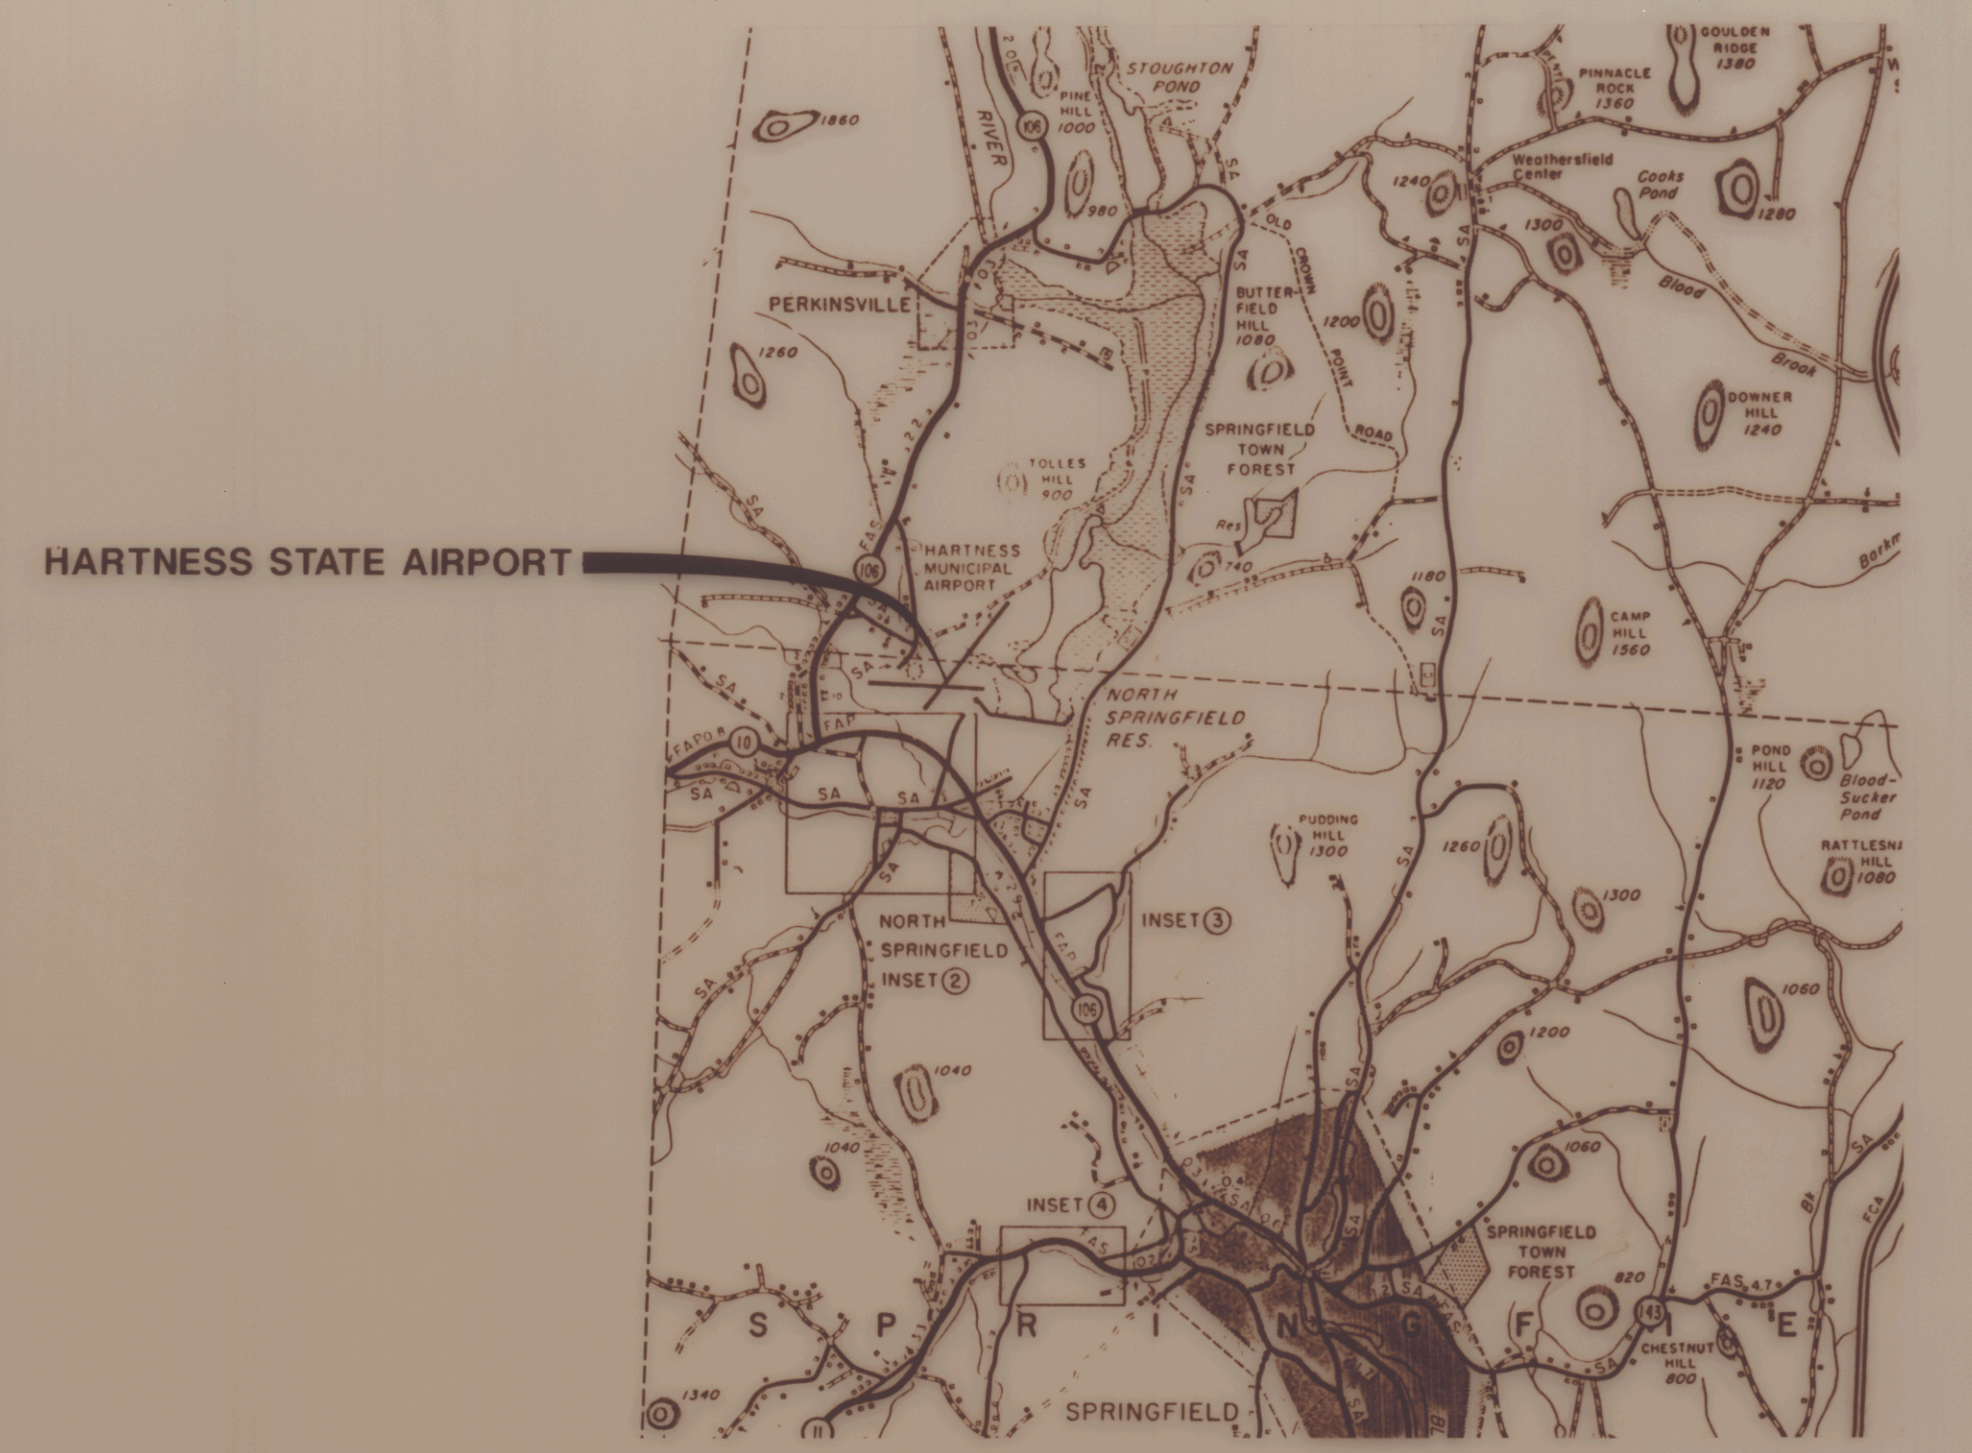

VICINITY MAP
1" = 1 MILE

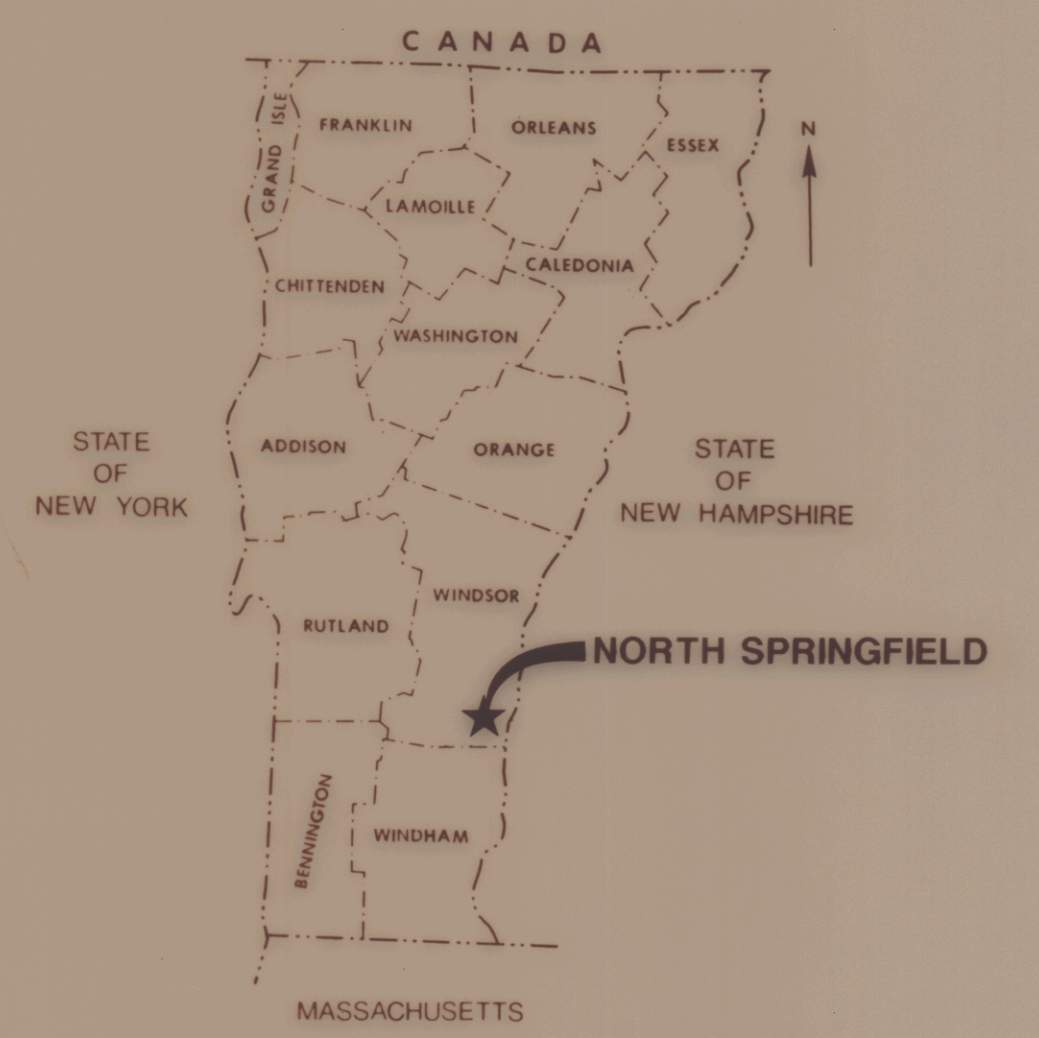

LOCATION MAP
NOT TO SCALE



NOTE: THIS DRAWING REPRESENTS EXISTING FEATURES ON THE DATE OF THE SITE INSPECTION BY DUFRESNE-HENRY. IT IS A COMPLETION DRAWING BASED ON INFORMATION PROVIDED BY THE VERMONT AGENCY OF TRANSPORTATION, THE SYSTEM OPERATOR, AND VERIFIED BY FIELD INSPECTION.

VERMONT AGENCY OF TRANSPORTATION
**FUEL SYSTEM STUDY
HARTNESS STATE AIRPORT**

NORTH SPRINGFIELD, VERMONT

	Client No. 217016	
	Proj. Manager T.S. REEVES	
	Proj. Designer T.S. REEVES	
	Drawn By W. HAZLETT	
	Checked By P.N. ANDREWS	
	Scale AS SHOWN	
Approved	Sheet 4 of 11	
Date FEBRUARY 1, 1987	D 11,175	

Rev.	Description	By	Date