





**SITE PLAN**  
1" = 20'

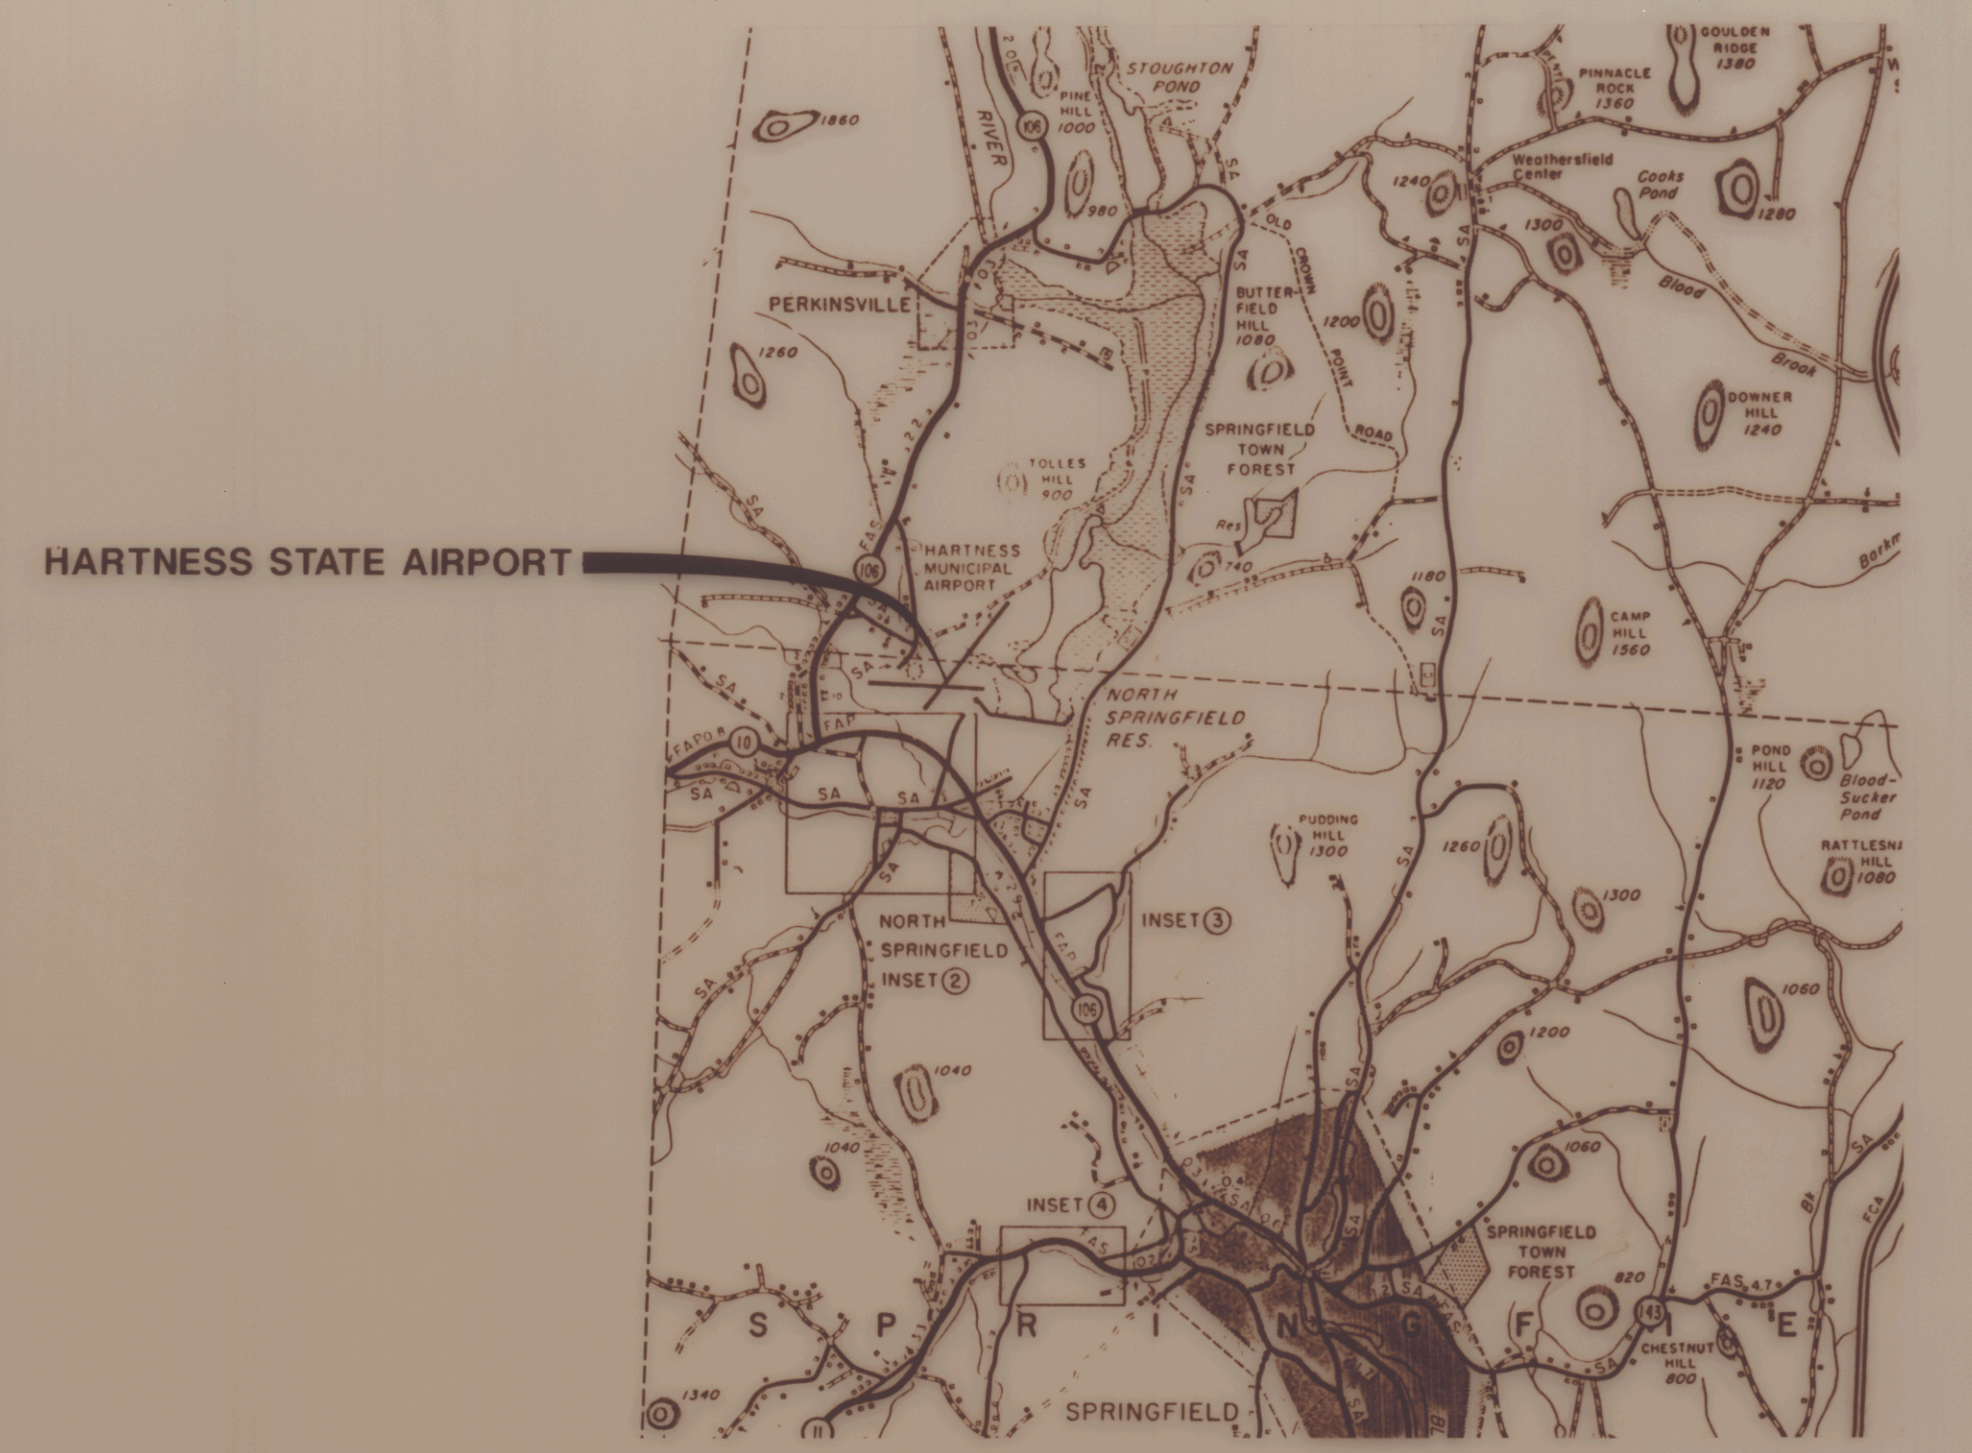

**VICINITY MAP**  
1" = 1 MILE

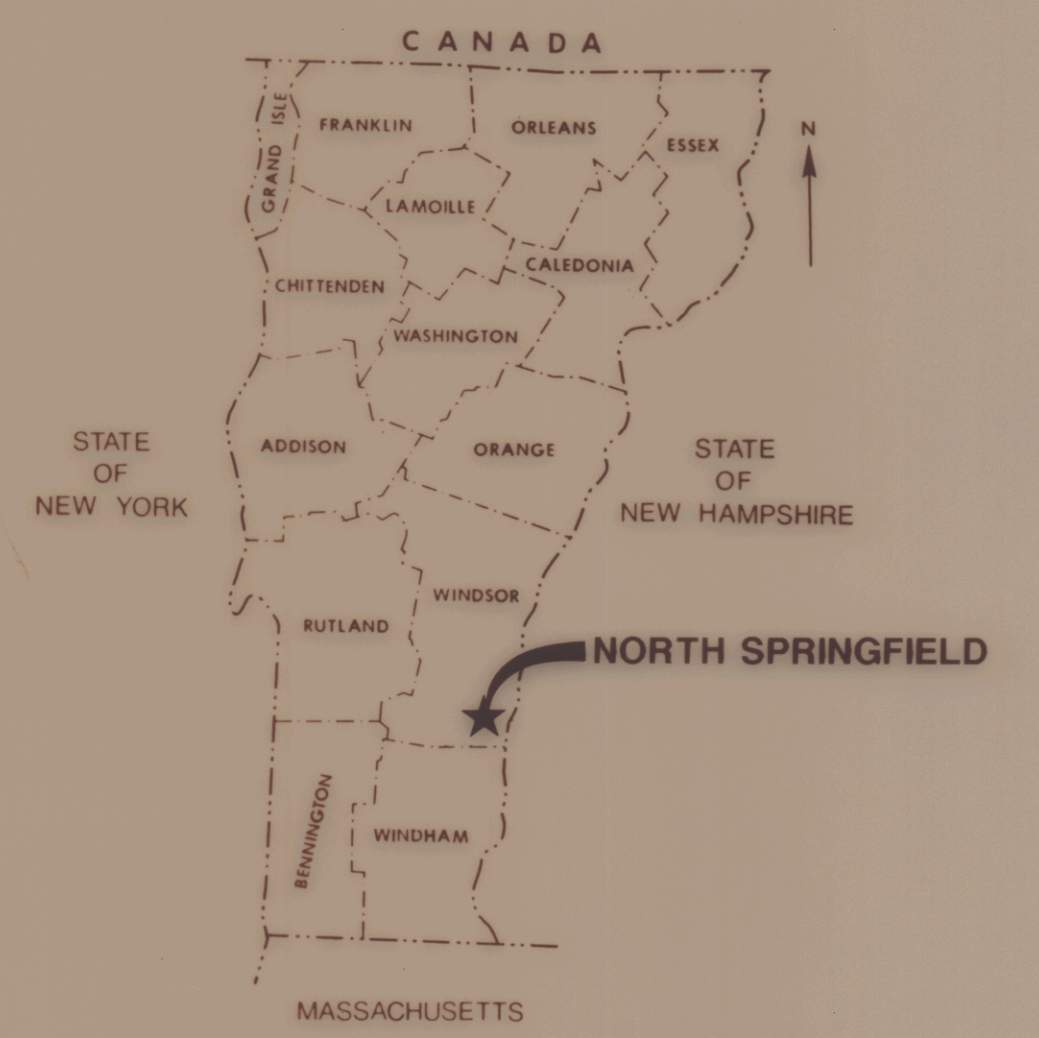

**LOCATION MAP**  
NOT TO SCALE

**NOTE:** THIS DRAWING REPRESENTS EXISTING FEATURES ON THE DATE OF THE SITE INSPECTION BY DUFRESNE-HENRY. IT IS A COMPLETION DRAWING BASED ON INFORMATION PROVIDED BY THE VERMONT AGENCY OF TRANSPORTATION, THE SYSTEM OPERATOR, AND VERIFIED BY FIELD INSPECTION.



VERMONT AGENCY OF TRANSPORTATION  
**FUEL SYSTEM STUDY**  
**HARTNESS STATE AIRPORT**

NORTH SPRINGFIELD, VERMONT

 <b>Dufresne-Henry</b> Precision Park No. Springfield, Vermont 05150	Client No. 217016	 STATE OF VERMONT PETER W. ANDREWS No. 8108 REGISTERED PROFESSIONAL ENGINEER
	Proj. Manager T.S. REEVES	
	Proj. Designer T.S. REEVES	
	Drawn By W. HAZLETT	
	Checked By P.N. ANDREWS	
	Scale AS SHOWN	
Approved	Sheet 4 of 11	
Date FEBRUARY 1, 1987	D 11,175	

Rev.	Description	By	Date