


ISSUE	REVISION	NO
NO DATE	DESCRIPTION	PRINTS
12/1/84	REVISIONS	
12/20/84	FOR AIRPORT ZONE VALVE	1
	FOR AIRPORT ZONE VALVE	2
	FOR AIRPORT ZONE VALVE	7

P - To Panel
 T - Thermostat
 TS - Time Switch
 EM - Emergency Light Panel
 Z - Zone Valve
 T - Junction Box
 PA - Public Address System
 Tel - Telephone Board
 All Conduits 3/4" Except as Noted

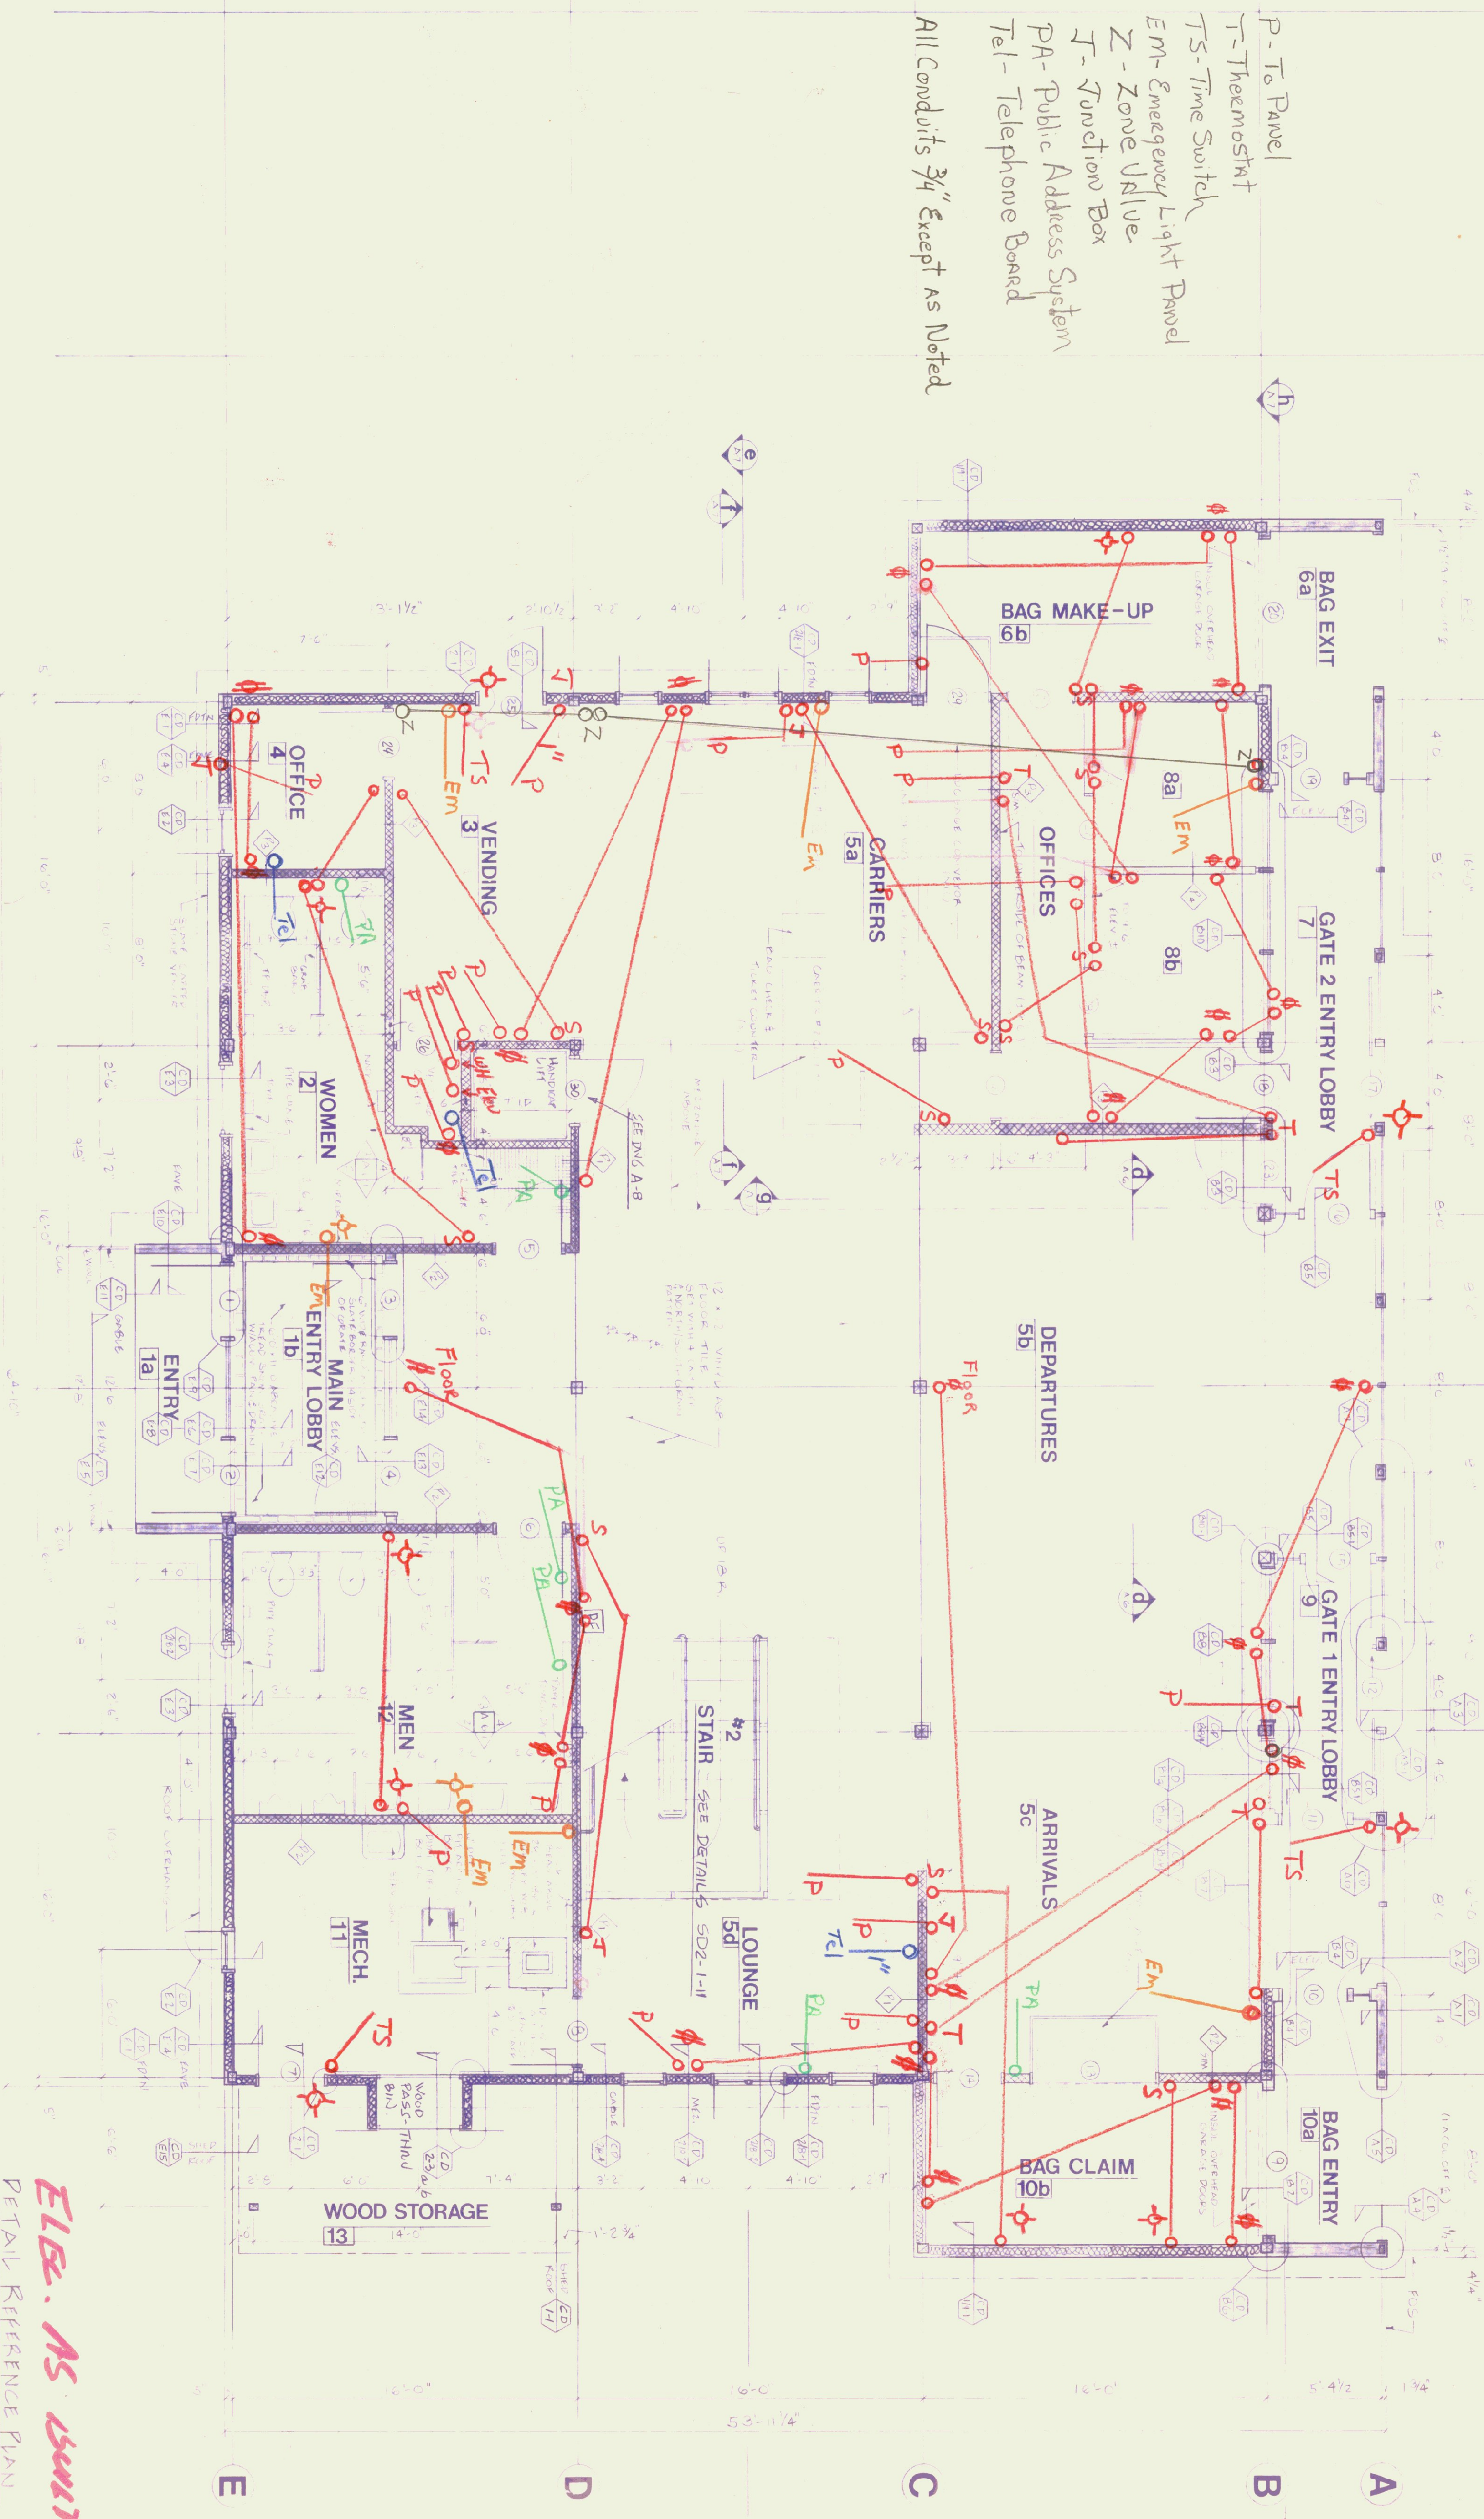

ELB. AS UNIT

DETAIL REFERENCE PLAN

STATE OF VERMONT
 DIVISION OF STATE BUILDINGS
 ADMINISTRATION
 MONTPELIER, VERMONT

RUTLAND TERMINAL BUILDING AIR 23-2024
FIRST FLOOR PLAN

REVISIONS
 NO DATE DESCRIPTION
 1 12/1/84
 2 12/20/84
 7