



GRANITE CURBING TO MATCH EXISTING

TYPE 'A' PAVEMENT PLAN

SCALE: FULL SIZE

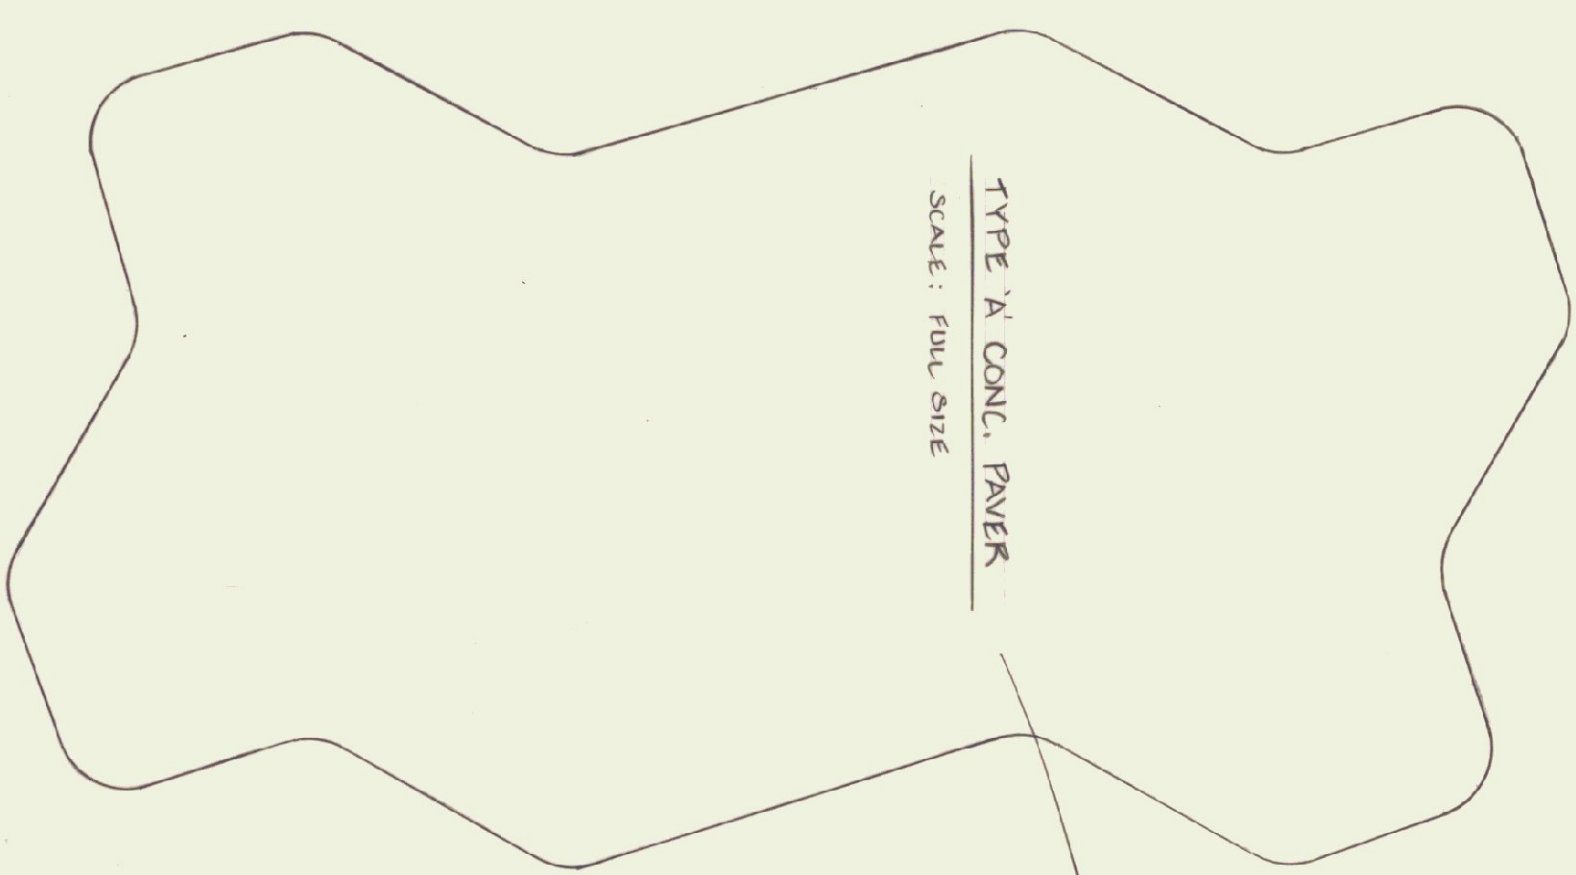


TYPE 'A' TO BE SET IN A 4"x4"x1/2" CONC. PAVEMENT. ALL OUTSIDE EDGES @ GRASS & TYPE 'B' PAVEMENTS ARE TO BE EDGED WITH PRESSURE TREATED (LP-22) 4"x4"x1/2" SPIKE 4"x4"x1/2" INTO GROUND WITH 1/2"x1/2"x2" STAINLESS STEEL RODS @ 6" O.C. SET 4"x4"x1/2" FLUSH WITH TOP OF PAVEMENT. TYPE 'A' TO BE SET ON 2" OF COMPACTED SAND ON 10" OF COMPACTED GRANULAR FILL.

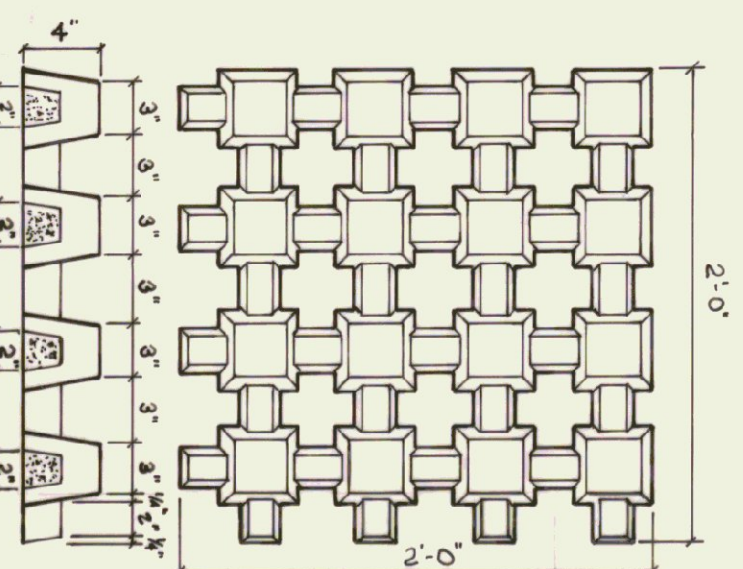

TYPE 'B' PAVEMENT  
UNIT PLAN  
BUTT JOINTS CONTAIN BUSHY WOOD AS SHOWN IN PLAN. TYPE 'B' TO BE SET ON 2" OF COMPACTED SAND ON 10" OF COMPACTED GRANULAR FILL.


TYPE 'B' TO BE SET ON 2" OF COMPACTED SAND ON 10" OF COMPACTED GRANULAR FILL. JOINTS IN PAVEMENTS FLUSH WITH A MANTLE OF TOPSOIL. LINE FERTILIZER TO 20" DEPTH AND SETTING SAND WITH A TORUSOL MIX TO BRING THE TORUSOL FLUSH WITH TOP OF THE PAVEMENT. SEED AT SLIGHTLY LESS THAN NORMAL RATE, AND MULCH WHEN GRASS IS 2 1/2" HIGH. CUT TO 1 1/2".

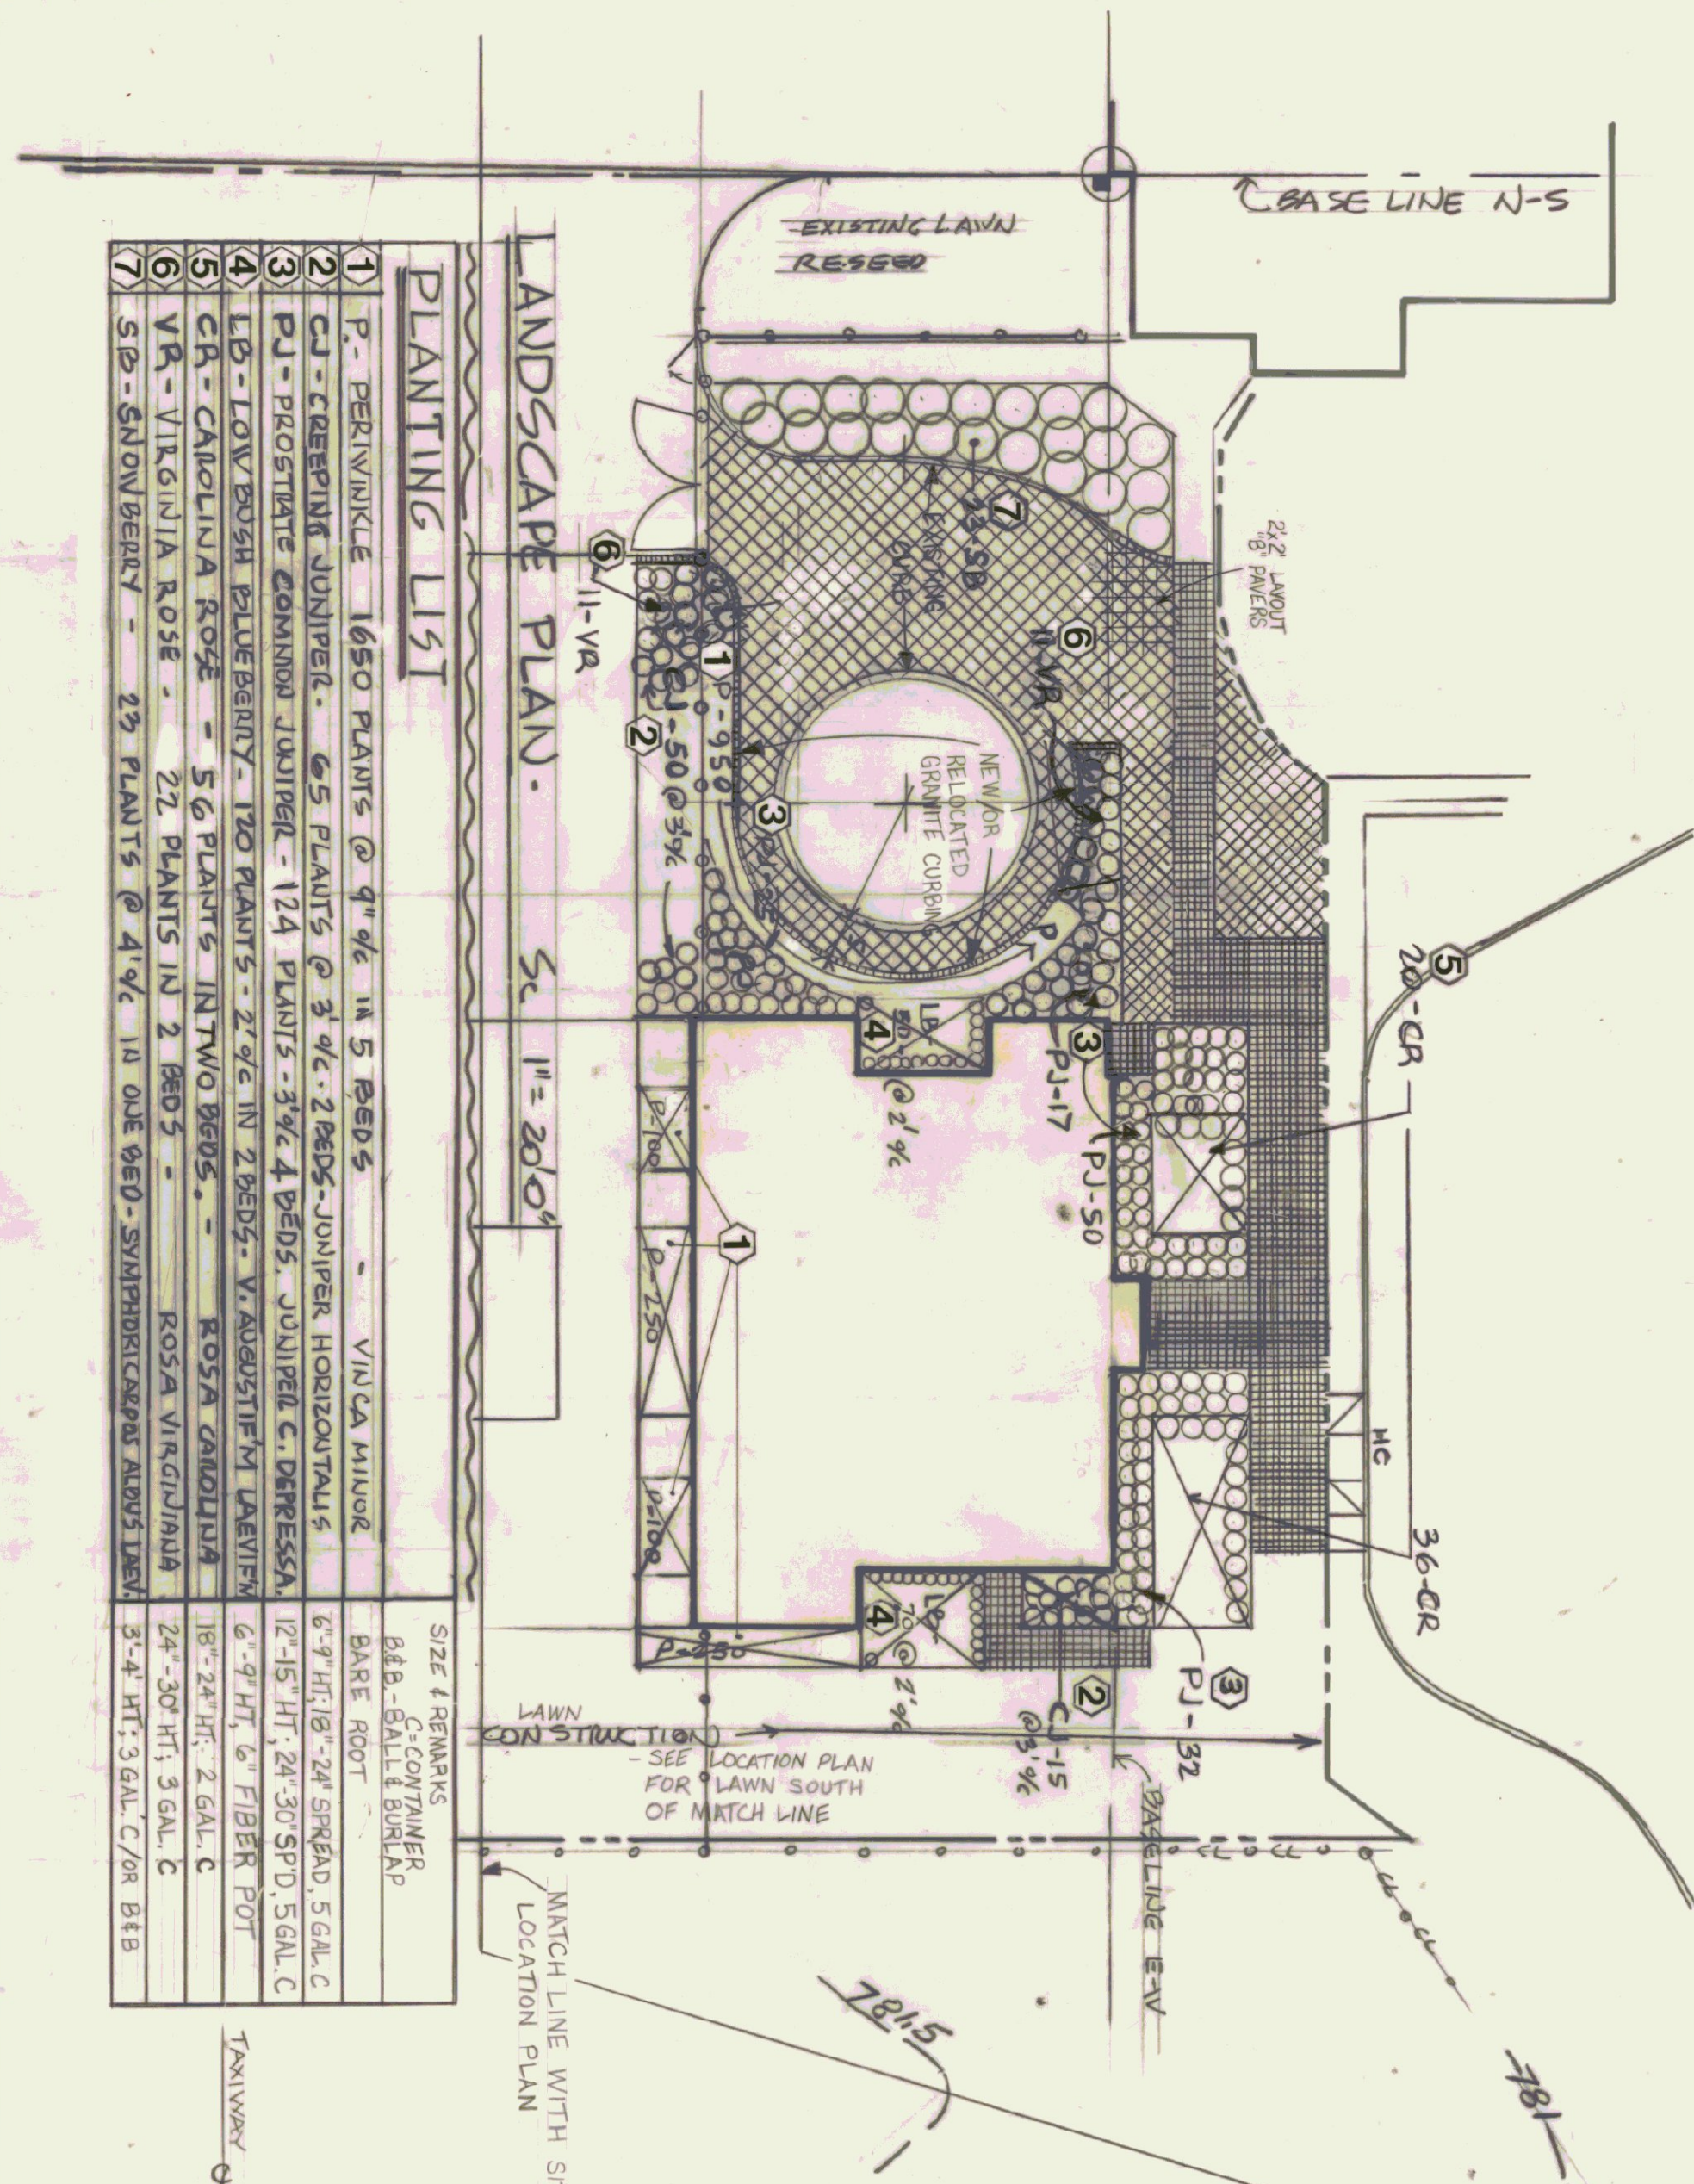

LANDSCAPE PLAN - Scale 1/4" = 20'-0"

PLANTING LIST	SIZE & REMARKS
1 P - BERLINI UNCLER 1650 PLANTS @ 9" x 6" IN 5 BEDS	5" x 9" HT. 18" - 24" SPREAD 5 GAL. C
2 CJ - CREEPER JUNIPER 65 PLANTS @ 3" x 4" 2 BEDS - JUNIPER HORIZONTALIS	12-15 HT. 24" - 30" SPREAD 5 GAL. C
3 PJ - PROSTRATE COMMON JUNIPER 124 PLANTS @ 3" x 4" 4 BEDS - JUNIPER C. DRESSERA	6" - 9" HT. 6" FIBER POT
4 LB - LOW BUSH BLUEBERRY 120 PLANTS @ 2 1/2" x 2 1/2" IN 2 BEDS - V. AUSTRIACUM LAEVIFL.	18" - 24" HT. 2 GAL. C
5 CA - CAROLINA ROSE 50 PLANTS IN TWO BEDS - ROSA CAROLINANA	24" - 30" HT. 3 GAL. C
6 VA - VIRGINIA ROSE 22 PLANTS IN 2 BEDS - ROSA VIRGINIANA	3" - 4" HT. 3 GAL. C OR 8TB
7 SB - SNOW BERRY 23 PLANTS @ 4 1/4" IN ONE BED - SWAMPBERRY	

FOR GRADES & LAYOUT OF ROADS NORTH OF SITE WORK CONTRACT LIMIT LINE REFER TO DRAWINGS FOR RUTLAND STATE AIRPORT, DATED 8-15-83. PREPARED BY PHILIP ENGINEERING ASSOC., INC. DRAWING 3 OF 44 FOR GRADES AND DRAWING 15 OF 44 FOR ROAD LAYOUT.

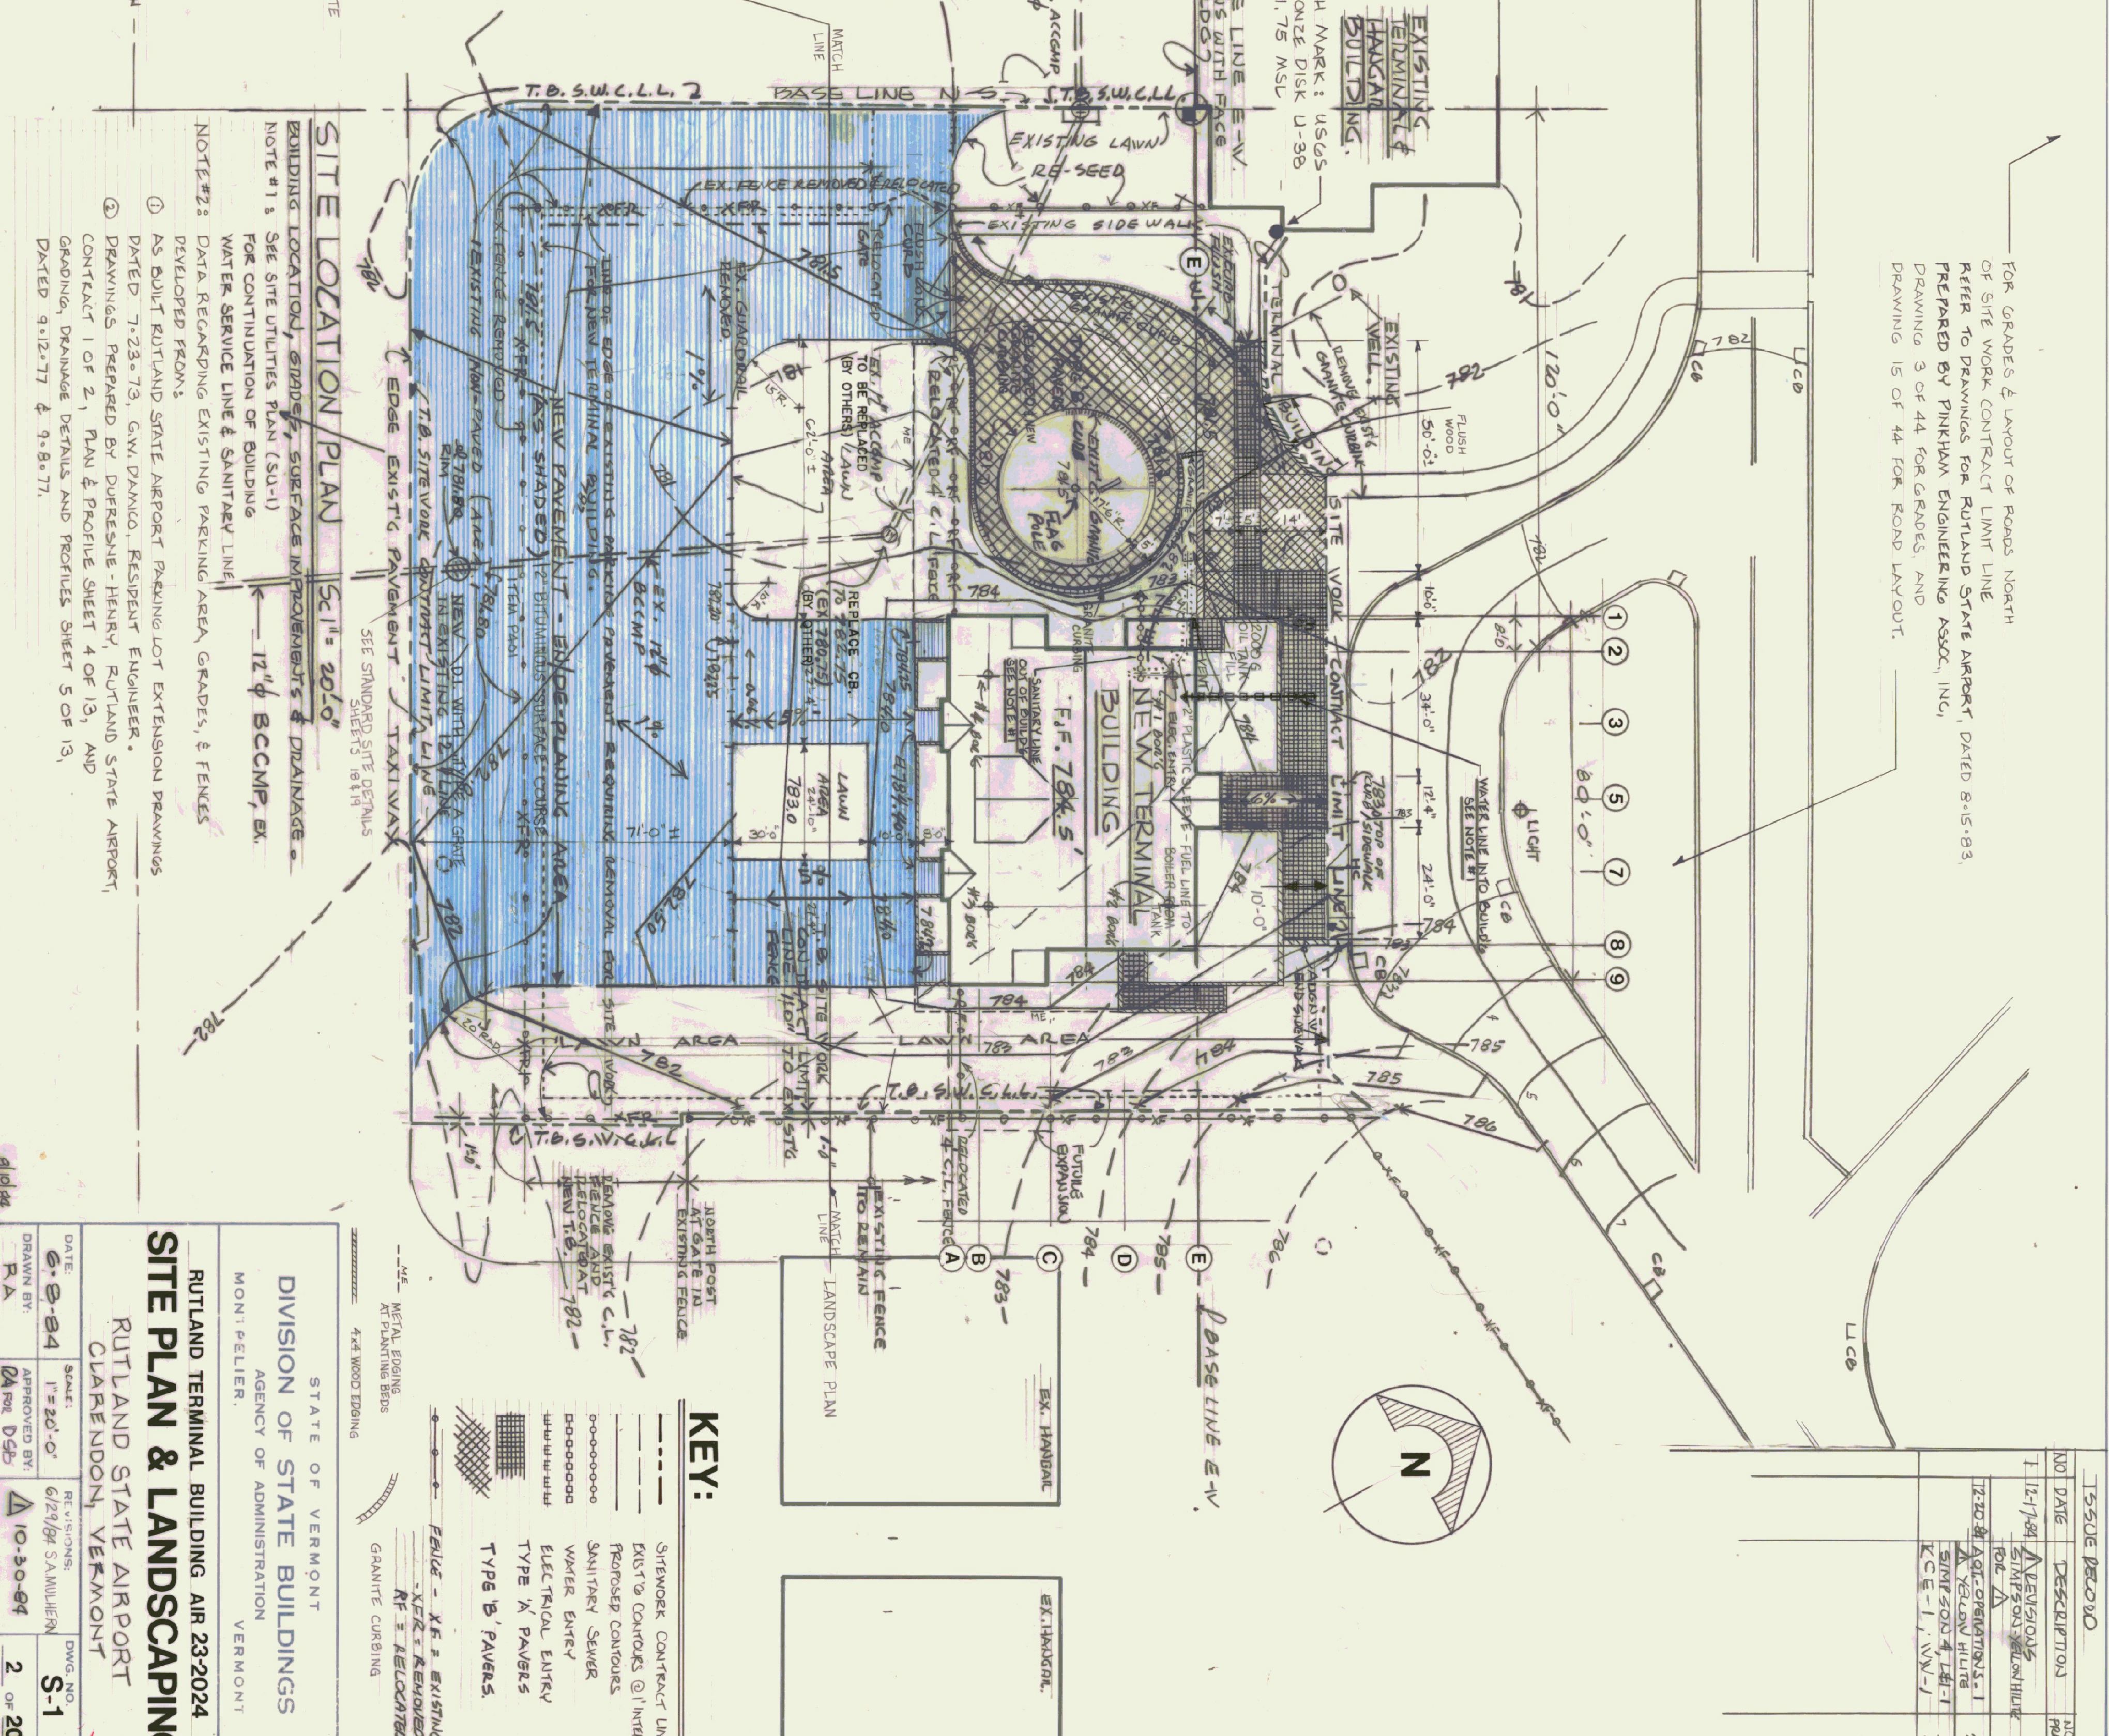

SITE LOCATION PLAN - Scale 1/4" = 20'-0"

NOTE #1: SEE SITE UTILITIES PLAN (SD-1) FOR CONTINUATION OF BUILDING WATER SERVICE LINE & SANITARY LINE.

NOTE #2: DATA REGARDING EXISTING PARKING AREA GRADES, & FENCES DEVELOPED FROM:

1 AS BUILT RUTLAND STATE AIRPORT PARKING LOT EXTENSION DRAWINGS DATED 7-23-73, G.W. DAVINO, RESIDENT ENGINEER.

2 DRAWINGS PREPARED BY DUFRESNE - HENRY, RUTLAND STATE AIRPORT, CONTACT 1 OF 2, PLAN & PROFILE SHEET 4 OF 13, AND GRADING, DRAINAGE DETAILS AND PROFILES SHEET 5 OF 13, DATED 9-12-77 & 9-8-77.

STATE OF VERMONT  
DIVISION OF STATE BUILDINGS  
AGENCY OF ADMINISTRATION  
VERMONT

MONI PELIER

SITE PLAN & LANDSCAPING

RUTLAND STATE AIRPORT  
CLARENDON, VERMONT

DRAWN BY: RA  
APPROVED BY: DAP/DSP  
SCALE: 1/4" = 20'-0"  
DWG NO: S-1  
2 OF 20

KEY:

---	SITENOTE CONTRACT LIMITS
---	EXIST'G CONTOURS @ INTERVALS
---	PROPOSED CONTOURS
---	SANITARY SEWER
---	WATER ENTRY
---	ELECTRICAL ENTRY
---	TYPE 'A' PAVEMENTS
---	TYPE 'B' PAVEMENTS
---	EXIST'G - X.F. = EXISTING
---	X.F. = EXISTING
---	RELOCATED
---	GRANITE CURBING