
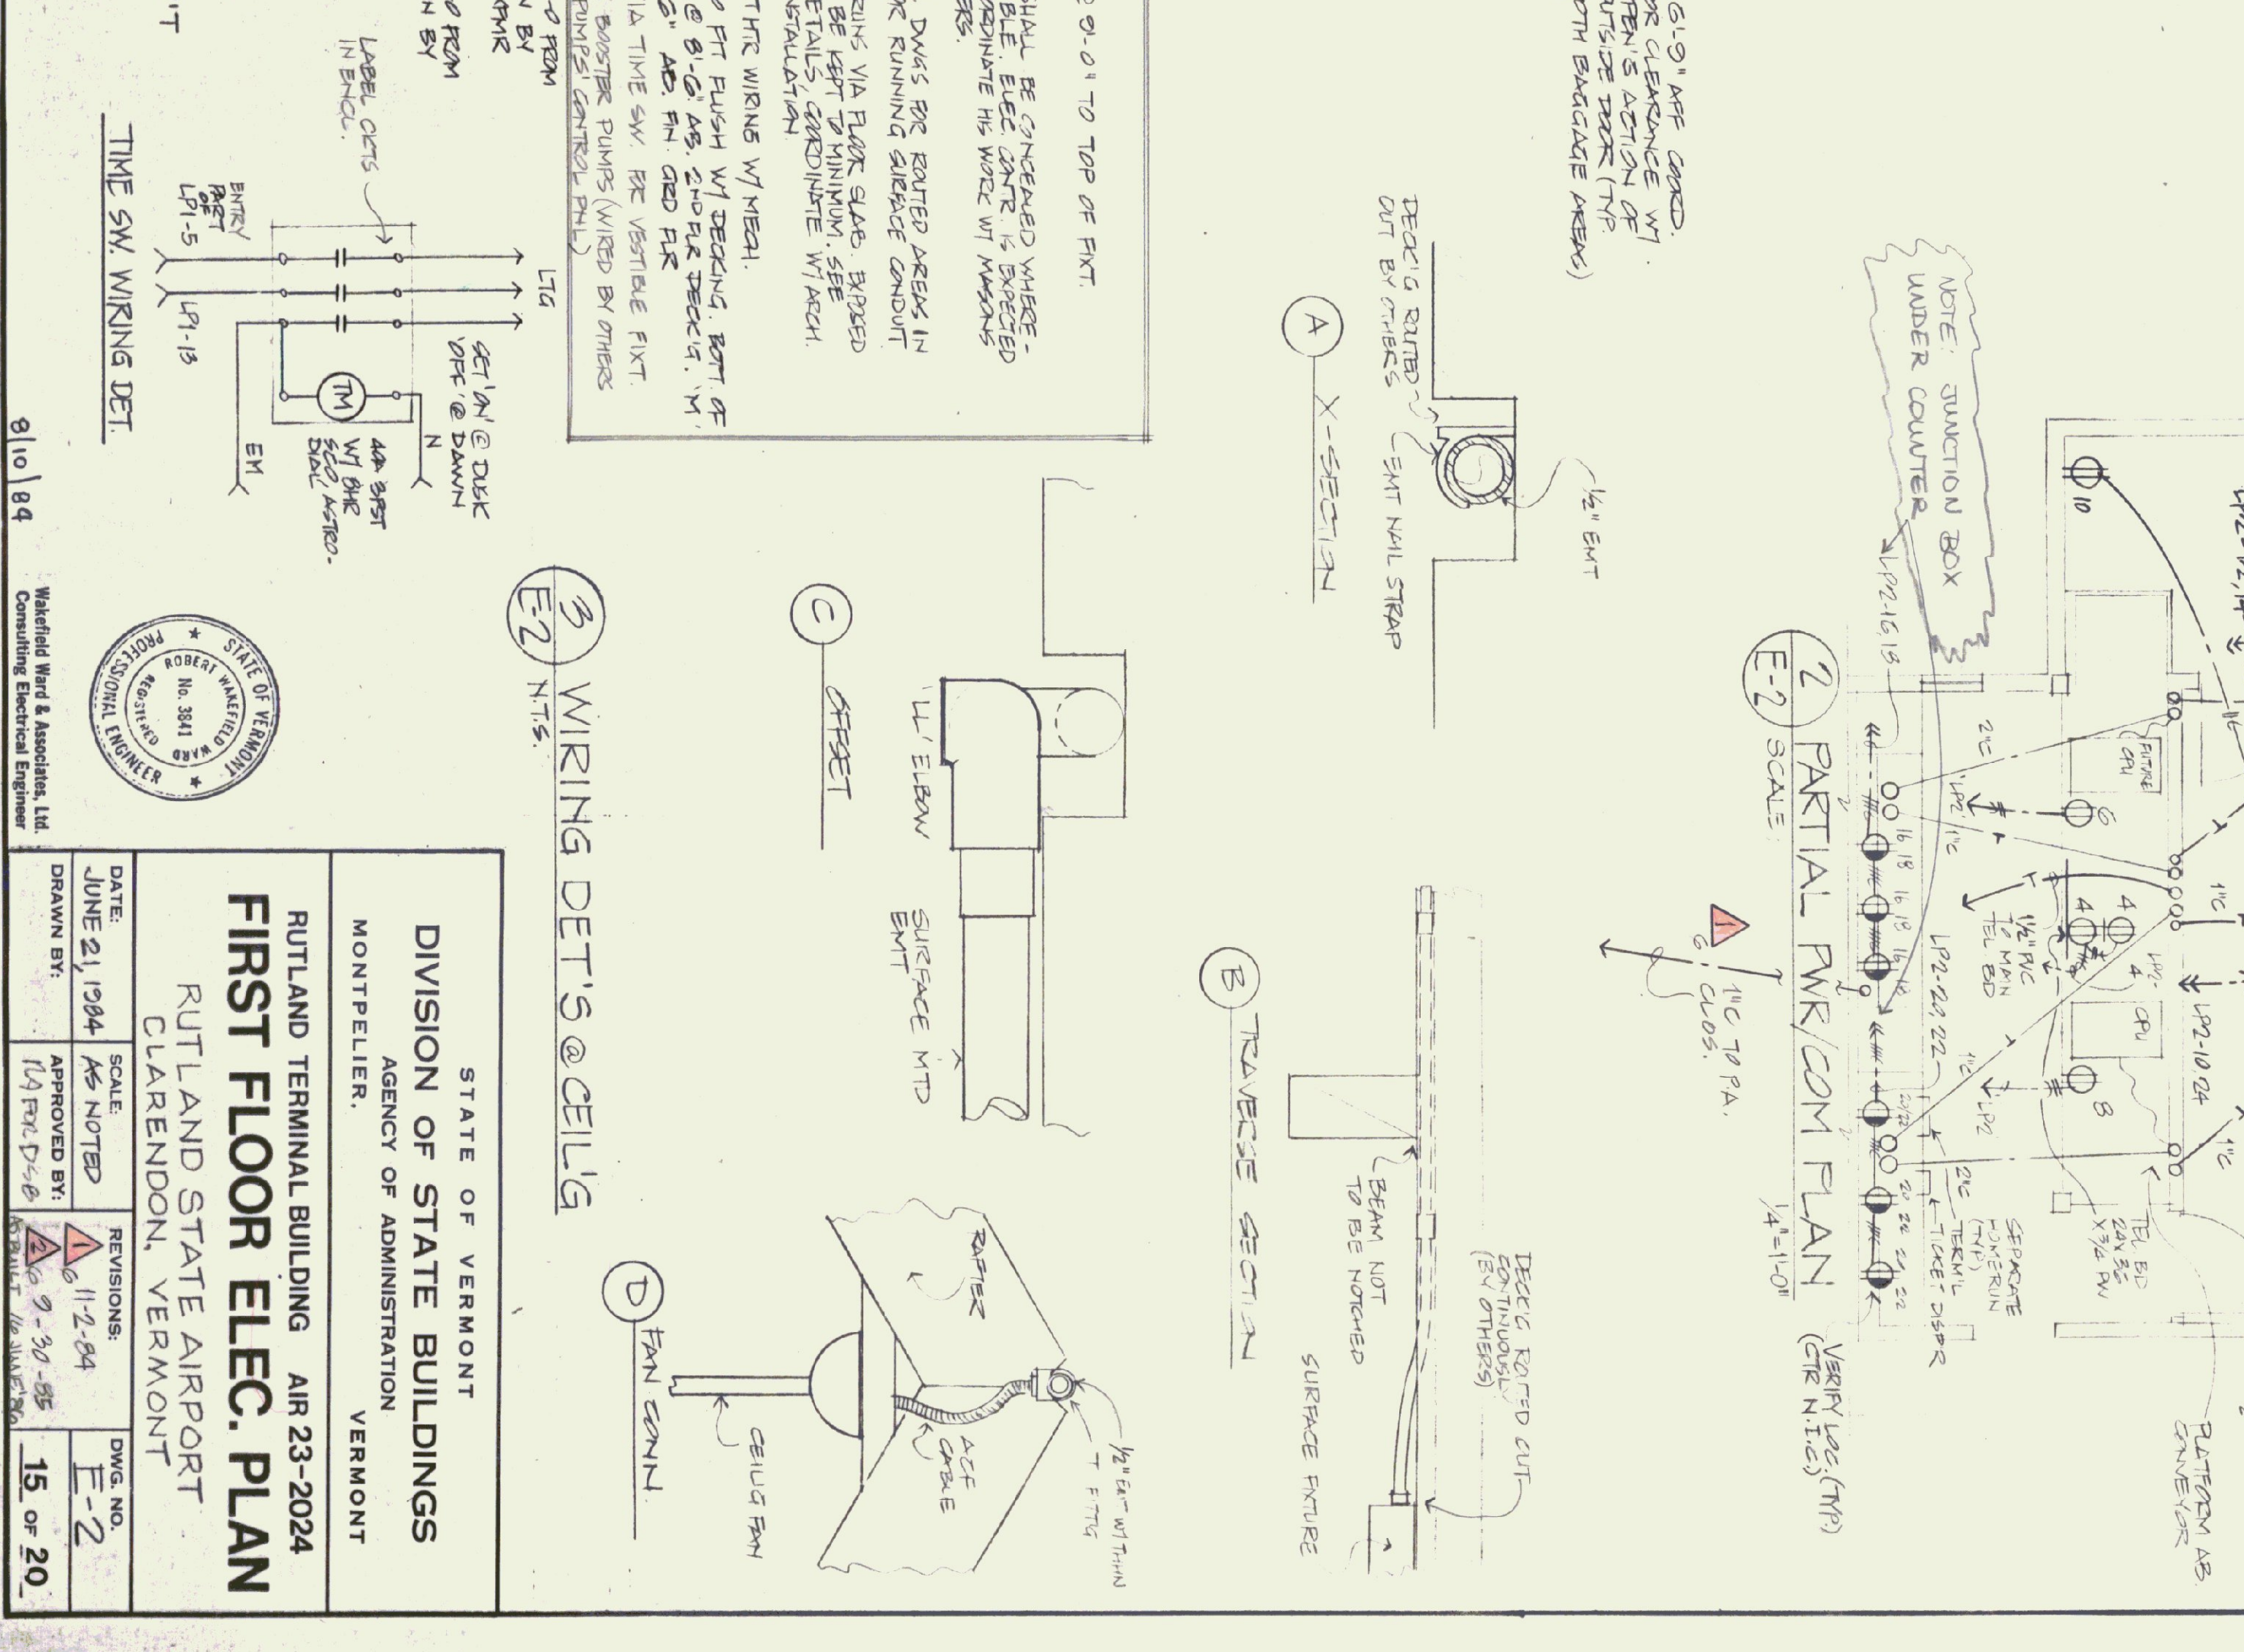
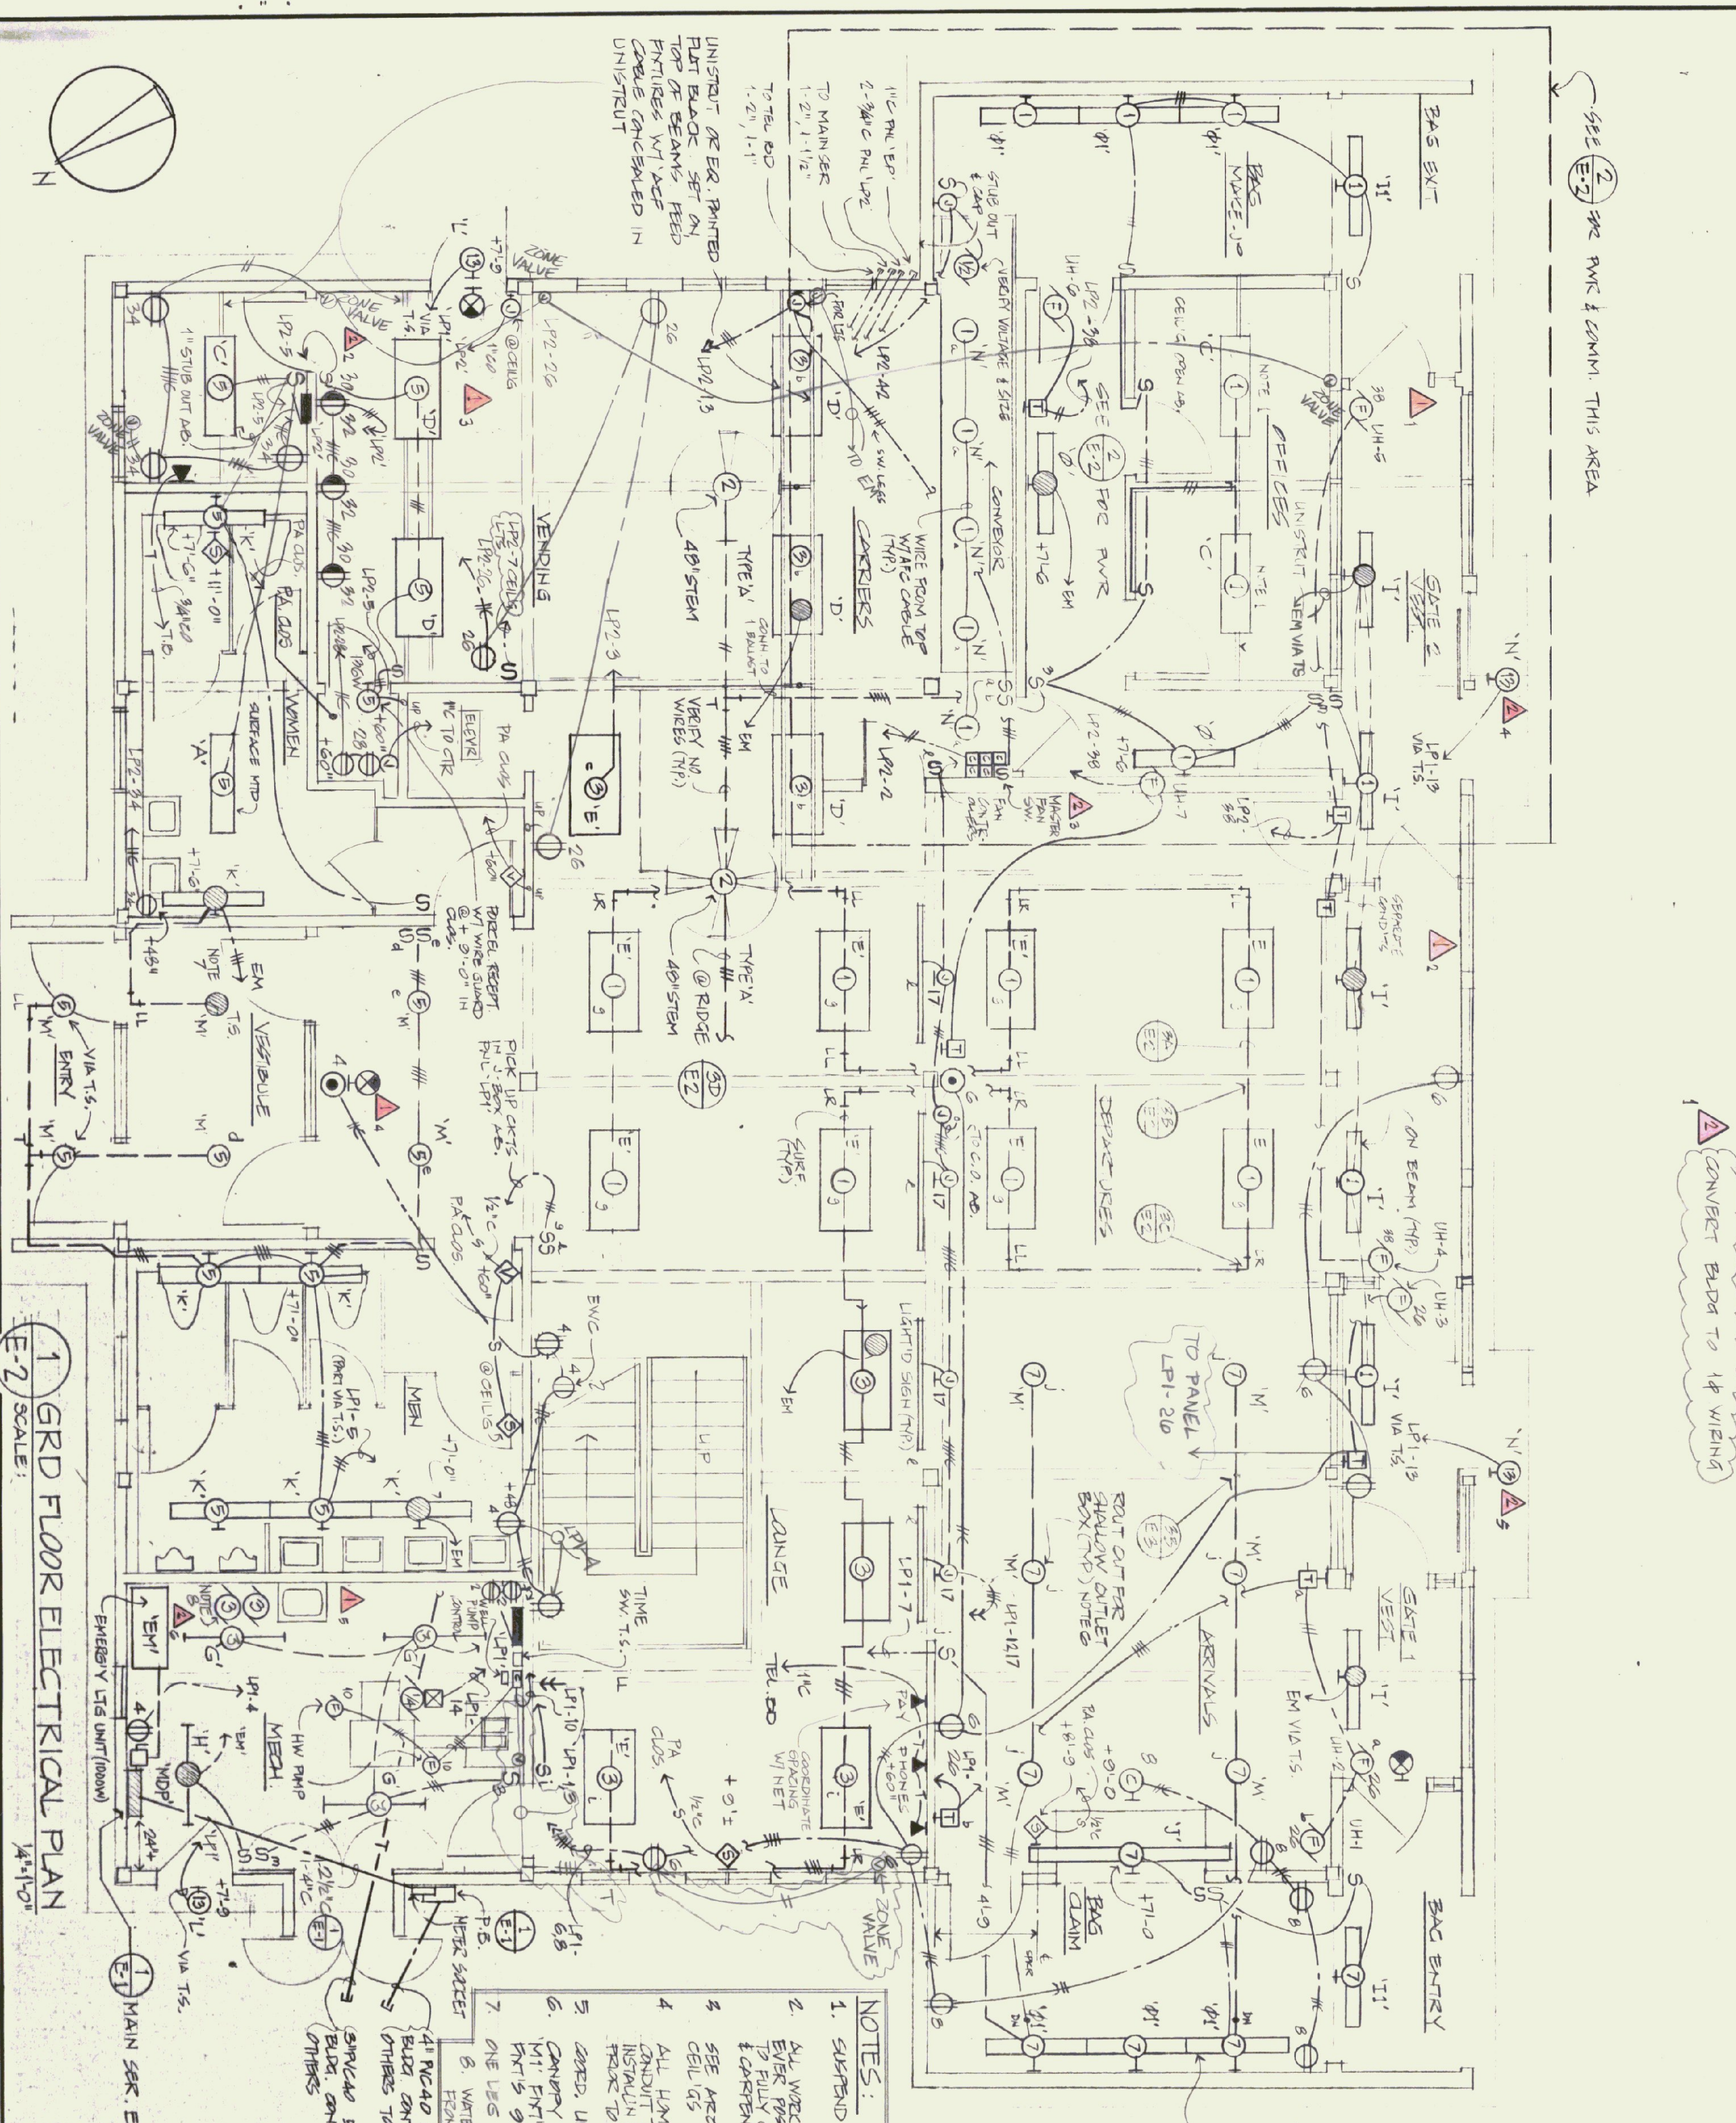


CIRCUIT NO.	CIRCUIT DESCRIPTION	LOAD VOLT - AMPERES			FEED: BOTTOM	TOP	MFG. SURFACE	FINISH
		L1	L2	L3				
1	110V AC	3600	3600	3600	✓	✓	✓	
2	110V AC	980	1080	1200	✓	✓	✓	
3	110V AC	3000	700	615	✓	✓	✓	
4	110V AC	350	670	500	✓	✓	✓	
5	110V AC	400	2450	800	✓	✓	✓	
6	110V AC	3100	3100	800	✓	✓	✓	
7	110V AC	1200	900	800	✓	✓	✓	
8	110V AC	615	1440	920	✓	✓	✓	
SUB-TOTAL		28000	3725	10010				
CONNECTED LOAD / PHASE		12,790	13,195	12,790				
DEMAND LOAD / PHASE		9750	10,350	9750				
TOTAL DEMAND LOAD		10,500 VA						

CIRCUIT NO.	CIRCUIT DESCRIPTION	LOAD VOLT - AMPERES			FEED: BOTTOM	TOP	MFG. SURFACE	FINISH
		L1	L2	L3				


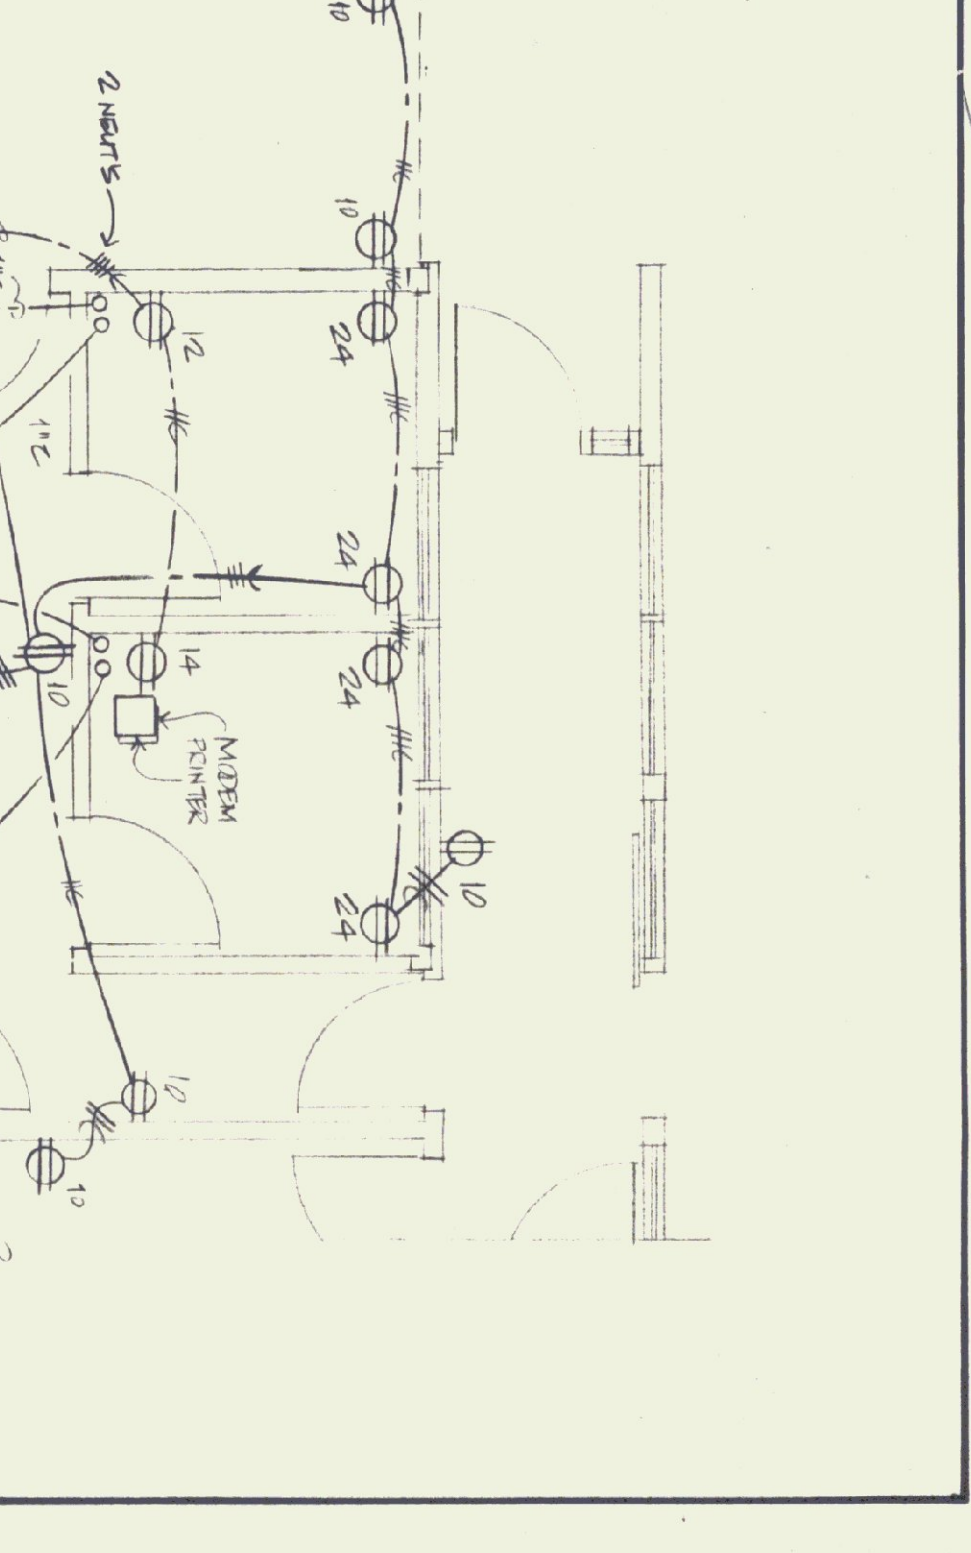

STATE OF VERMONT  
DIVISION OF STATE BUILDINGS  
AGENCY OF ADMINISTRATION  
VERMONT

RUTLAND TERMINAL BUILDING AIR 23-2024  
**FIRST FLOOR ELEC. PLAN**  
RUTLAND STATE AIRPORT  
CLARENDON, VERMONT

DATE: JUNE 21, 1984  
DRAWN BY: [Signature]  
SCALE: AS NOTED  
APPROVED BY: [Signature]  
REVISIONS: 11-2-84  
9-30-85  
DWG. NO. E-2  
15 OF 20