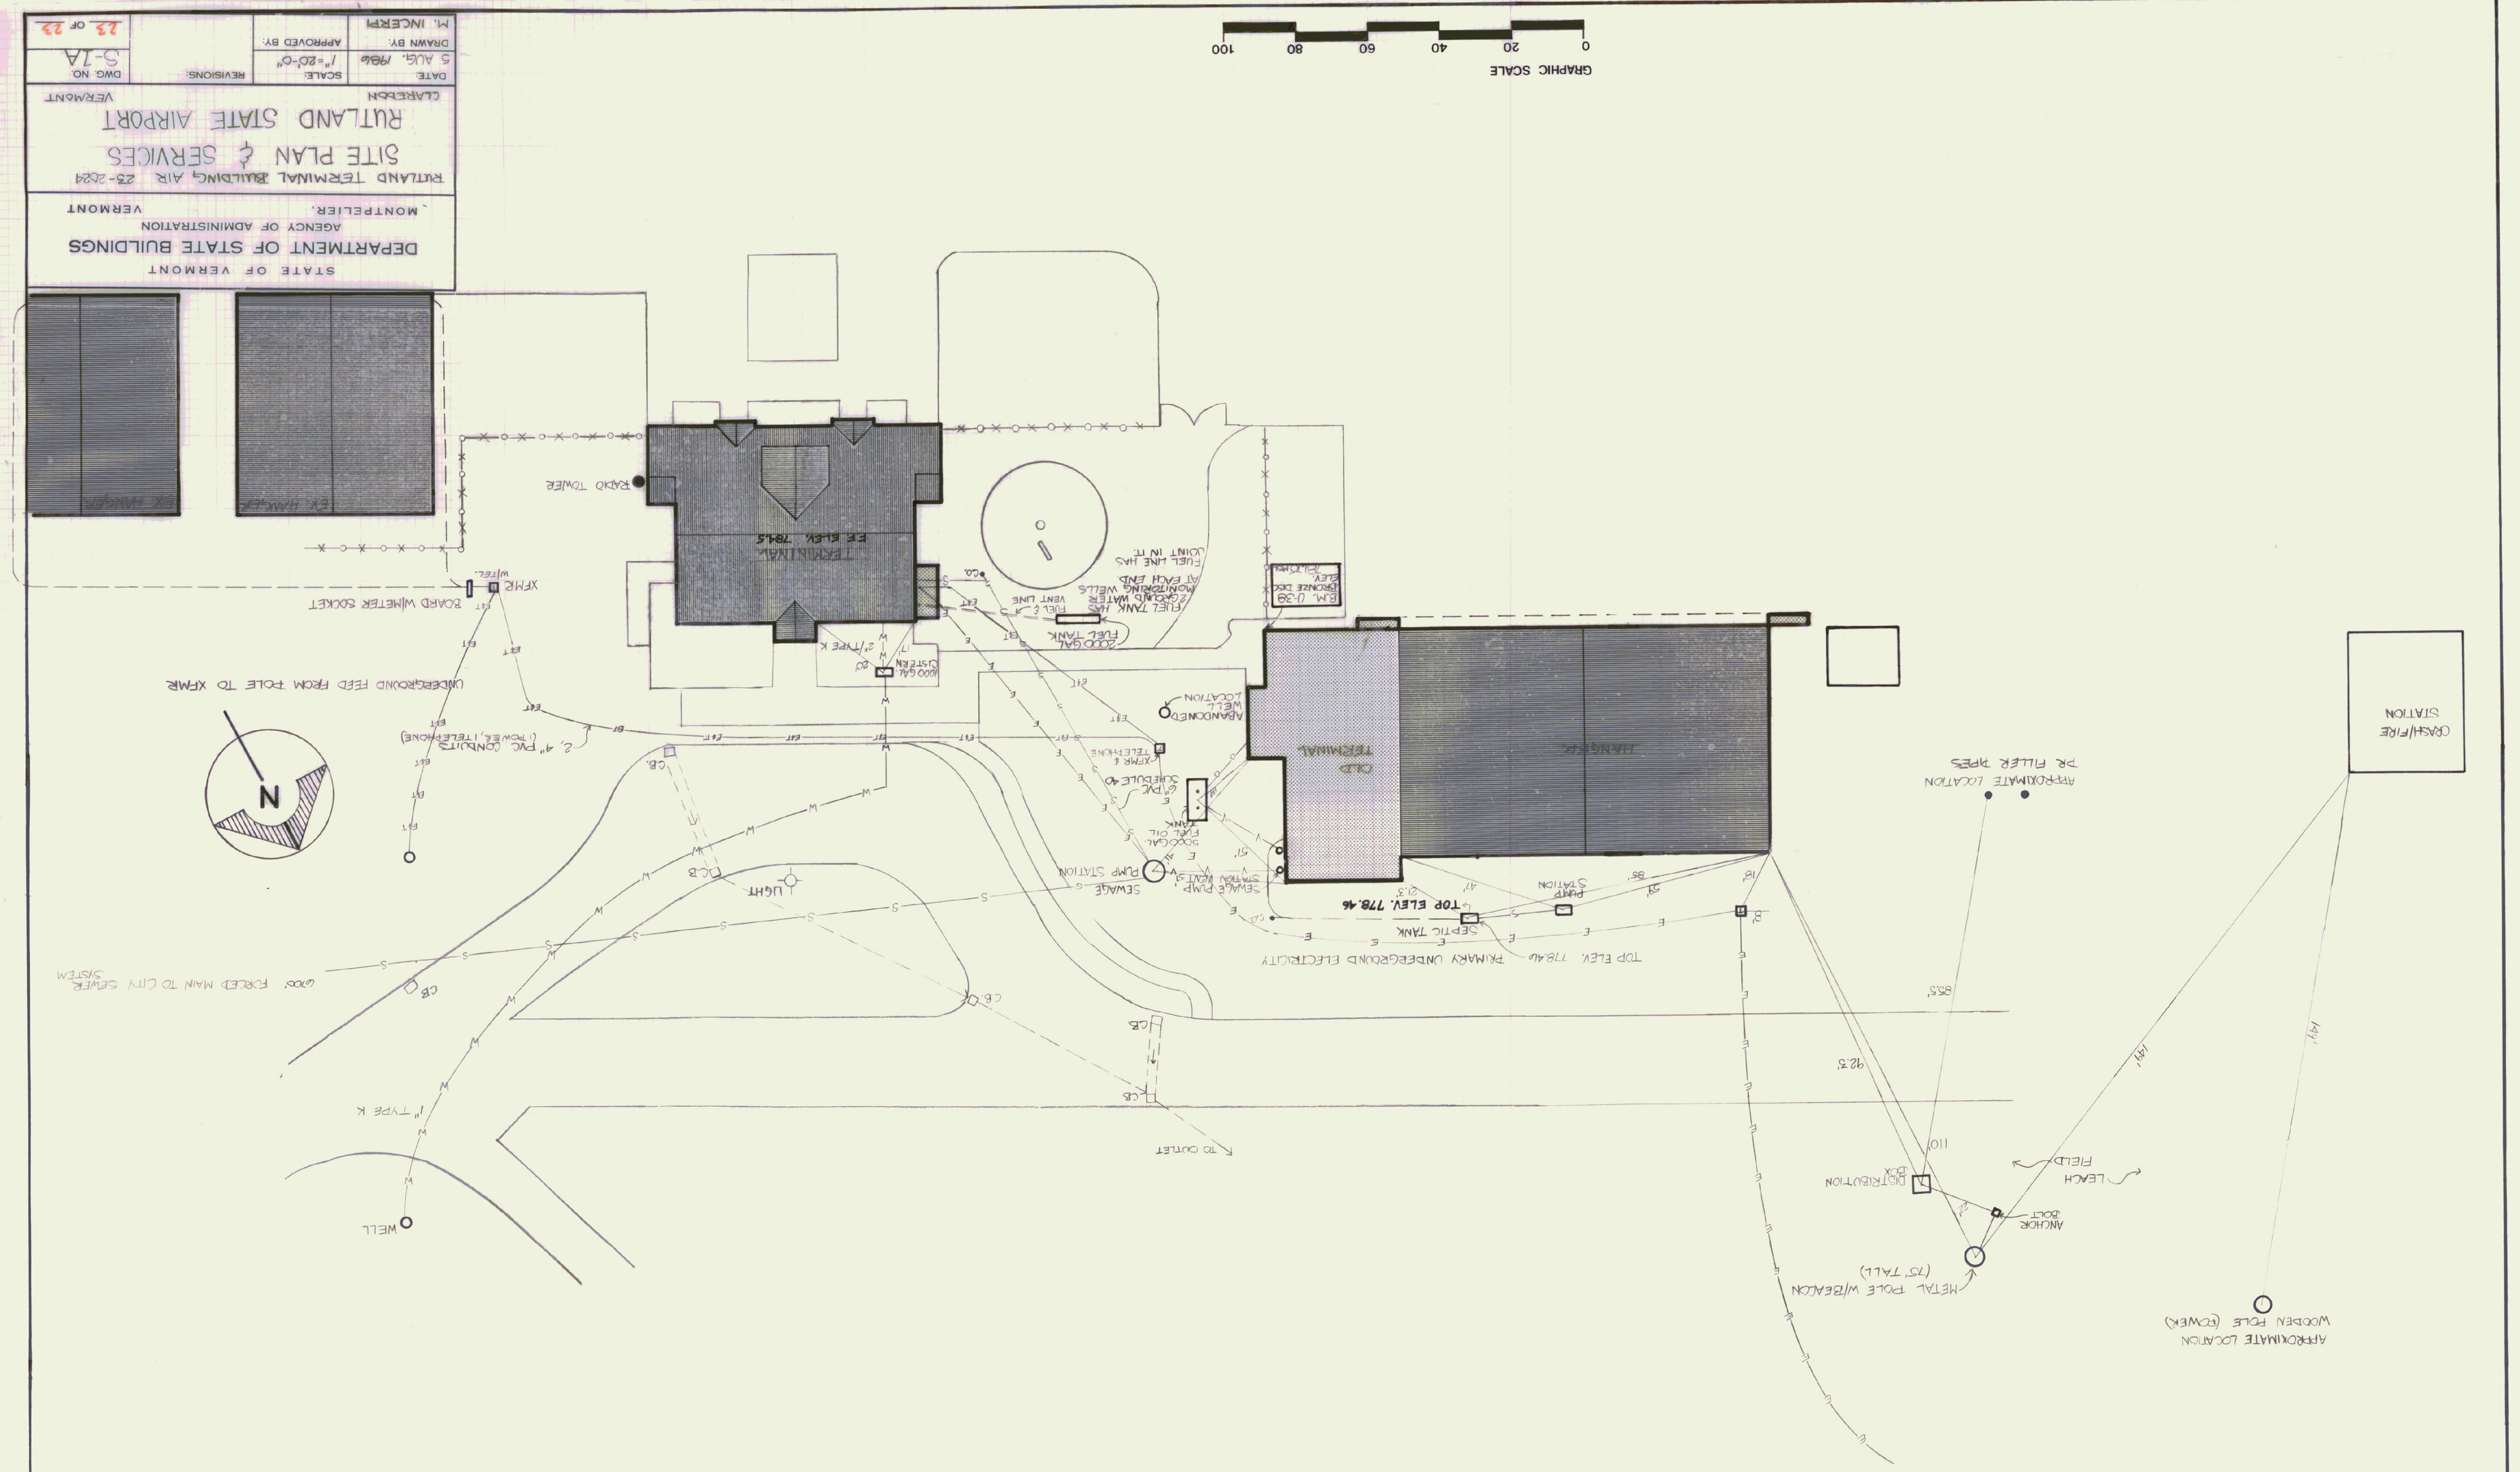
STATE OF VERMONT
DEPARTMENT OF STATE BUILDINGS
AGENCY OF ADMINISTRATION
MONTPELIER, VERMONT
RUTLAND TERMINAL BUILDING AIR 23-2024
SITE PLAN & SERVICES
RUTLAND STATE AIRPORT
CLARENDON VERMONT
DATE 5 AUG. 1986
SCALE 1"=20'-0"
DRAWN BY: M. INCERPI
APPROVED BY:
REVISIONS:
DWG NO S-1A
23 OF 23
GRAPHIC SCALE
0 20 40 60 80 100
N
EX HANGER
EX HANGER
RADIO TOWER
TERMINAL
EE ELEV. 78.5
OLD TERMINAL
HANGER
CRASH/FIRE STATION
APPROXIMATE LOCATION PR FILLER PIPES
APPROXIMATE LOCATION WOODEN POLE (TOWER)
METAL POLE W/BEACON (75' TALL)
ANCHOR BOLT
LEACH FIELD
DISTRIBUTION BOX
110'
92.3'
85.5'
140'
140'
TOP ELEV. 78.46
PUMP STATION
TOP ELEV. 78.4
PRIMARY UNDERGROUND ELECTRICITY
SEPTIC TANK
TO OUTLET
SEWAGE PUMP STATION
SEWAGE PUMP STATION
500 GAL. FUEL OIL TANK
4" PVC SCHEDULE 40
EXTRA 4 TELEPHONE
ABANDONED WELL LOCATION
2" TYPE K
LIGHT
CB
WELL
600' FORCED MAIN TO CITY SEWER SYSTEM
2, 4" PVC CONDUITS (POWER, TELEPHONE)
UNDERGROUND FEED FROM POLE TO XFMR
BOARD WATER SOCKET
XFMR
WATER
2" TYPE K
1000 GAL. CISTERN
2000 GAL. FUEL TANK
FUEL TANK HAS 2 GROUND WATER MONITORING WELLS AT EACH END
FUEL & VENT LINE
FUEL LINE HAS JOINT IN IT
E.M. 0.38 BRONZE DECK ELEV. 78.5