PLUMBING LEGEND

- EXISTING PIPING TO BE REMOVED (EV=EXIST VENT, ES=EXIST SANITARY, ECW=EXIST COLD, EHW=EXIST HOT, EFP=EXIST FIRE)
- SANITARY WASTE AND SOIL PIPING
- SANITARY VENT PIPING
- ES — EXISTING SANITARY PIPING
- L — RAIN LEADER PIPING
- G — GAS PIPING
- PIPE RISER
- PIPE DROP
- PIPE UNION
- GATE VALVE
- GLOBE VALVE
- BALL VALVE
- GAS COCK
- CO — CLEANOUT
- CO — SIDE CLEANOUT
- PIPE CAP
- FCO — FLOOR CLEANOUT
- R.D. — ROOF DRAIN
- M.C. — MECHANICAL CONTRACTOR
- P.C. — PLUMBING CONTRACTOR
- V.T.R. — VENT THROUGH ROOF
- N.I.C. — NOT IN CONTRACT
- G.C. — GENERAL CONTRACTOR
- CONNECT TO EXISTING

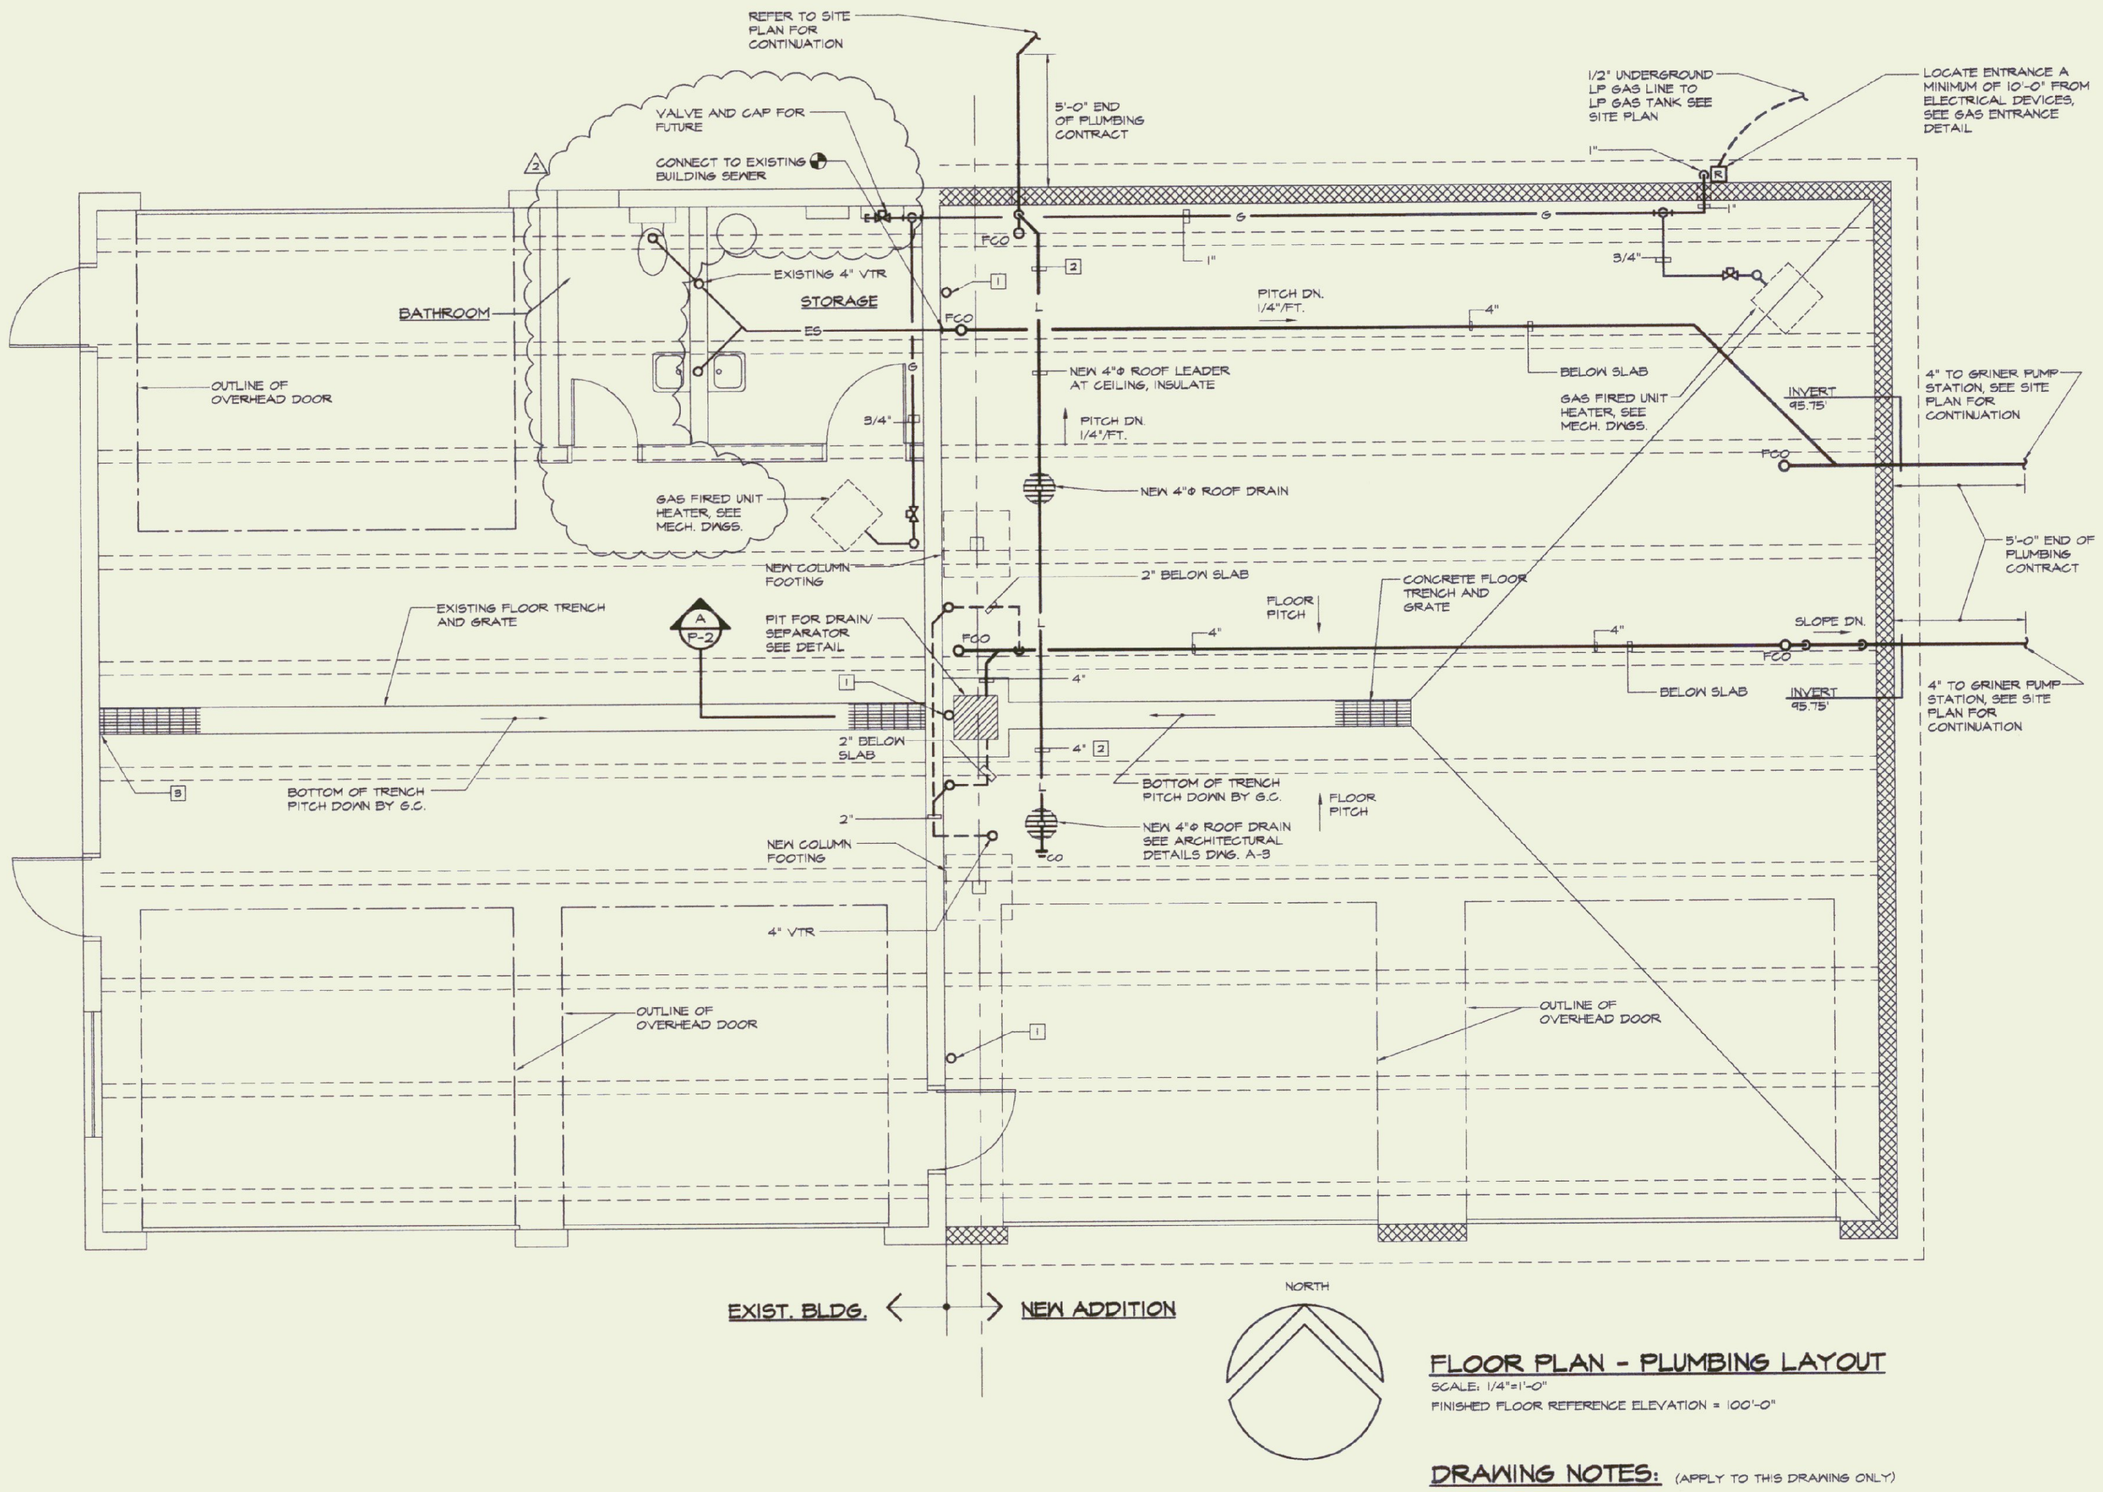

FLOOR PLAN - PLUMBING LAYOUT

SCALE: 1/4"=1'-0"

FINISHED FLOOR REFERENCE ELEVATION = 100'-0"

DRAWING NOTES: (APPLY TO THIS DRAWING ONLY)

1. REMOVE EXISTING ROOF LEADER, ROOF DRAIN AND ALL ASSOCIATED PIPING AND ACCESSORIES.
2. INSULATE NEW ROOF LEADER AT CEILING.

THE STATE OF VERMONT — DANIEL W. DUPRAS — NO. 17635 — REGISTERED PROFESSIONAL ENGINEER

NO.	ISSUED FOR	DATE
2	COST REDUCING CHANGES	7-22-02
1	BIDDING	5-24-02

LANE ASSOCIATES CONSULTING ENGINEERS, P.C.

HEATING, VENTILATION, & AIR CONDITIONING, PLUMBING, FIRE PROTECTION, & ELECTRICAL

CHARLES F. LANE, P.E.
DANIEL W. DUPRAS, P.E.

51 KILLINGTON AVENUE,
RUTLAND, VERMONT 05701

TELEPHONE: (802)747-3346
FAX/MODEM: (802)747-3356

MAIN FLOOR PLAN - PLUMBING AND DETAILS

RUTLAND STATE AIRPORT
CLARENDON, VERMONT
ADDITION TO FIRE/CRASH/ RESCUE BUILDING

P1

APPR:	DWD	DRAWN:	BWM/BML	SCALE:	AS NOTED	PROJ. NO.	0132-01

X:\0132\01\drawings\plumb\0132-P01.dwg, Layout1, 07/19/02 03:33:03 PM, © LANE ASSOCIATES CONSULTING ENGINEERS PC, 2002