


1 SECTION AT NEW DORMER
SCALE: 1/4" = 1'-0"




2 SOUTH BUILDING ELEVATION
SCALE: 1/4" = 1'-0"

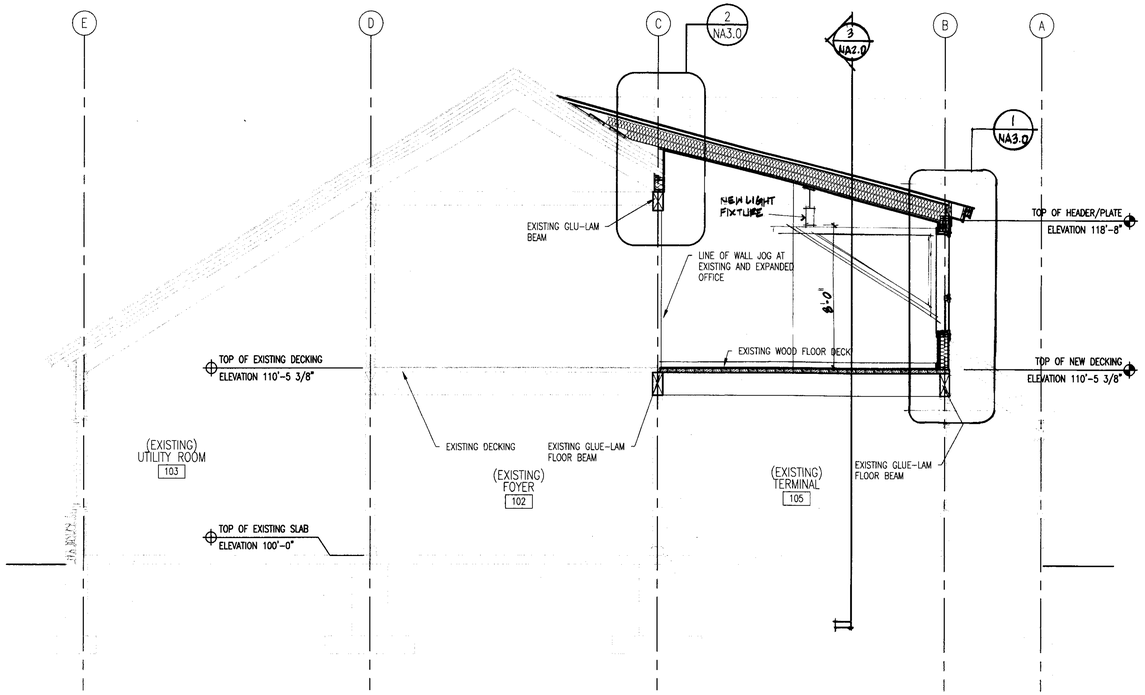


3 TRANSVERSE SECTION THROUGH DORMER
SCALE: 1/4" = 1'-0"

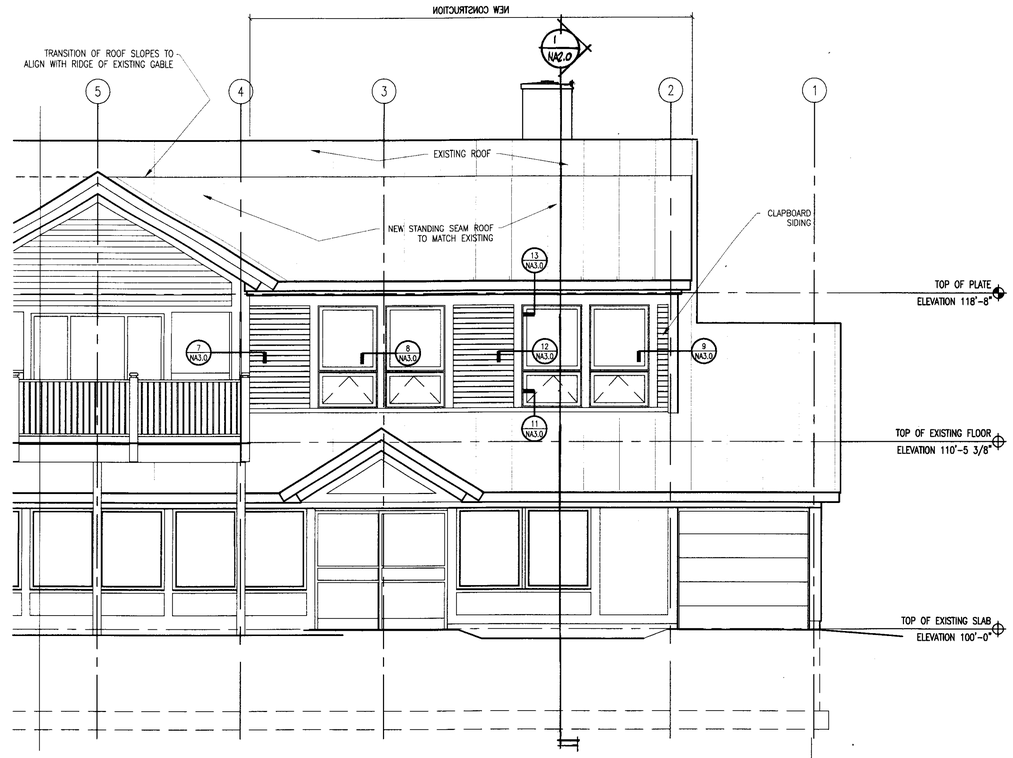


4 EAST BUILDING ELEVATION
SCALE: 1/4" = 1'-0"

LICENSED ARCHITECT
GREGG F. GOSSENS
No. 1367
STATE OF VERMONT

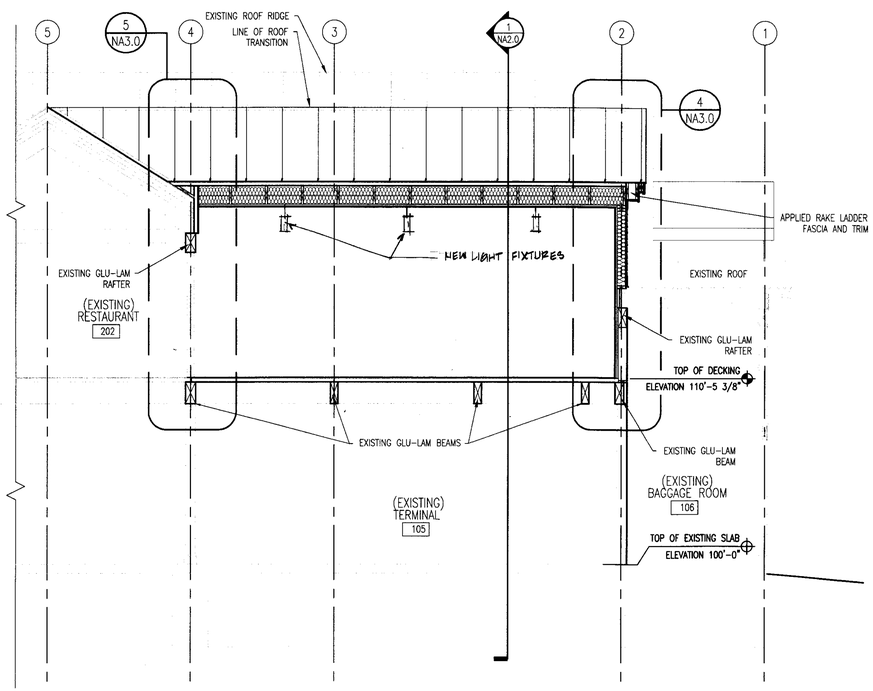GBA

GOSSENS BACHMAN ARCHITECTS

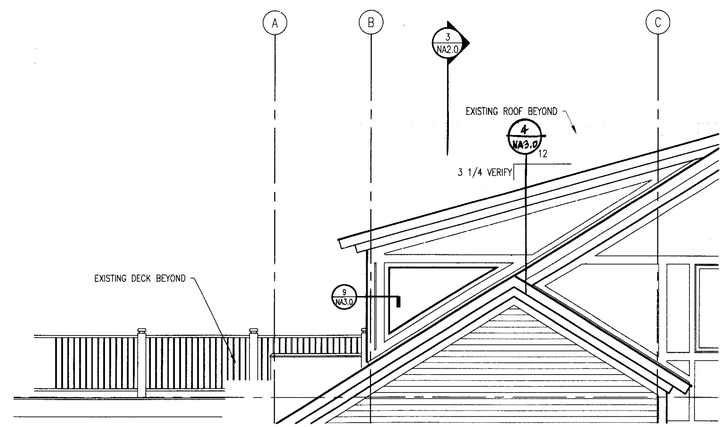85 Granite Shed Lane
Montpelier, Vermont 05602
P 802. 229. 1664 F 802. 229. 4822

STATE OF VERMONT
DEPARTMENT OF BUILDINGS AND GENERAL SERVICES
AGENCY OF ADMINISTRATION
MONTPELIER, VERMONT

# Rutland Airport

## New Terminal

Rutland, Vermont

Revisions:

| | |
|---|---|
| Job Number: | 0302-105 |
| File Name: | 0302-NTelev-sect.dwg |
| Scale: | As Noted |
| Date: | March, 2005 |

## ELEVATIONS/ SECTIONS

NA2.0

© Gossens Bachman, Inc.

Apr 01, 2005 12:15:11 pm J:\0302-105\drawings\0302-NTelev-sect.dwg