NOTE:
ALL ELECTRICAL CONDUITS & DUCTS SHALL BE FURNISHED & INSTALLED BY THE ELECTRICAL CONTRACTOR - INTERIOR & EXTERIOR DUCTS & CONDUITS. CHECK WITH GENERAL CONTRACTOR FOR DIGGING TRENCHES ETC. SEE SHEET #2.

ALL DUCTS NOT LESS THAN 2'-6" BELOW FINISH GRADE.
ELECTRICAL CONTRACTOR SHALL RELOCATE THE RUNWAY LIGHTS AS INDICATED & MAKE THE NECESSARY CONNECTION FOR THEIR CORRECT OPERATION.

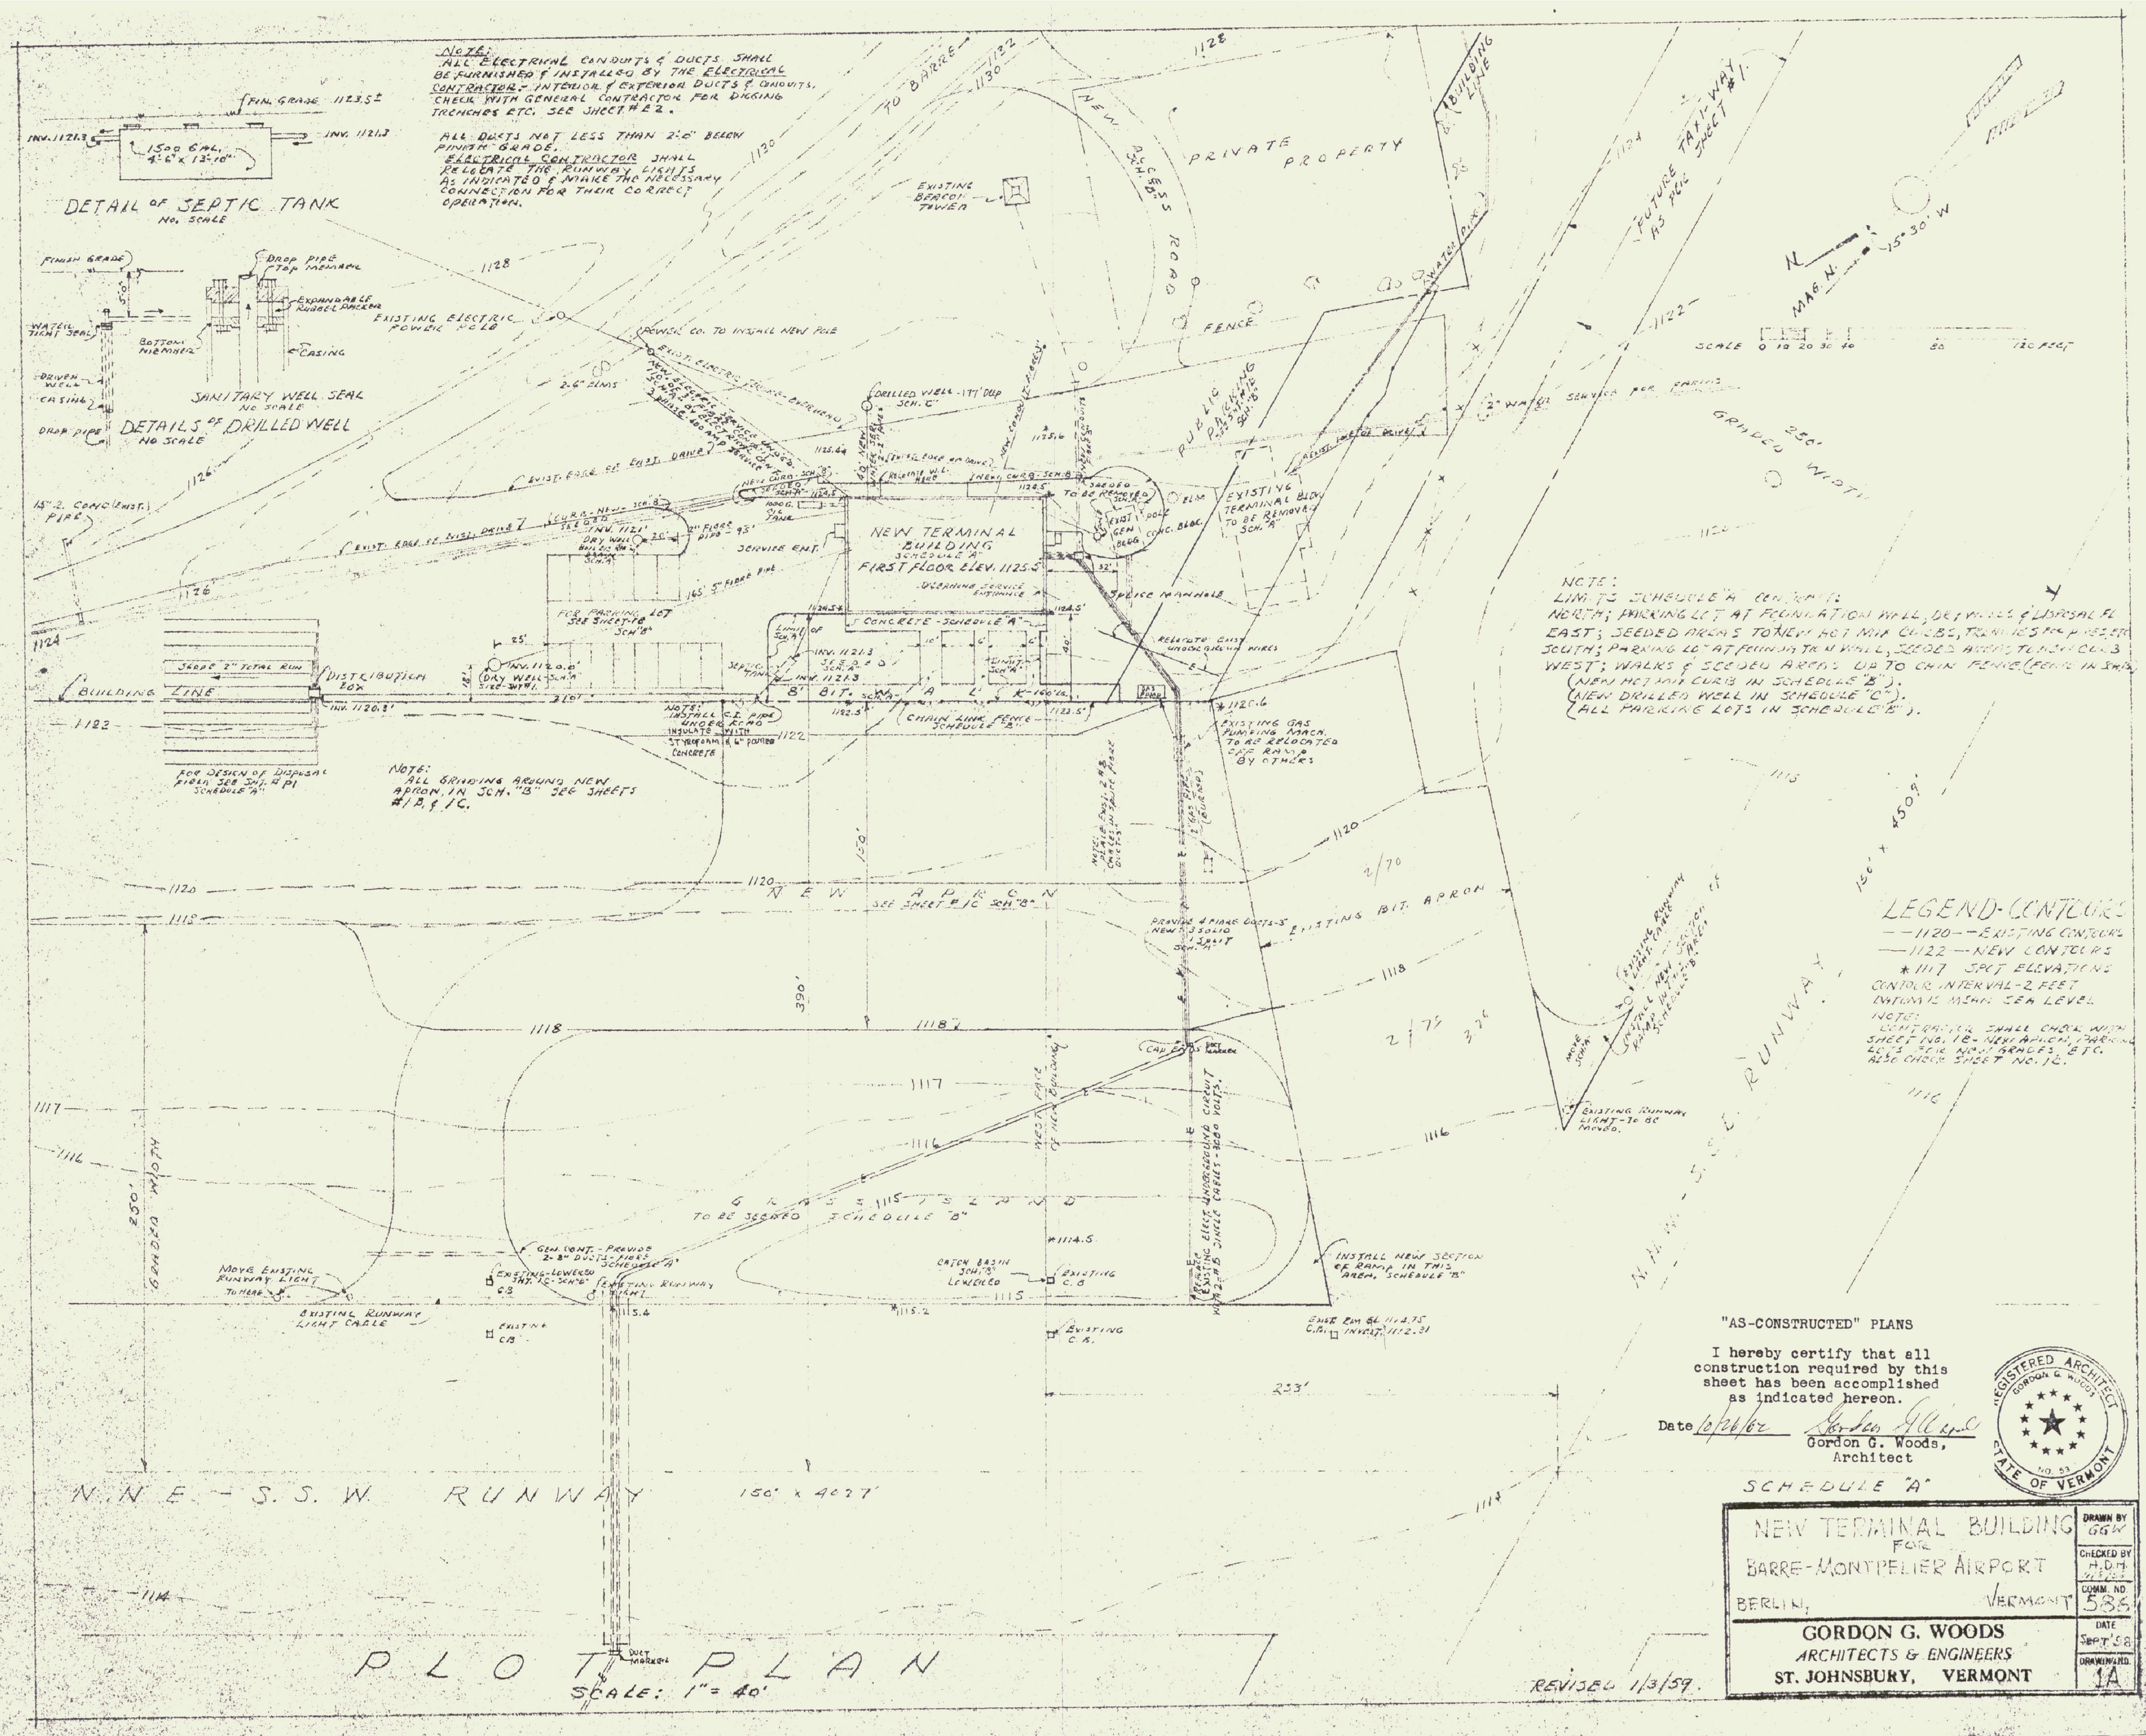

NOTE:
LIMITS SCHEDULE "A" CONSISTS:
NORTH; PARKING LOT AT FOUNDATION WALL; DETAILS & DISPOSAL FIELD
EAST; SEEDED AREAS TO NEW HOT MIX CURBS, TRANSITIONS FOR PIPES, ETC.
SOUTH; PARKING LOT AT FOUNDATION WALL, SEEDED AREAS TO NEW CURB
WEST; WALKS & SEEDED AREAS UP TO CHAIN FENCE (FENCE IN SCH. "B").
(NEW HOT MIX CURB IN SCHEDULE "B").
(NEW DRILLED WELL IN SCHEDULE "C").
(ALL PARKING LOTS IN SCHEDULE "B").

LEGEND-CONTOURS
--1120-- EXISTING CONTOURS
—1122— NEW CONTOURS
* 1117 SPOT ELEVATIONS
CONTOUR INTERVAL - 2 FEET
INFORMATION MSHN SEA LEVEL
NOTE:
CONTRACTOR SHALL CHECK WITH SHEET NO. 1B - NEW APRON, PARKING LOTS FOR NEW GRADES, ETC. ALSO CHECK SHEET NO. 1C.

"AS-CONSTRUCTED" PLANS

I hereby certify that all construction required by this sheet has been accomplished as indicated hereon.

Date 10 feb 62 Gordon G. Woods
Gordon G. Woods,
Architect

REGISTERED ARCHITECT GORDON G. WOODS NO. 53 STATE OF VERMONT

SCHEDULE "A"

NEW TERMINAL BUILDING FOR BARRE-MONTPELIER AIRPORT BERLIN, VERMONT	DRAWN BY GGW
	CHECKED BY H.D.M.
	COMM. NO. 586
GORDON G. WOODS ARCHITECTS & ENGINEERS ST. JOHNSBURY, VERMONT	DATE Sept '58
	DRAWING NO. 1A

PLOT PLAN
SCALE: 1" = 40'

REVISED 1/3/59.