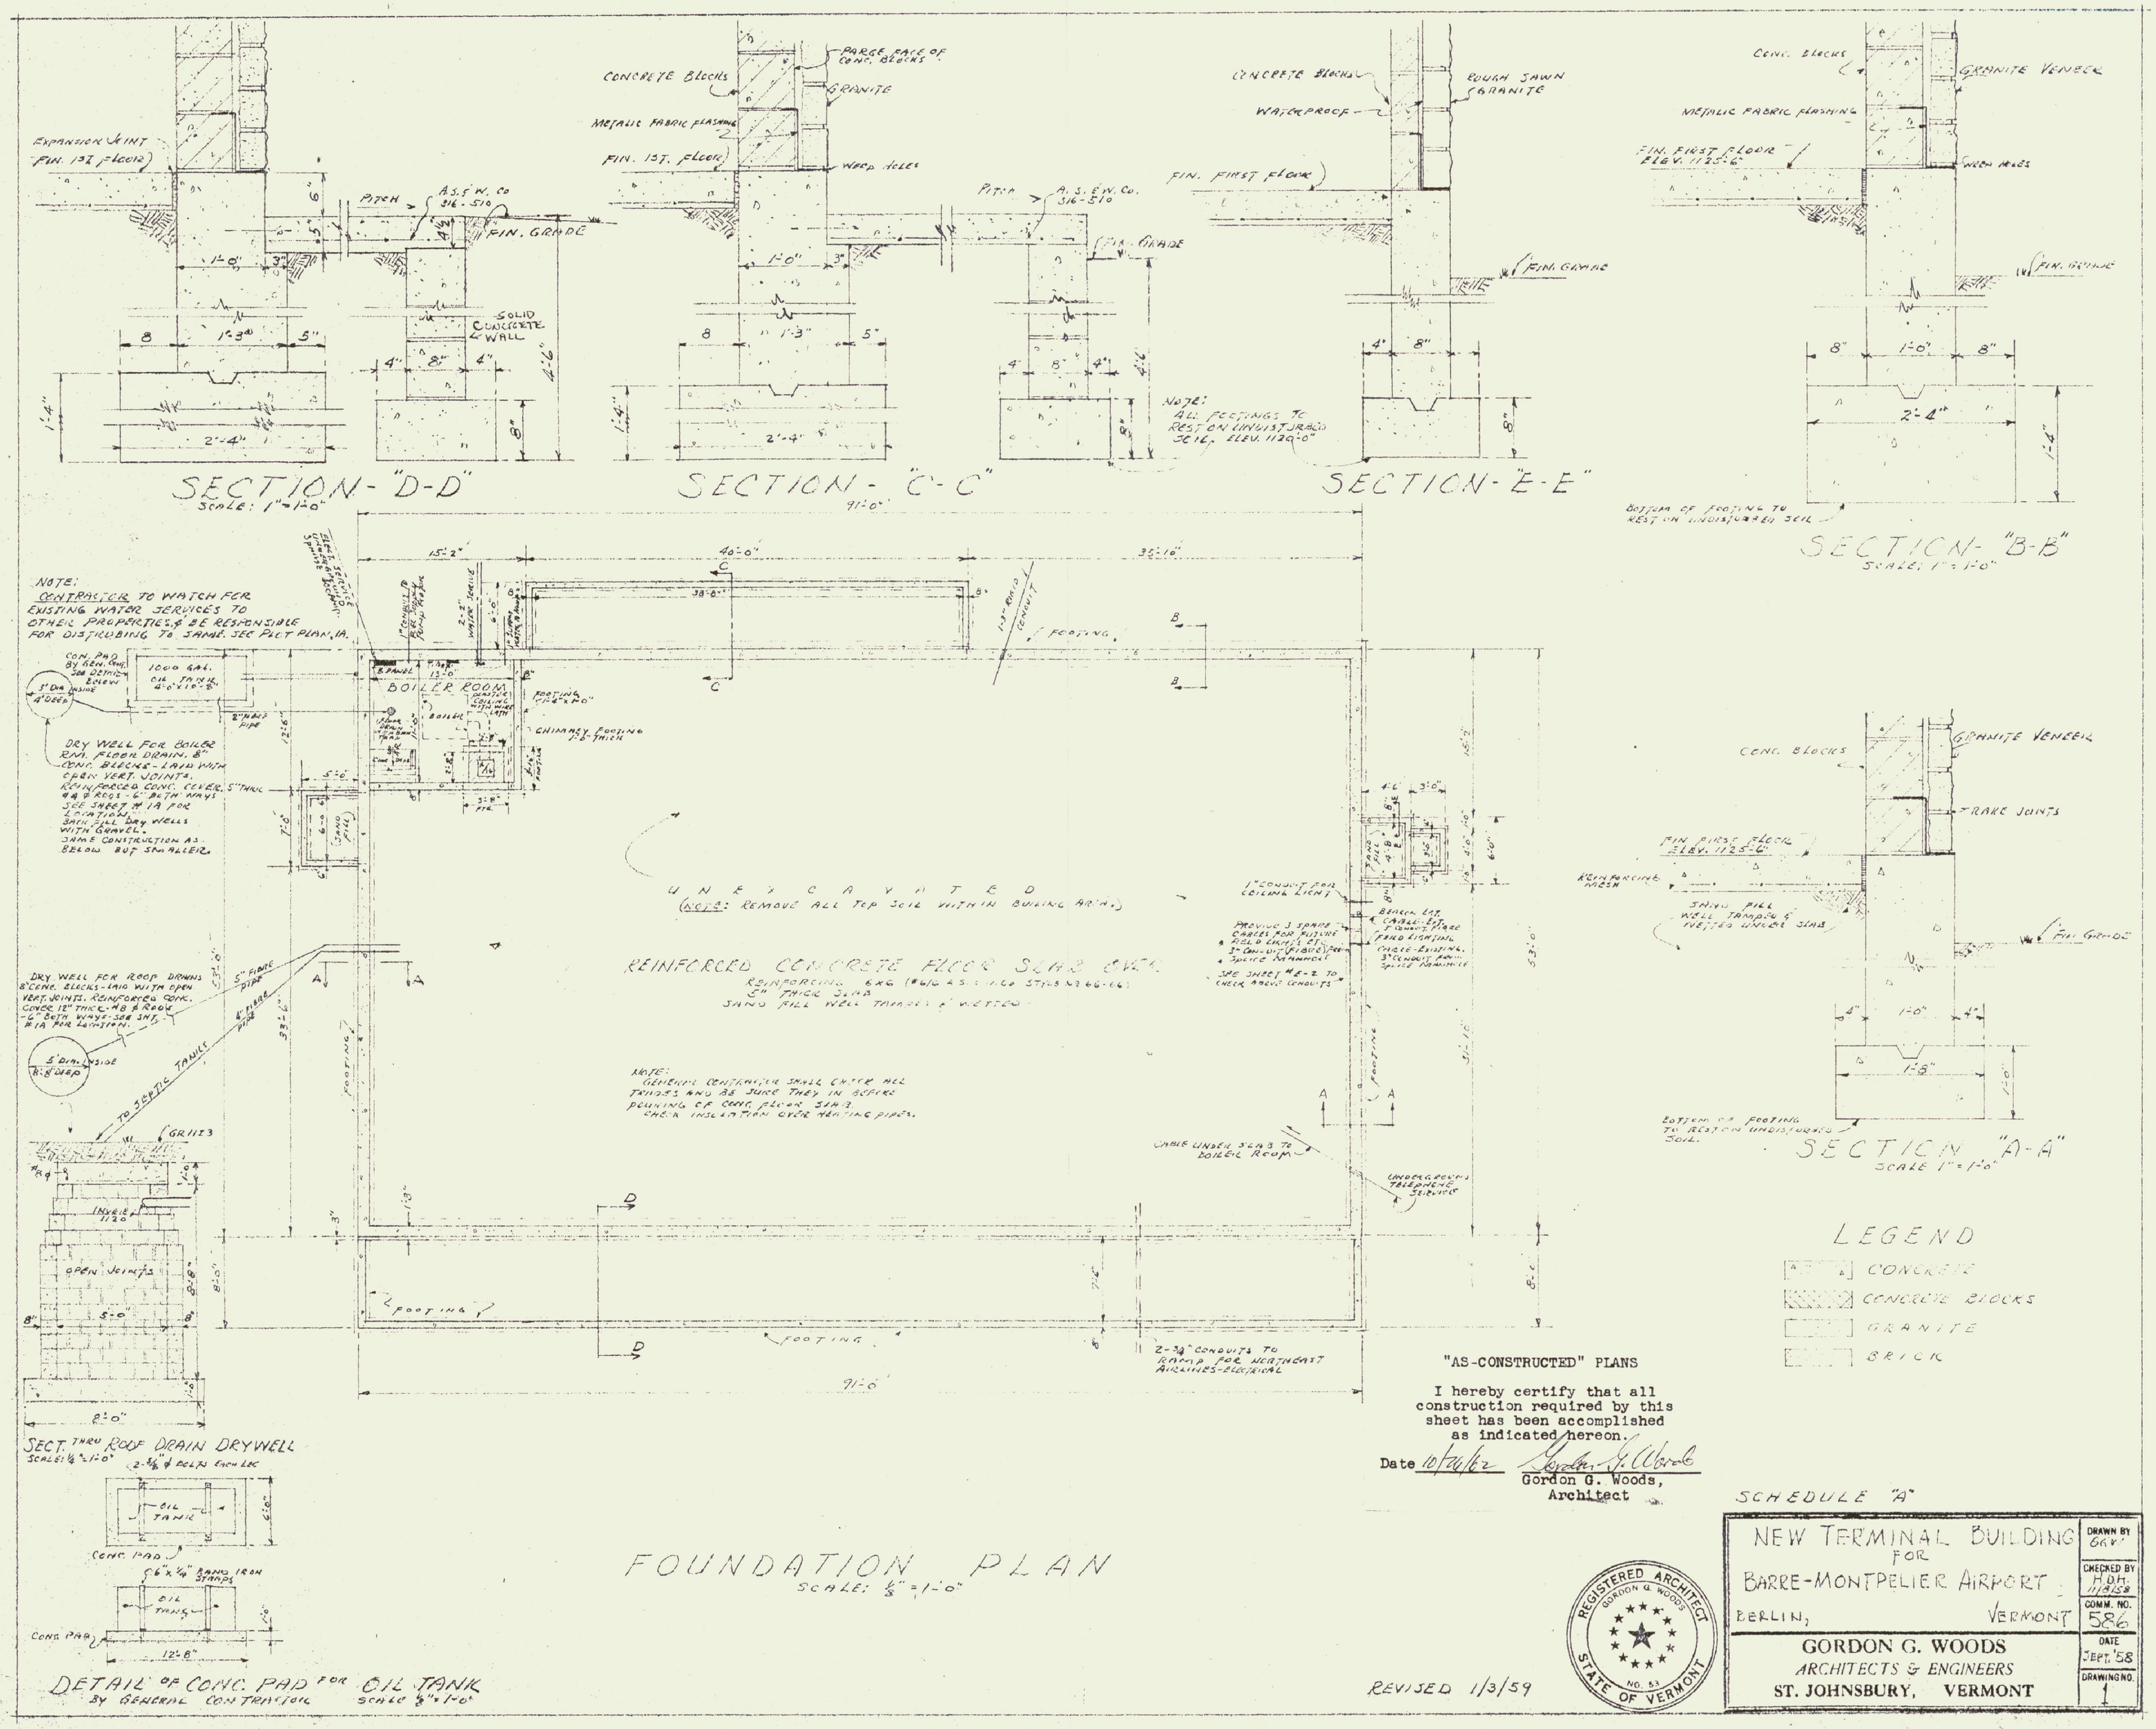

"AS-CONSTRUCTED" PLANS

I hereby certify that all construction required by this sheet has been accomplished as indicated hereon.

Date 10/26/62 Gordon G. Woods
Gordon G. Woods, Architect

SCHEDULE "A"

REGISTERED ARCHITECT GORDON G. WOODS NO. 53 STATE OF VERMONT

REVISED 1/3/59

NEW TERMINAL BUILDING FOR BARRE-MONTPELIER AIRPORT, BERLIN, VERMONT	DRAWN BY GGW
	CHECKED BY H.D.H. 11/14/58
	COMM. NO. 586
GORDON G. WOODS ARCHITECTS & ENGINEERS ST. JOHNSBURY, VERMONT	DATE SEPT. '58
	DRAWING NO. 1