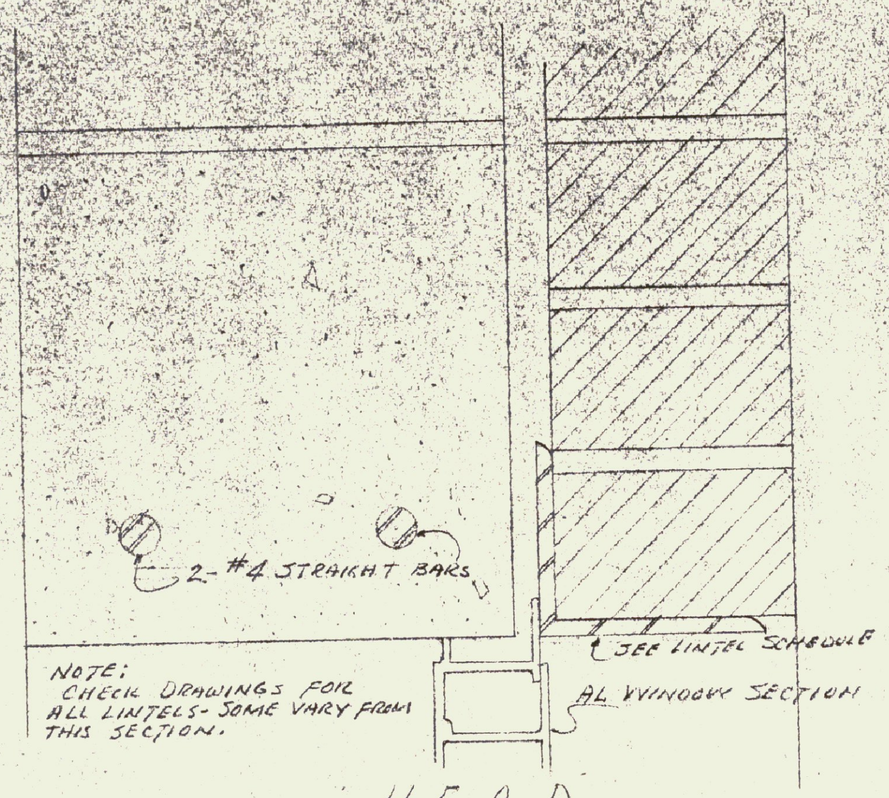

HEAD

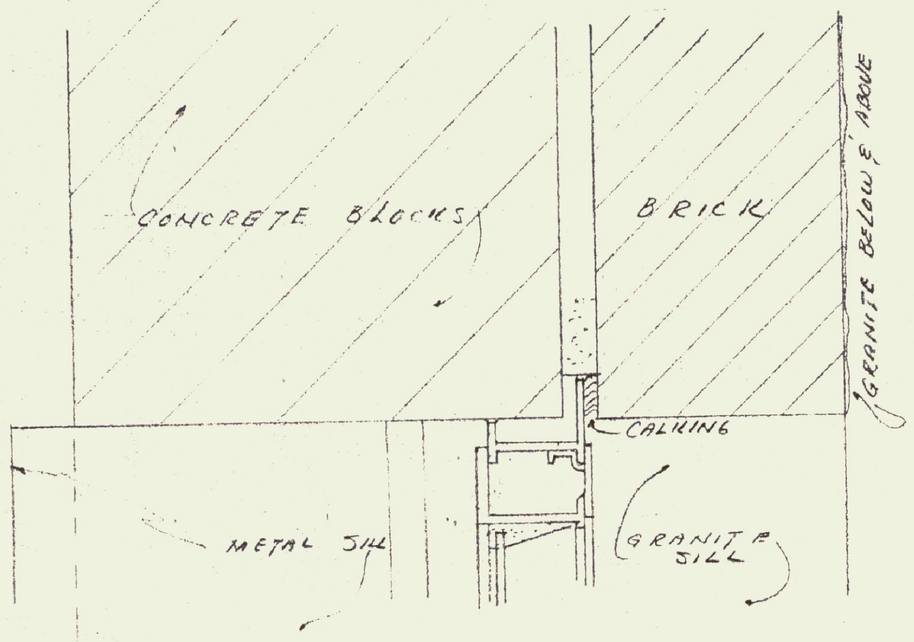

JAMB

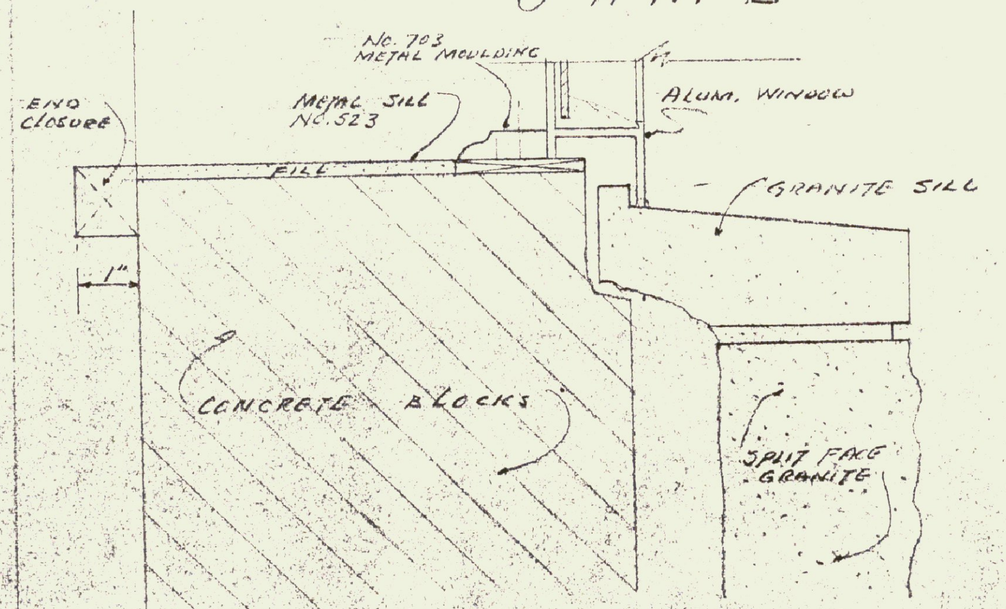

SILL

SECTION THRU ALUM. WINDOWS
SCALE: HALF SIZE

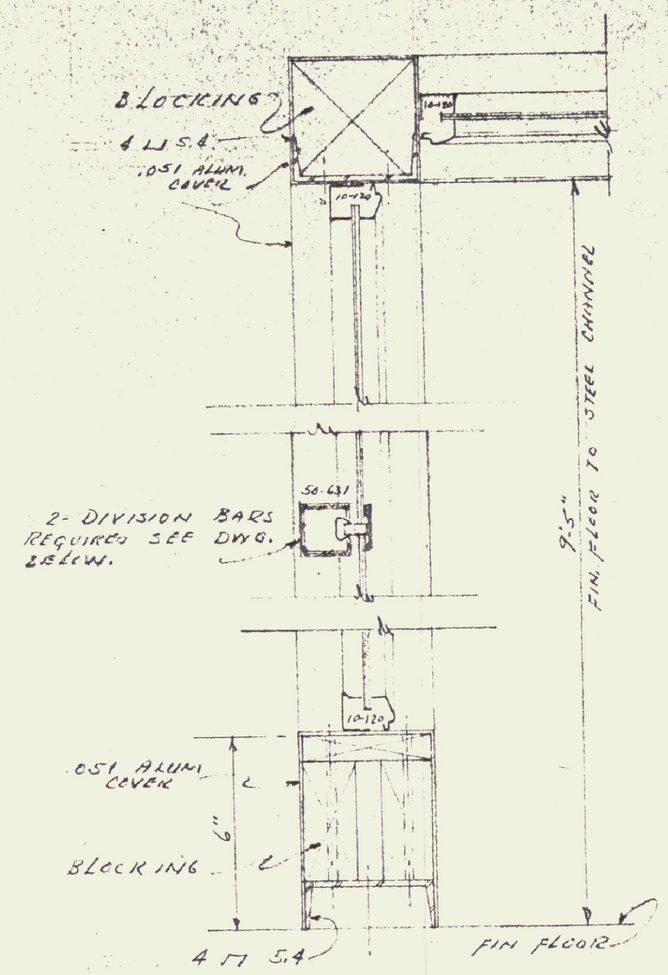

SECTION THRU HEAD, DIV BARS & SILL OF ENT. VESTIBULE
SCALE: ONE QUARTER SIZE

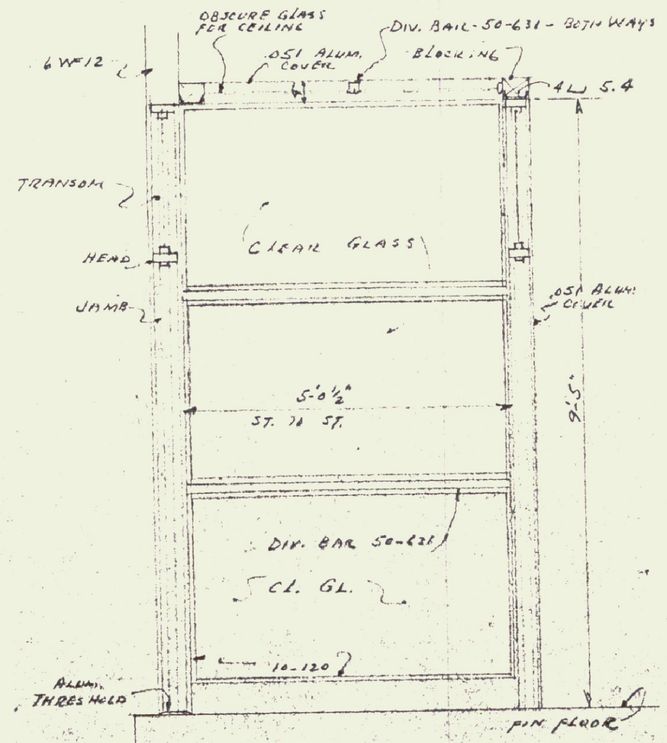

ELEV. OF LEFT SIDE OF VEST.
SCALE: ½" = 1'-0"

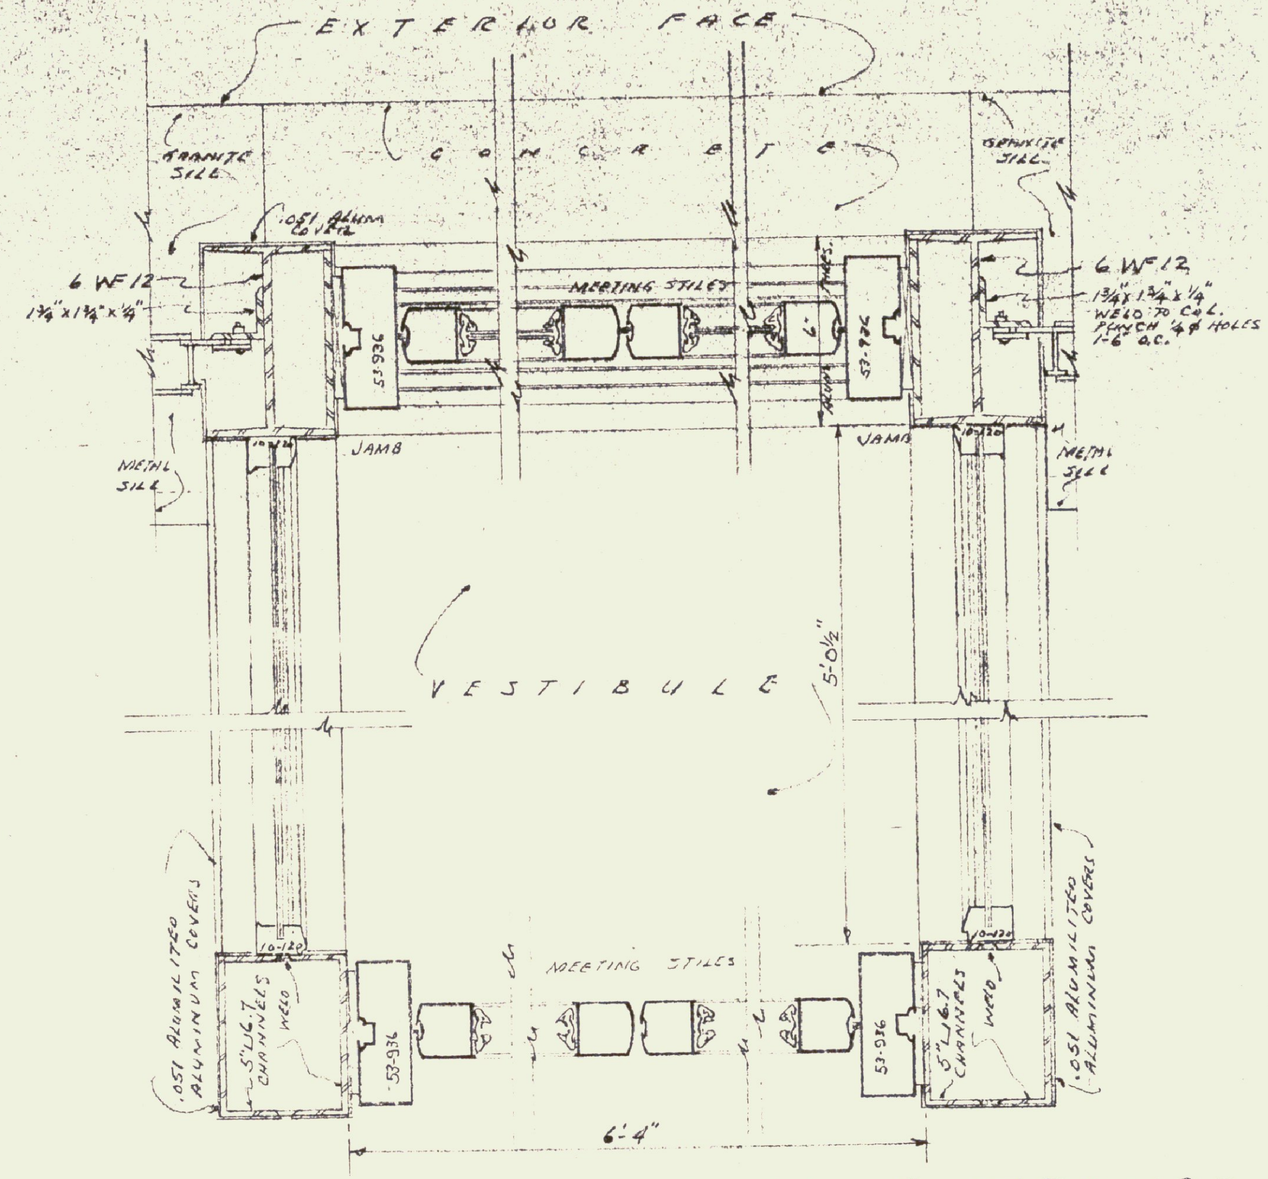

SECTION THRU PUBLIC ENTRANCE & VESTIBULE RUNWAY SIDE
SCALE: ONE QUARTER SIZE

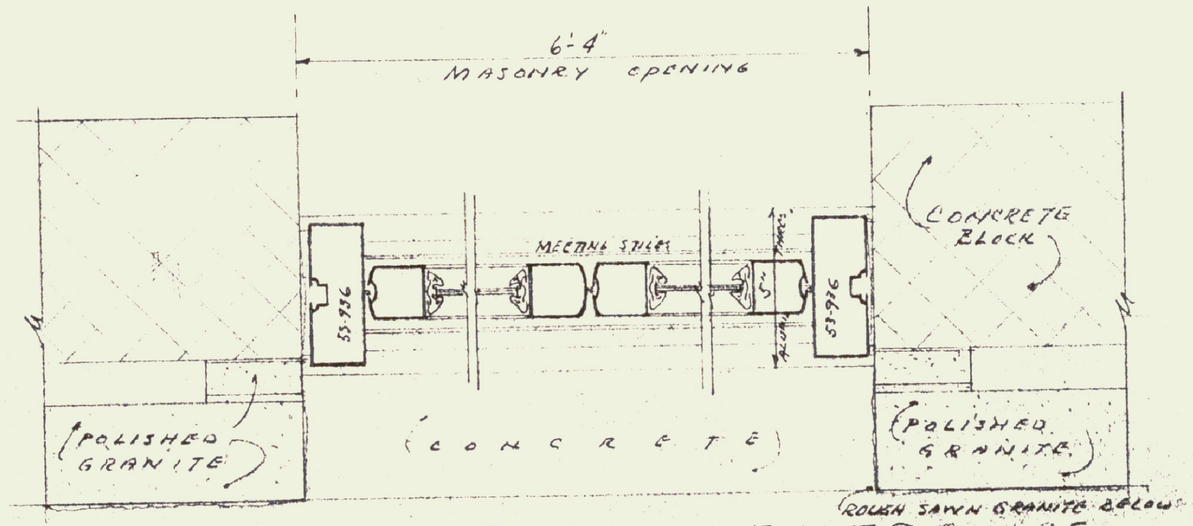

SECTION THRU PUBLIC ENTRANCE STREET SIDE
SCALE: ONE QUARTER SIZE

"AS-CONSTRUCTED" PLANS

I hereby certify that all construction required by this sheet has been accomplished as indicated hereon.

Date 10/26/62 Gordon G. Woods

Gordon G. Woods,
Architect

REGISTERED ARCHITECT
GORDON G. WOODS
NO. 53
STATE OF VERMONT

SCHEDULE "A"

NEW TERMINAL BUILDING
FOR
BARRE-MONTPELIER AIRPORT
BERLIN, VERMONT

GORDON G. WOODS
ARCHITECTS & ENGINEERS
ST. JOHNSBURY, VERMONT

DRAWN BY	DM GGW
CHECKED BY	HBM 11/8/62
COMM. NO.	586
DATE	Sept. 58
DRAWING NO.	6