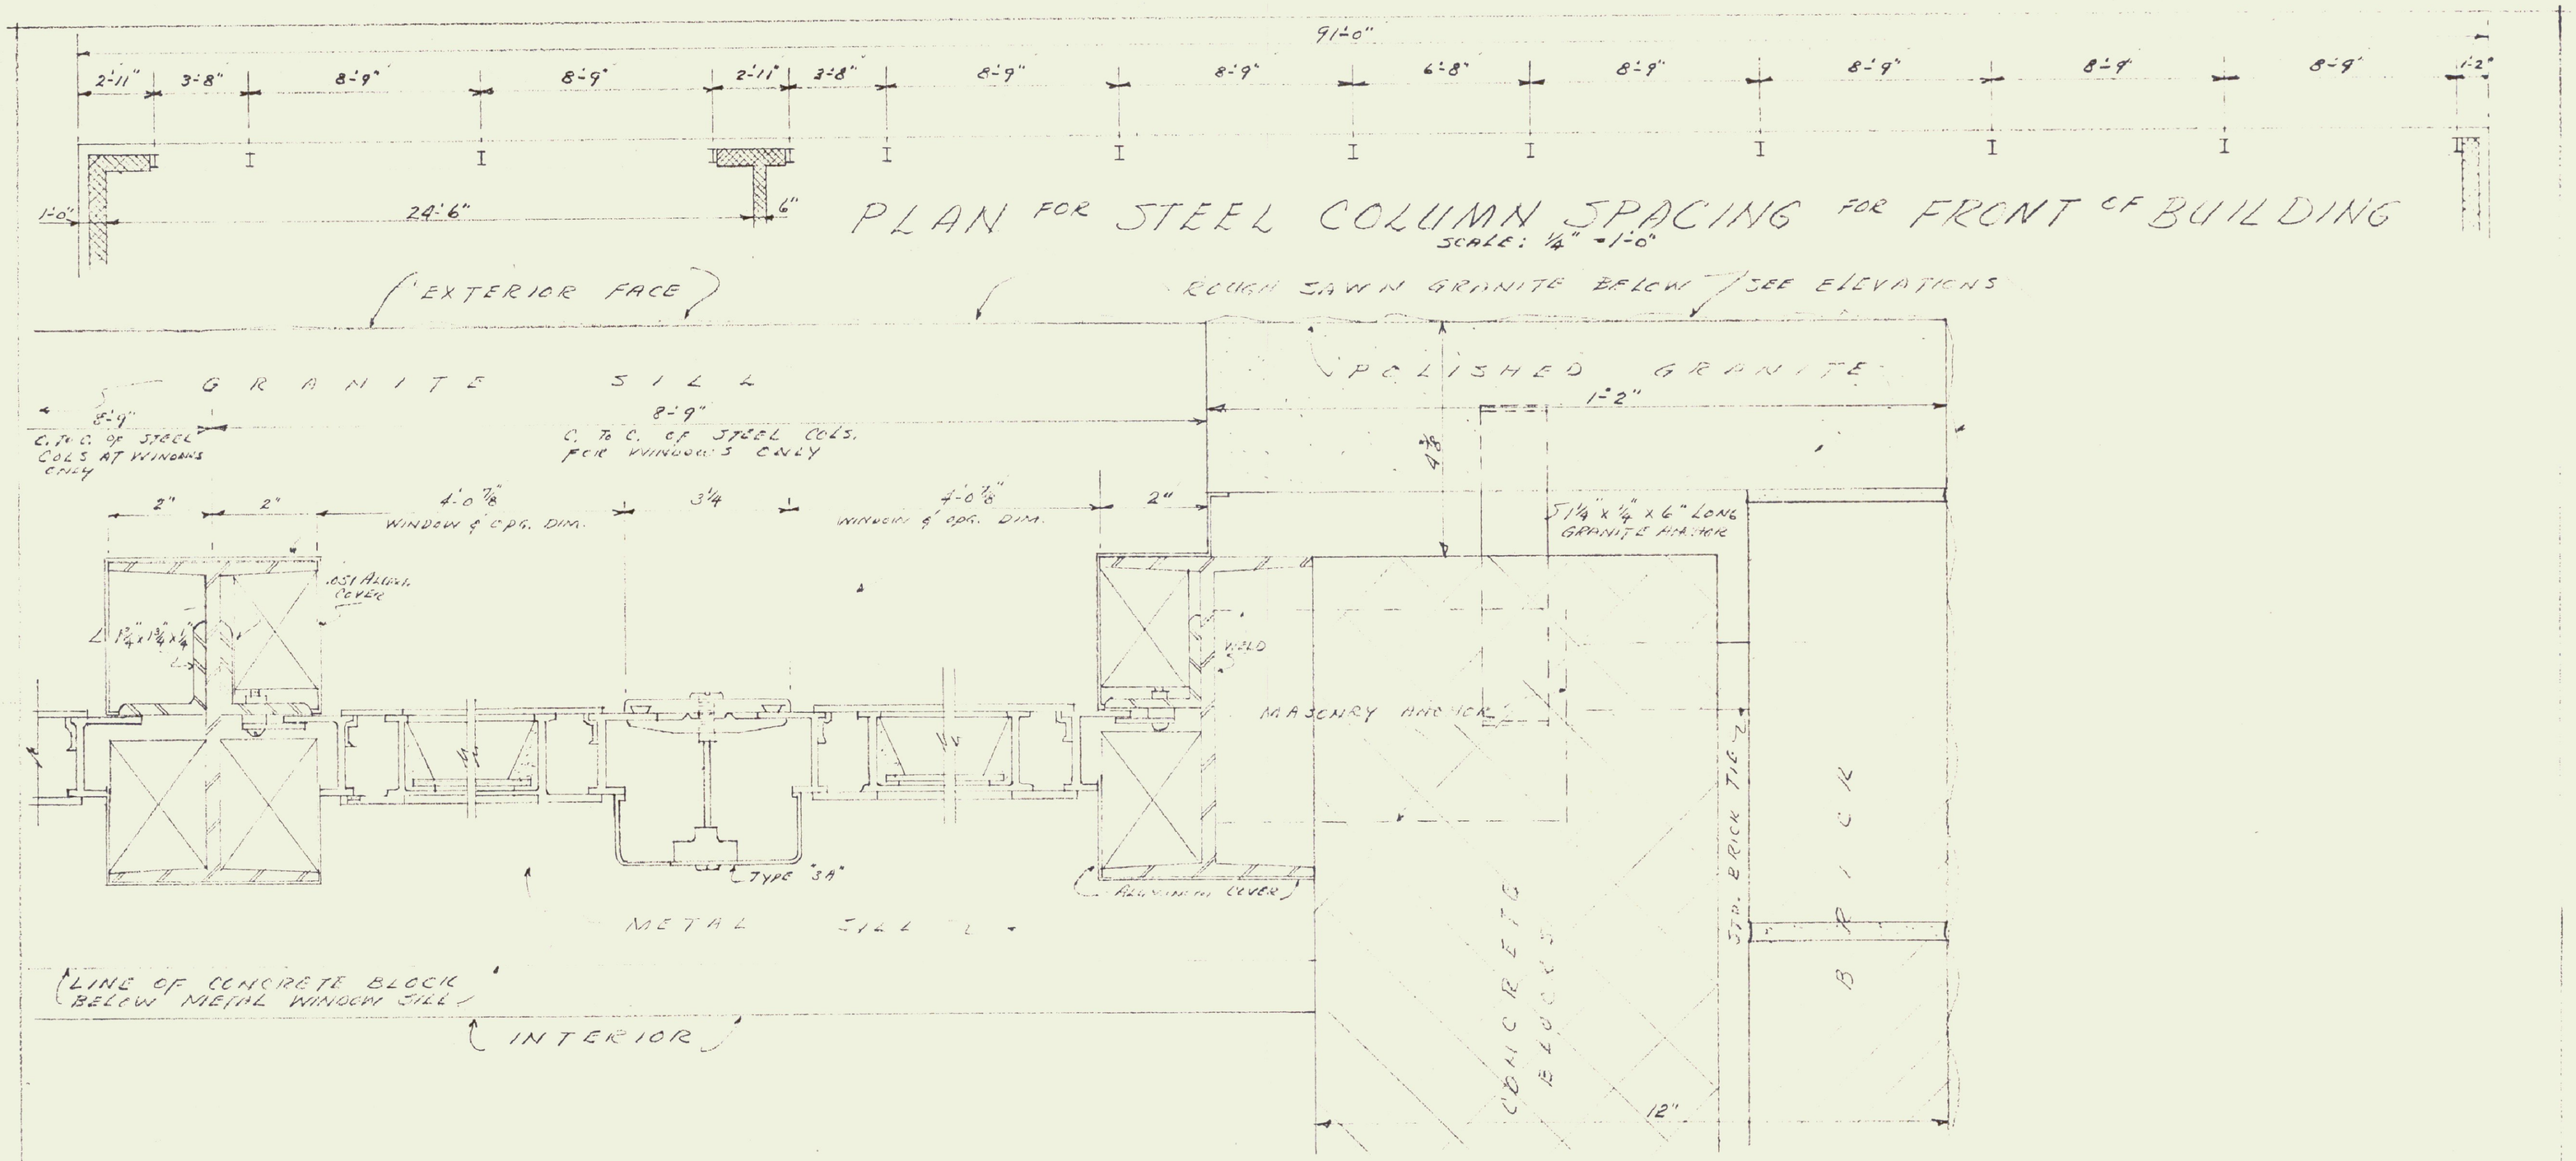

SECTION THRU STEEL COLS, ALUM. WINDOWS, MULLIONS & N.E. CORNER OF BUILDING
SCALE: HALF SIZE

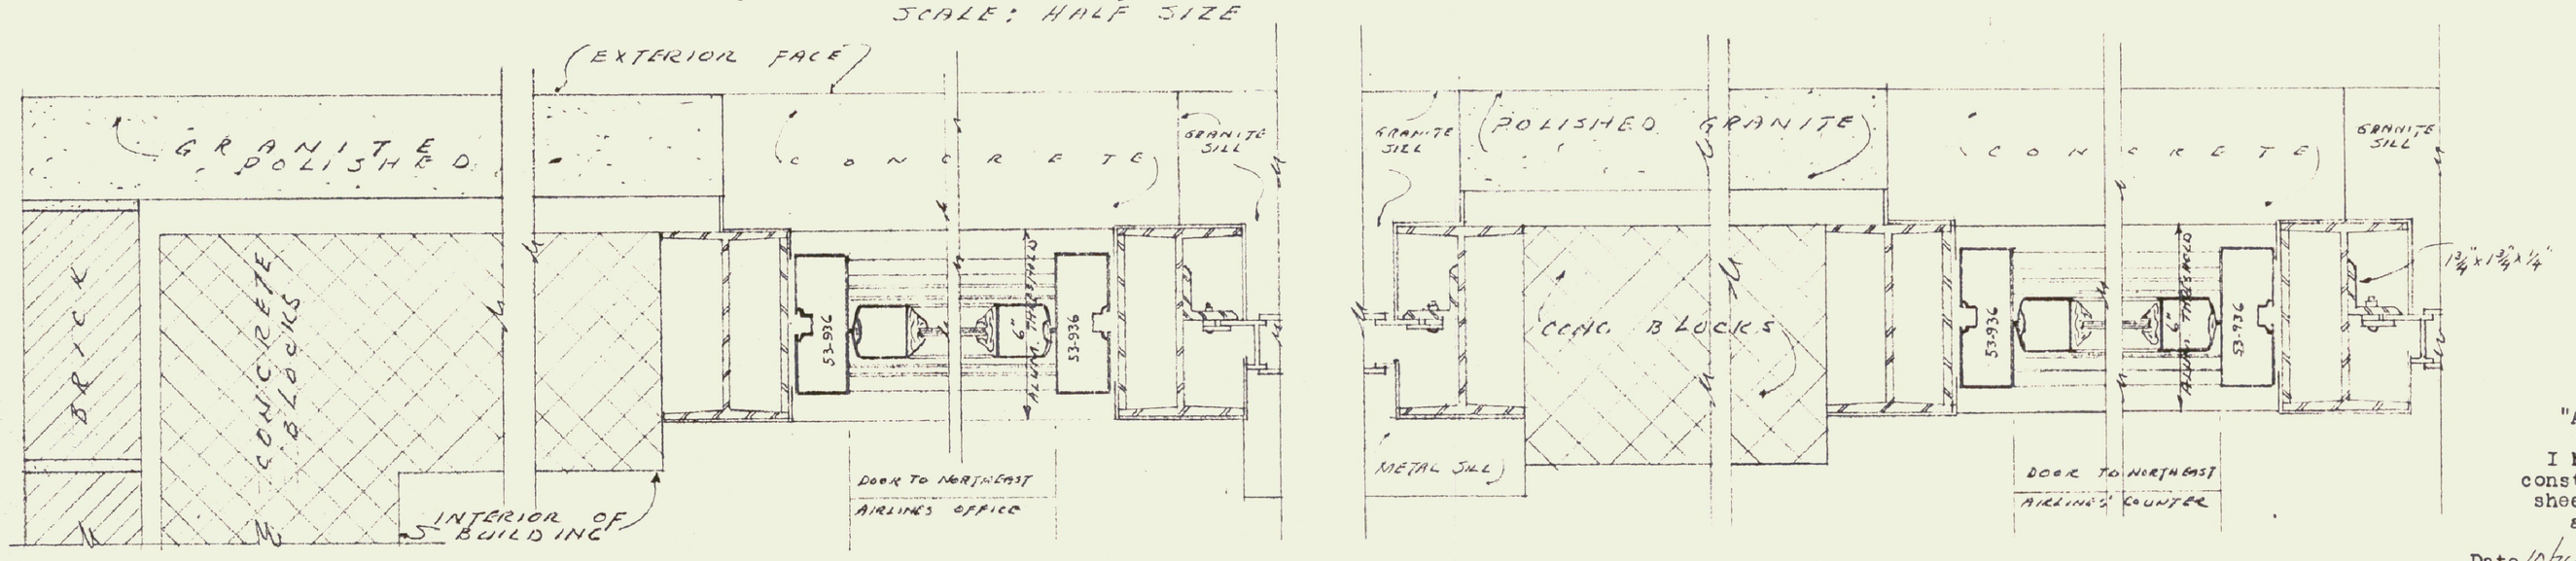

SECTION THRU N-W CORNER OF BUILDING, ALUM. DOOR, WINDOWS & DOOR
SCALE: ONE QUARTER SIZE

"AS-CONSTRUCTED" PLANS

I hereby certify that all construction required by this sheet has been accomplished as indicated hereon.

Date 10/24/62 Gordon G. Woods
Gordon G. Woods, Architect

SCHEDULE "A"

REGISTERED ARCHITECT GORDON G. WOODS NO. 53 STATE OF VERMONT

NEW TERMINAL BUILDING FOR BARRE-MONTPELIER AIRPORT BERLIN, VERMONT	DRAWN BY GGW
	CHECKED BY HDH 9/8/58
	COMM. NO. 586
GORDON G. WOODS ARCHITECTS & ENGINEERS ST. JOHNSBURY, VERMONT	DATE SEPT. 58
	DRAWING NO. 7