Frame Member Schedule

Mem.	Part	Width	Thick.	Webthk	Depth1	Depth2	Approx. Lgth
1	CX003	5"	.2500	.1345	8"	2'-4"	10'-11 5/8"
2	RBX001	5"	.2500	.1345	2'-0"	9"	18'-9 7/8"
3	RBX002	5"	.2500	.1345	9"	2'-0"	18'-9 7/8"
4	CX004	5"	.2500	.1345	8"	2'-4"	10'-11 5/8"

Denoted with circle

A325 Bolt Connection & Plate Schedule

Id	Qty	Bolt Dia.	Bolt Length	Plate Thick.	Rows Out	Rows In	Tension Bolt	Washer
A	10	3/4"	2"	1/2"	3	2		
B	4	3/4"	2"	1/2"	1	1		
C	12	3/4"	2"	1/2"	3	3		

Denoted with hexagon

Frame Clearances

Horiz. Clearance between members 1 and 4: 31'-0 3/4"
Vert. Clearance at member 1: 13'-11 5/8"
Vert. Clearance at member 4: 13'-11 5/8"
Finished Floor Elevation = 0'-0" (Unless Noted Otherwise)

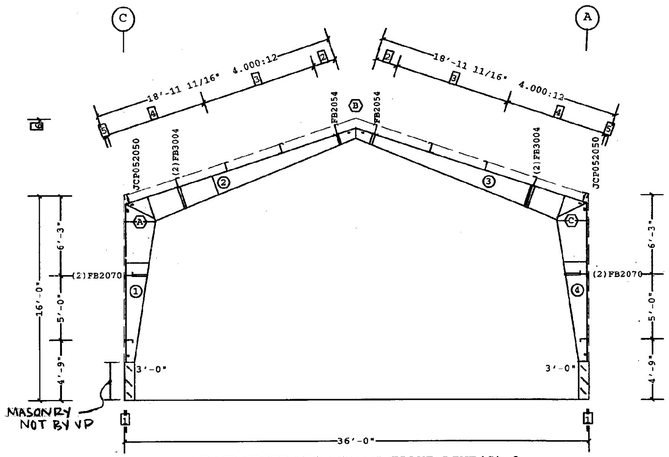

FRAME CROSS SECTION AT FRAME LINE(S) 2

Dimension Key

[1] 1 5/8"
[2] 1'-8 13/16"
[3] 2 @ 4'-6"
[4] 2 @ 3'-11 7/8"
[5] 3 1/16"
[6] 22'-0"

Denoted with rectangle

STATE OF VERMONT
STEVEN J. OAKESON
NO. 7548
STRUCTURAL I
LICENSED PROFESSIONAL ENGINEER

10-24-00

VP REF., Shape Name - Storage along Wall 4, Frame 2

W.J.C. 10-24-00

1. USE 1/2 DIA. A325 BOLTS FOR PURLIN TO FRAME, GIRT TO FRAME, AND GIRT TO CLIP CONNECTIONS UNLESS NOTED OTHERWISE. SEE JOB DETAILS FOR BOLT LENGTHS.

THE VP ENGINEER'S SEAL APPLIES ONLY TO THE WORK PRODUCT OF VP AND DESIGN AND PERFORMANCE REQUIREMENTS SPECIFIED BY VP. THE VP ENGINEER'S SEAL DOES NOT APPLY TO THE PERFORMANCE OR DESIGN OF ANY OTHER PRODUCT OR COMPONENT FURNISHED BY VP EXCEPT TO ANY DESIGN OR PERFORMANCE REQUIREMENTS SPECIFIED BY VP.

Building Code: 96BOCA
Live Load: (Not Reducible) 20.00 psf
Coll. Load:Gravity 4.00, Uplift 0.00 psf
Wind Speed: 76.00 mph
Wind Exposure: C
Ground Snow: 70.60 , Roof Snow: 49.00 psf
Snow Exposure Category: 3
Seismic Hazard Group: Group 1
Building Use:Standard Occupancy Structures

THIS DRAWING, INCLUDING THE INFORMATION HEREON, REMAINS THE PROPERTY OF VP BUILDINGS.

IT IS PROVIDED SOLELY FOR REVIEW THE BUILDING DRAWINGS IN THE APPLICABLE PROGRAM CODES AND STANDARDS. IT IS NOT TO BE USED FOR BIDDING OR FOR ANY OTHER PURPOSE WITHOUT PRIOR WRITTEN APPROVAL OF VP BUILDINGS.

THE GENERAL CONTRACTOR AND/OR ERECTOR IS SOLELY RESPONSIBLE FOR ACCURATE, GOOD QUALITY WORKMANSHIP IN ERECTING THIS BUILDING IN ACCORDANCE WITH THESE DRAWINGS. ERECTION IS TO BE WITH SOUND AND ALL APPLICABLE VP ERECTION METHODS.
ANY INCORRECT ERECTION FOUNDATION OR OTHER DEFICIENCIES, INCLUDING THE CURRENT USE OF PERMANENT BRACING.

FOR CONSTRUCTION

TYP.	DATE	BY	DESCRIPTION

NTS

FRAME CROSS SECTION AT FRAME LINE(S) 2

BUYLINE	E.F. Wall & Associates, Inc.
CUSTOMER	Morrisville/Stowe State Airport
LOCATION	Morrisville, Vermont
PROJECT	Morrisville/Stowe State Airport
DEPARTMENT	WI0012201-01 OE1
FILENAME	WI0012201-01OE1.vpc

VP BUILDINGS
DATE 10/22/00
TIME 12:00:00
DRAWN/CHECK JDP
PAGE 20F20
VPC VERSION 2.0