


LEGEND

- EXISTING AVIATION BUILDINGS
- EXISTING NON-AVIATION RELATED BUILDINGS

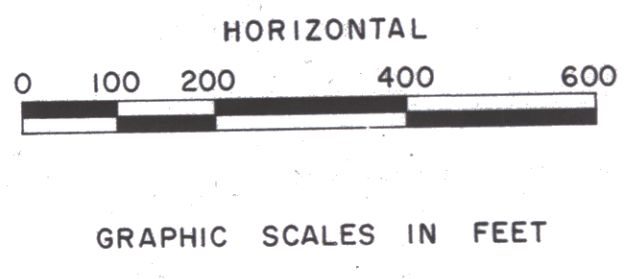

NO.	DESCRIPTION	BY	DATE
1	HANGAR ADDITIONS	SDS	10/93
2	HANGAR ADDITIONS	SDS	1/93
3	ASOS INSTRUMENTS	SDS	12/92
4	NO.	DESCRIPTION	BY

MORRISVILLE/STOWE STATE AIRPORT
MORRISVILLE, VERMONT

AIRPORT MASTER PLAN

RUNWAY PLAN & PROFILE

GERALD D'AMICO, P.E.
RIST-FROST ASSOCIATES, P.C.
CONSULTING ENGINEERS

ROXBURY, VERMONT 05669
LACONIA, NEW HAMPSHIRE
GLENS FALLS, NEW YORK

DRAWN BY PT. McLAUGHLIN	ENGR. CHK.
SCALE 1" = 200'	TRADE COORD. CHK.
DATE MAY, 1990	TECH. MGR.
PROJECT NO. SR-1742	PROJ. MGR.
FILE NO. 2742	
DRAWING NO. 6	
SHEET 6 OF 8	REV. NO.