




VICINITY MAP  
1" = 1 MILE

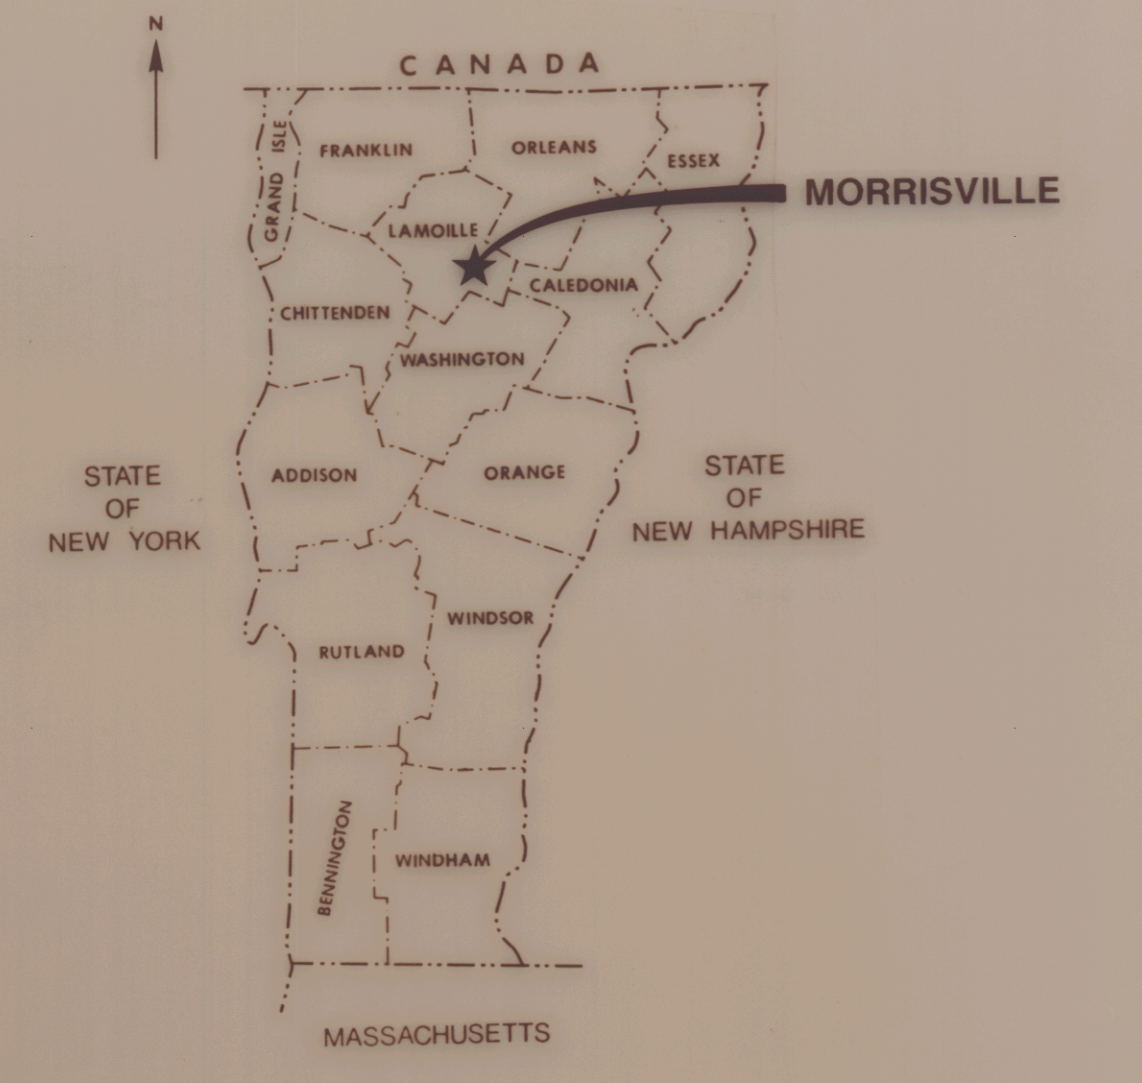

LOCATION MAP  
NOT TO SCALE

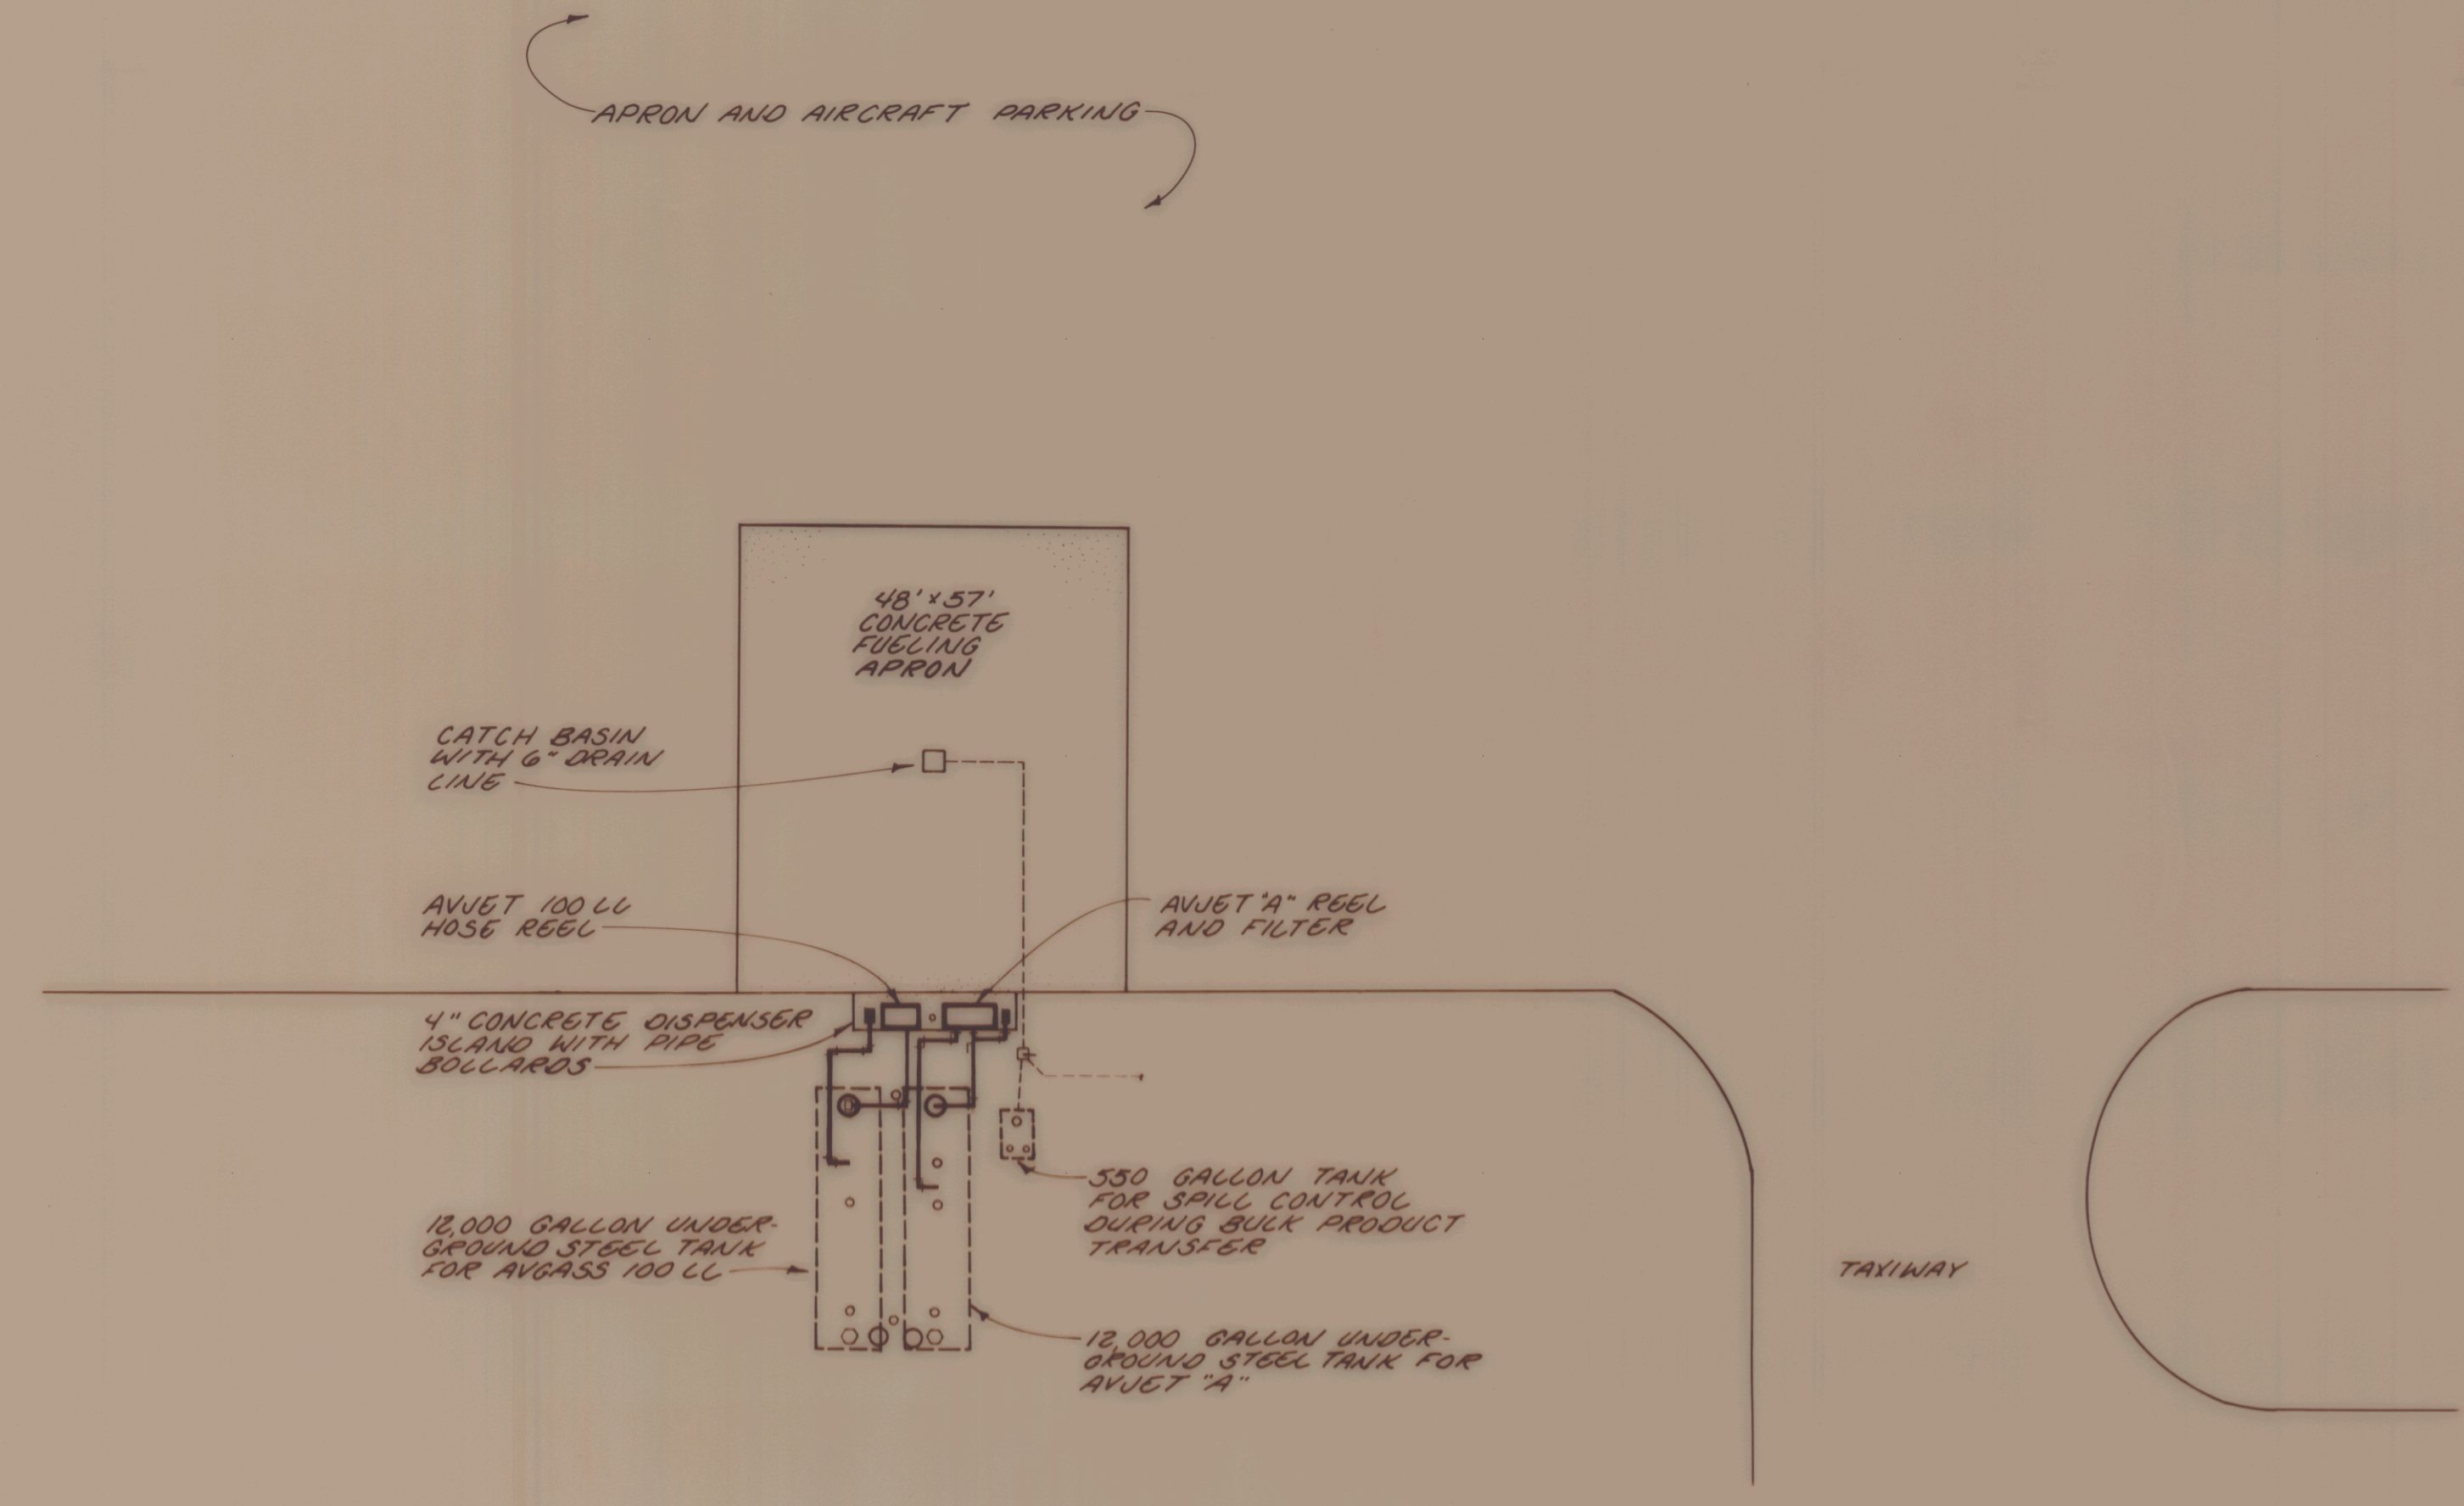

SITE PLAN  
1" = 20'

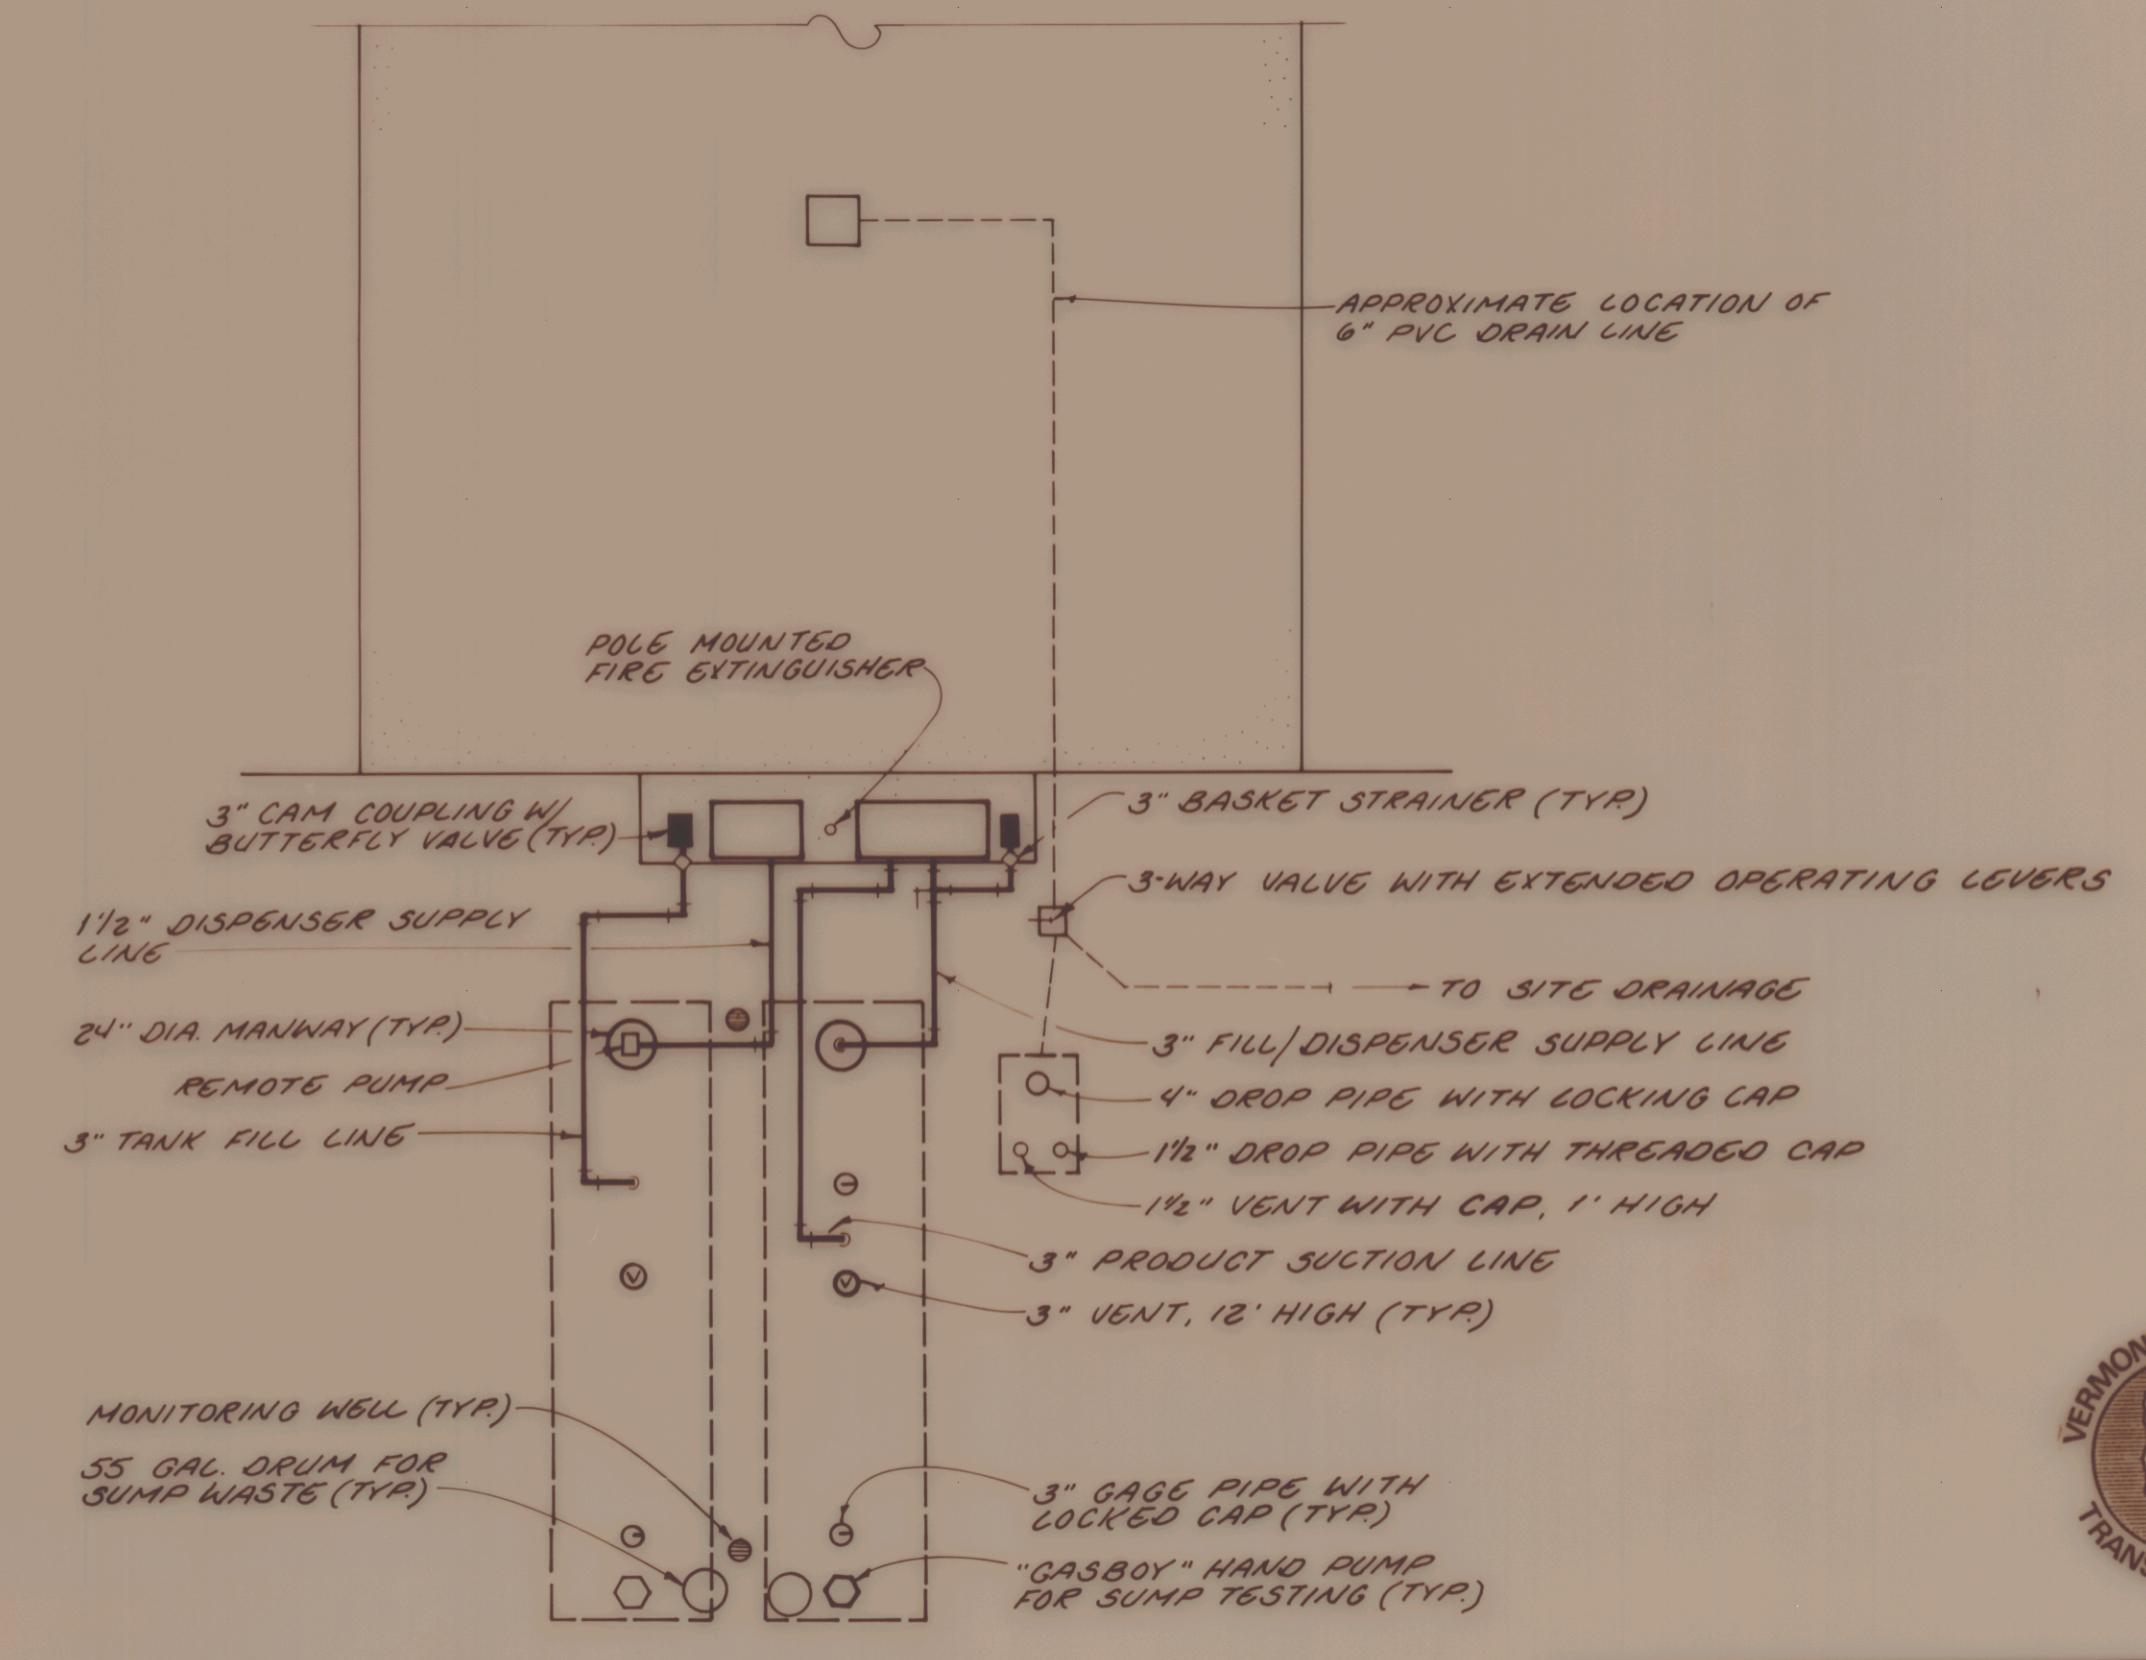

DETAIL - FUEL SYSTEM  
1" = 10'



NOTE: THIS DRAWING REPRESENTS EXISTING FEATURES ON THE DATE OF THE SITE INSPECTION BY DUFRESNE-HENRY. IT IS A COMPILATION DRAWING BASED ON INFORMATION PROVIDED BY THE VERMONT AGENCY OF TRANSPORTATION, THE SYSTEM OPERATOR, AND VERIFIED BY FIELD INSPECTION.

Rev.	Description	By	Date

VERMONT AGENCY OF TRANSPORTATION  
FUEL SYSTEM STUDY  
MORRISVILLE-STOWE STATE AIRPORT

MORRISVILLE, VERMONT

<p><b>Dufresne-Henry Inc.</b> Precision First No. Springfield, Vermont 05150</p>	Client No.	217016	
	Proj. Manager	T.S. REEVES	
	Proj. Designer	T.S. REEVES	
	Drawn By	W. HAZLETT	
	Checked By	P.N. ANDREWS	
	Scale	AS SHOWN	
Approved		Sheet 8 of 11	
Date		D 11,173	