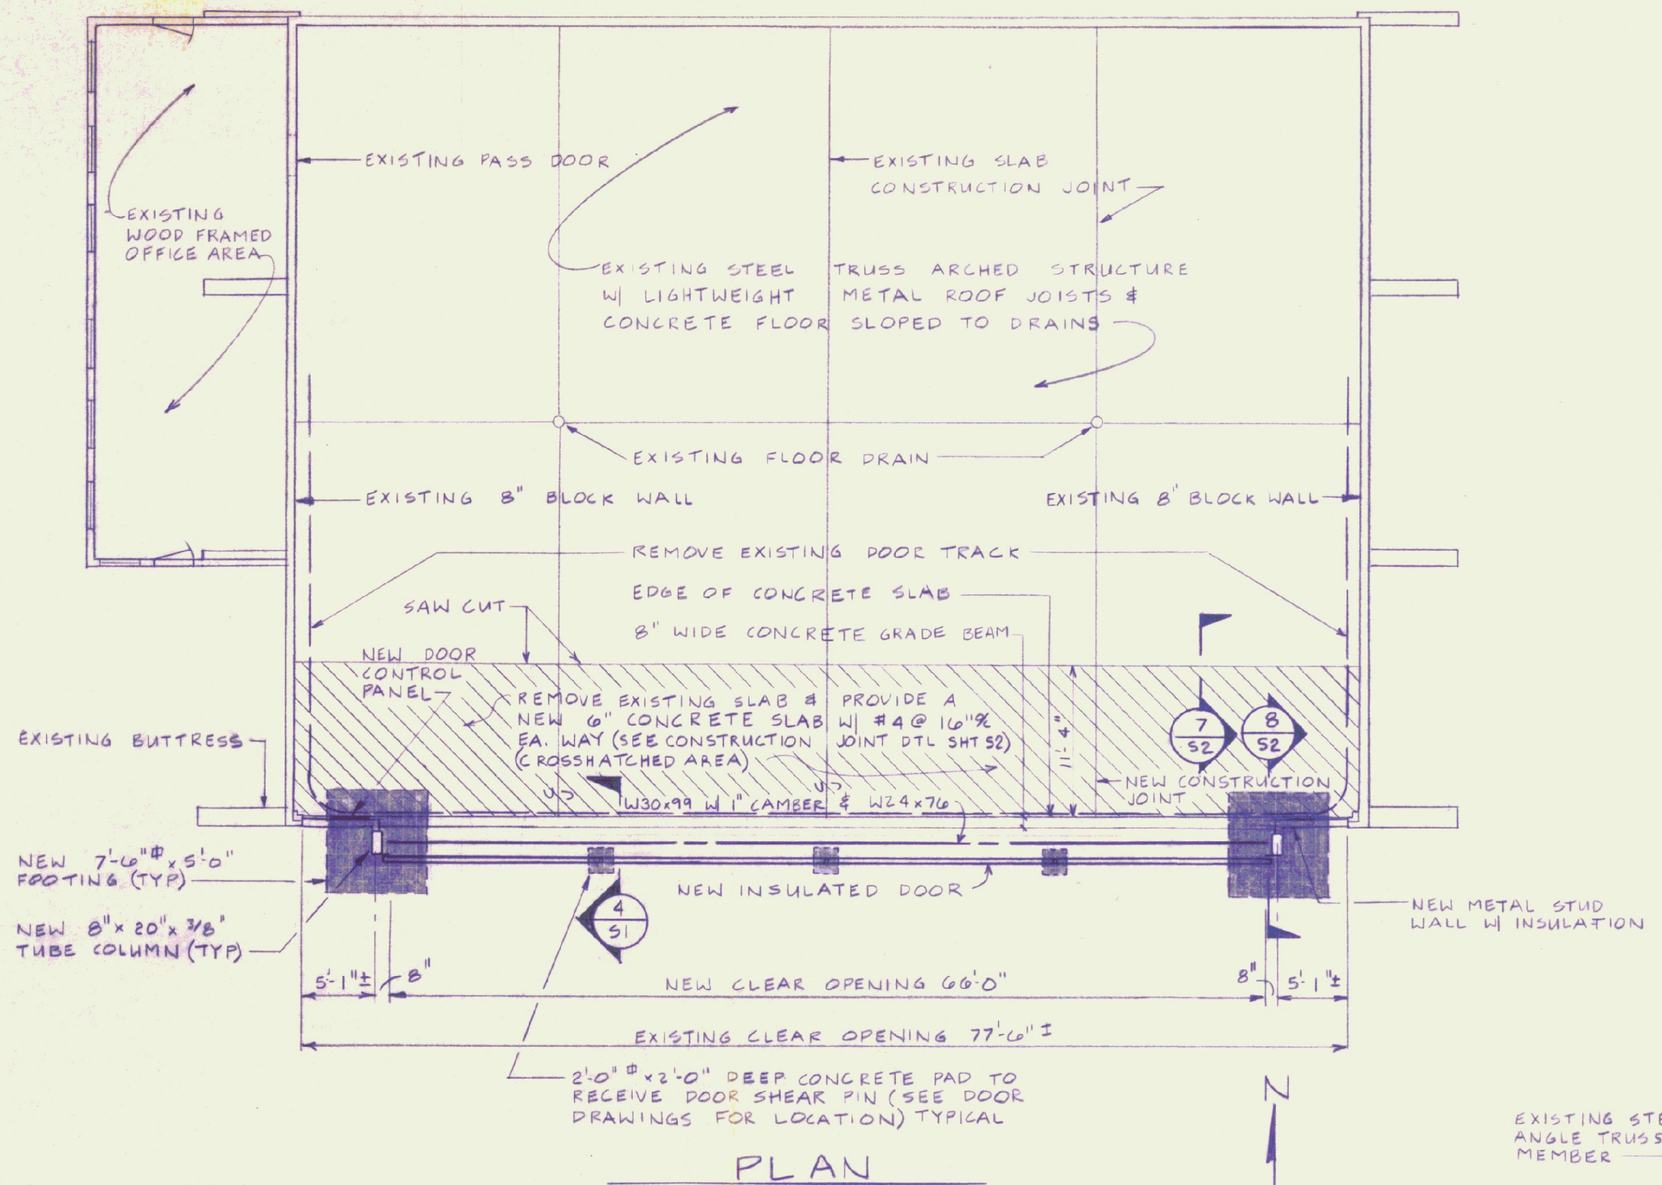

PLAN

SCALE: 1/8" = 1'-0"

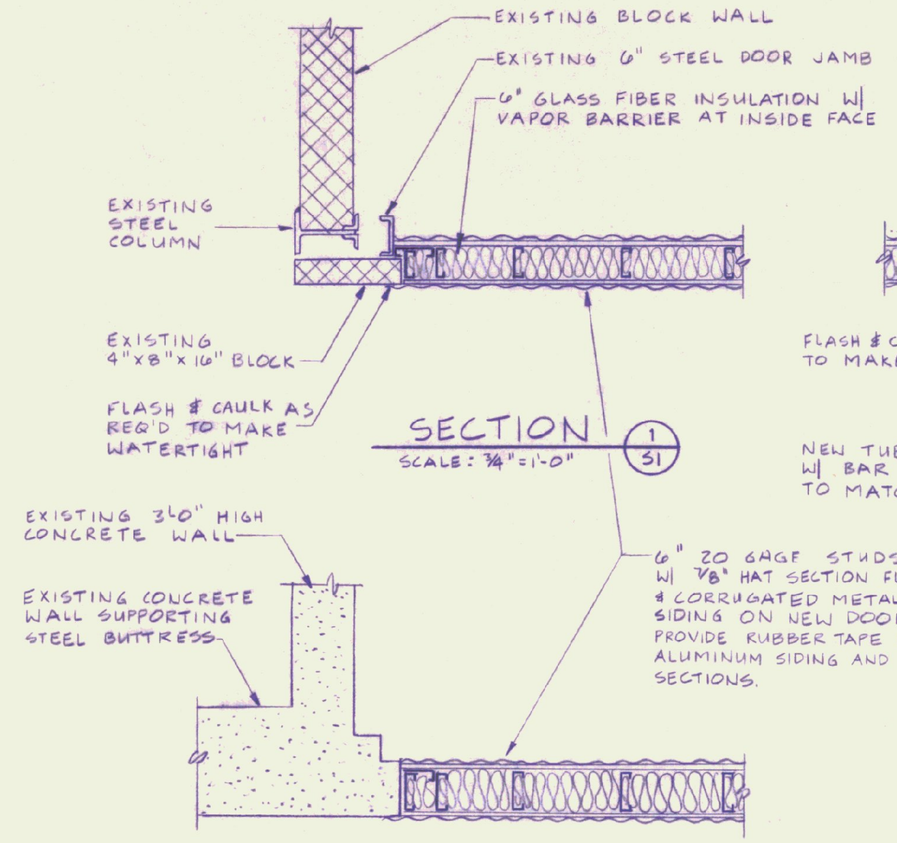

SECTION 1/S1

SCALE: 3/4" = 1'-0"

SECTION 2/S1

SCALE: 3/4" = 1'-0"

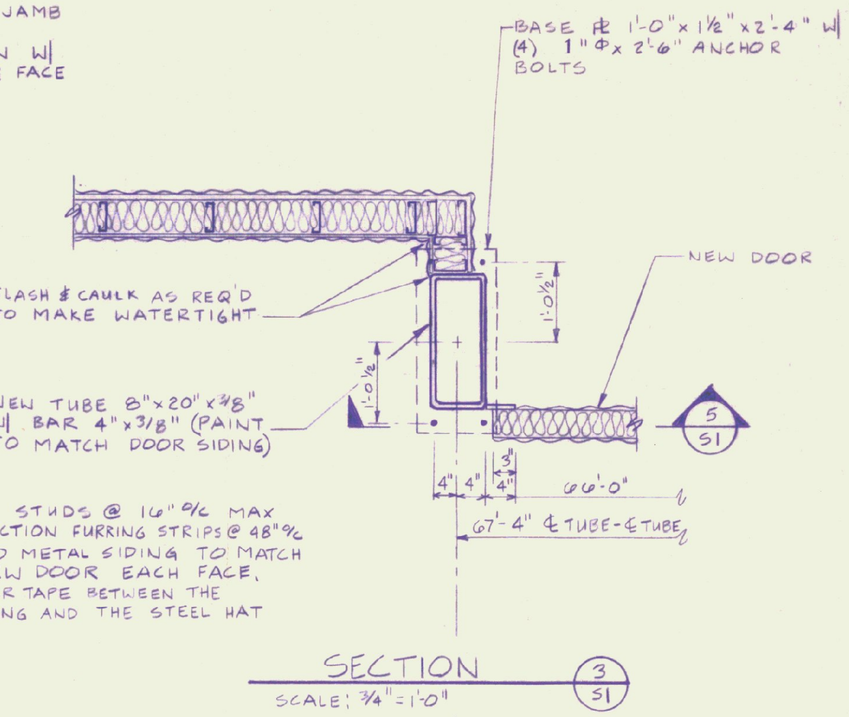

SECTION 3/S1

SCALE: 3/4" = 1'-0"

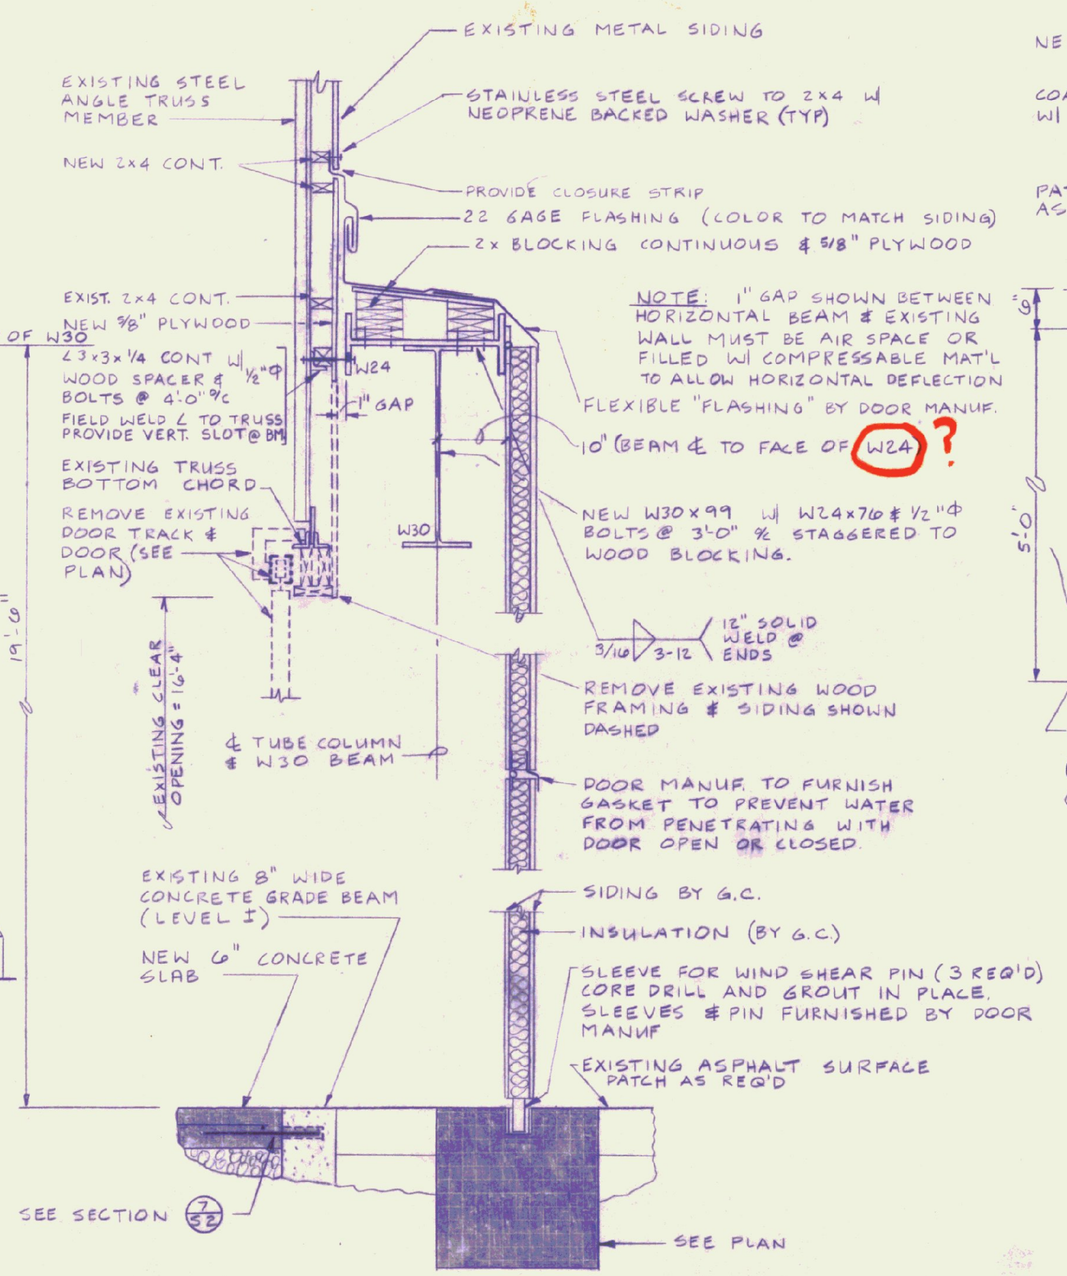

SECTION 4/S1

SCALE: 3/4" = 1'-0"

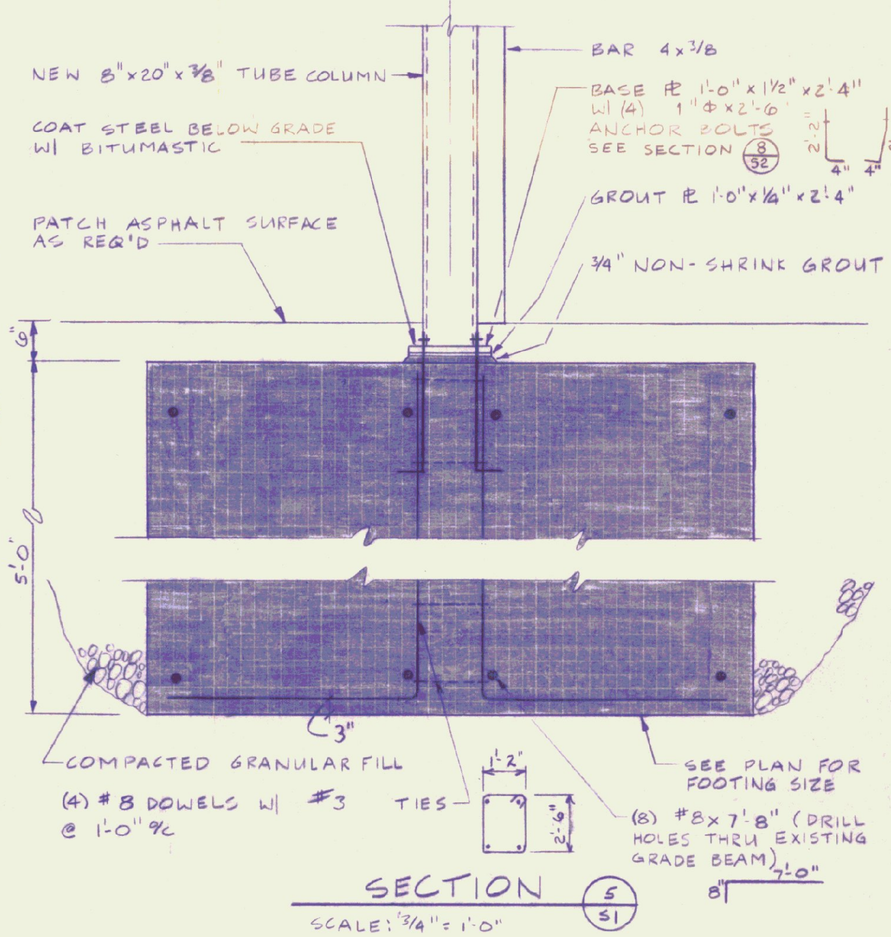

SECTION 5/S1

SCALE: 3/4" = 1'-0"

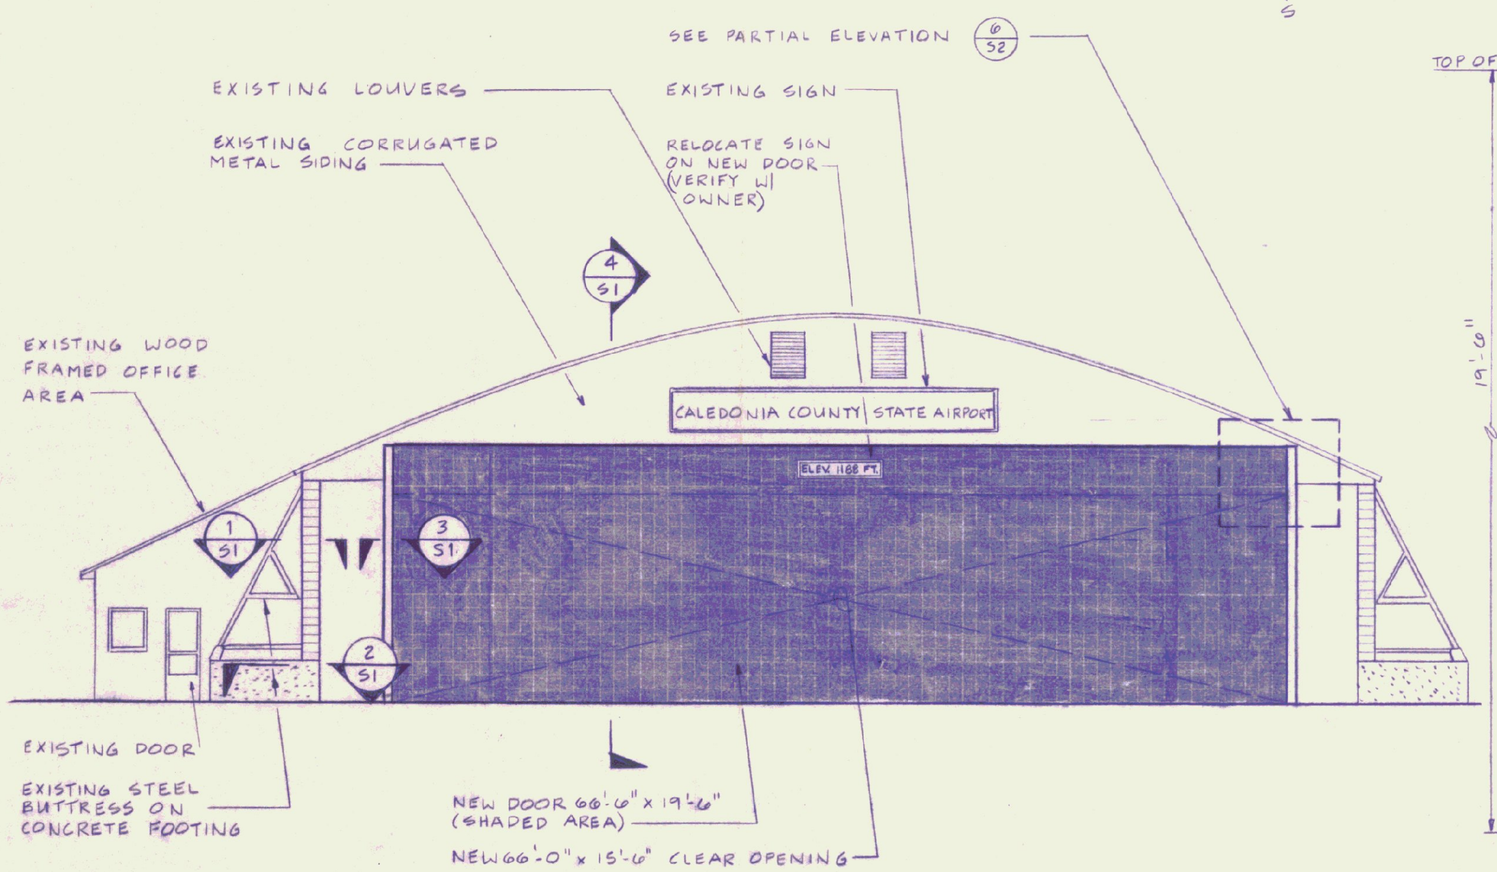

ELEVATION

SCALE: 1/8" = 1'-0"

STATE OF VERMONT
STEPHEN K. COLLINS
NO. 5133
REGISTERED PROFESSIONAL ENGINEER

No.	DATE	REVISION

Lawes Consulting Engineers, Inc.
ROUTE 2A WILLISTON, VERMONT 05495

STATE OF VERMONT DIVISION OF BUILDINGS
& WESTERN AVENUE MONTPELIER, VERMONT 05602

HANGAR DOOR
CALEDONIA COUNTY STATE AIRPORT
LYNDONVILLE VERMONT

PLAN AND DETAILS

DRAWN	PROJ. No.
SKC.	8575
CHECKED	DATE
SKC/TFB	11-22-85

S1

Return to Frank