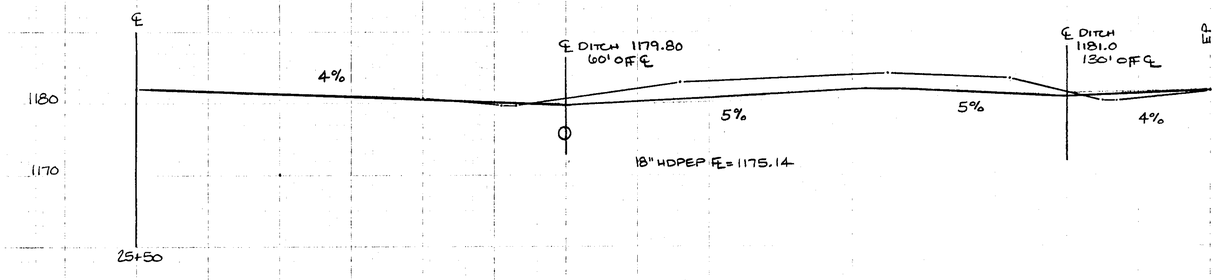

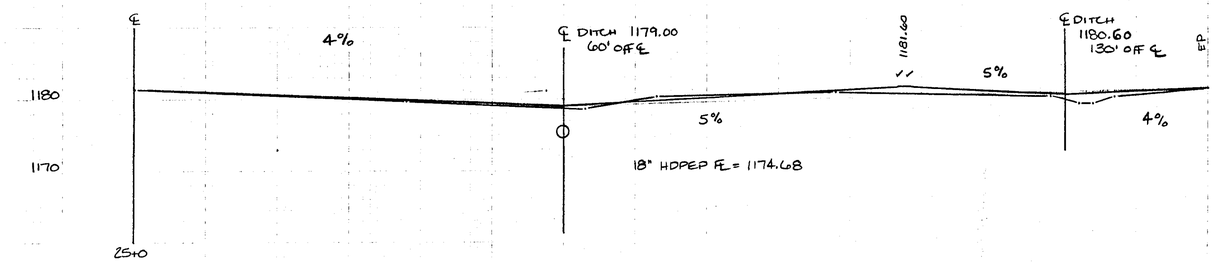

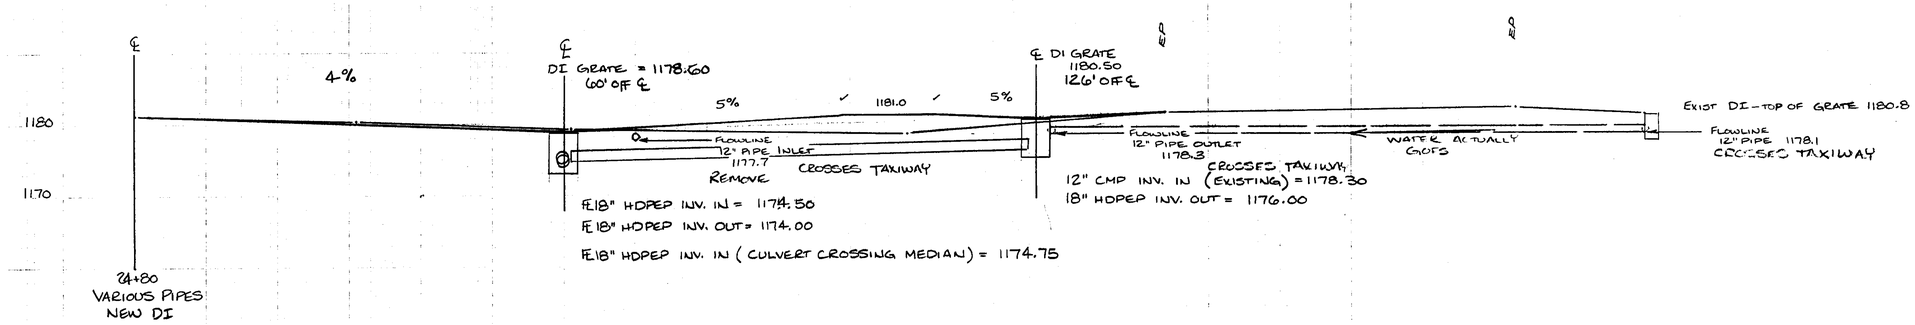

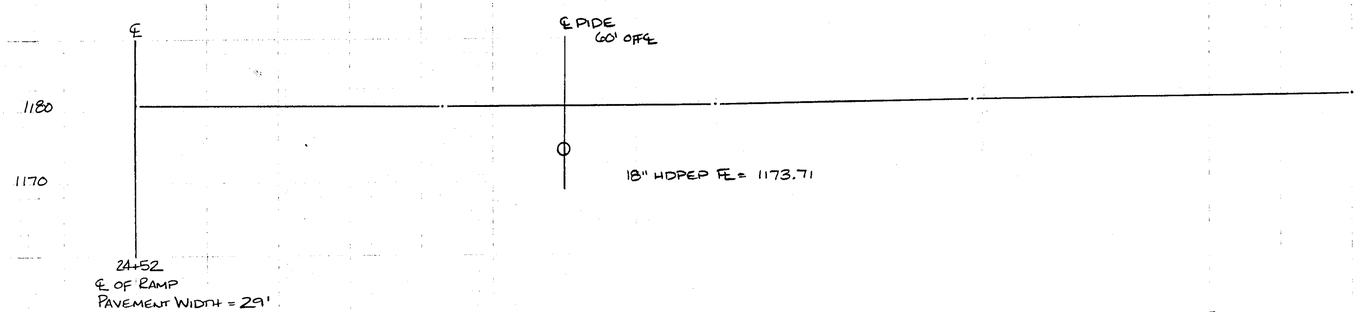

50 100 150 200 250

LYNDON AIRPORT
SURVEY BY: D. BUMPS 4-5-00
D. LUND
J. COTA
DRAWN BY: S. CLIFFORD 5-11-00
SCALE: 1" = 10' SHEET 9 OF 12