








F IS LOCATED 2 FEET OFF EDGE OF PAVEMENT OF RUNWAY.

50 100 150 200 250





LYNDON AIRPORT
 SURVEY BY: D. RUMPS 4-5-00
 D. LUND
 J. COTA
 DRAWN BY: S. CLIFORD 4-24-00
 SCALE: 1" = 10'

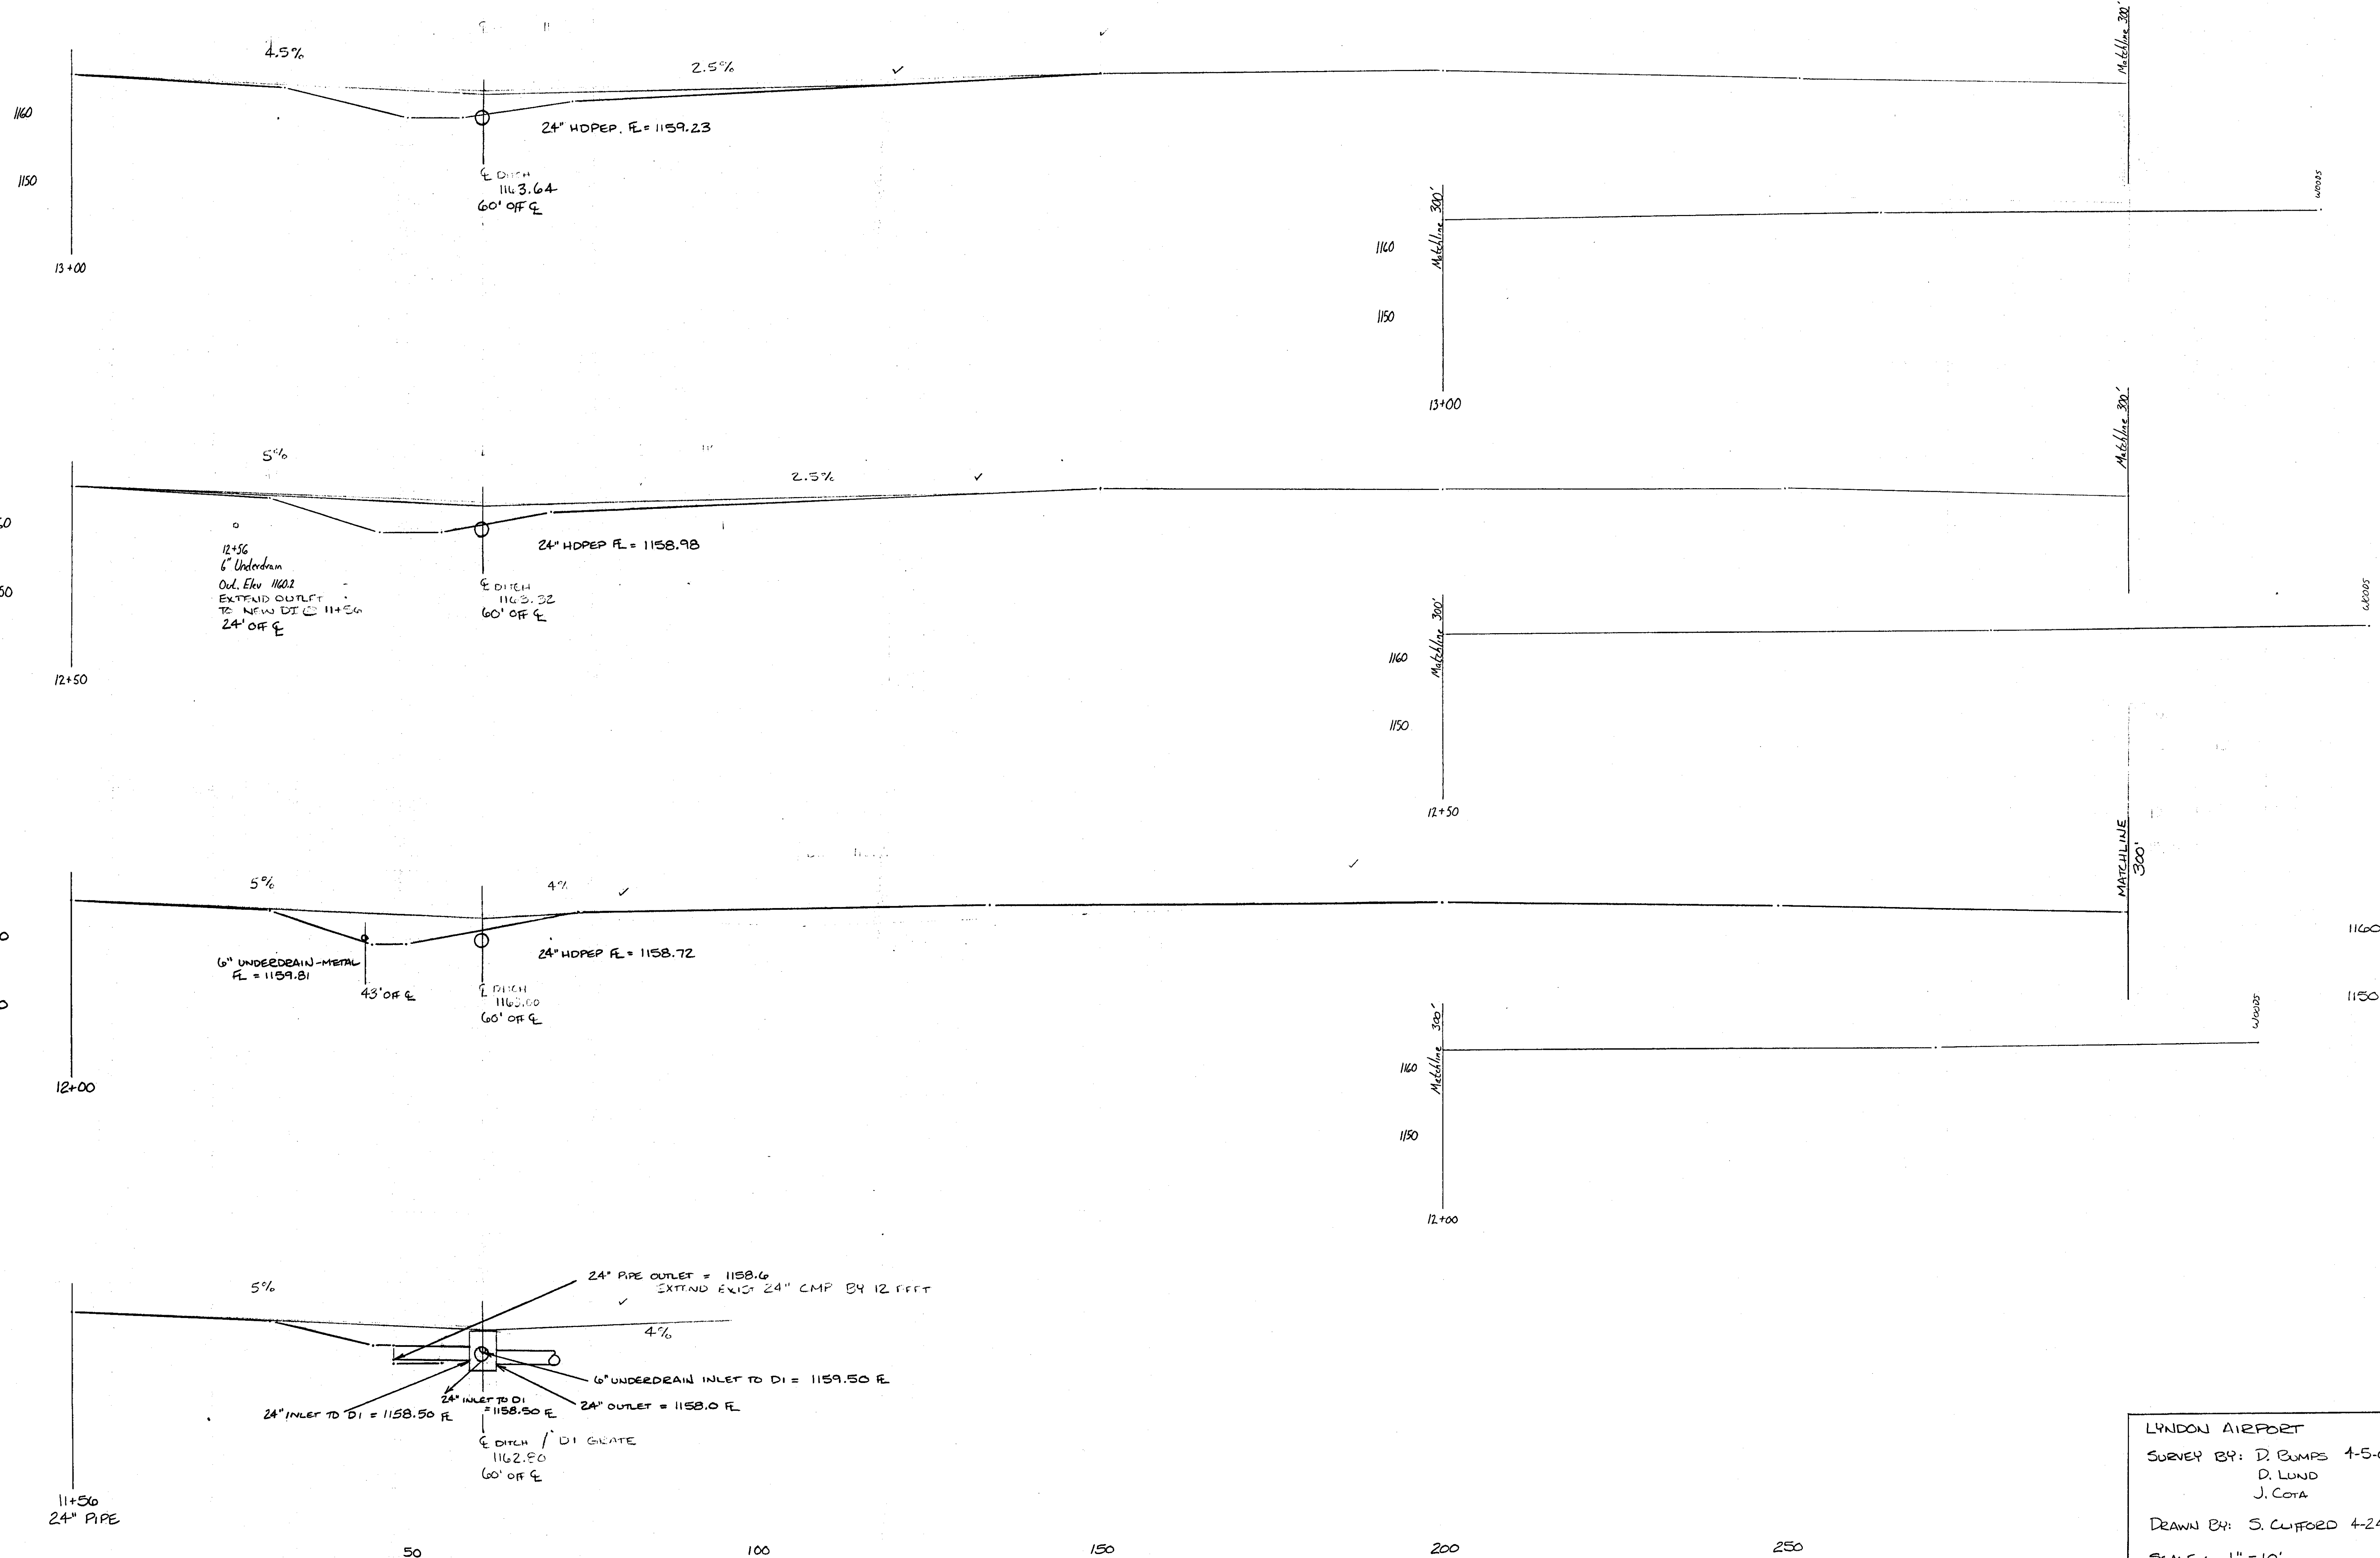





LYNDON AIRPORT
 SURVEY BY: D. BUMPS 4-5-0
 D. LUND
 J. COTA
 DRAWN BY: S. CLIFFORD 4-24
 SCALE: 1" = 10'
 SHEET 2 OF 12

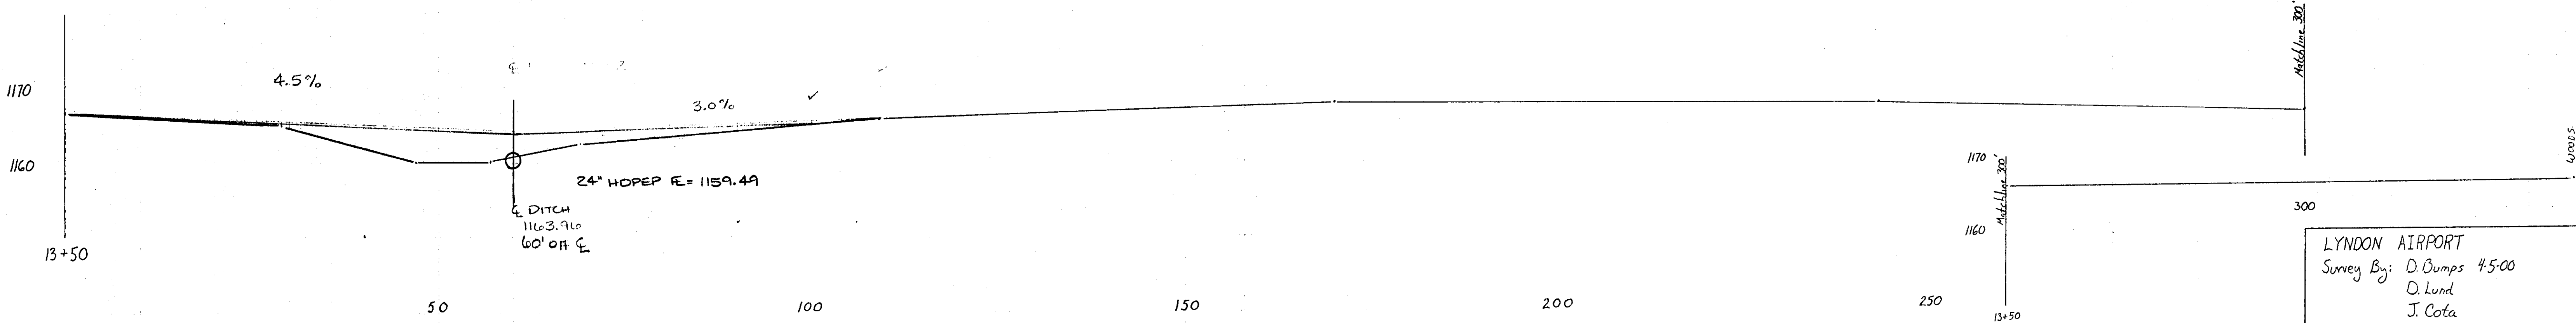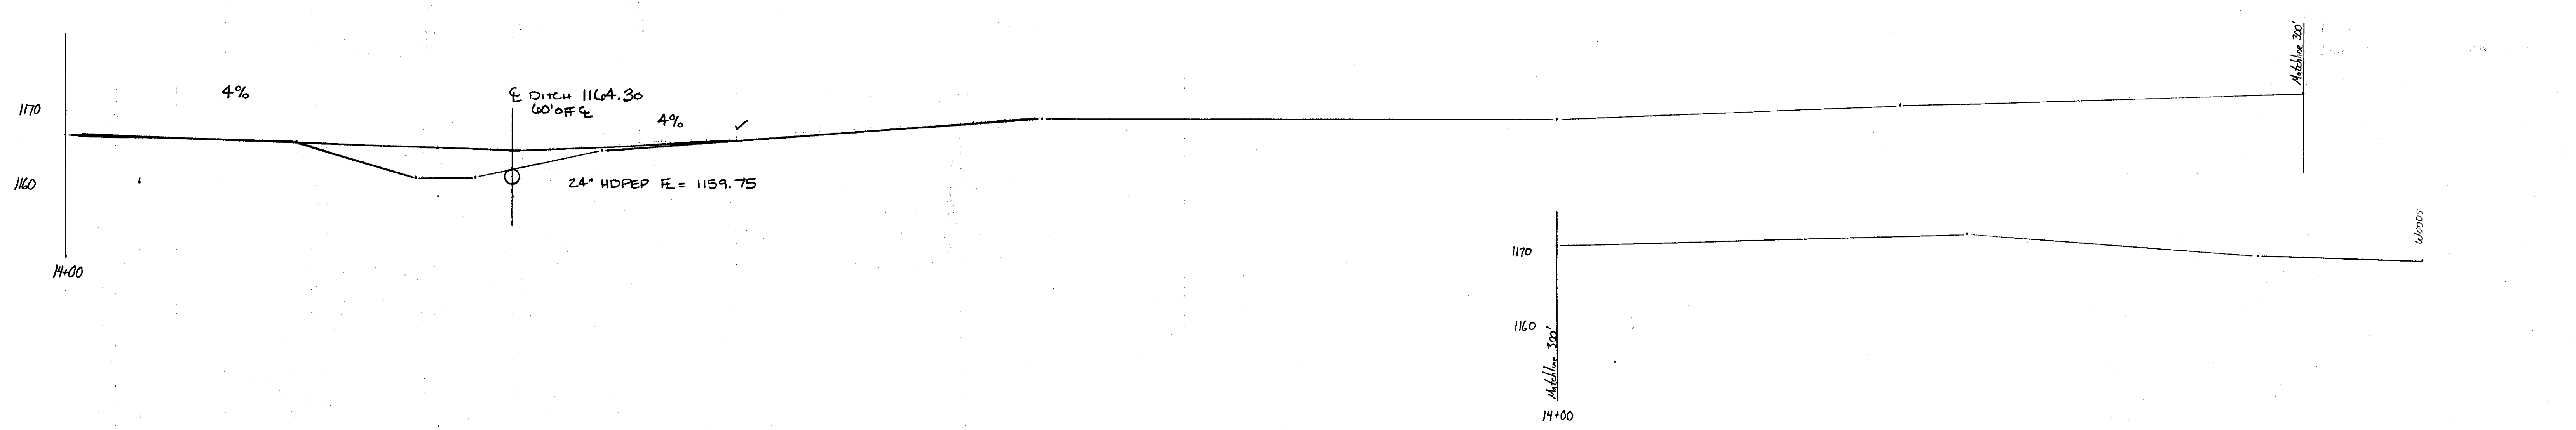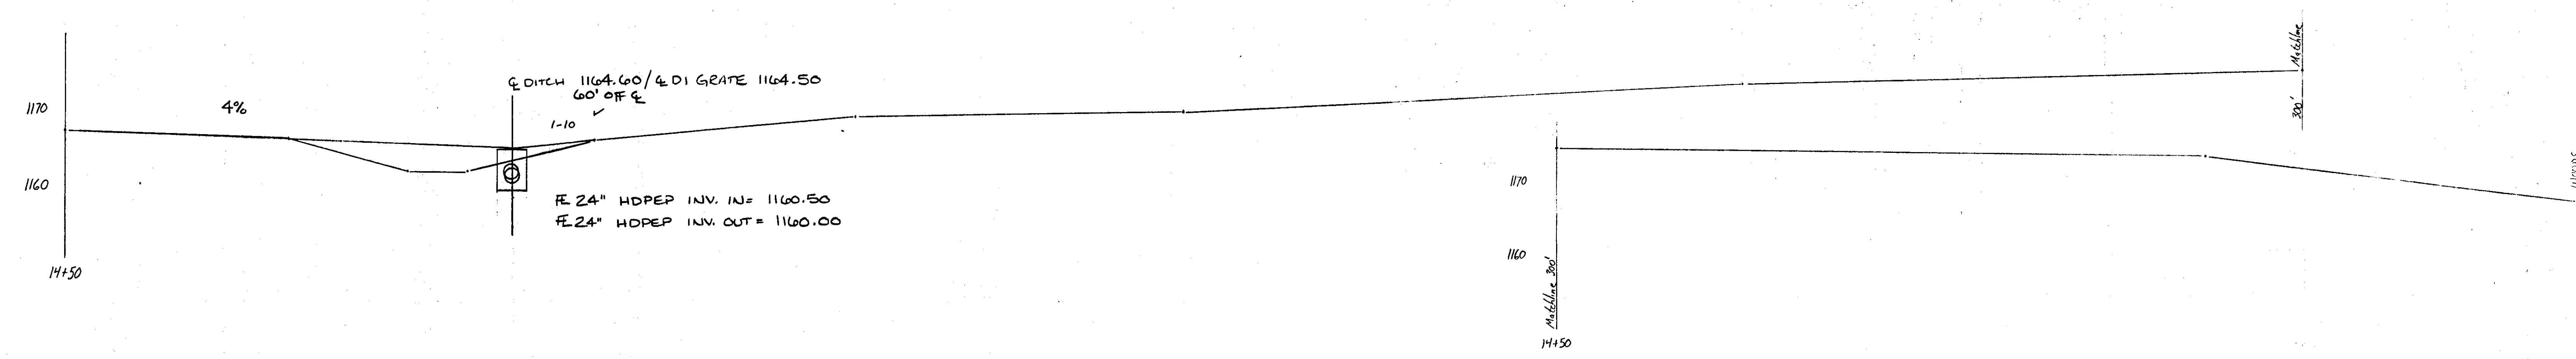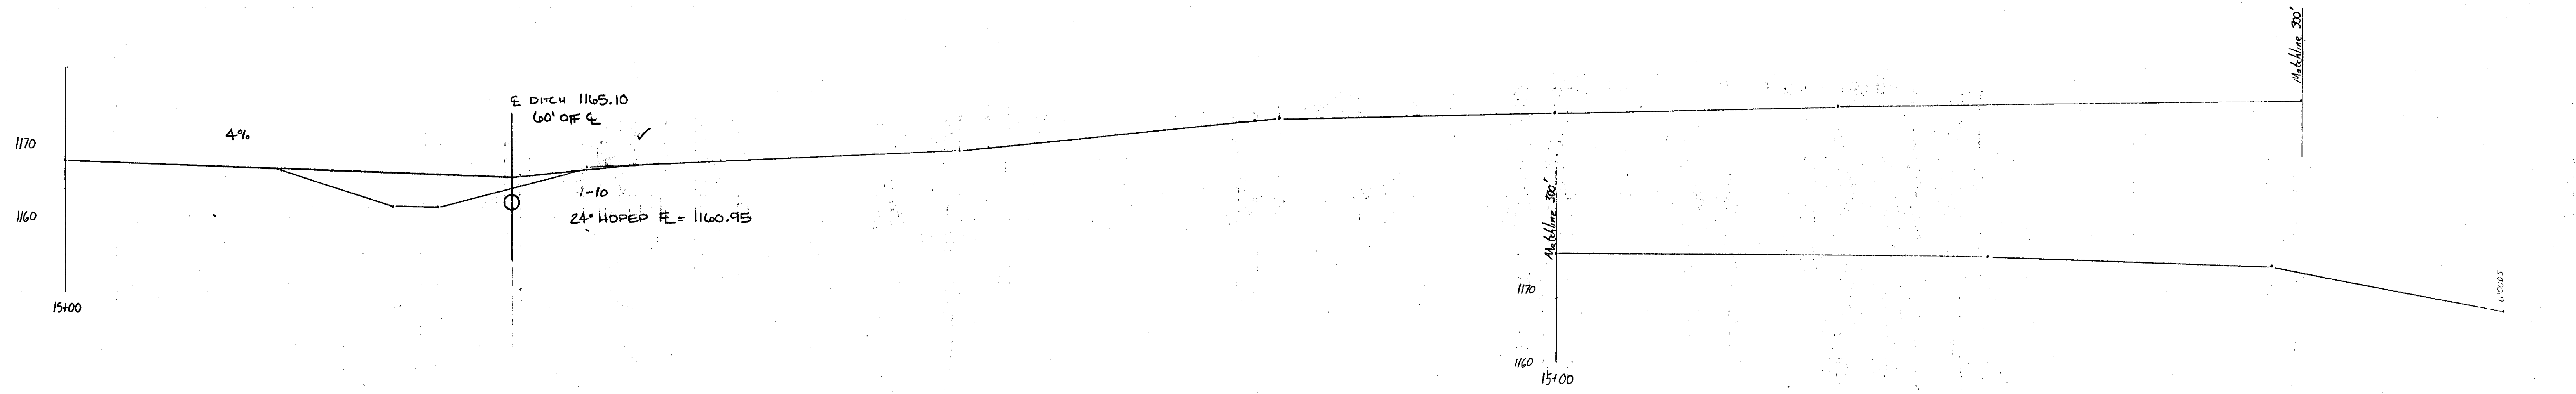





LYNDON AIRPORT
 Survey By: D. Dumps 4-5-00
 D. Lund
 J. Cota
 Drawn By: J. Cota 5-3-00
 S. L. 1"=40'
 SHEET 3 OF 17

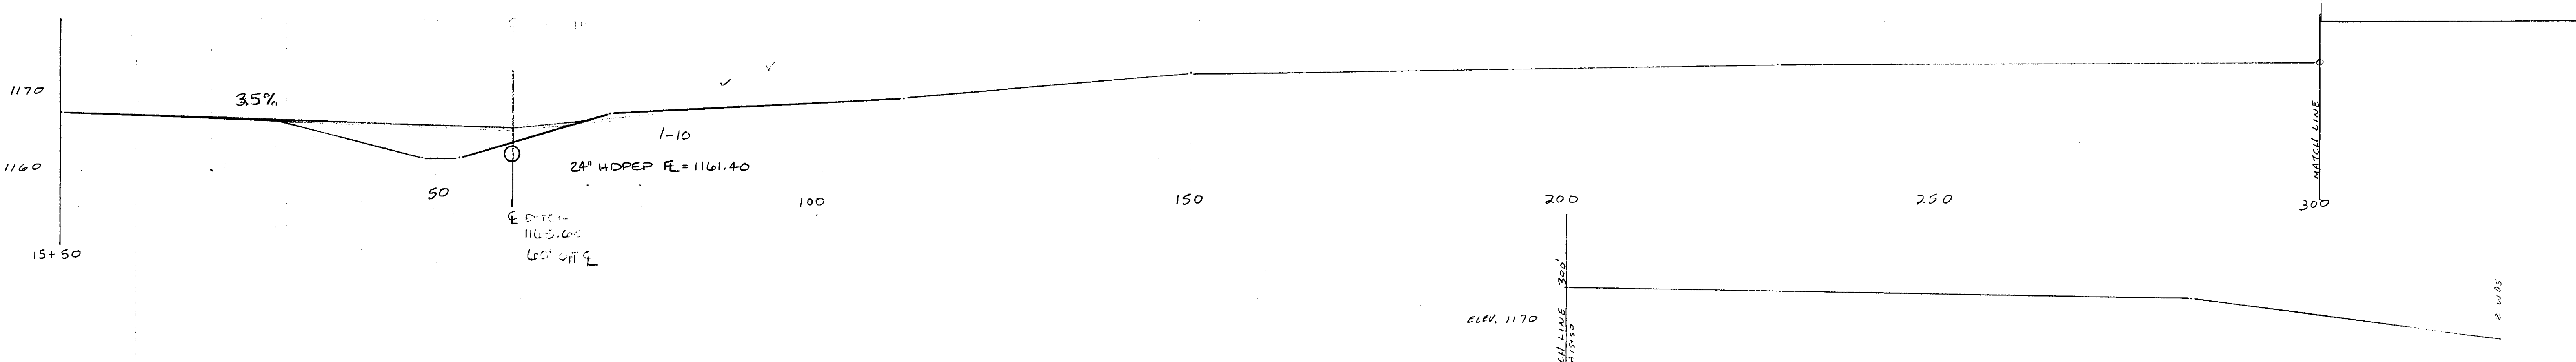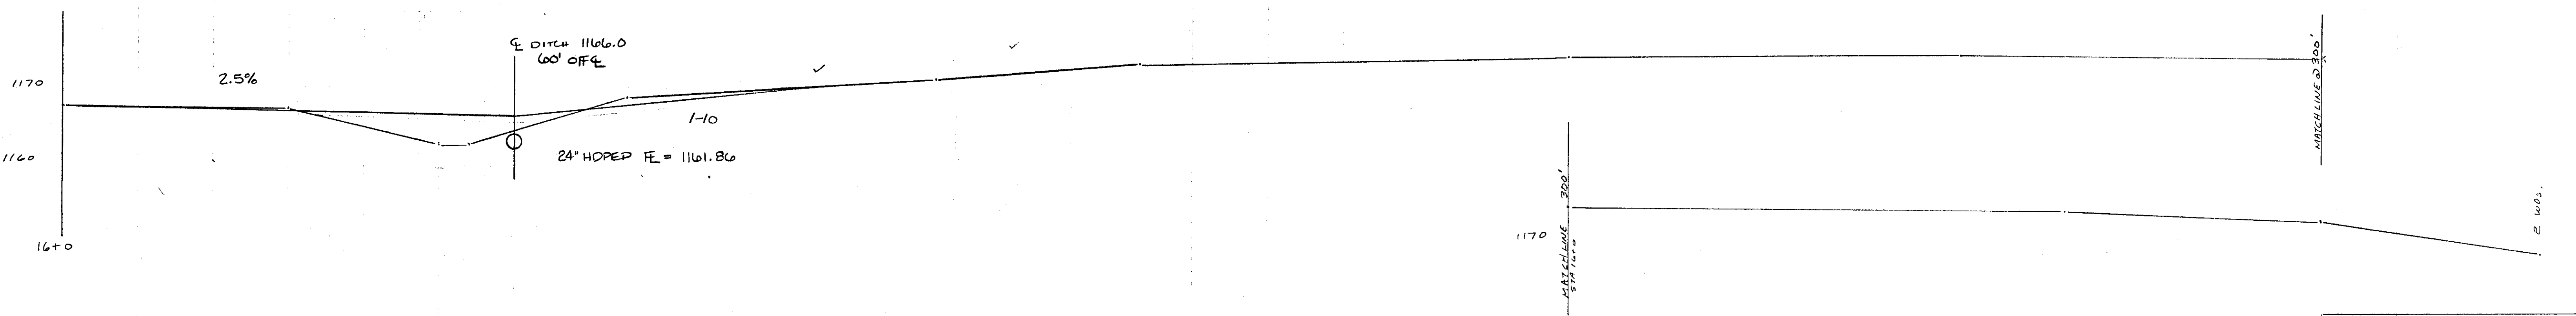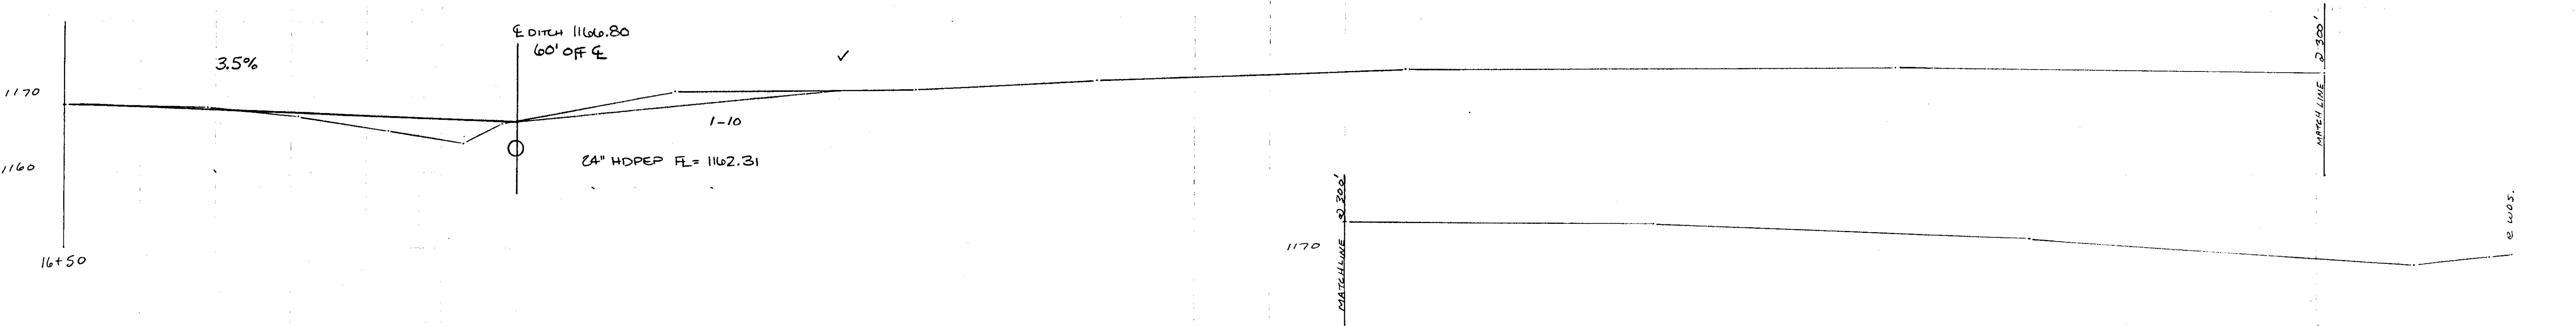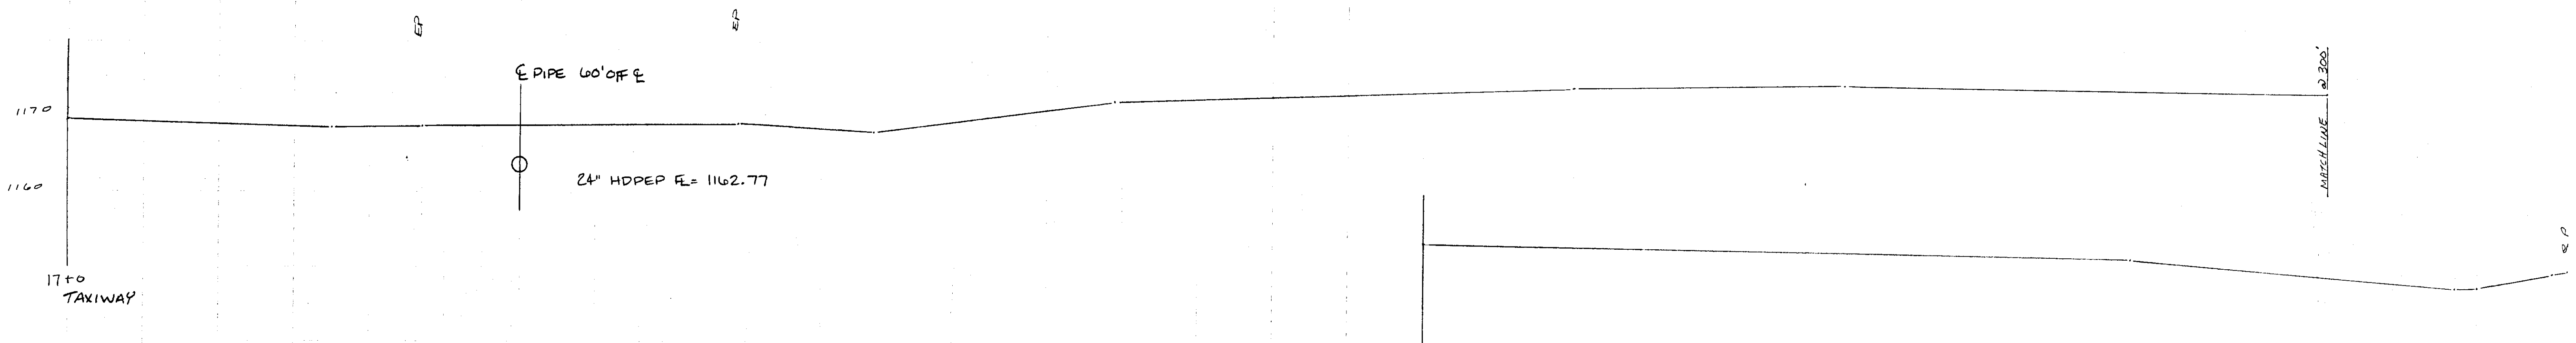





LYNDON AIRPORT
 SURVEY & D. BUMPS 4-5-00
 D. LUND
 T. COSTA
 DRAWN BY: L.J. WATERS 05-05-00
 SCALE: 1" = 10'
 SHEET 4 OF 12

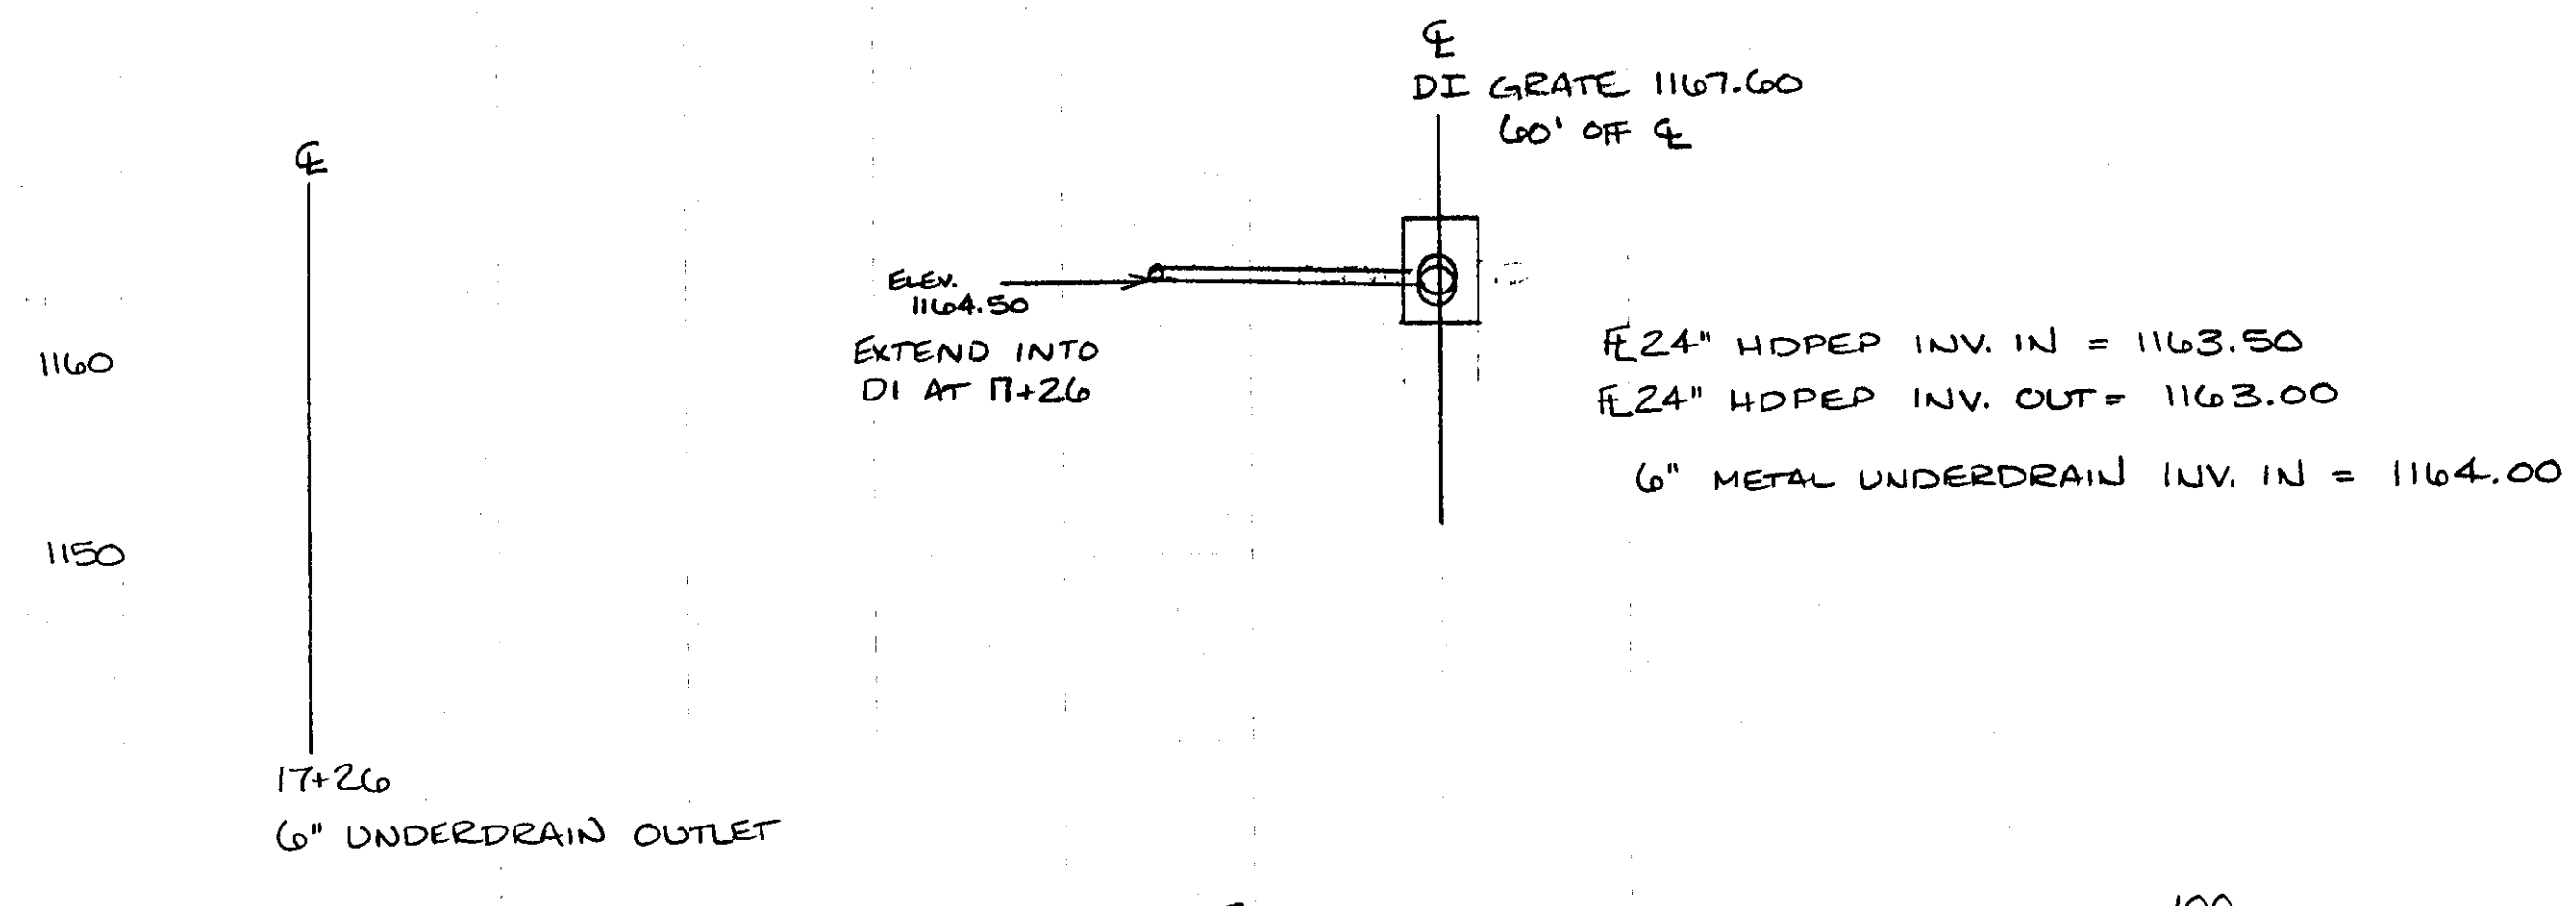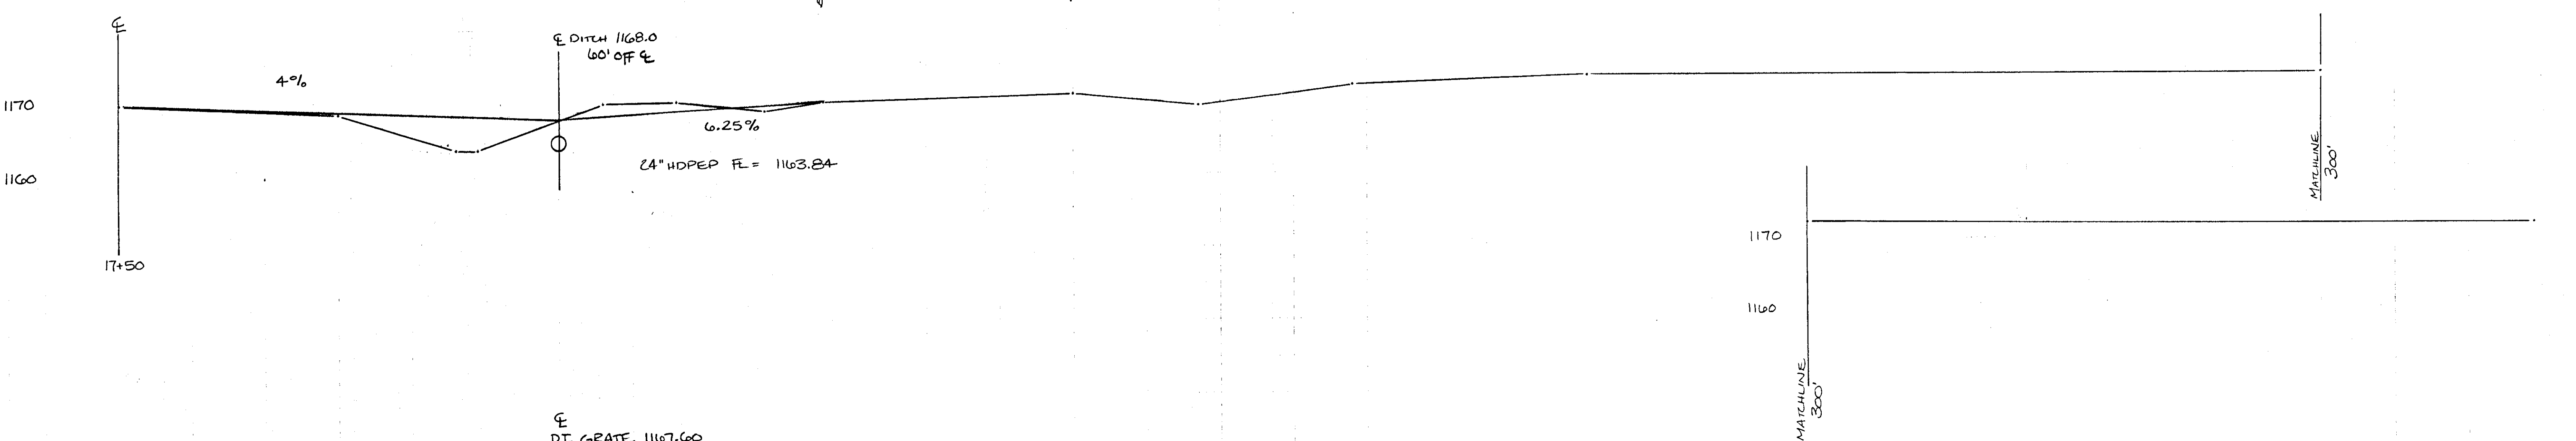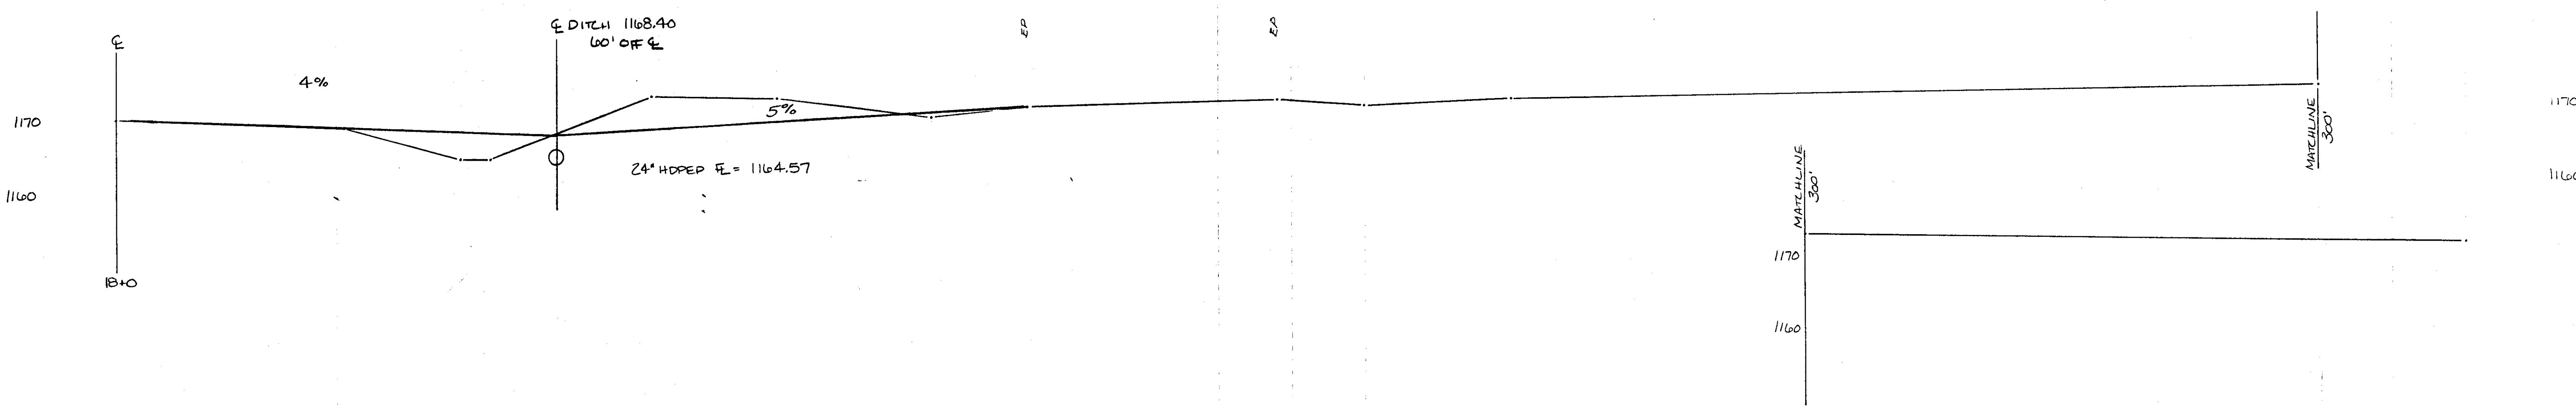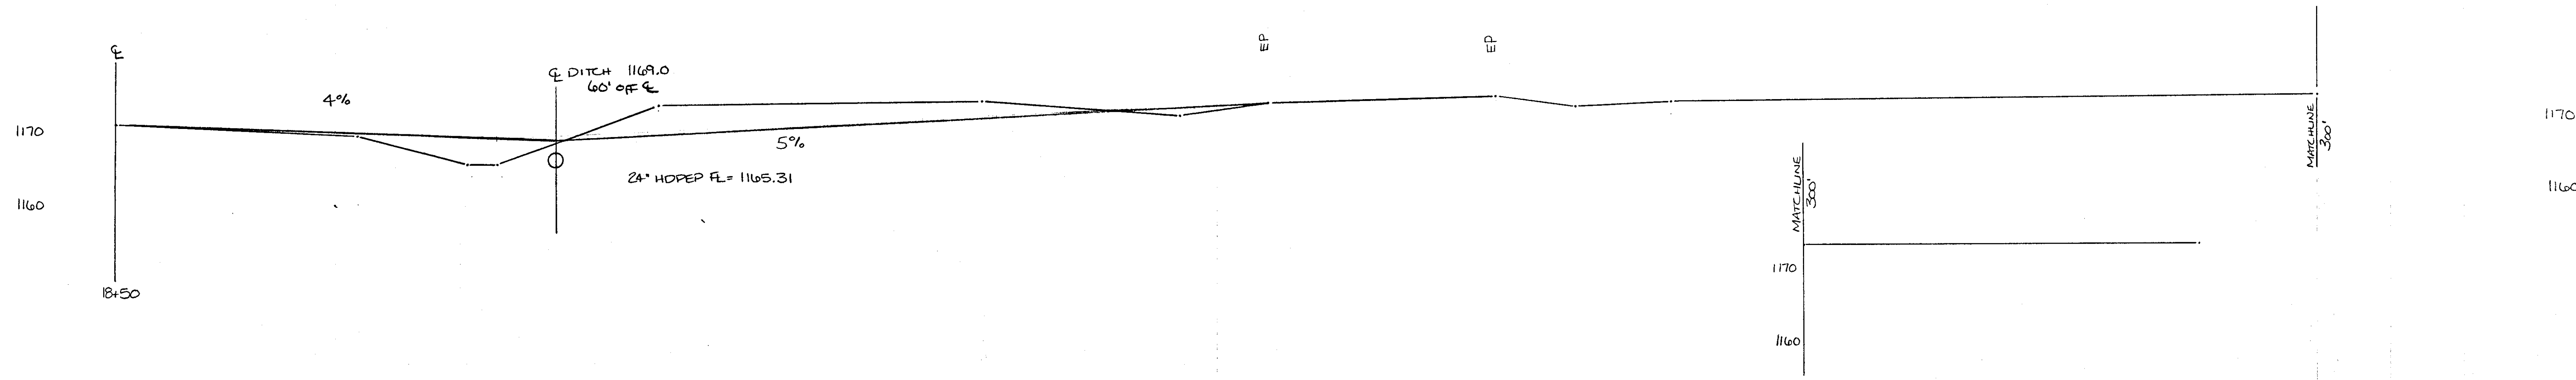





LYNDON AIRPORT
 SURVEY BY: D. BUMPS 04-05-00
 D. LUND
 J. COTA
 DRAWN BY: S. CUFFORD 5-10-00
 SCALE 1"=10' SHEET 5 OF 12

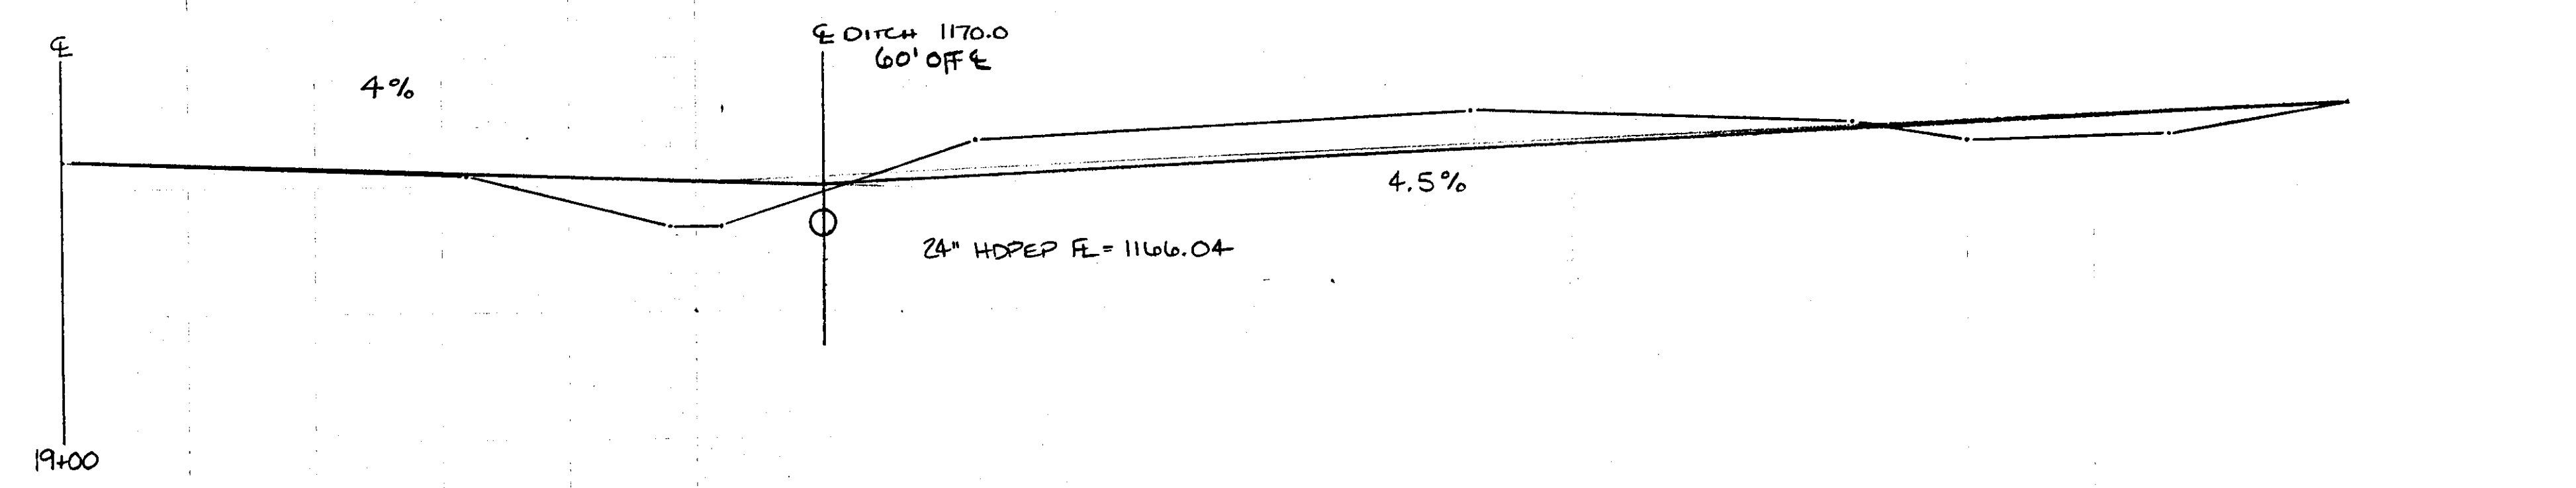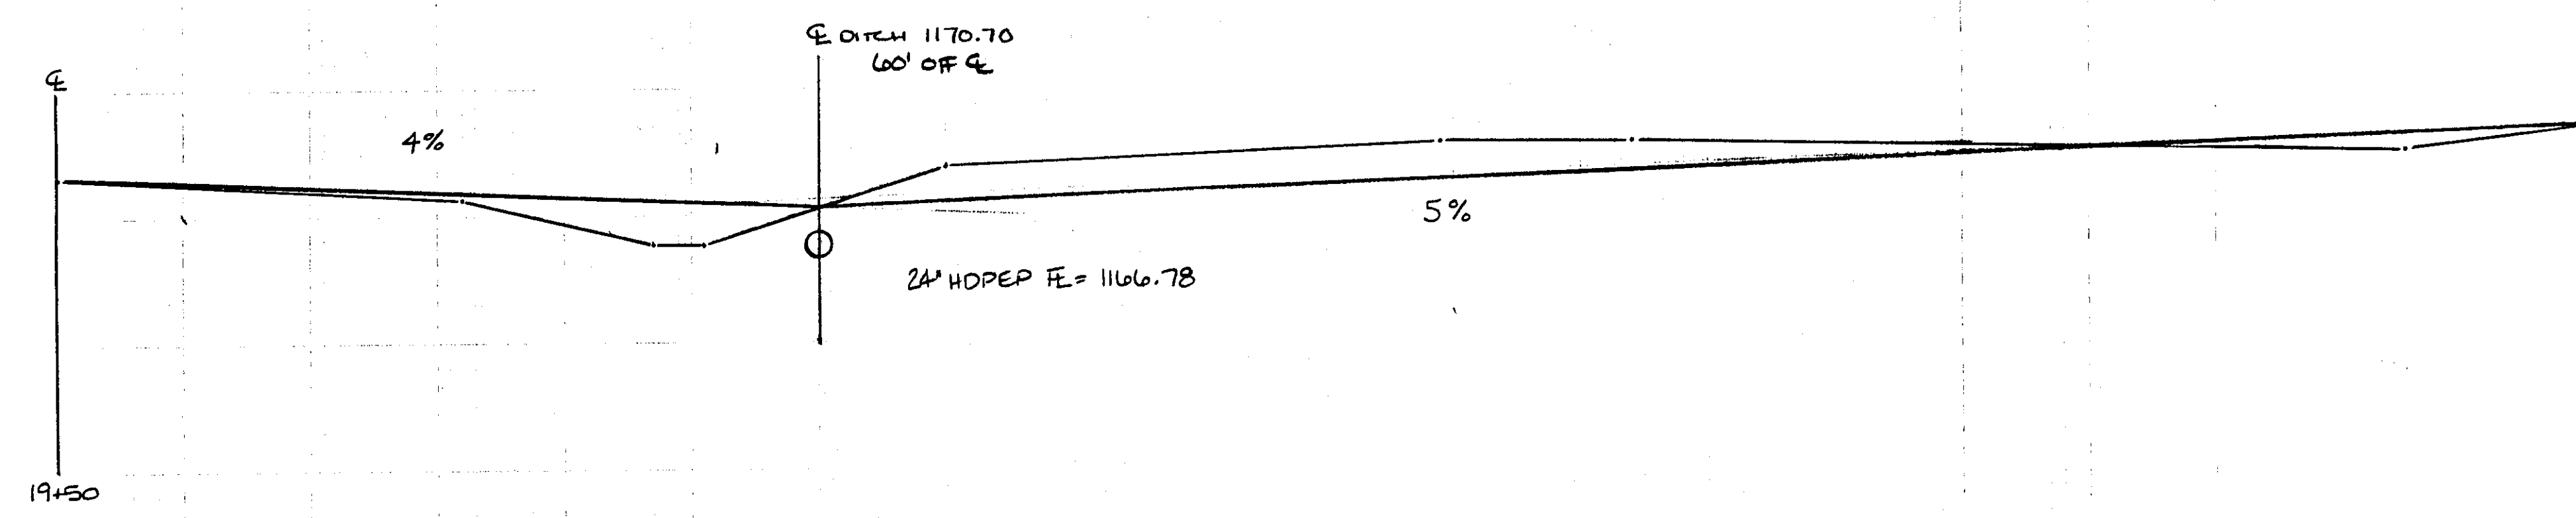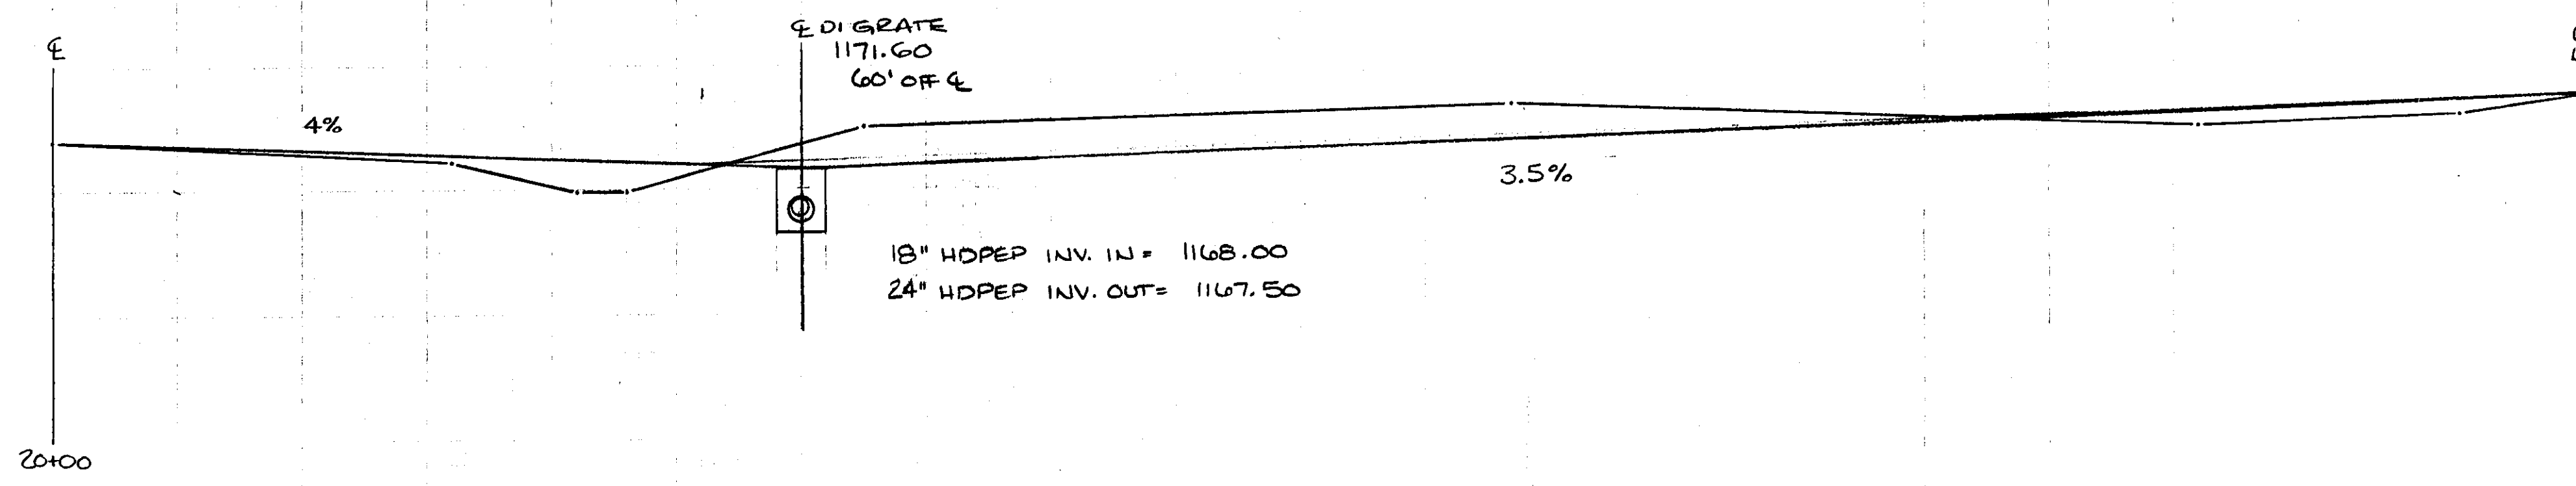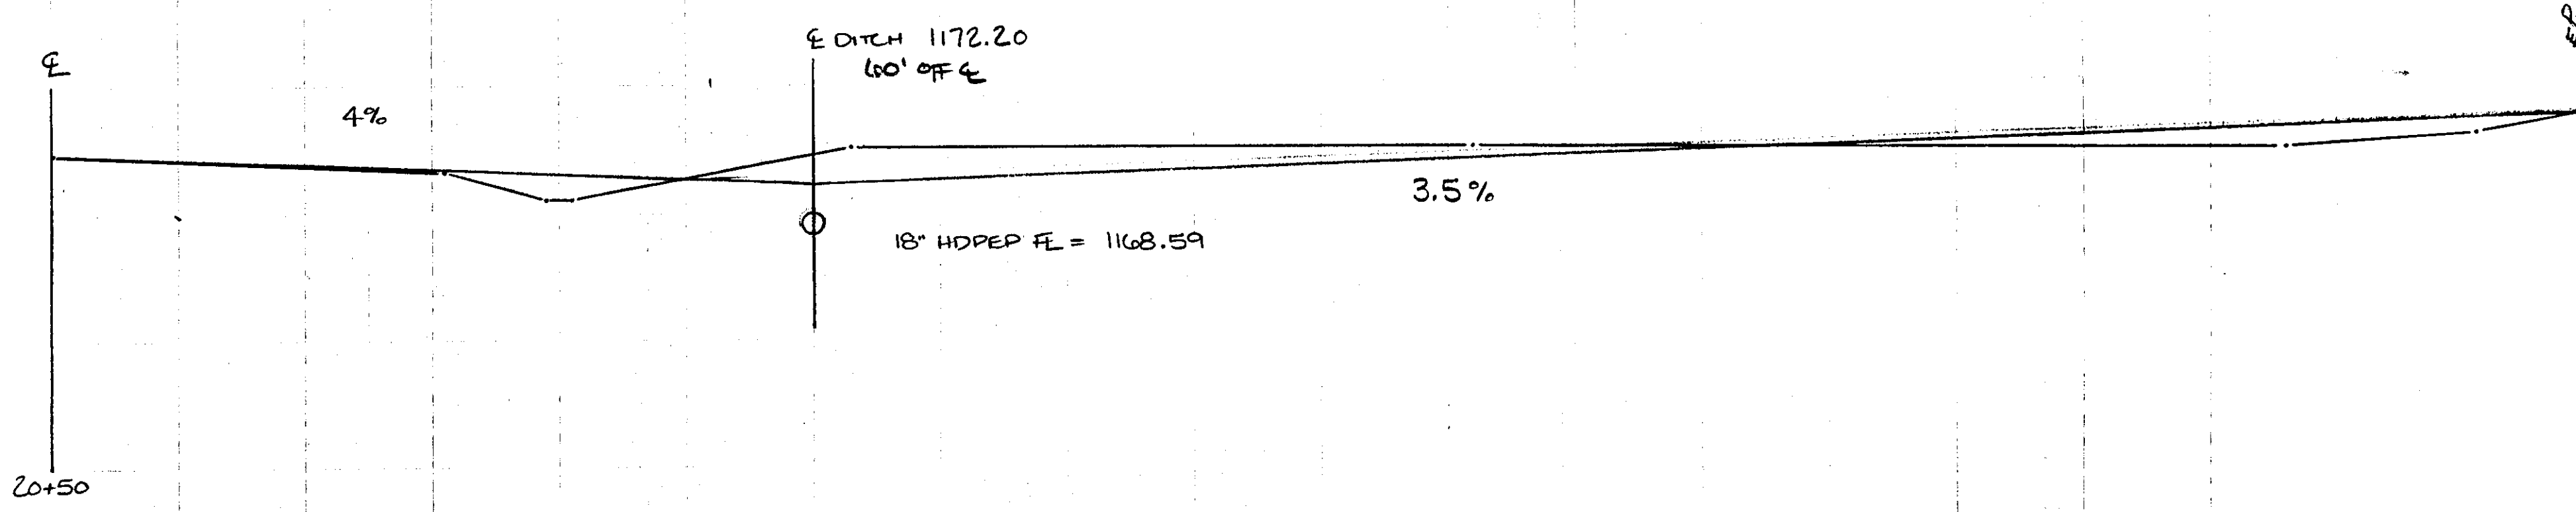

LYNDON AIRPORT
 SURVEY BY: D. BUMPS 4-5-00
 D. LUND
 J. COTA
 DRAWN BY: S. CLIFFORD 5-10-00
 SCALE: 1" = 10' SHEET 005

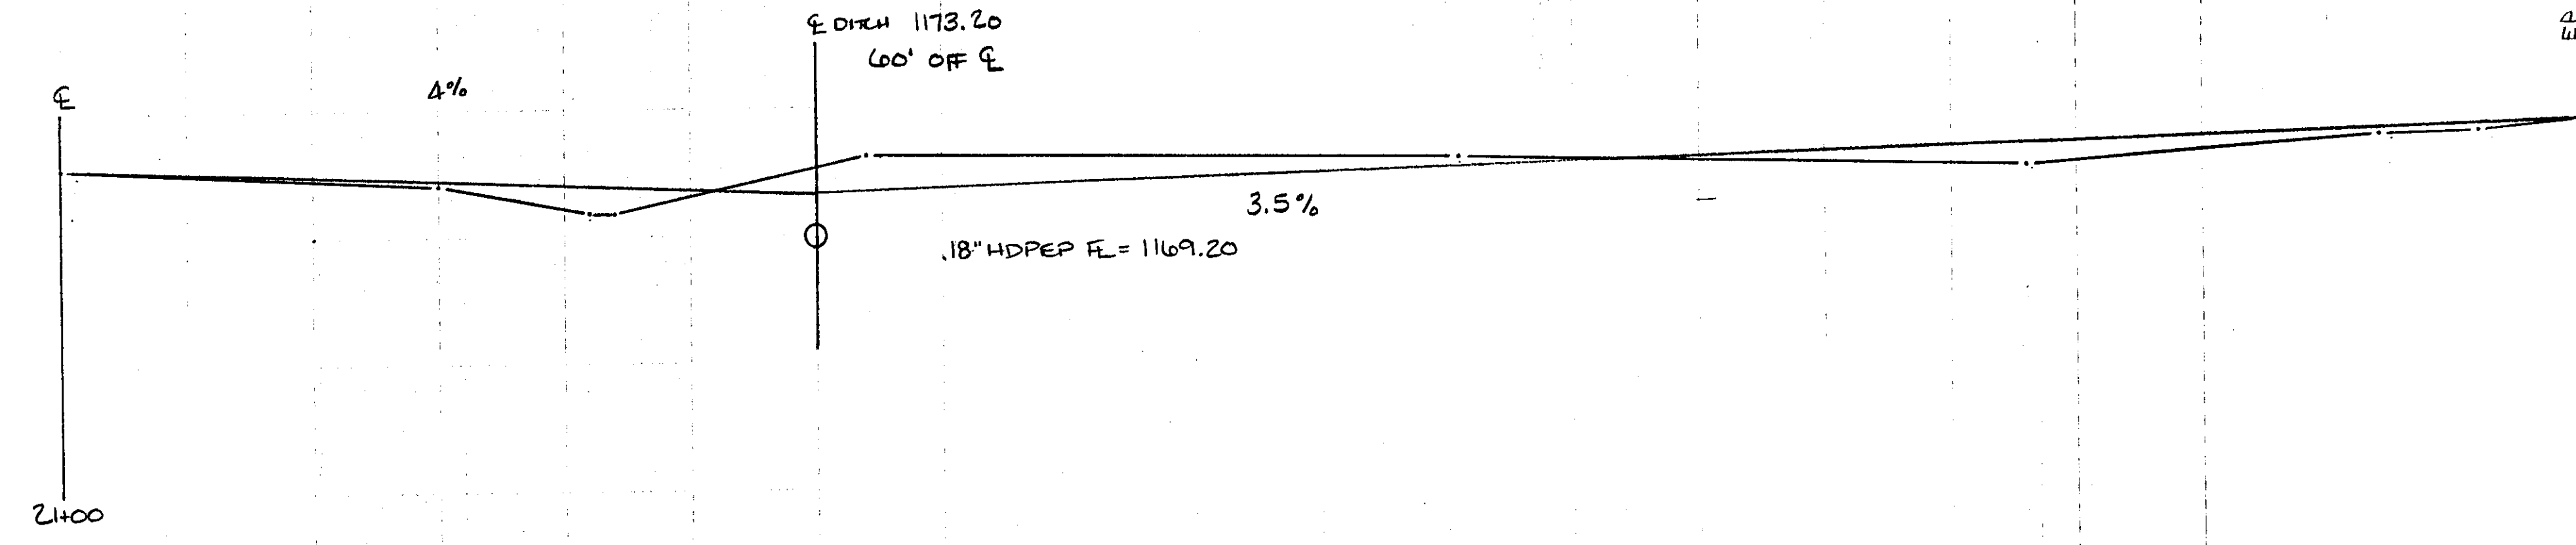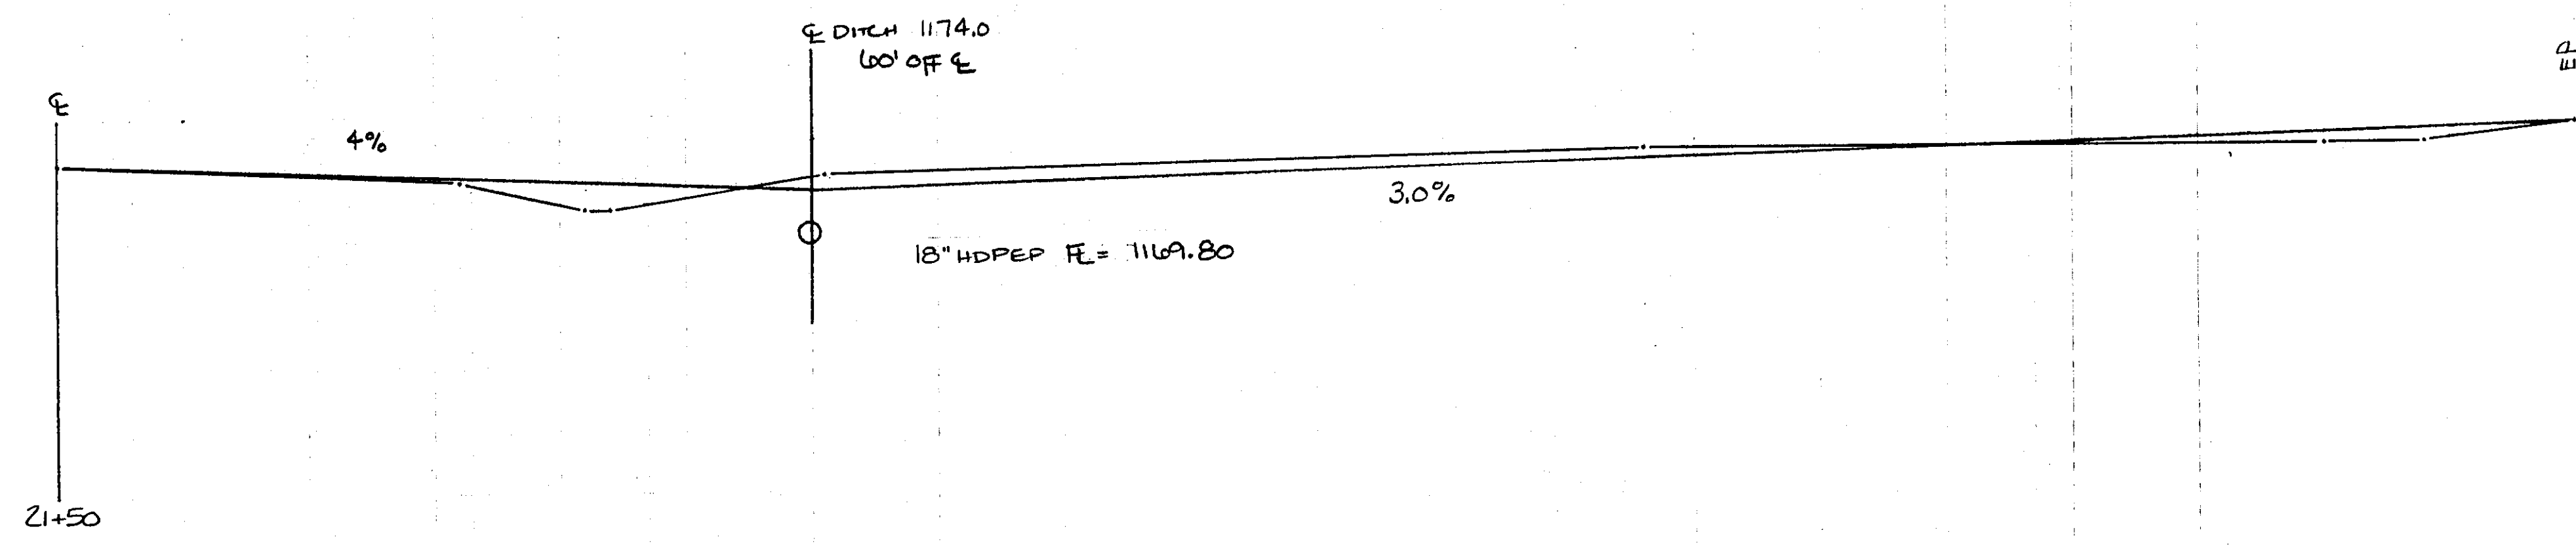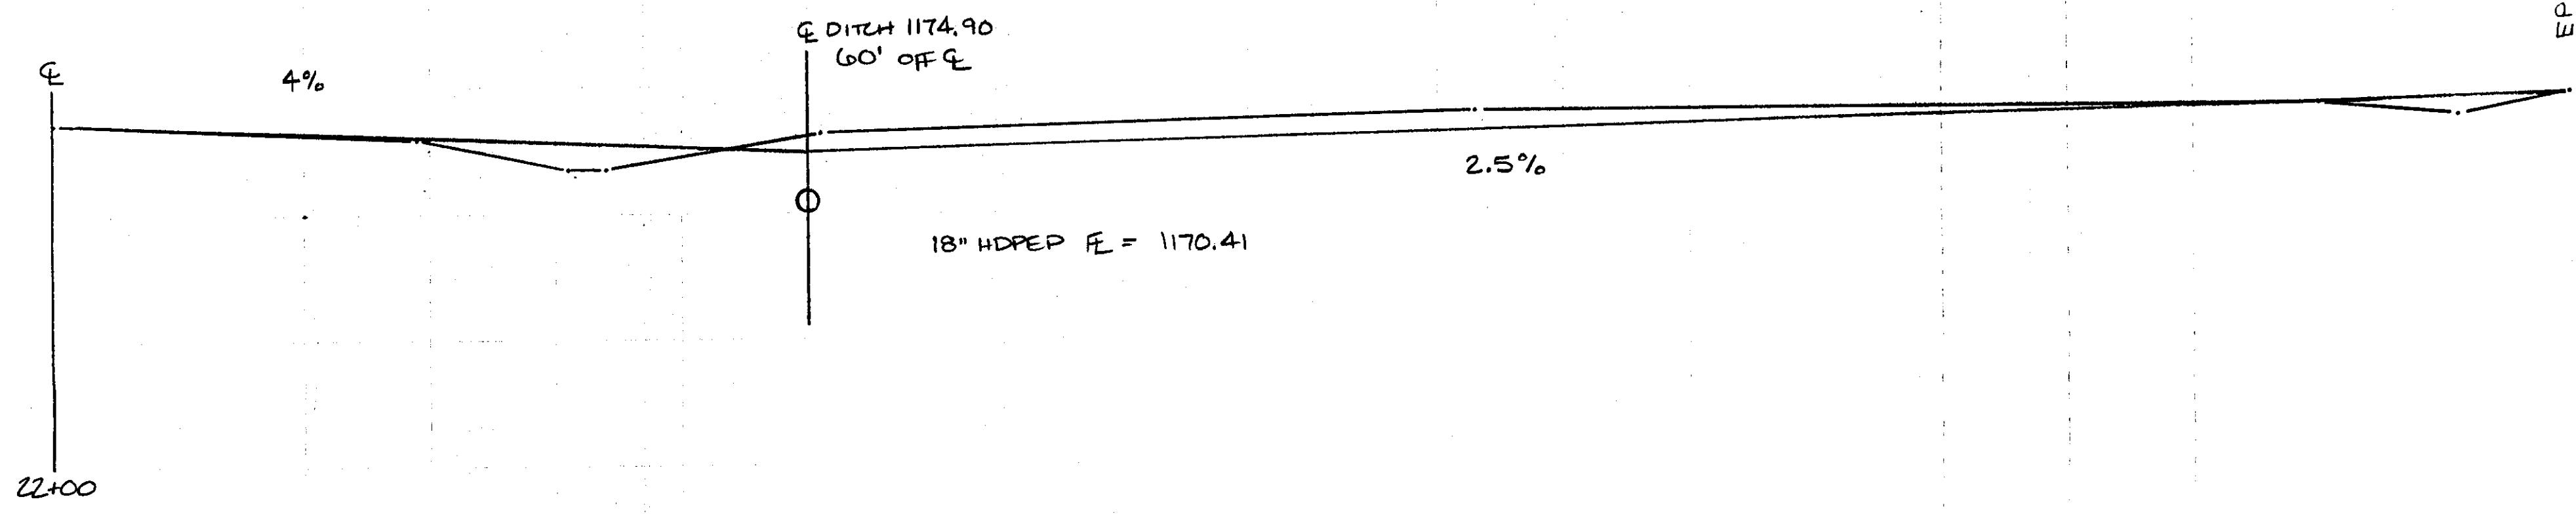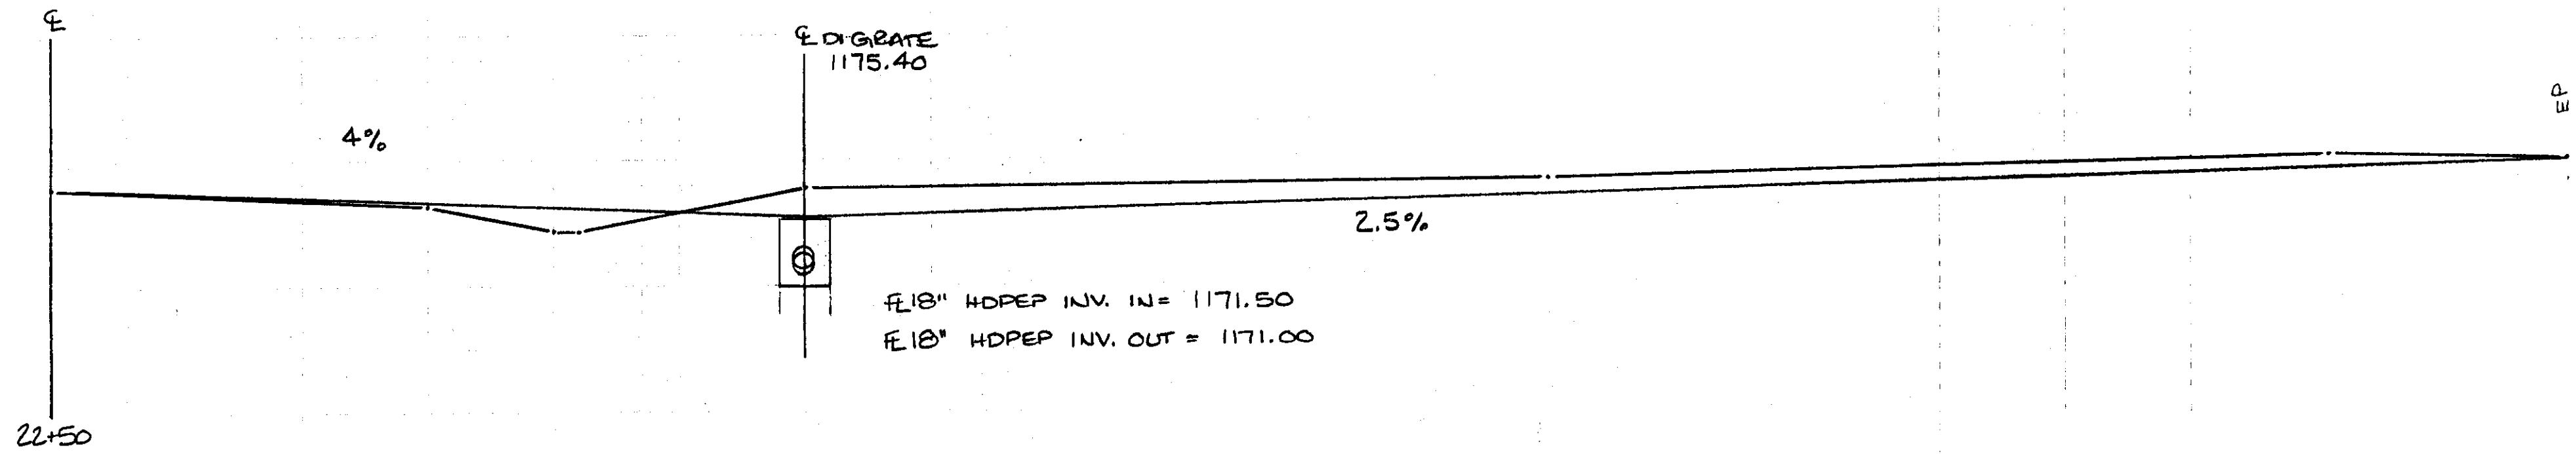

LYNDON AIRPORT
 SURVEY BY: D. BUMPS 4-5-0
 D. LUND
 J. COTA
 DRAWN BY: S. CLIFFORD 5-10-0
 SCALE: 1"=10' SHEET 7 OF

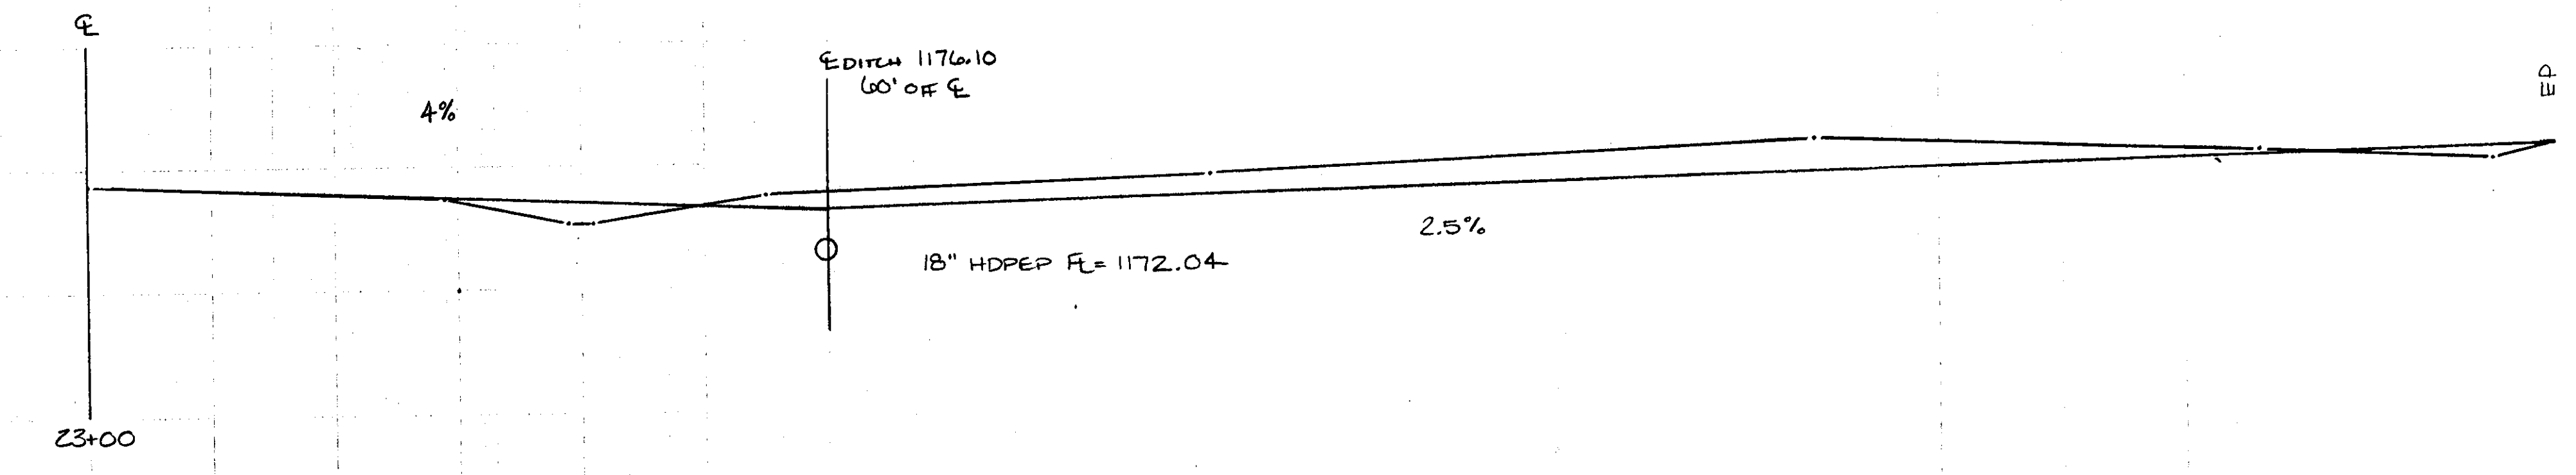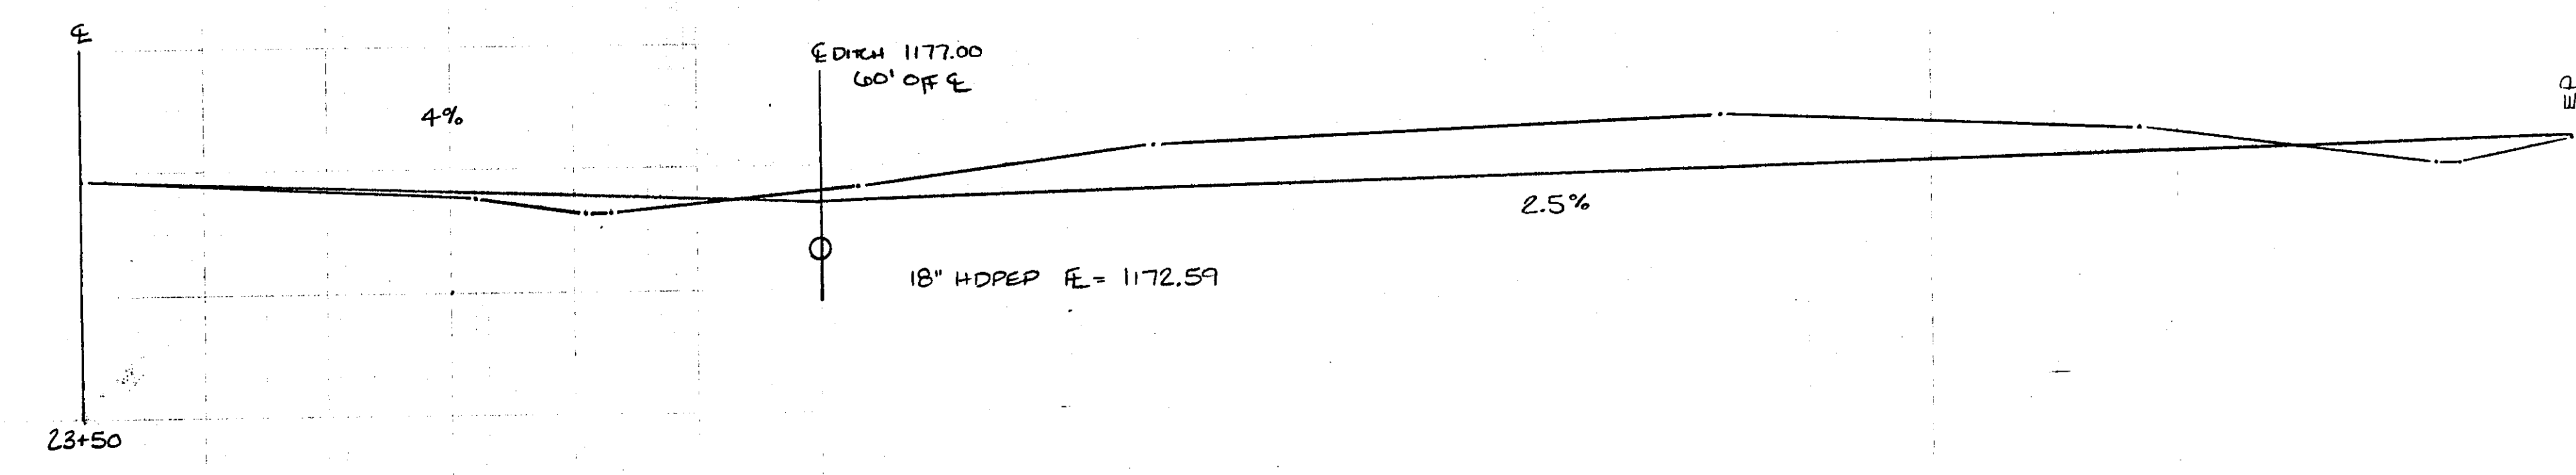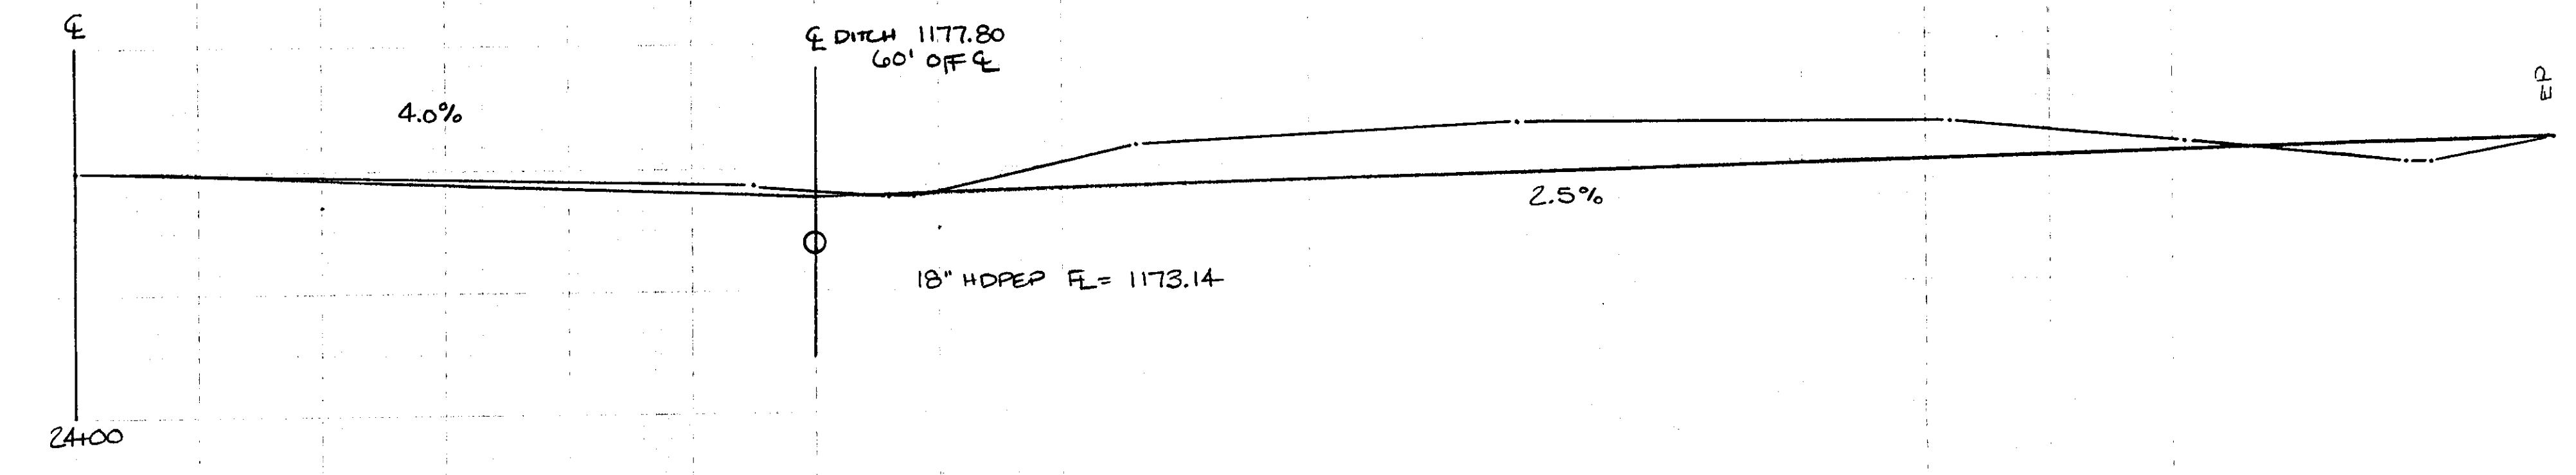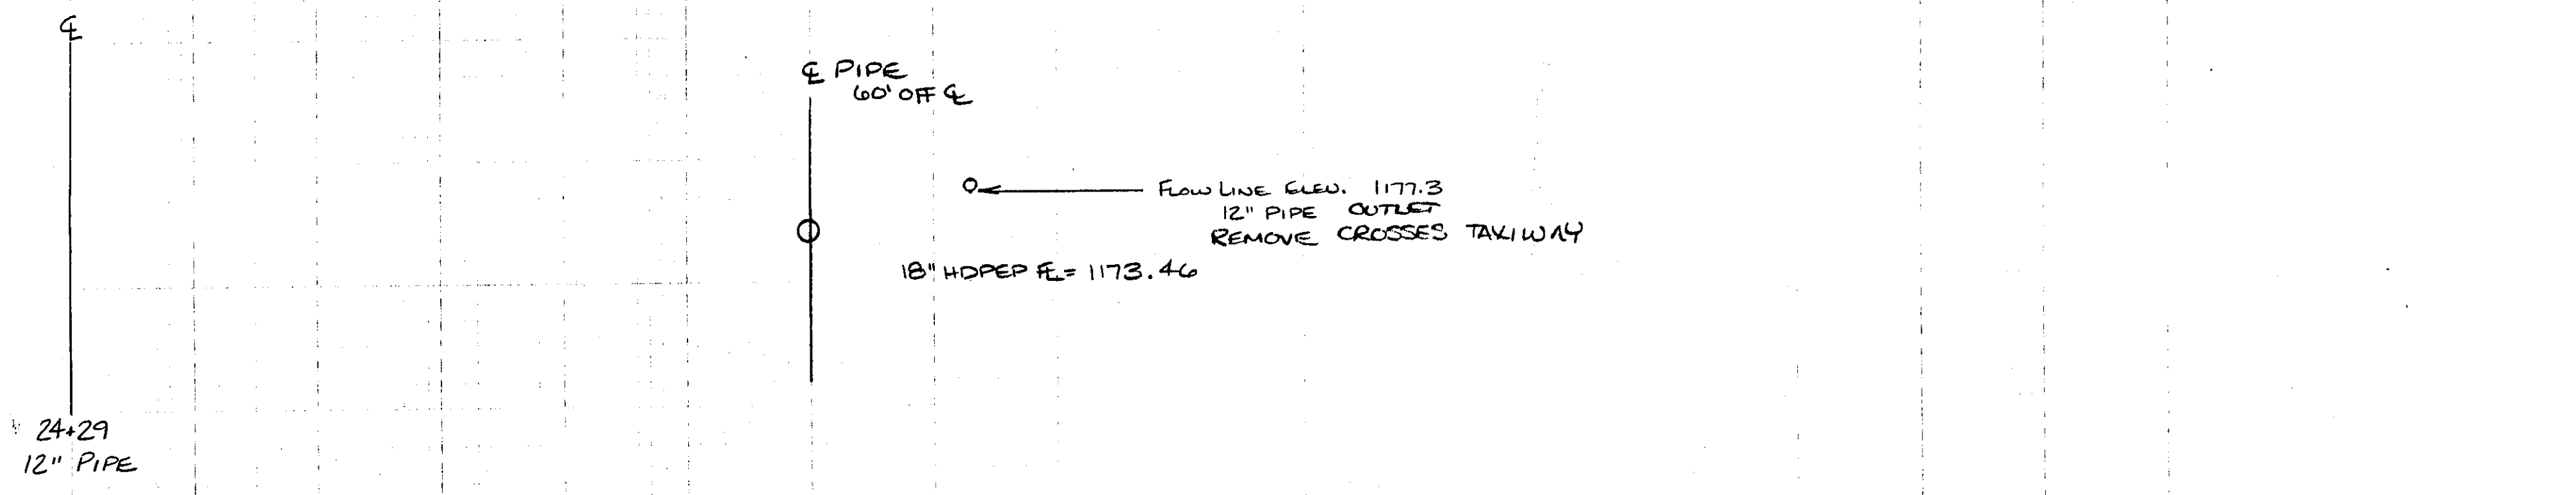

50





100

150





200

250





LYNDON AIRPORT
 SURVEY BY: D. BUMPS 4-5-00
 D. LUND
 J. COTA
 DRAWN BY: S. CLIFFORD 5-10-00
 SCALE: 1"=10' SHEET 8 OF

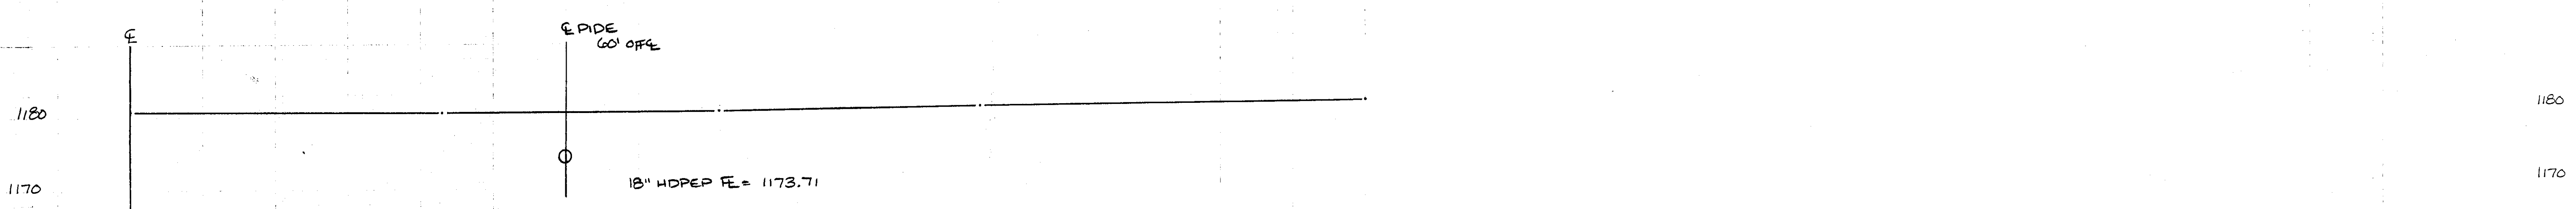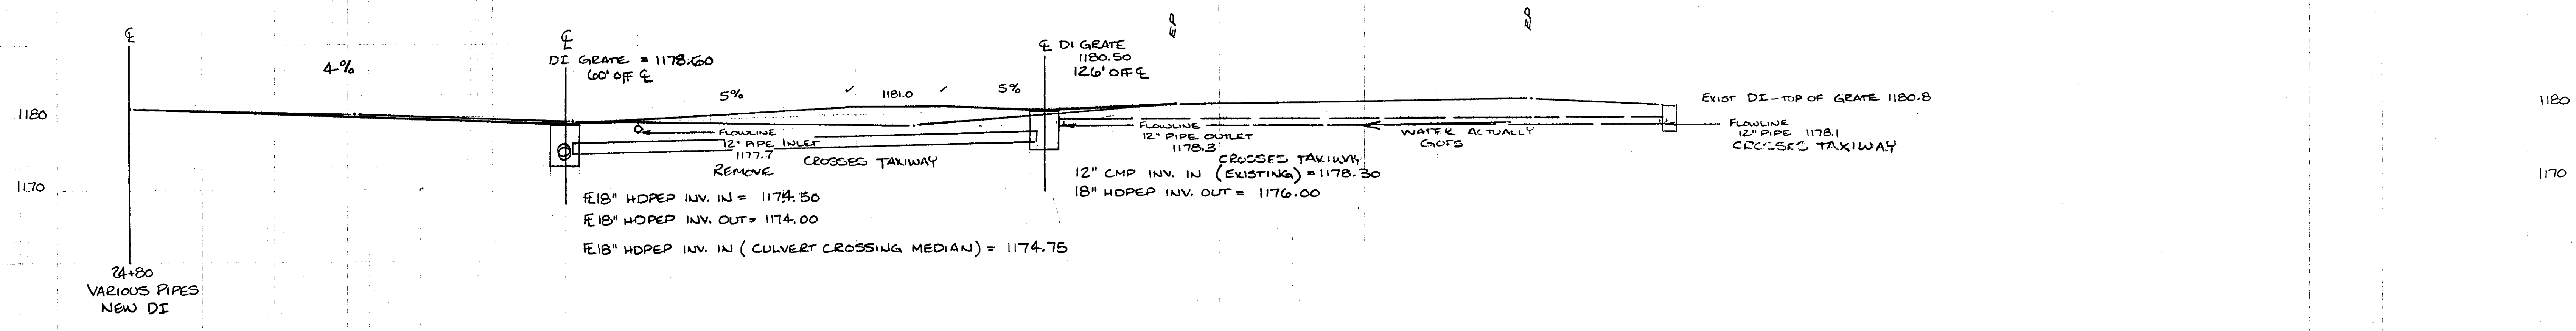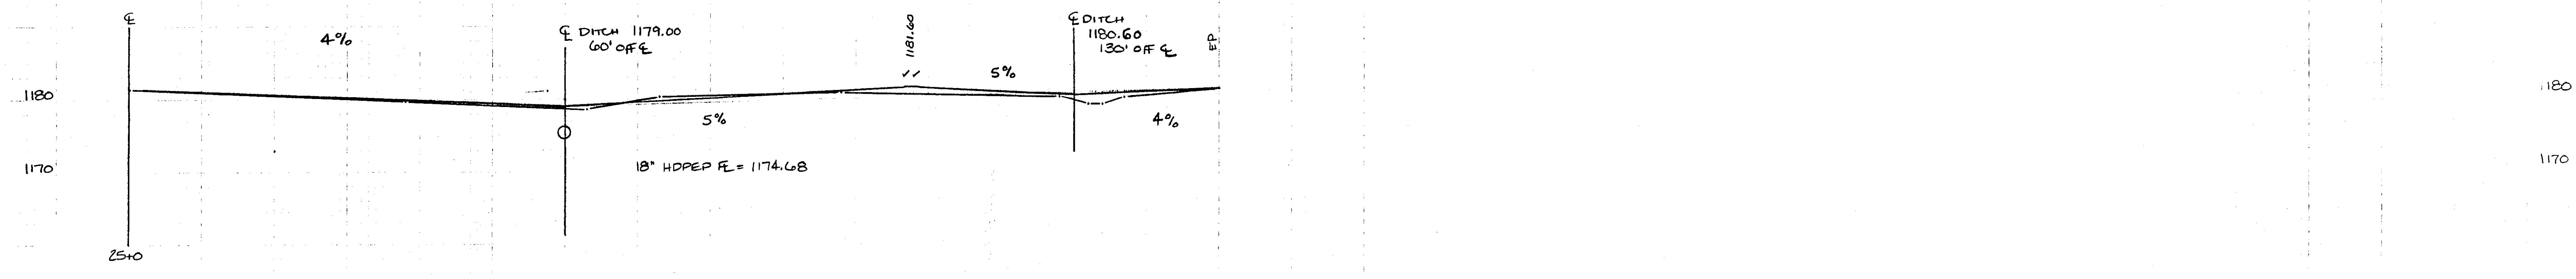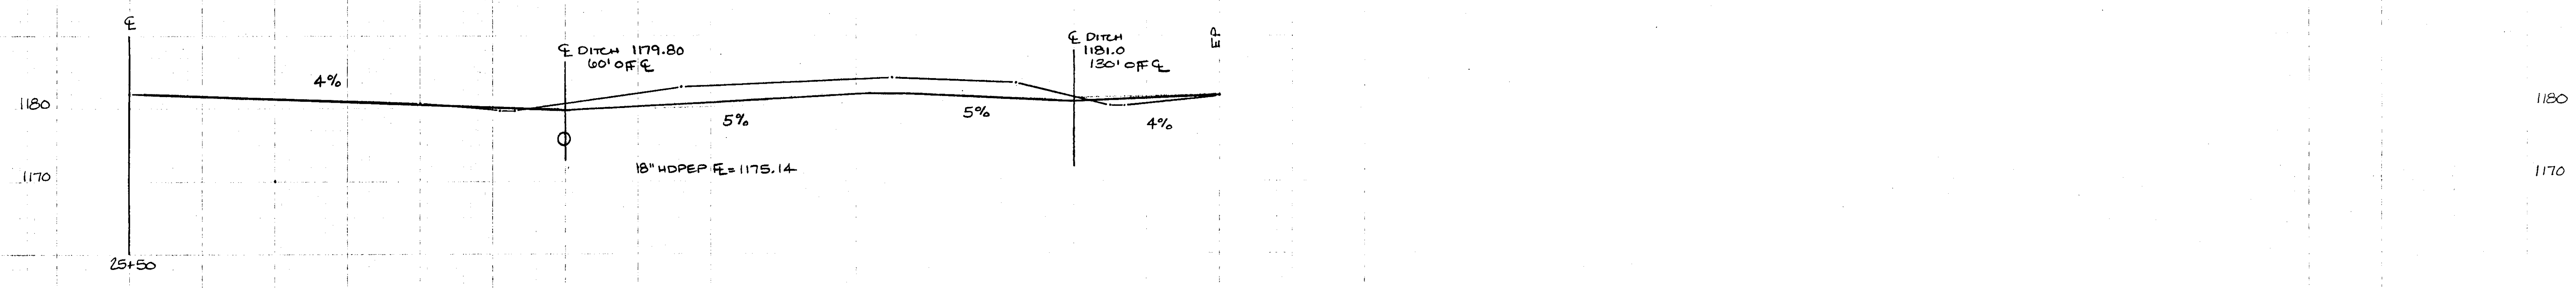


 SURVEY BY: D. BUMPS 4-5-00
 D. LUND
 J. COTA
 DRAWN BY: S. CLIFFORD 5-11-00
 SCALE: 1"=10' SHEET 9 OF 12

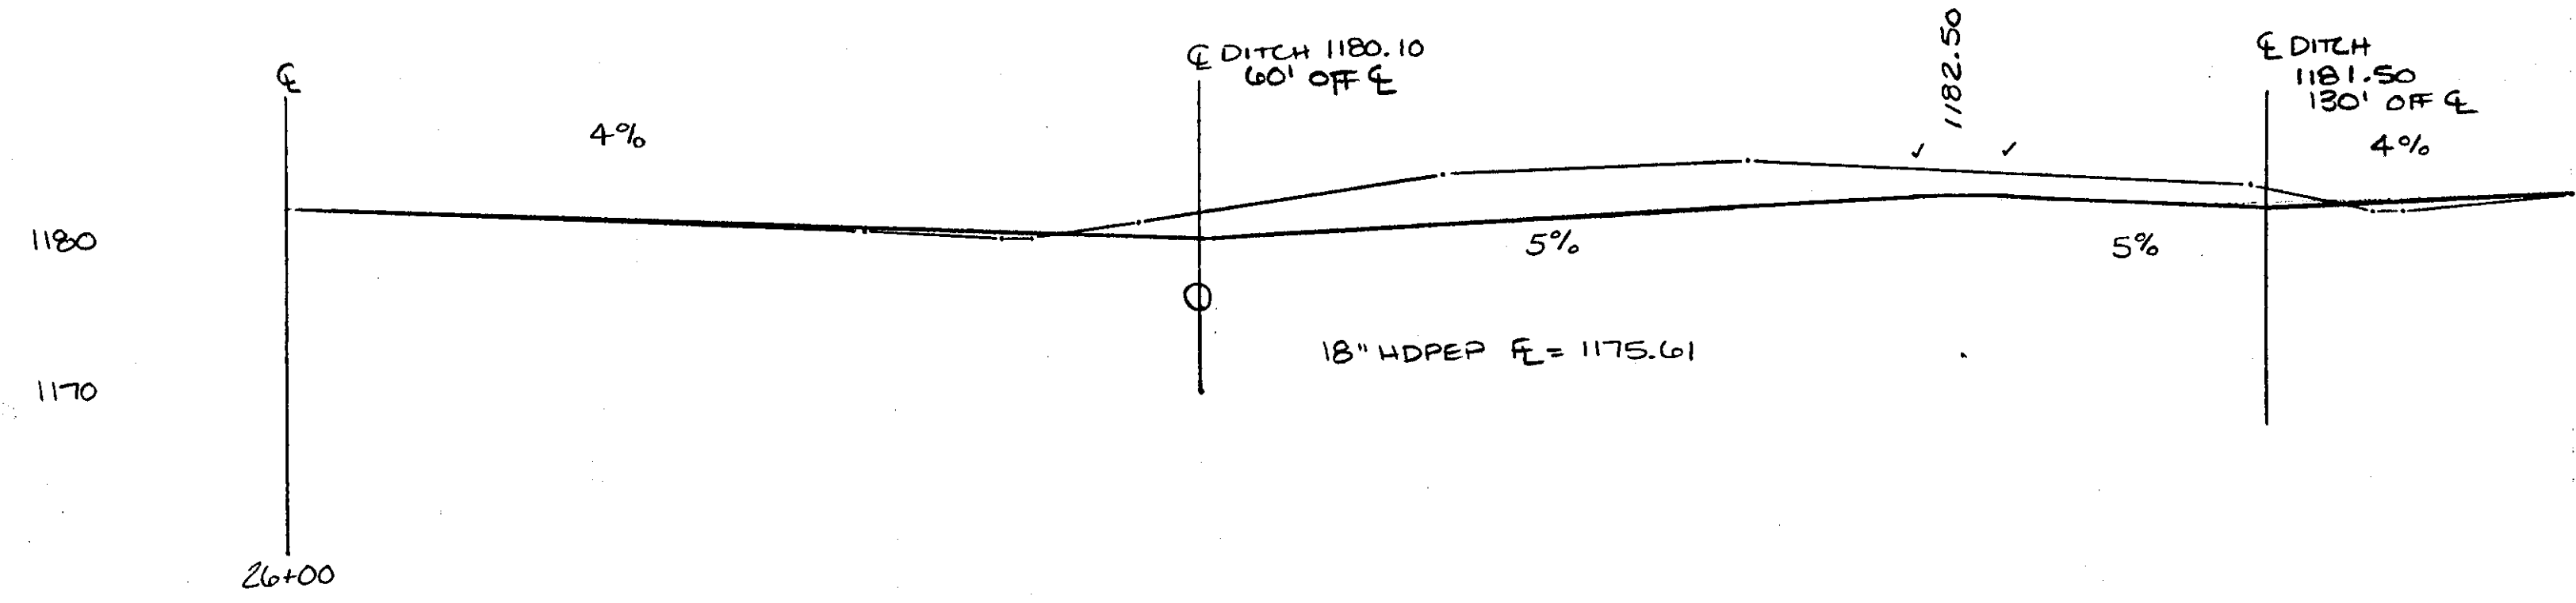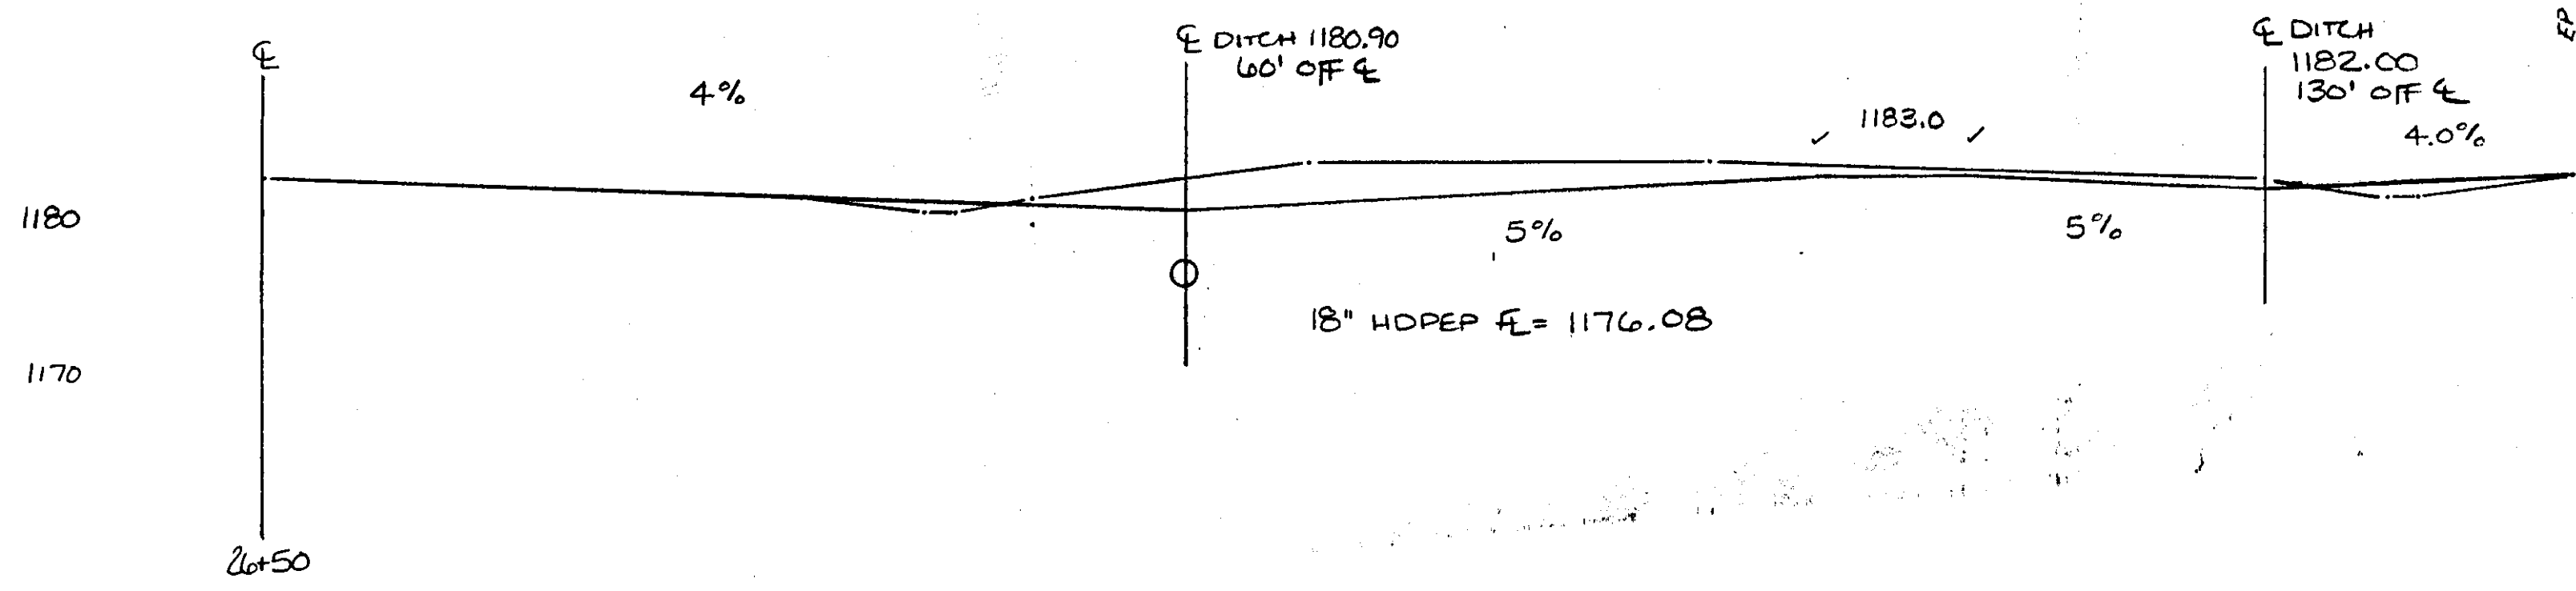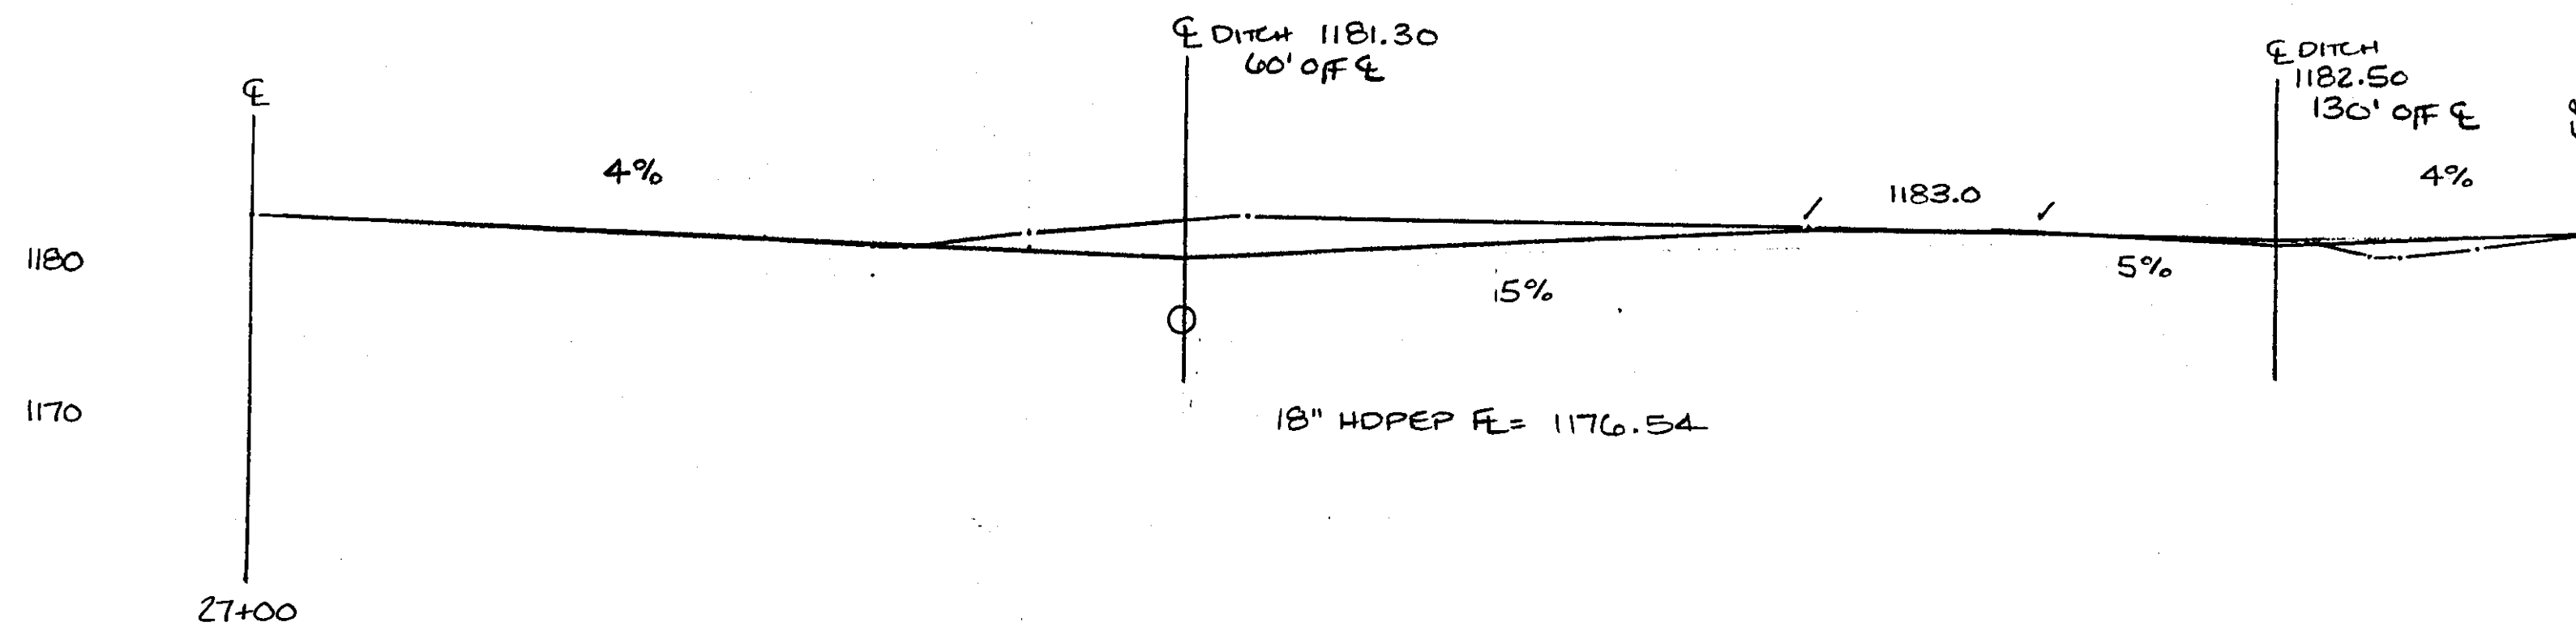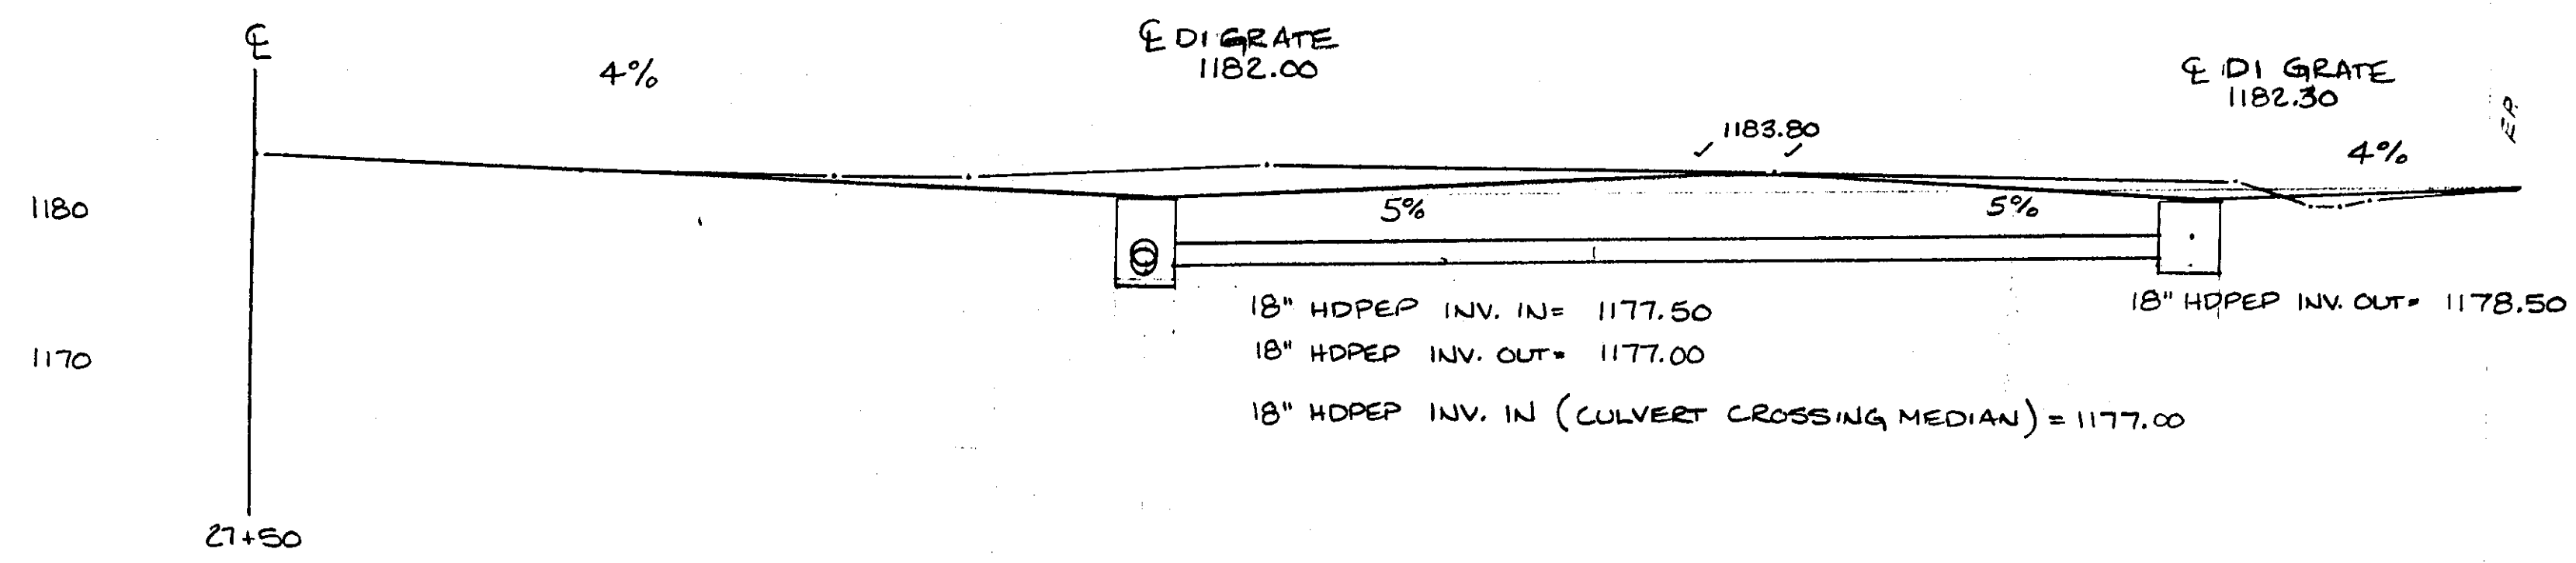

LYNDON AIRPORT
 SURVEY BY: D. BUMPS 4-5-00
 D. LUND
 J. COTA
 DRAWN BY: S. CLIFFORD 5-1-00
 SCALE: 1"=10' SHEET 10 OF 11

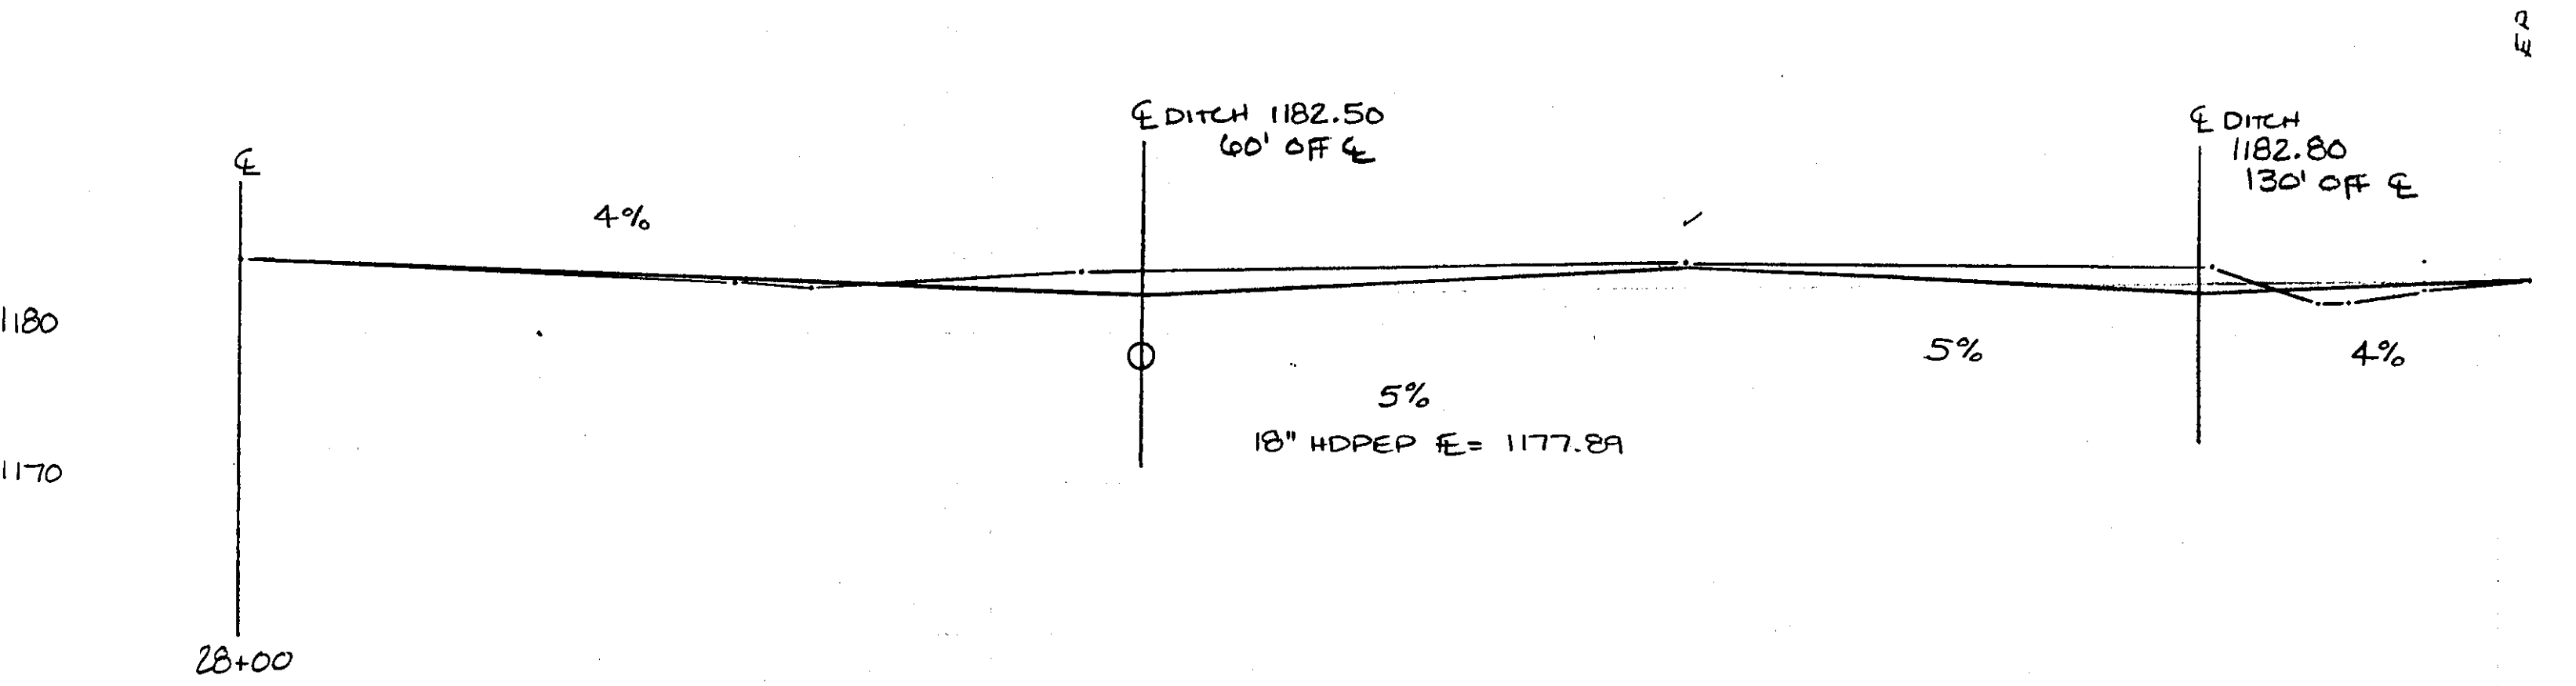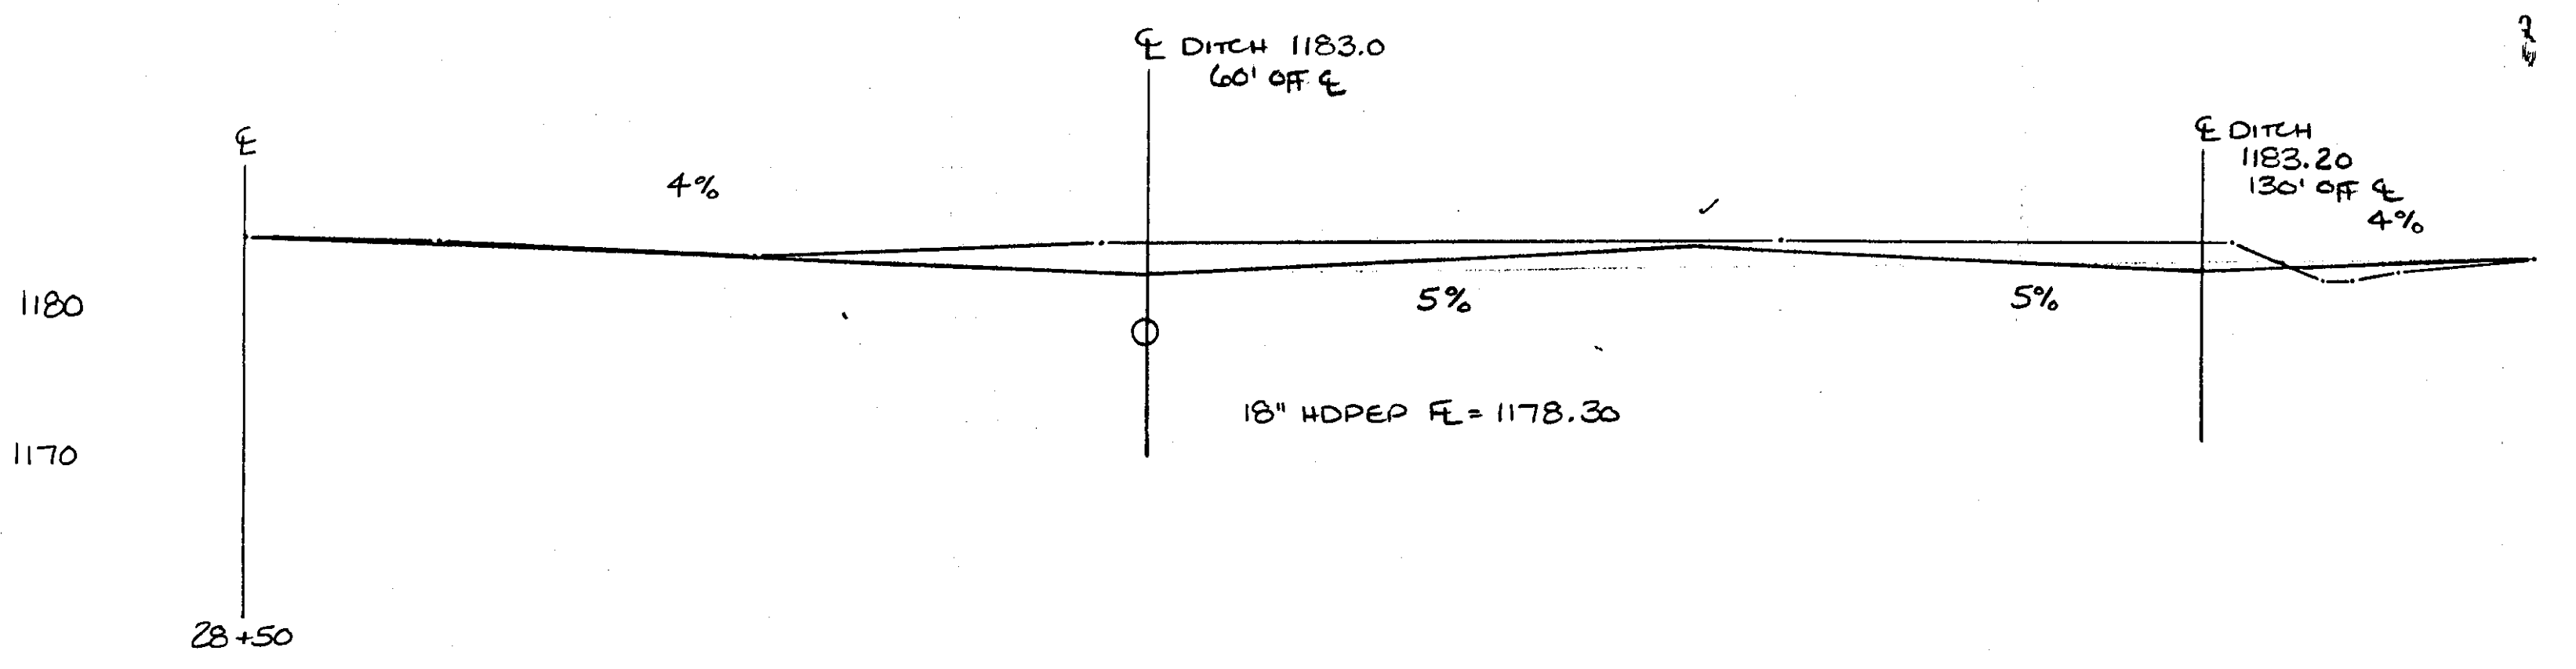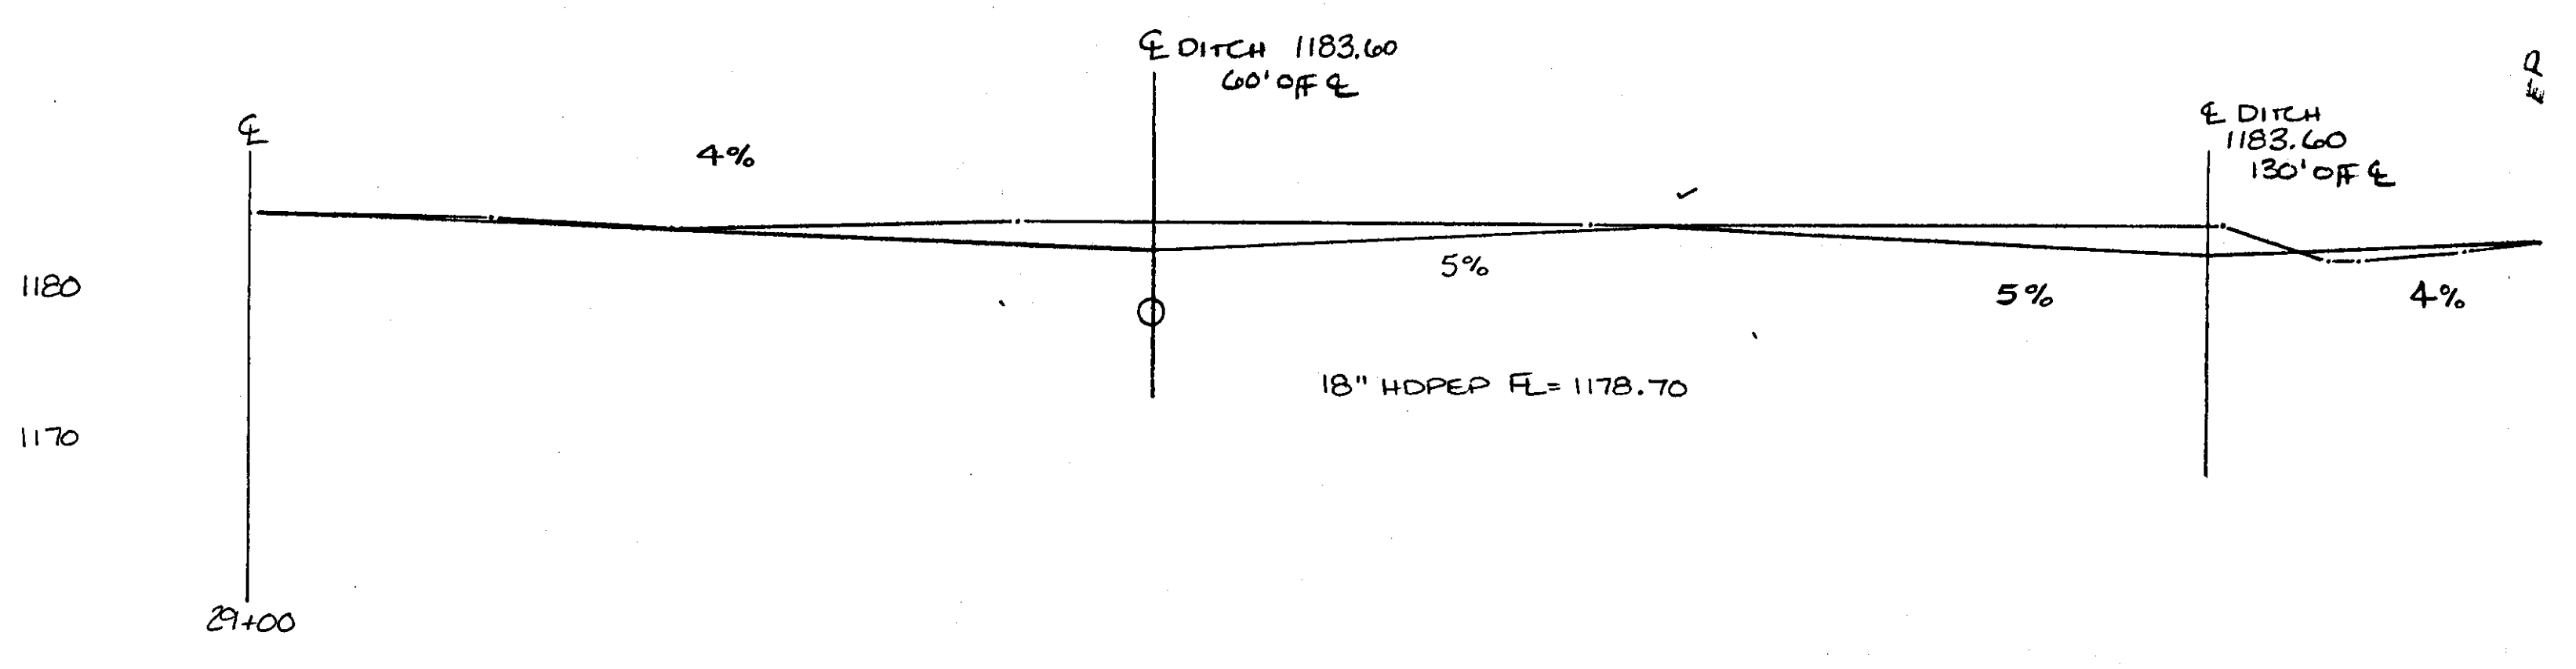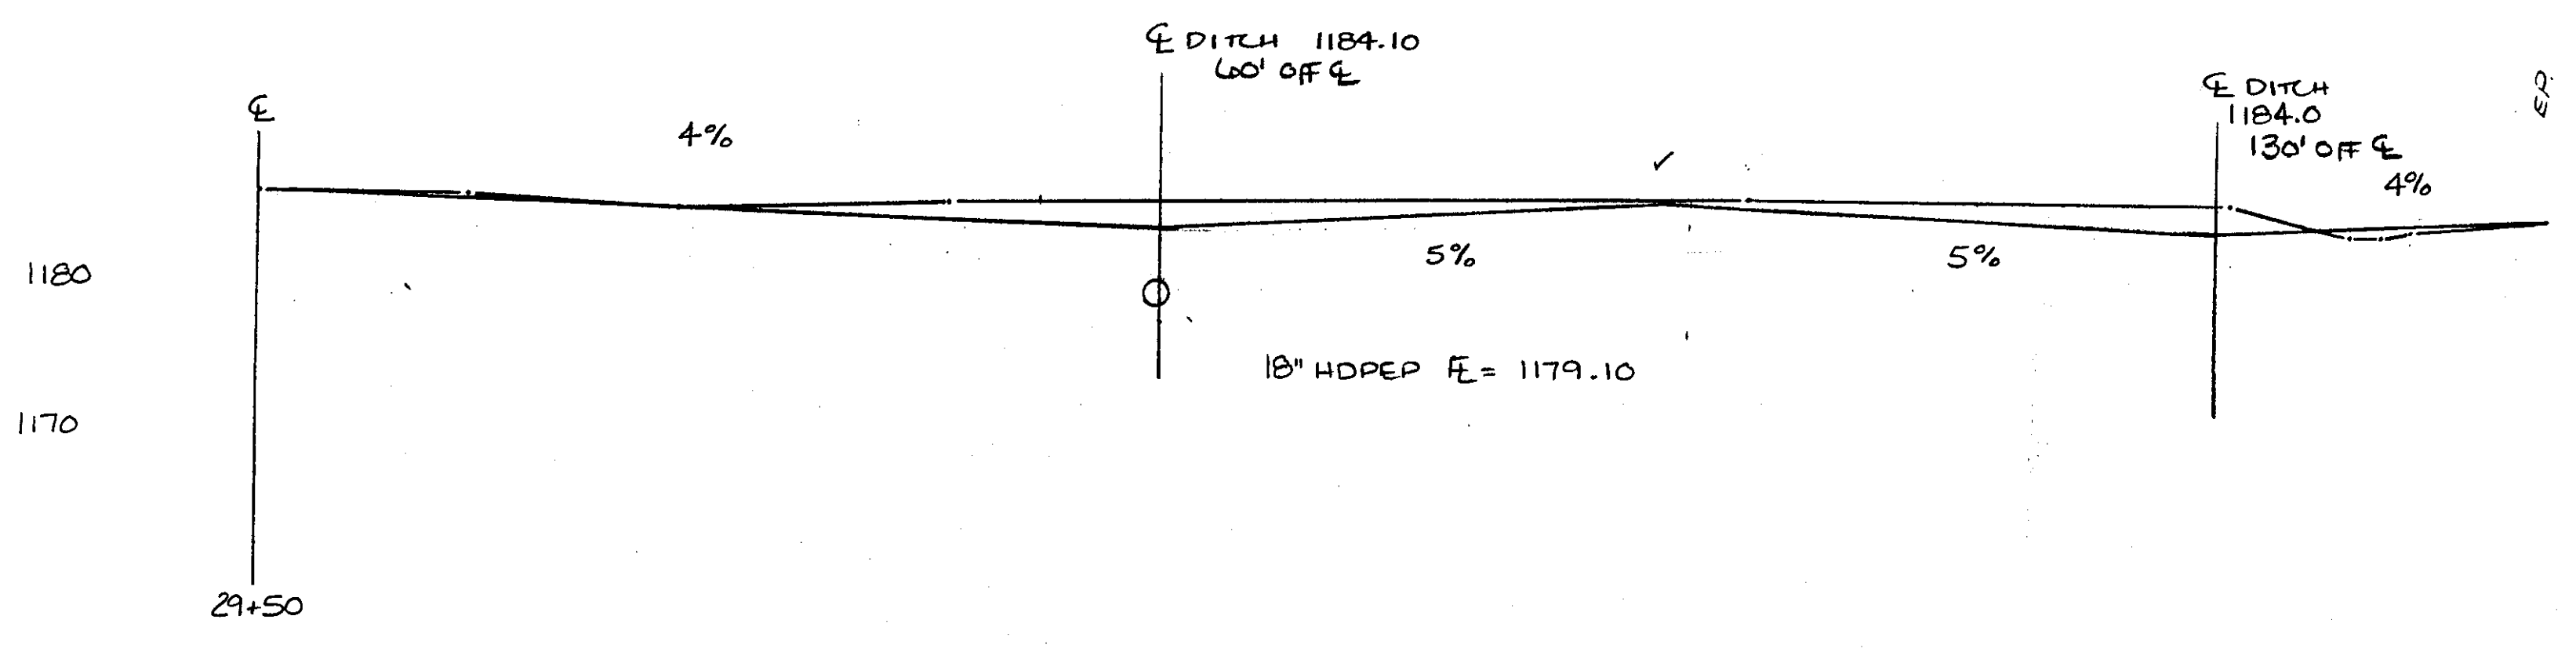

LYNDON AIRPORT
 SURVEY BY: D. BUMPS 4-5-00
 D. LUND
 J. COTA
 DRAWN BY: S. CLIFFORD 5-11-00
 SCALE: 1" = 10' SHEET 11 OF 12

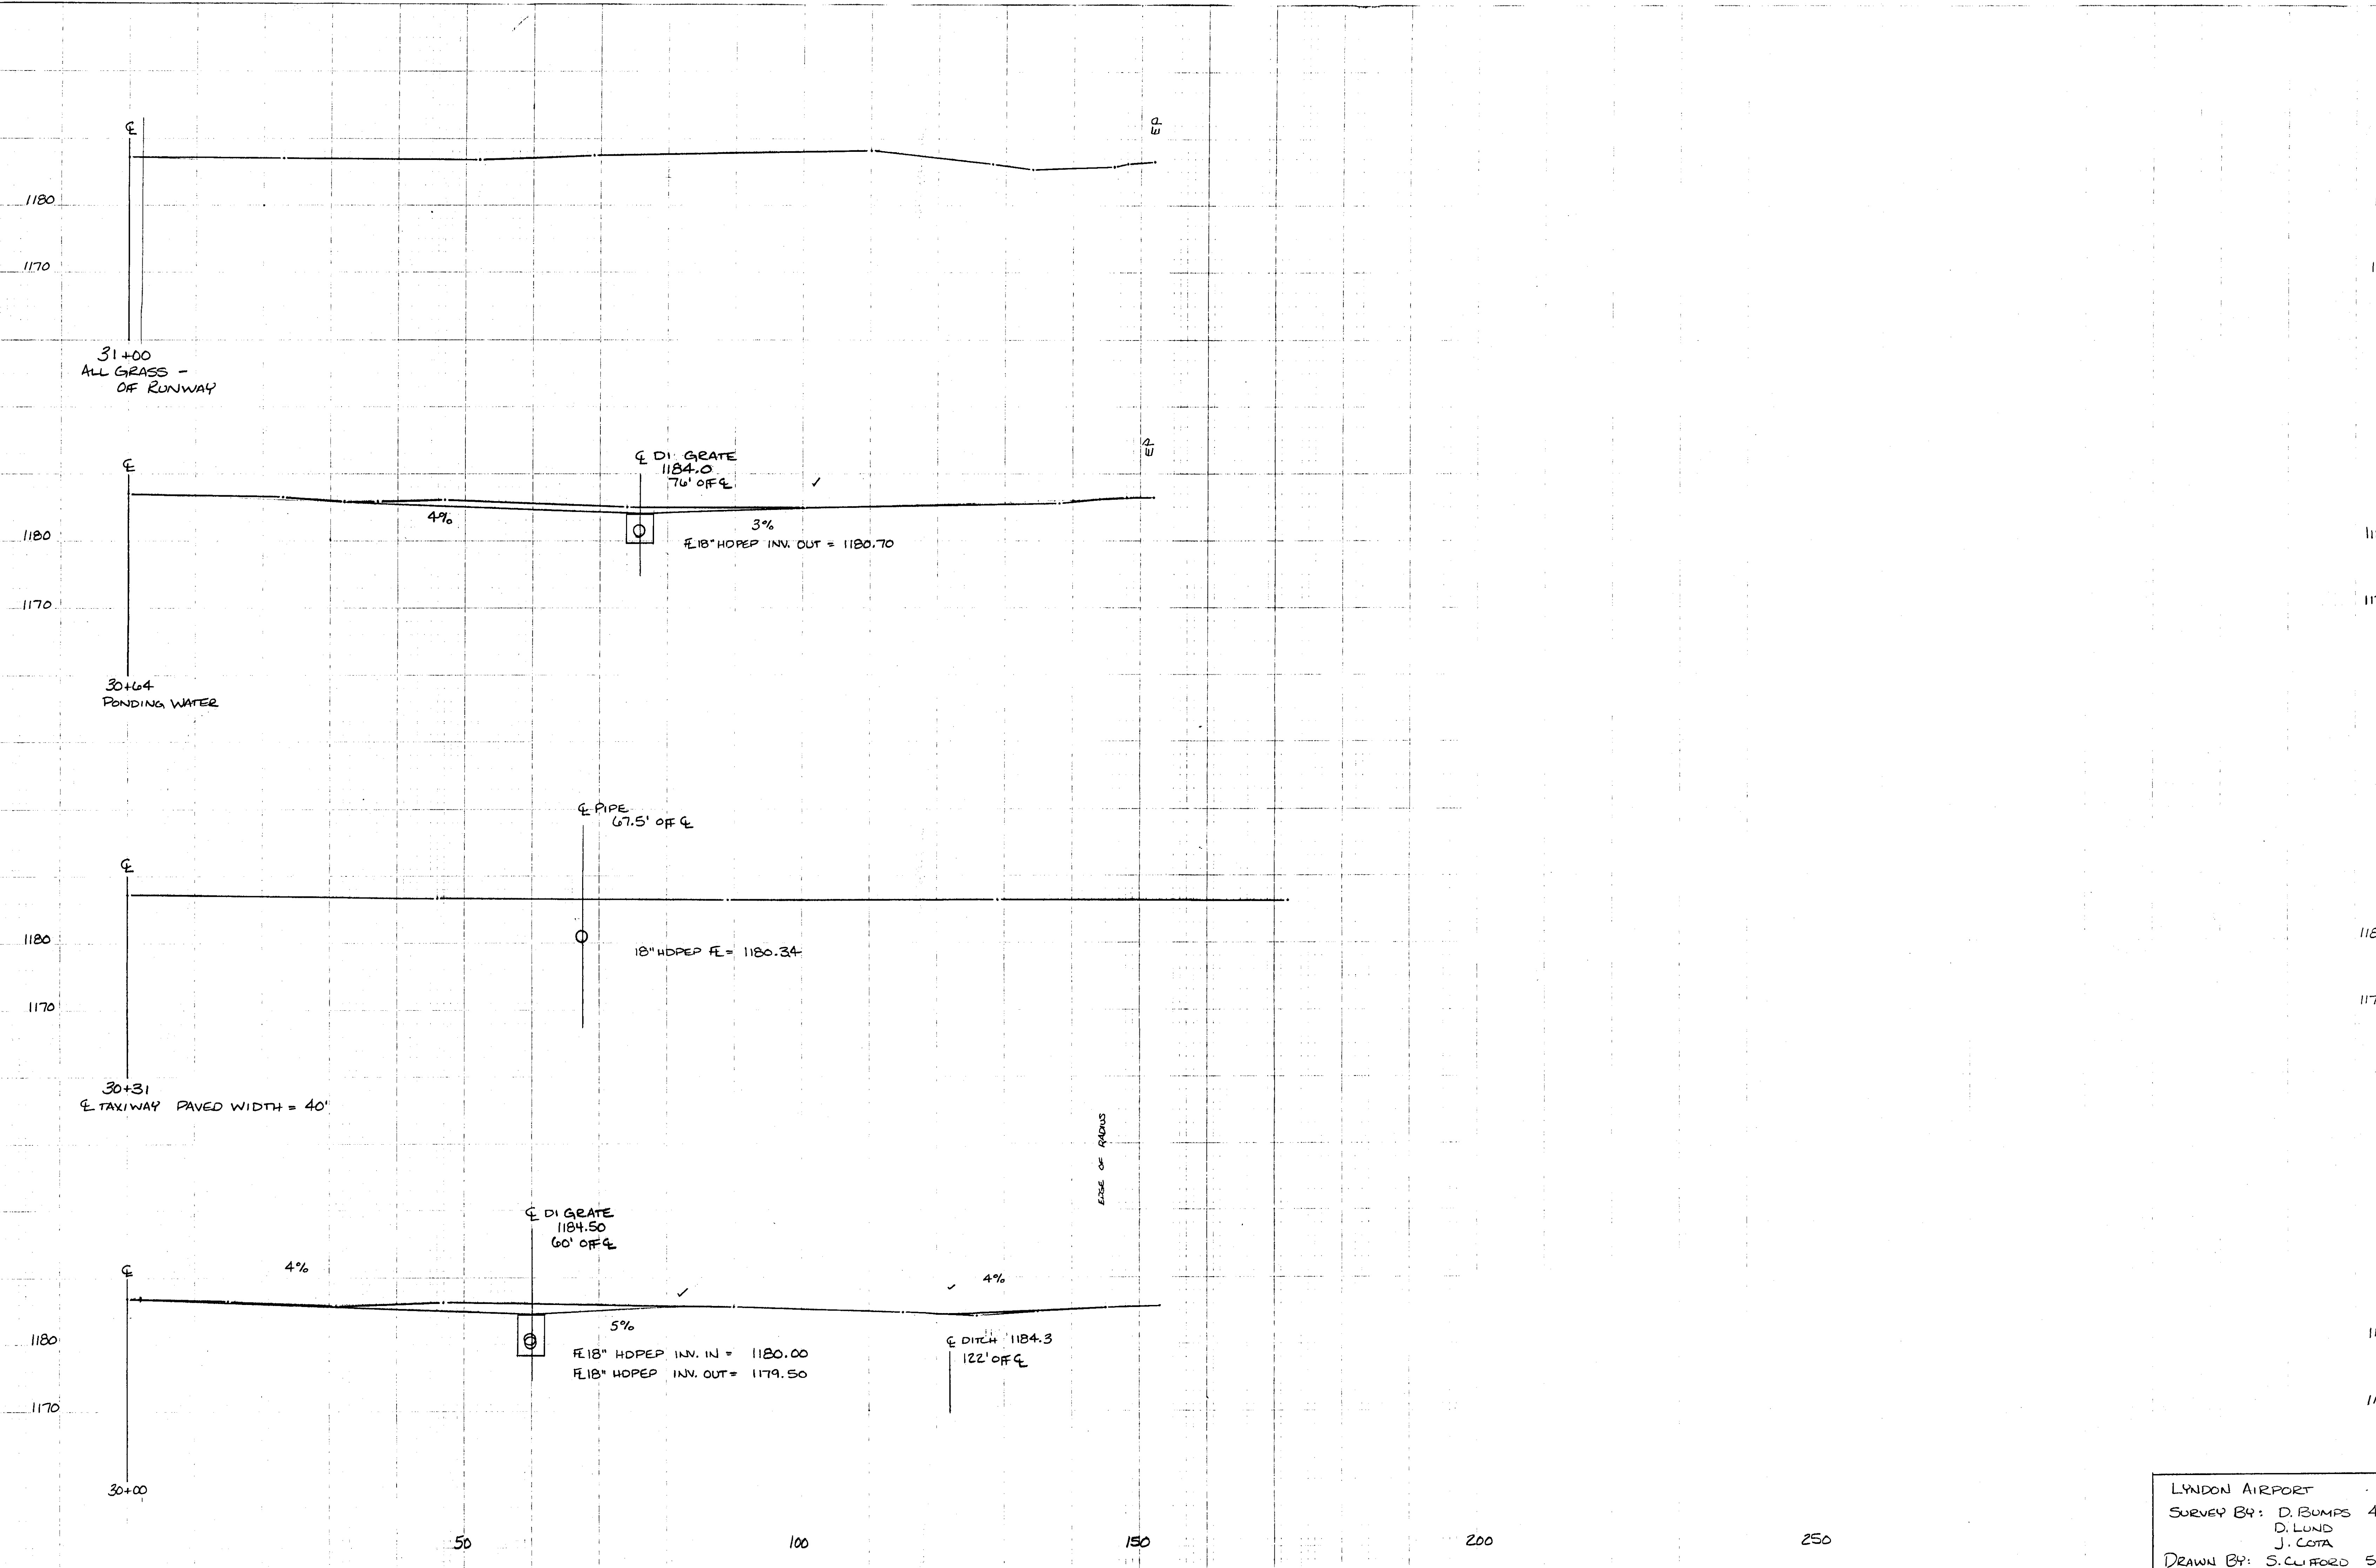

LYNDON AIRPORT
 SURVEY BY: D. BUMPS 4-5-
 D. LUND
 J. COTA
 DRAWN BY: S. CLIFFORD 5-11-
 SCALE: 1" = 10' SHEET 12 OF