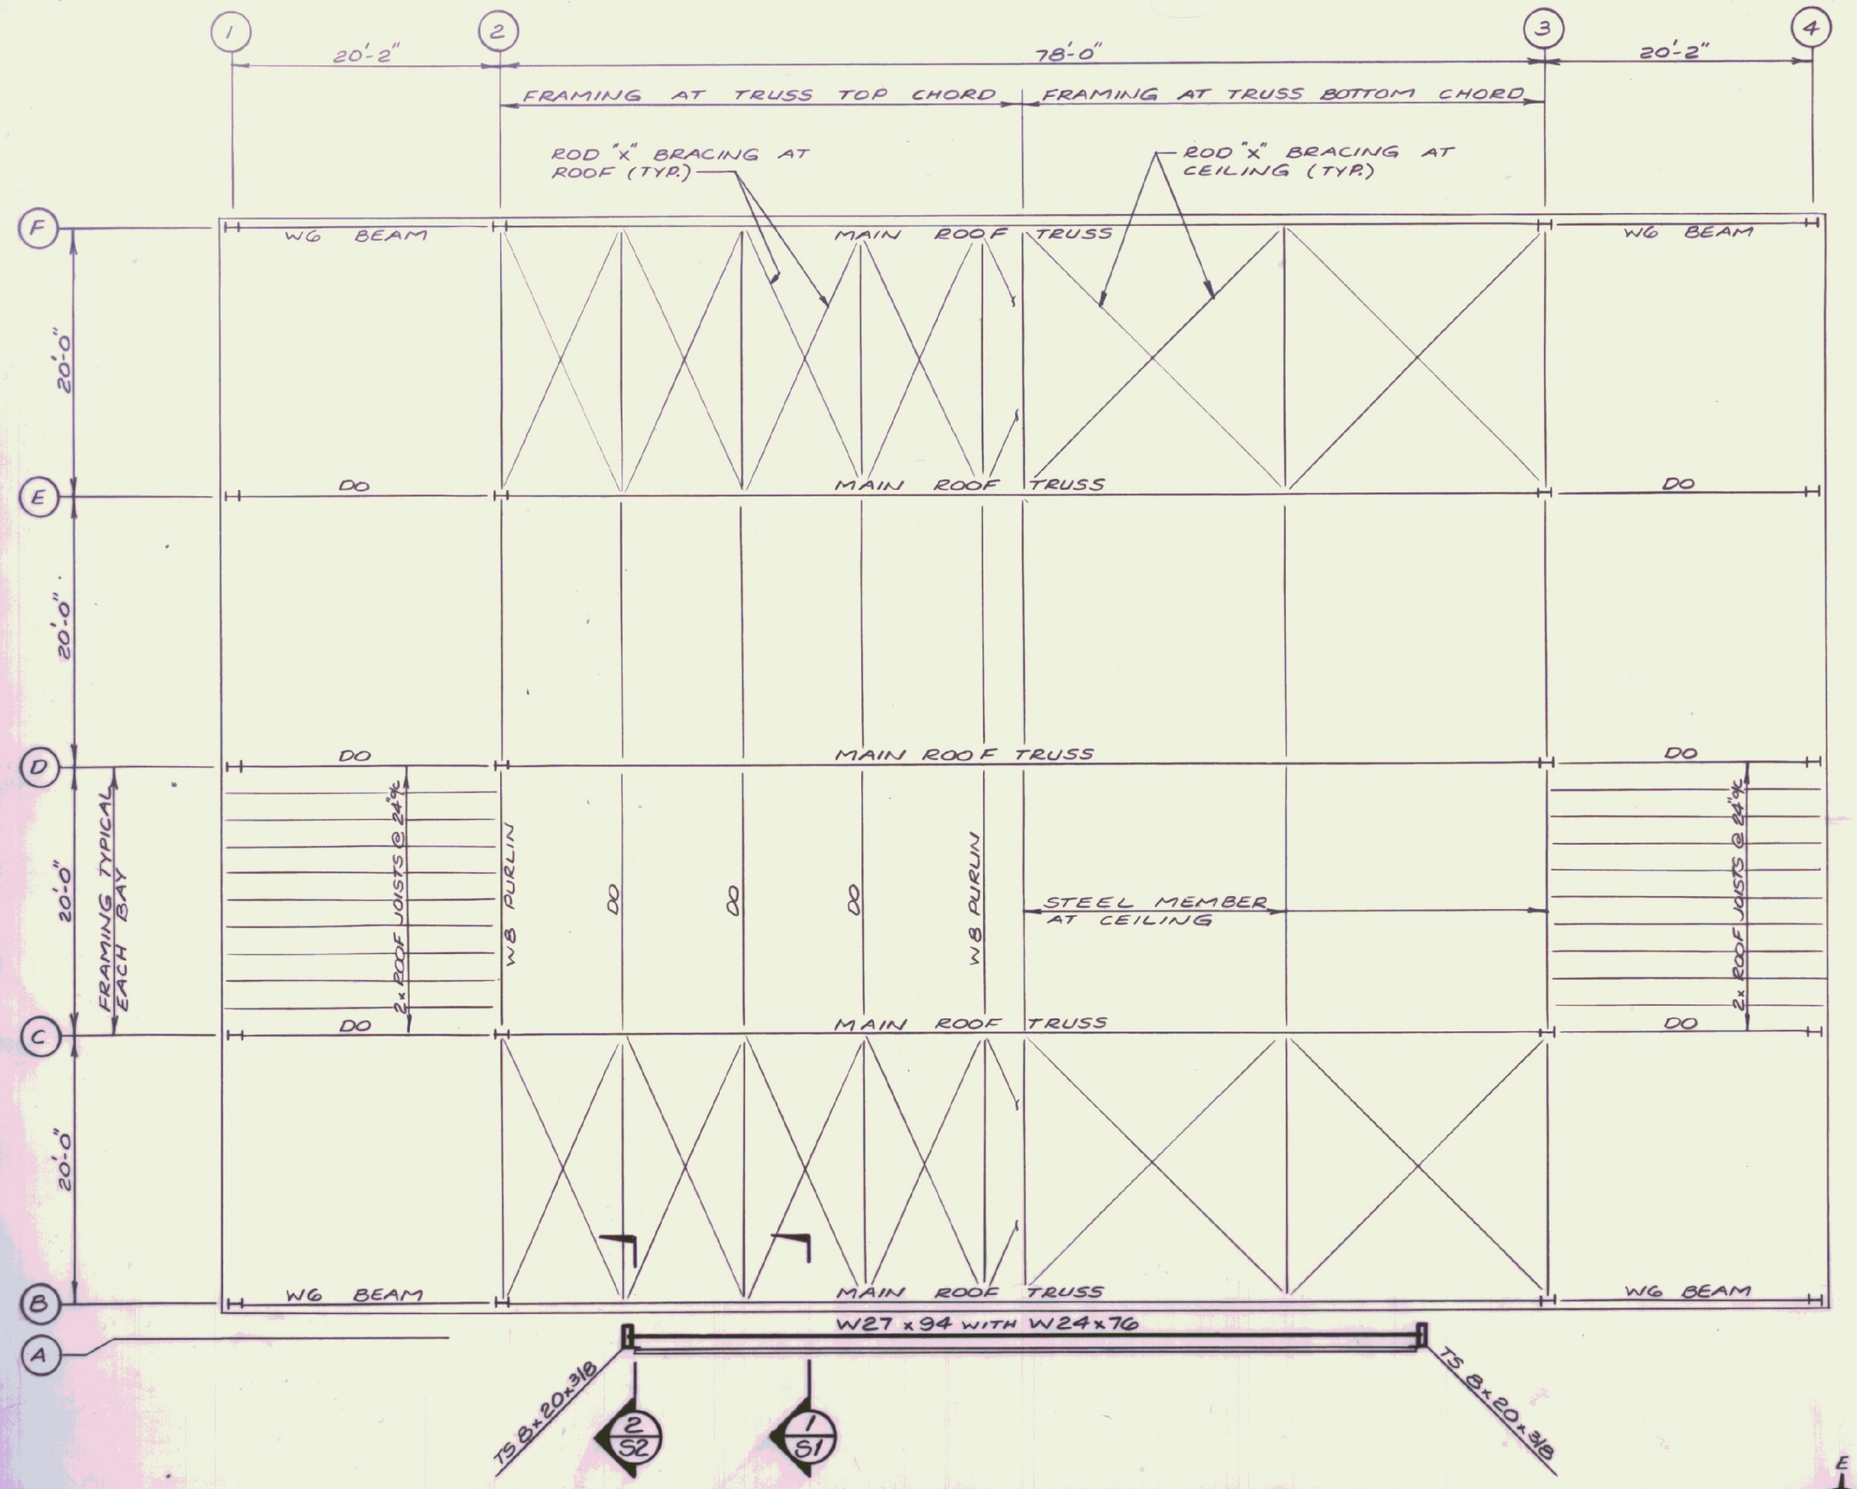

ROOF/CEILING FRAMING PLAN

SCALE: 1/8"=1'-0"

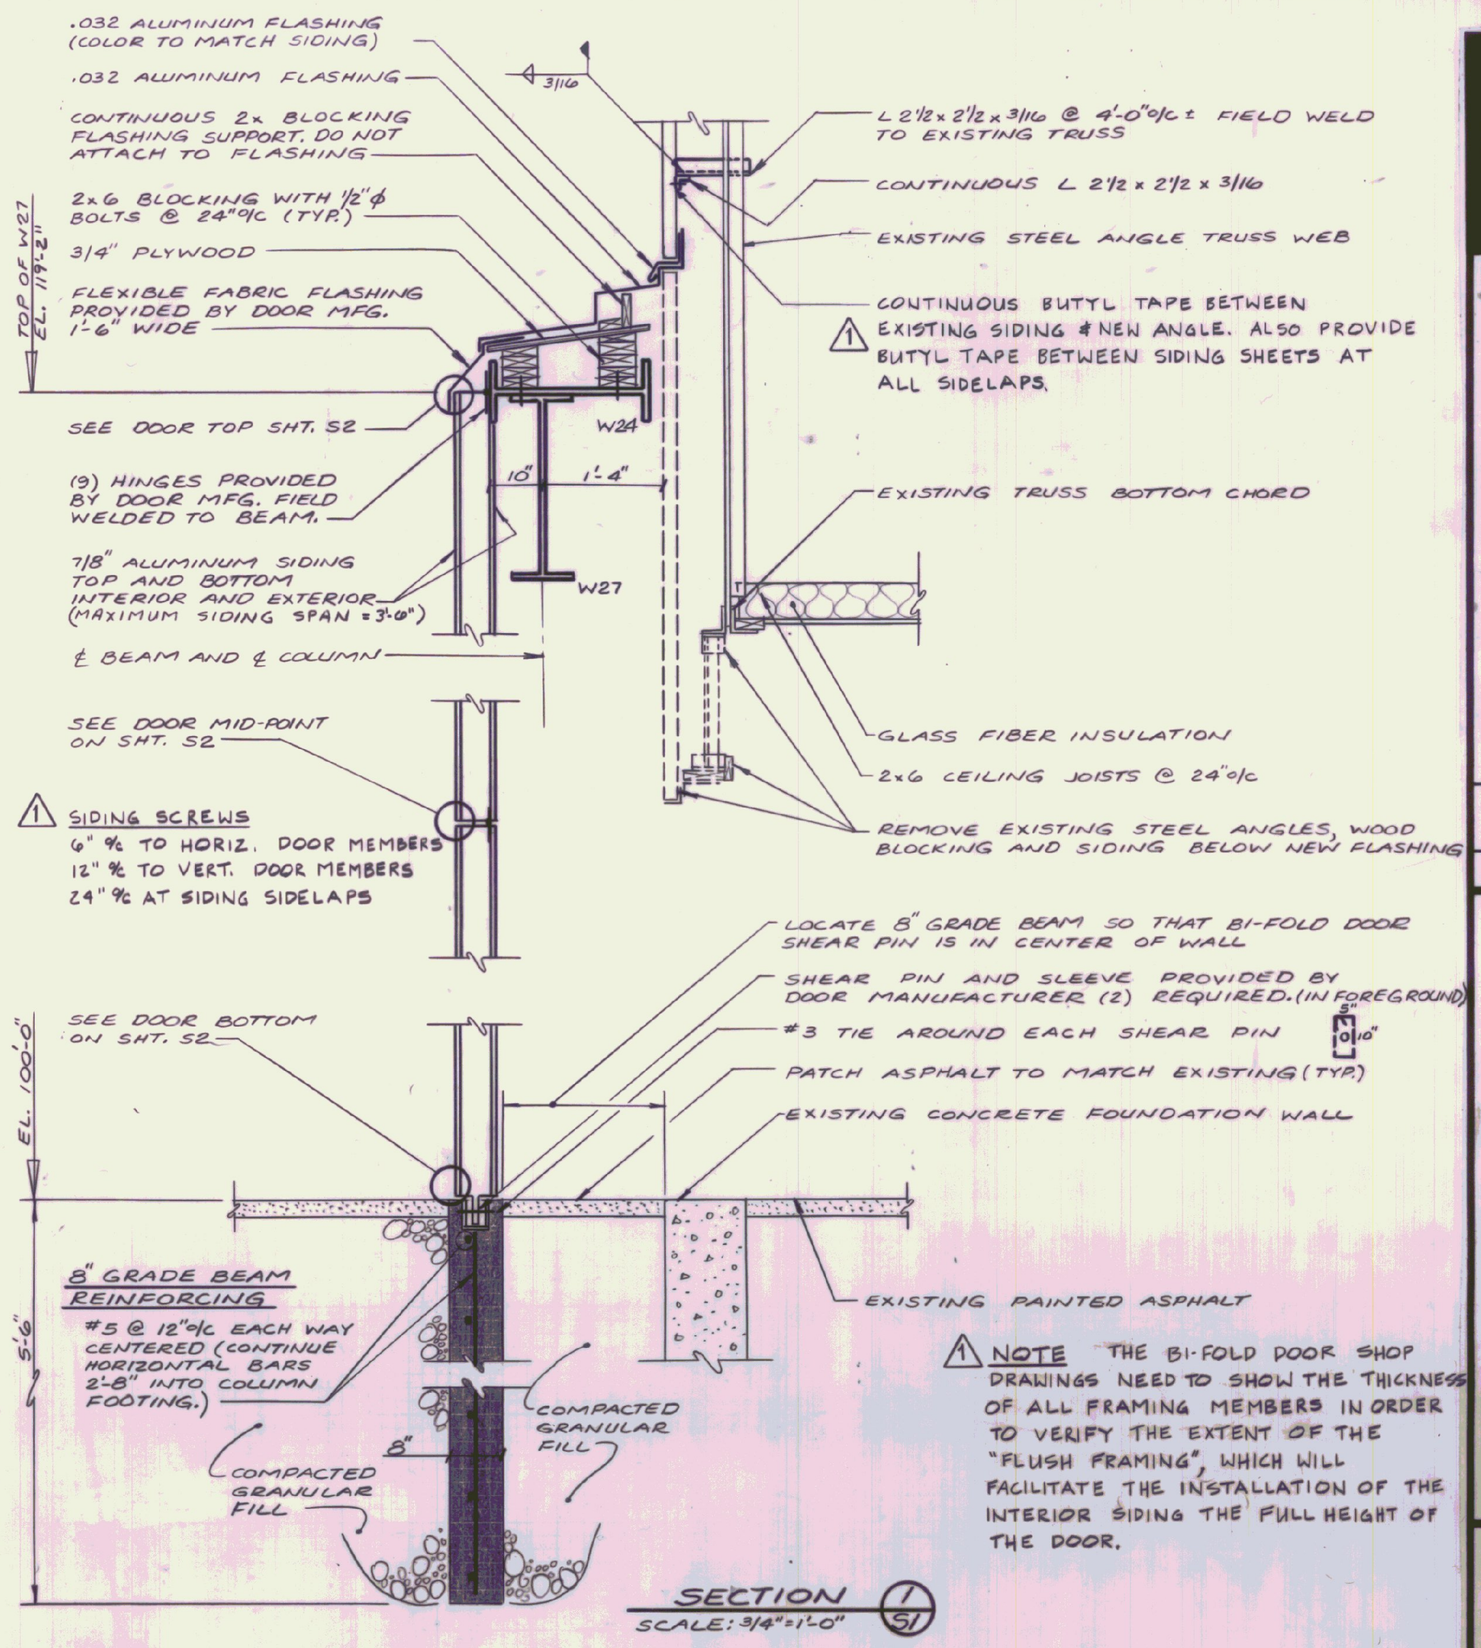

NOTE THE BI-FOLD DOOR SHOP DRAWINGS NEED TO SHOW THE THICKNESS OF ALL FRAMING MEMBERS IN ORDER TO VERIFY THE EXTENT OF THE "FLUSH FRAMING", WHICH WILL FACILITATE THE INSTALLATION OF THE INTERIOR SIDING THE FULL HEIGHT OF THE DOOR.

SECTION 1/S1

SCALE: 3/4"=1'-0"

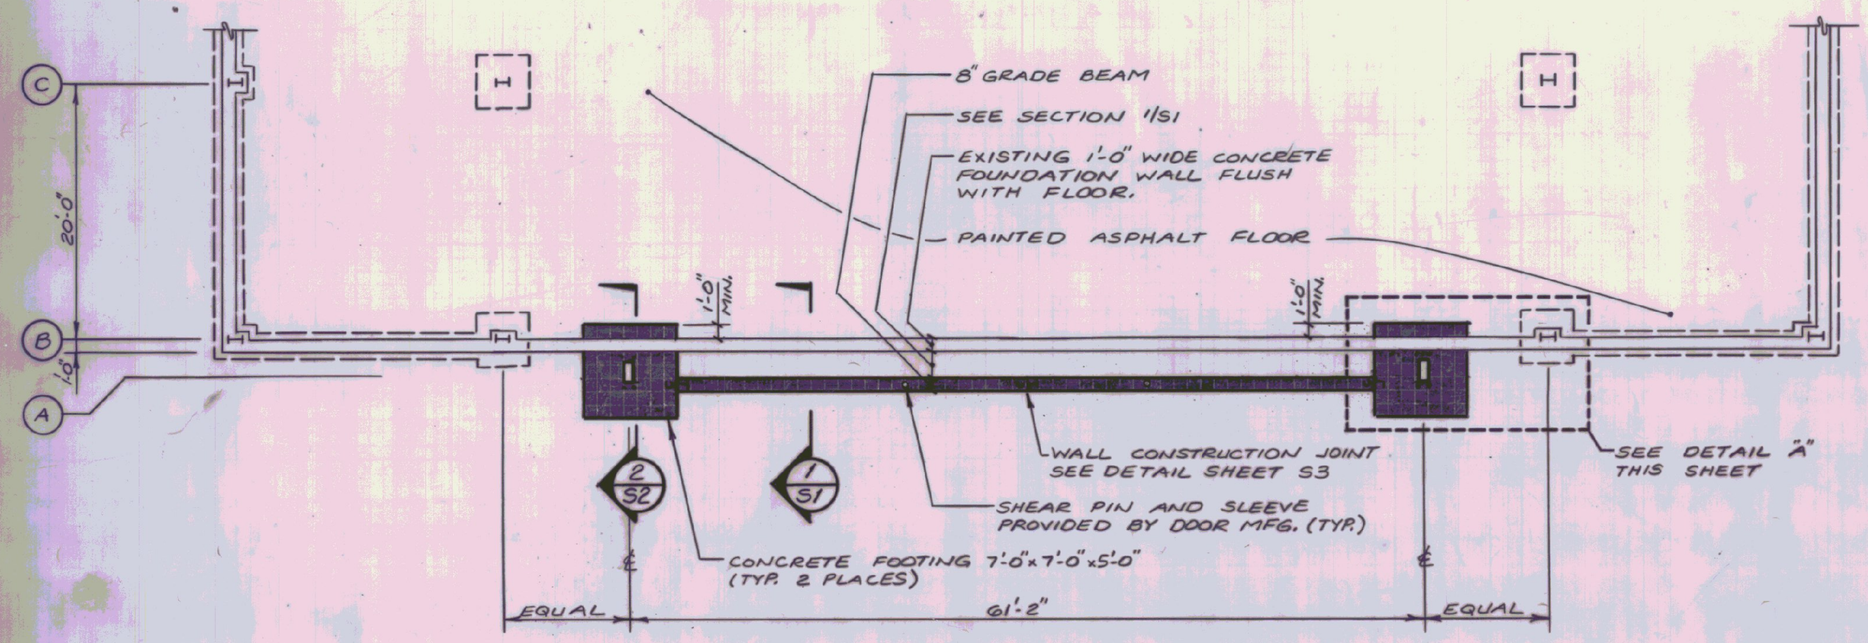

PARTIAL FOUNDATION PLAN

SCALE: 1/8"=1'-0"

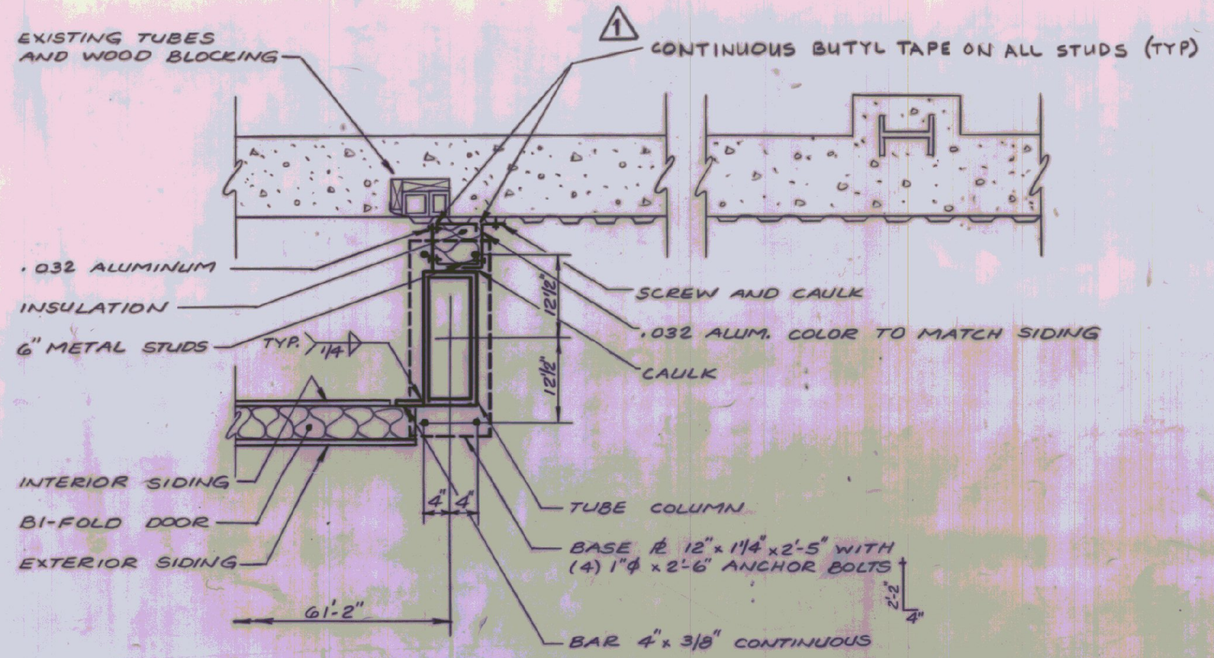

DETAIL "A"

SCALE: 3/4"=1'-0"

STATE OF VERMONT
STEPHEN K. COLLINS
NO. 5133
REGISTERED PROFESSIONAL ENGINEER

No.	DATE	REVISION
1	4-29-87	MISC. NOTES ADDED

Lawes Consulting Engineers, Inc.
ROUTE 2A WILLISTON, VERMONT 05495

HANGAR DOOR
FRANKLIN COUNTY STATE AIRPORT
HIGHGATE, VERMONT

PLANS, DETAILS AND SECTIONS

DRAWN	PROJ. No.
SOMA	86114
CHECKED	DATE
SKC/DWL	1/26/87

S1