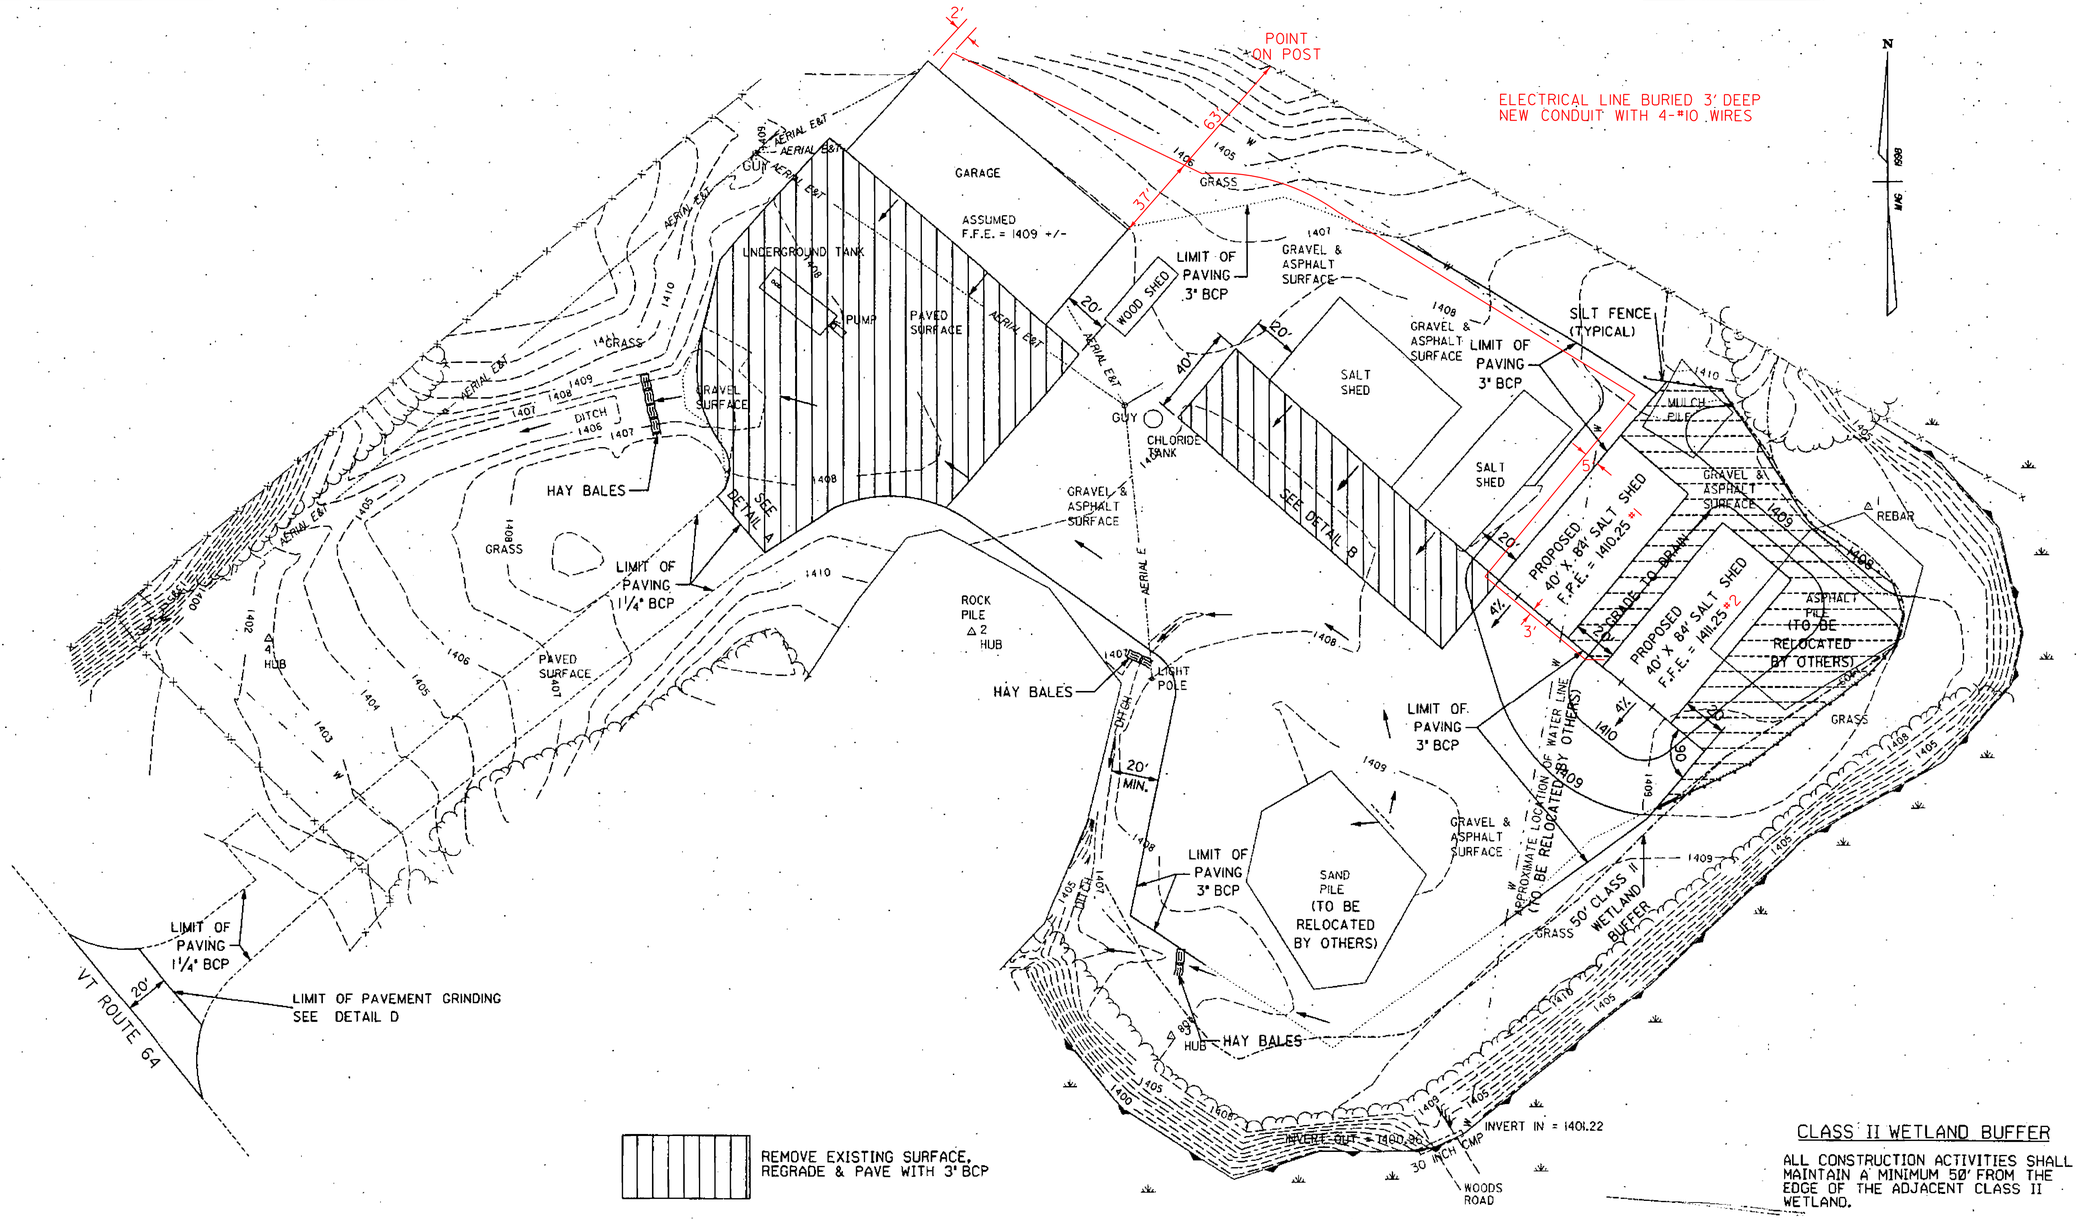

CLASS II WETLAND BUFFER

ALL CONSTRUCTION ACTIVITIES SHALL MAINTAIN A MINIMUM 50' FROM THE EDGE OF THE ADJACENT CLASS II WETLAND.

PROJECT: WILLIAMSTOWN SALT SHED	PROJECT NO.: STP SALT(S)S
DESIGN FILE NAME: 98212BDR.DGN	
IPARM FILE NAME:	PLOT DATE: 13 AUG 98
SURVEYED BY: CLD ENGINEERS	SURVEY DATE: 7/98
SQUAD LEADER: J. WARNER	DRAWN BY: T. LUTHER
	SHEET: 3 OF 5

AUG 13 1998