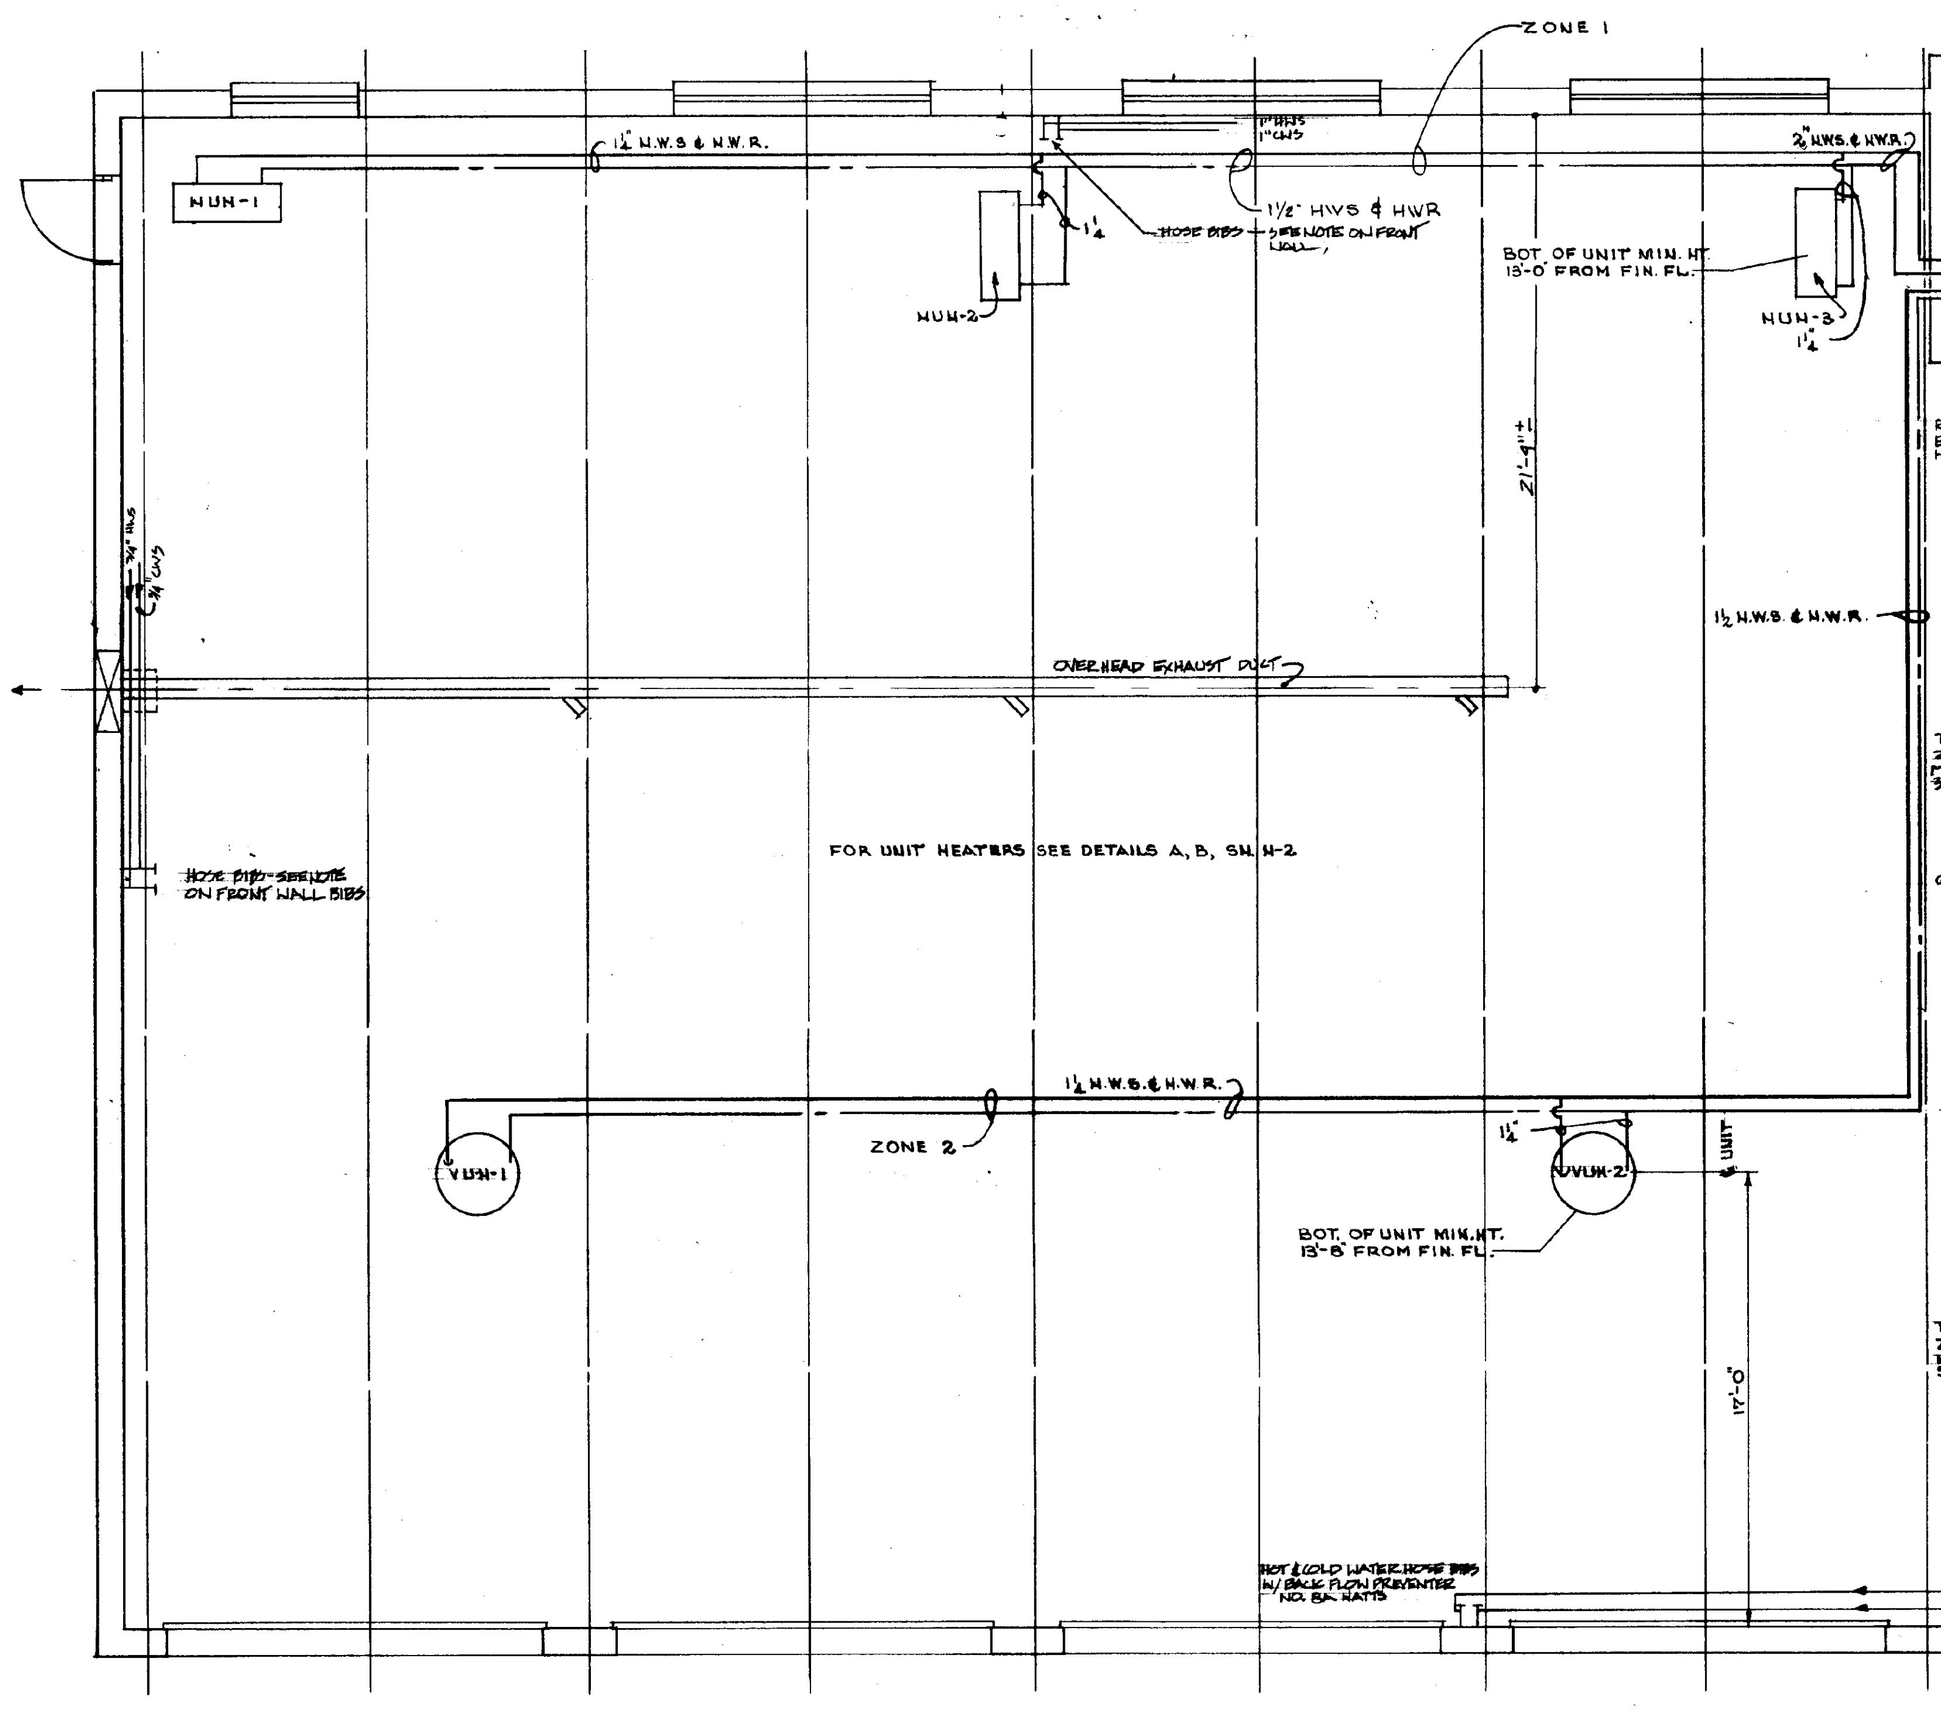

HEATING PLAN
4 BAY
SCALE: ¼"=1'-0"

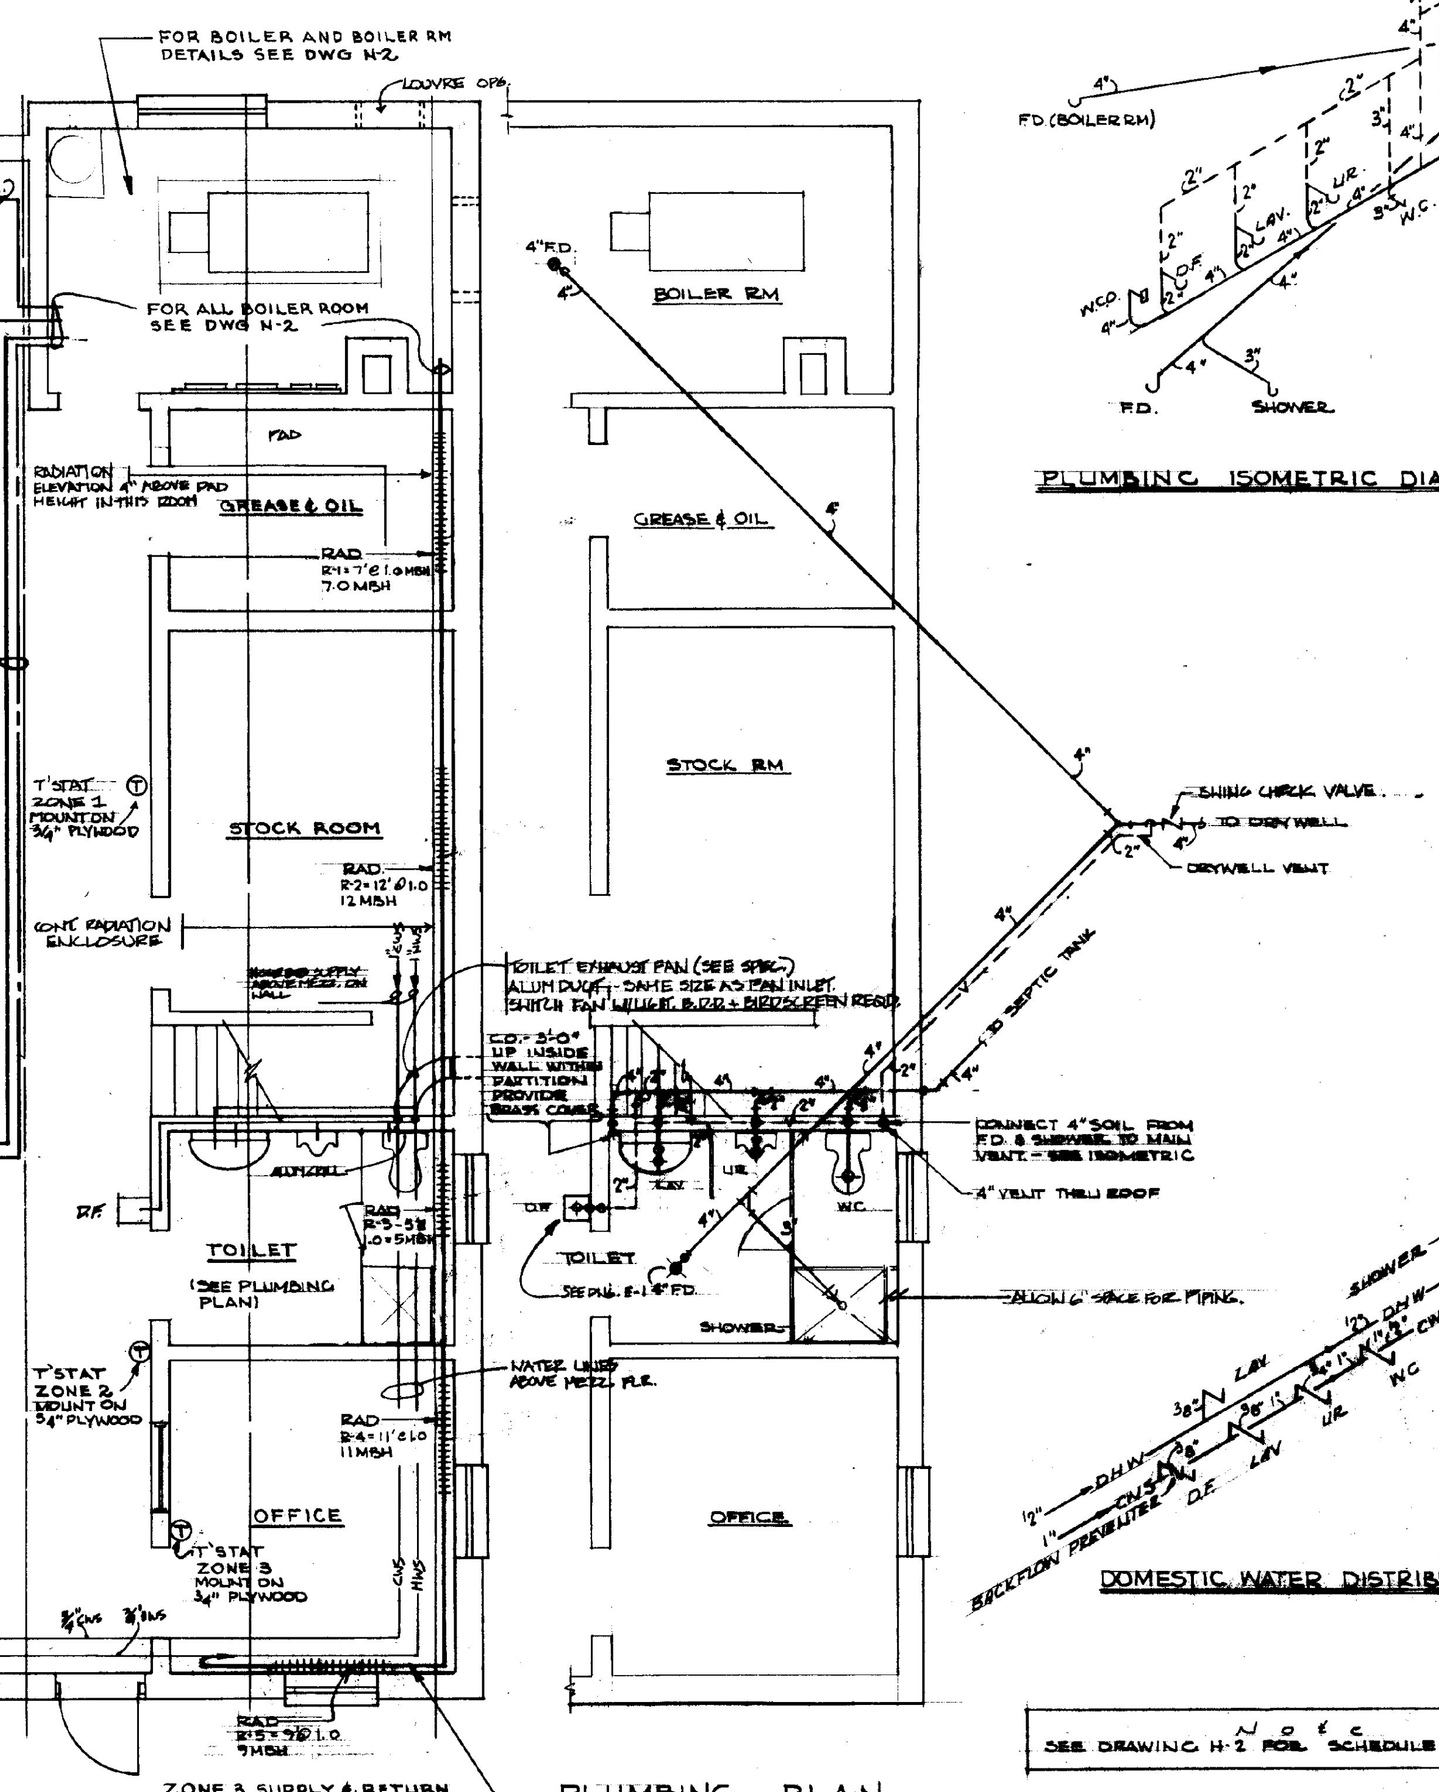

PLUMBING PLAN
SCALE: ¼"=1'-0"

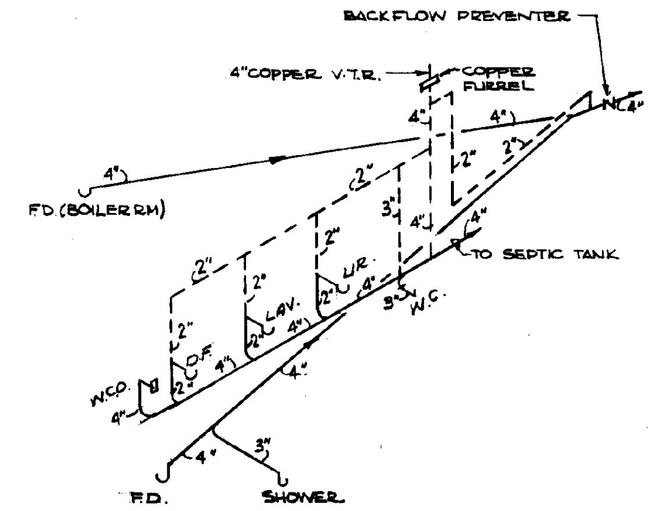

PLUMBING ISOMETRIC DIAGRAM

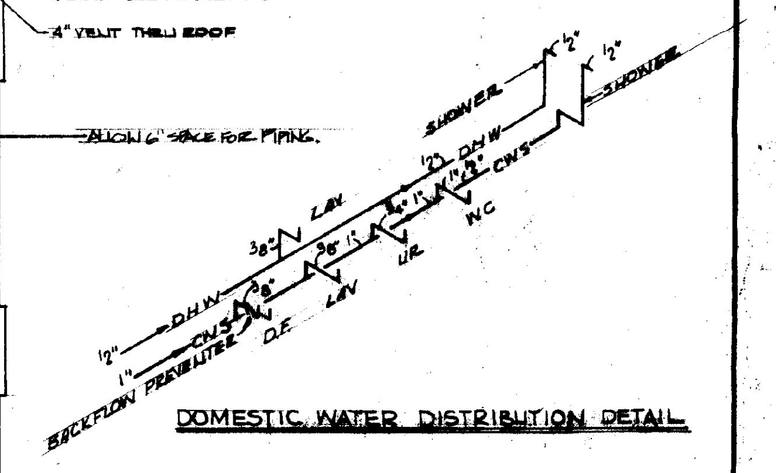

DOMESTIC WATER DISTRIBUTION DETAIL

NOTE
SEE DRAWING H-2 FOR SCHEDULE & GENERAL NOTES

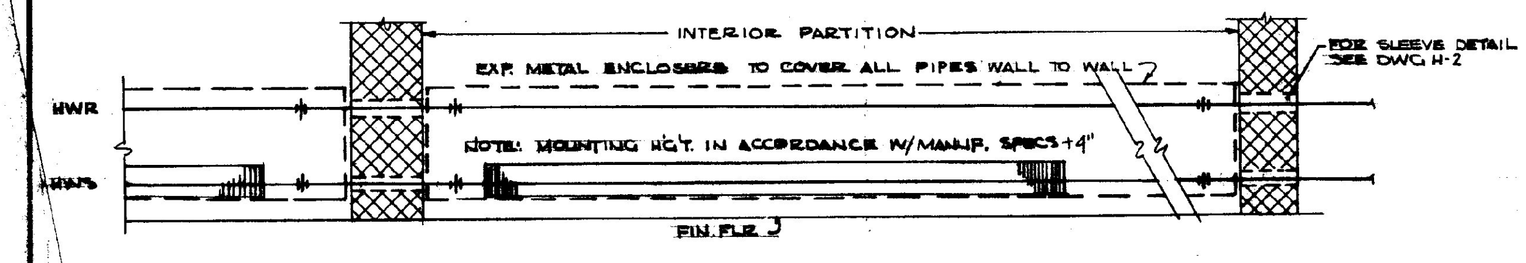

TYPICAL BASEBOARD RADIATION PIPING
SCALE: 1"=1'-0"

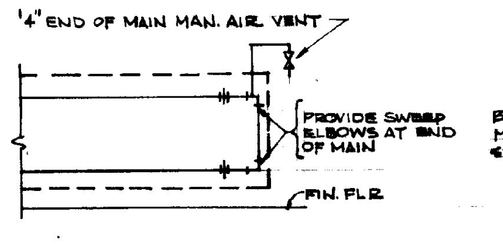

END OF MAIN DETAIL
SCALE: 1"=1'-0"
GARAGE OFFICE

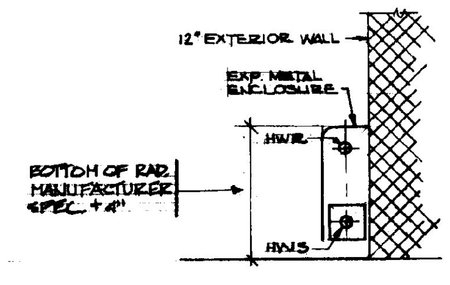

TYPICAL SECTION
SCALE: 1"=1'-0"

LEGEND

H.W.S.	
S.S.	BURNER SAFETY SWITCH (MTD 6'-0" ABOVE FIN. FLR.)
T	THERMOSTAT
VUH	PIPE SUPPLY TO BOTTOM & RETURN TO TOP
HUH	do
	GATE VALVE
	CHECK VALVE
	BALANCING COCK
	FLOW CONTROL VALVE
	UNION
	FUSIBLE LEVEL-MATIC VALVE
	STRAINER
	FPT - ALL BRONZE

	DATE	REVISION
REVISIONS	7-6-78	RCH - FAI RELOCATION

STATE OF VERMONT
DIVISION OF STATE BUILDINGS
AGENCY OF ADMINISTRATION
MONTPELIER, VERMONT

Standard Four Bay Highway Garage Bldg.

HEATING PLAN

SCALE: As noted

DATE: 10-10-74	DESIGNED BY: CLIFF MASTRO	DWG. NO. H-1
DRAWN BY: Sheila Sawyer Rev.	APPROVED BY: Thomas J. Salt	1 of 2