802-485-7427

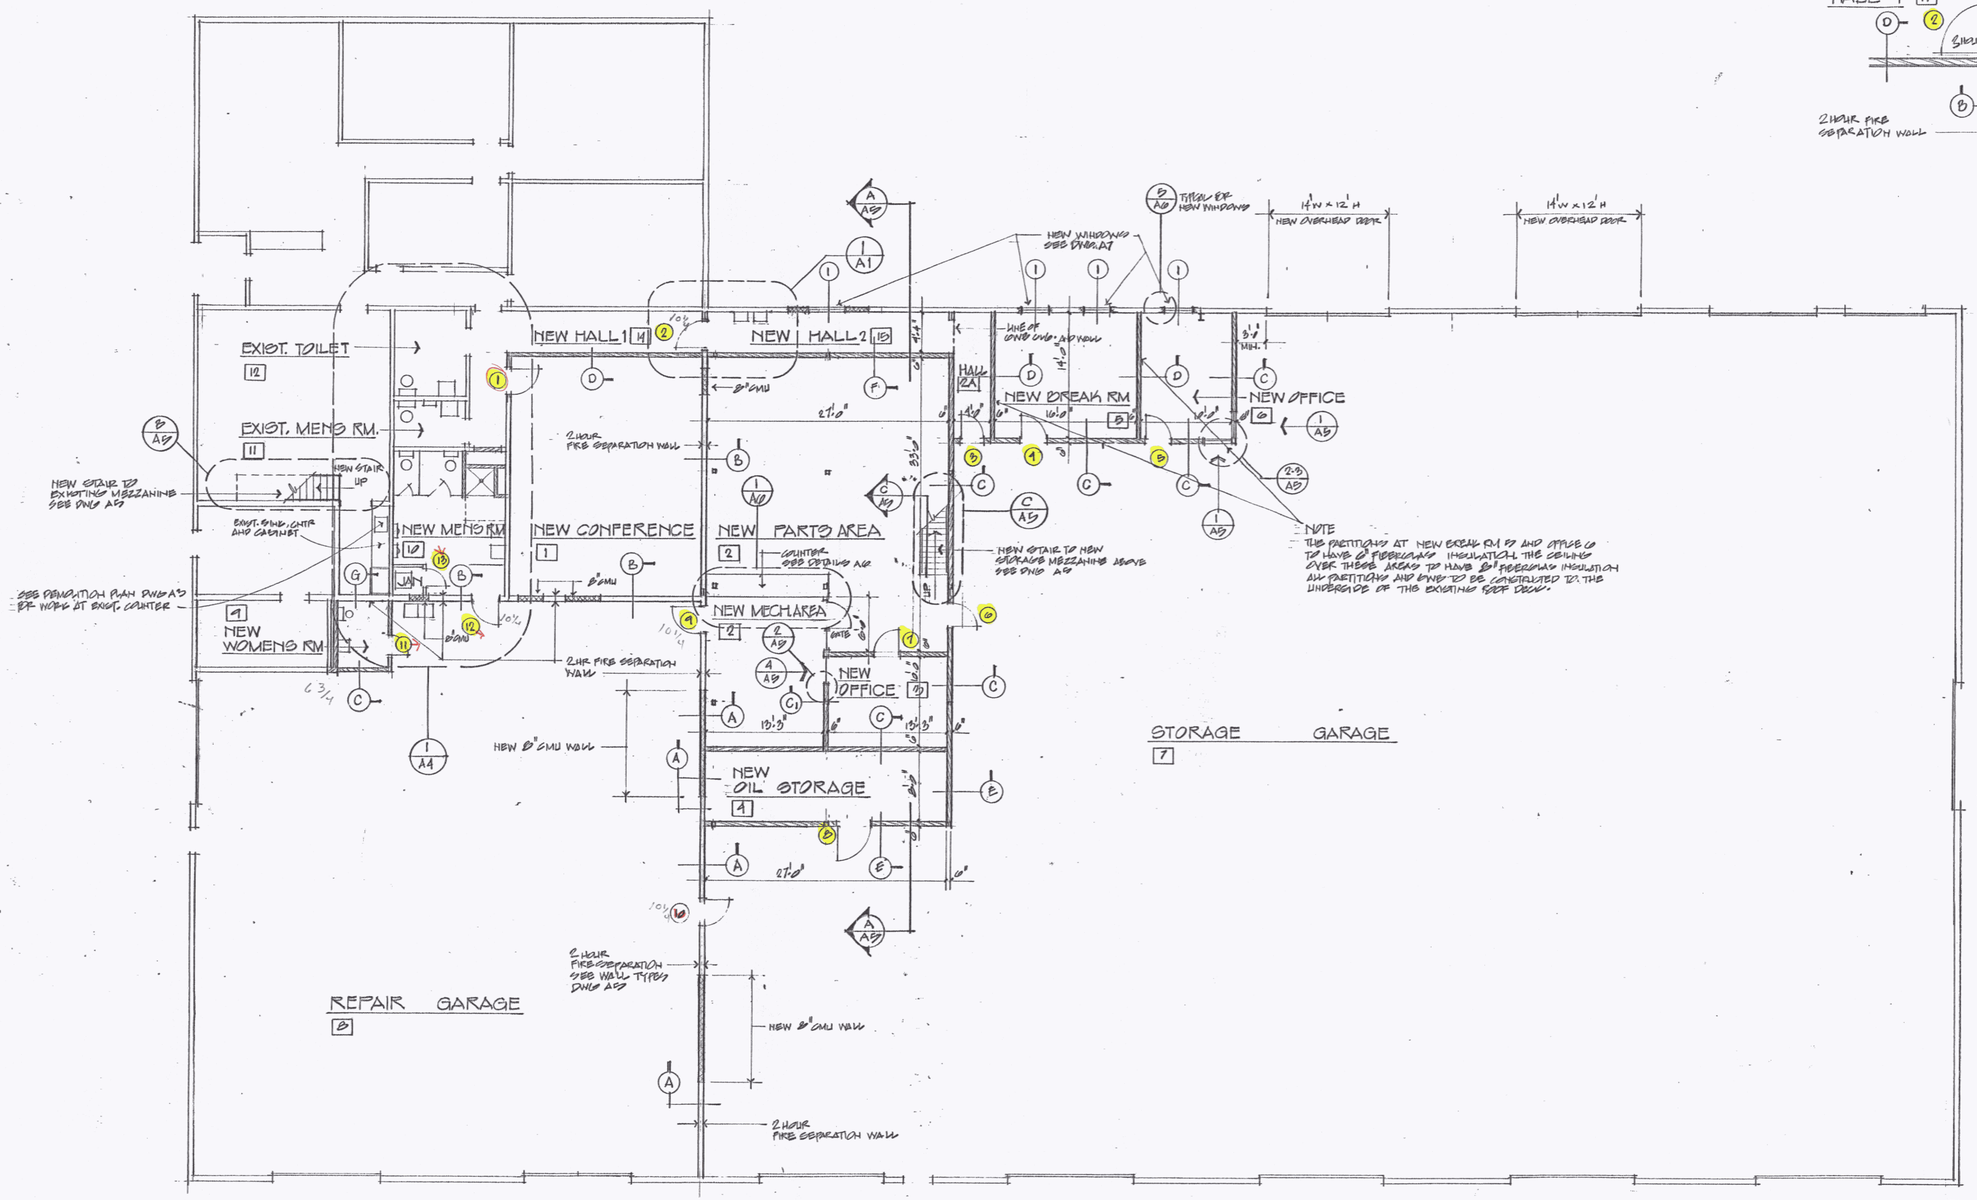

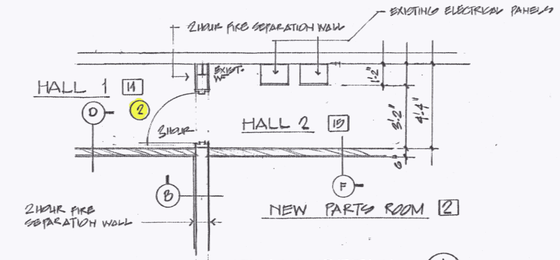

PLAN DETAIL 1

SCALE 1/4"=1'-0"

NORTH

FIRST FLOOR PLAN

SCALE 1/4"=1'-0"

INDICATES WALL TYPE

NEW WALLS - METAL STUD

EXISTING WALL

NEW WALLS - CONC. MASONRY UNITS

JANUARY 2004

REGISTERED ARCHITECT CHARLES E. METZ JR. No. 862 STATE OF VERMONT

PROJECT:
RENOVATIONS - BENNINGTON A.O.T.
DISTRICT OFFICE 1 BENNINGTON VT.

TITLE:
FIRST FLOOR PLAN

CHARLES E. METZ
ARCHITECT
THE GRIST MILL
BRADFORD VT 05033

DRAWING:
A1

SPILLER'S NO.18600