


ARE OTHER FANS EXISTING?
 COVERED IN SET 15?

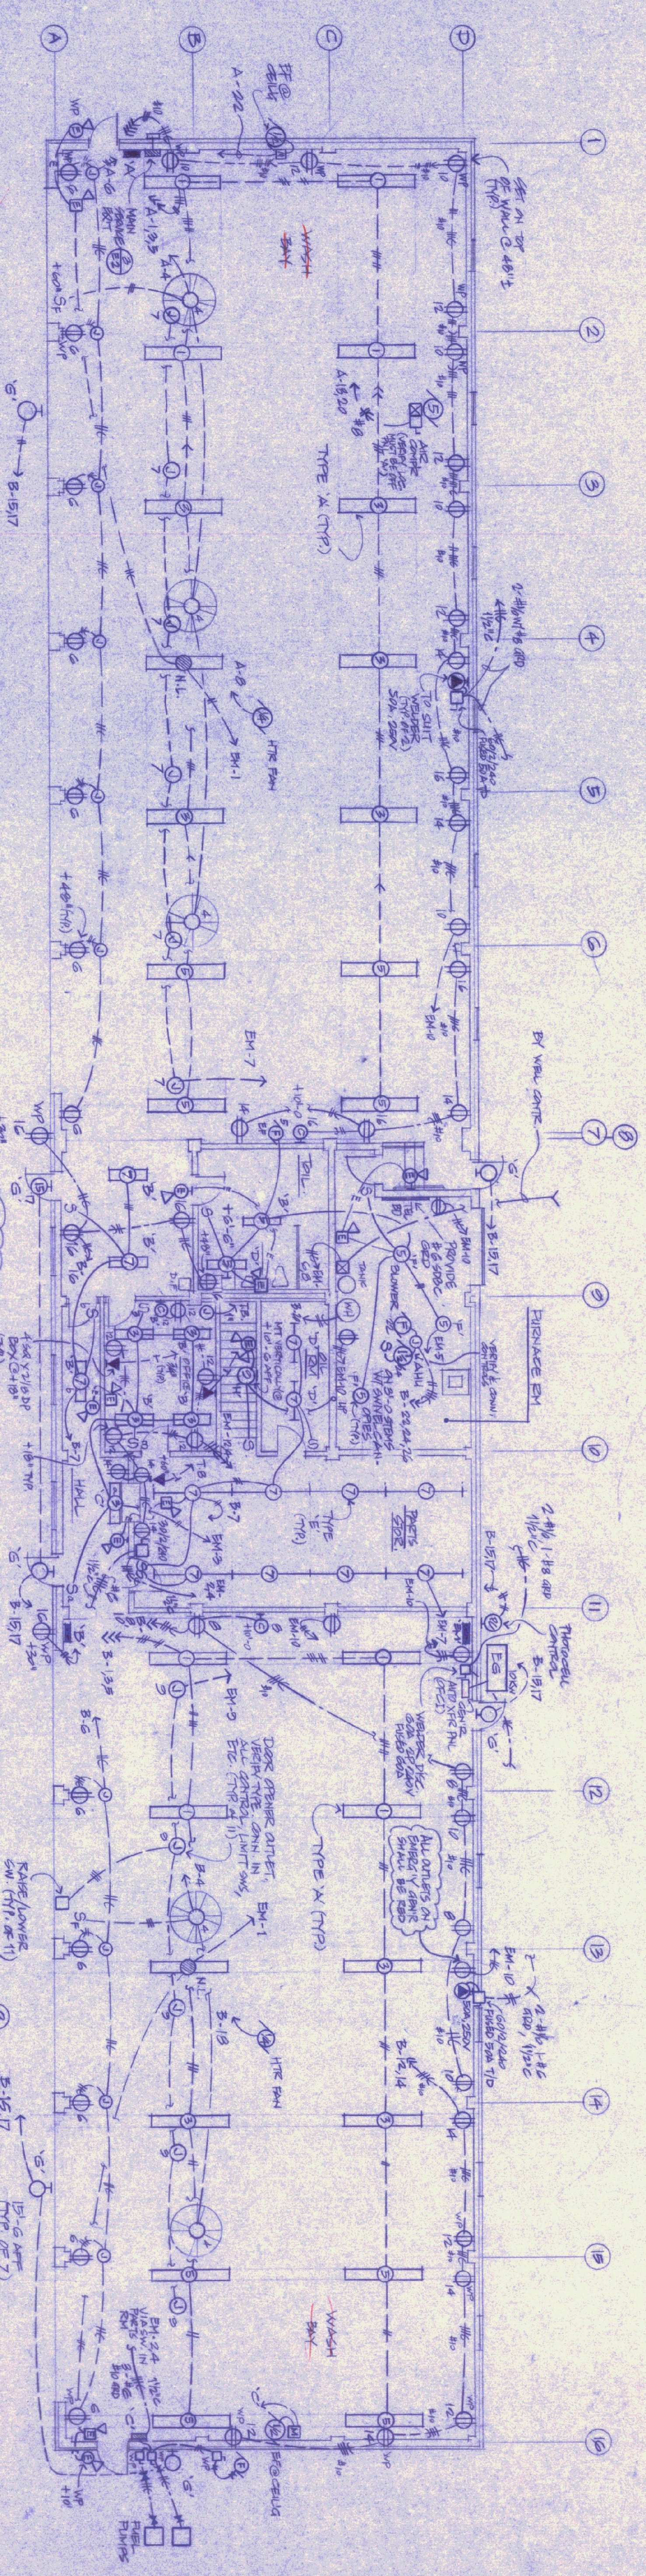


1 GRID FLR ELECT. PLAN
 SCALE: 1/8"=1'-0"

VOLTS 120/240		LUGS ONLY		LUGS ONLY		LUGS ONLY	


PANEL A (RUMBA 200)

PANEL B

VOLTS 120/240		LUGS ONLY		LUGS ONLY		LUGS ONLY	

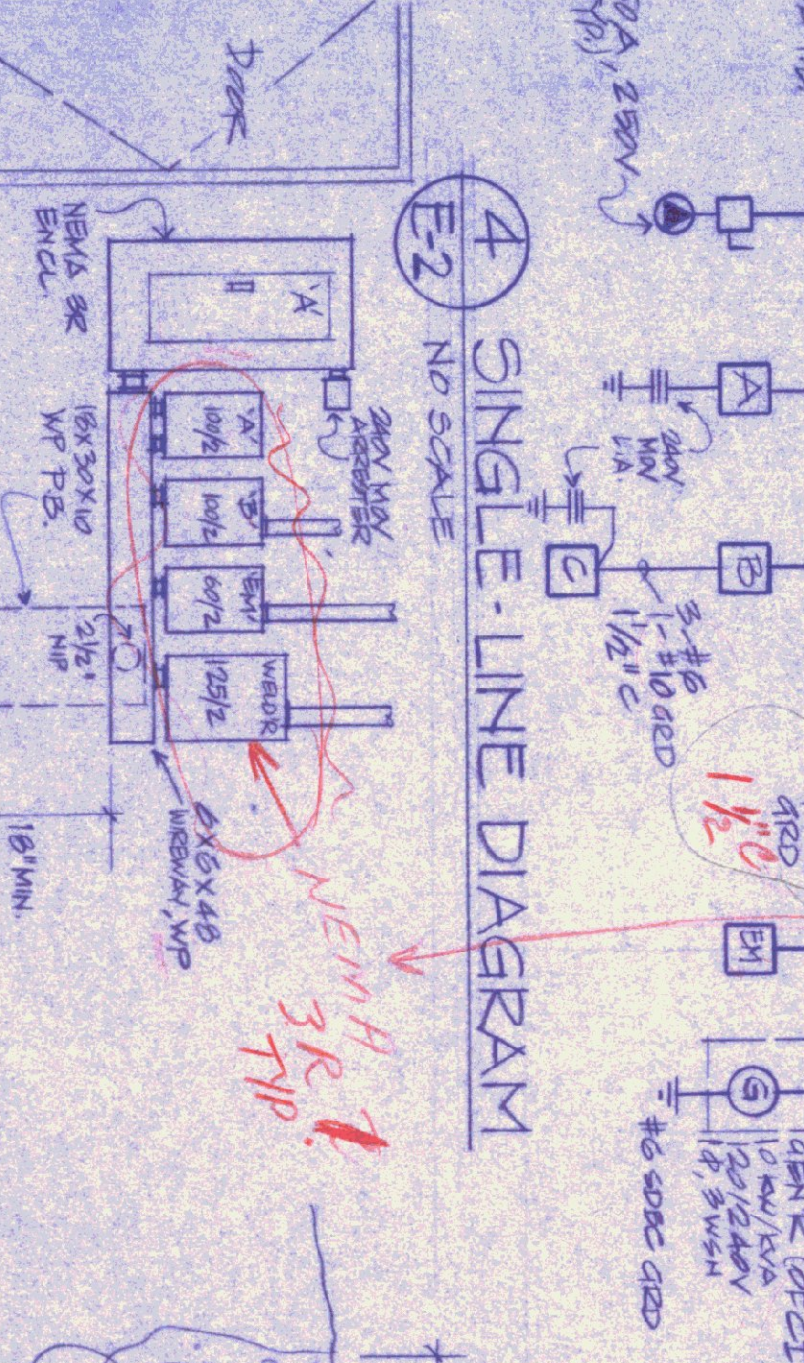

4 SINGLE-LINE DIAGRAM
 ND SCALE

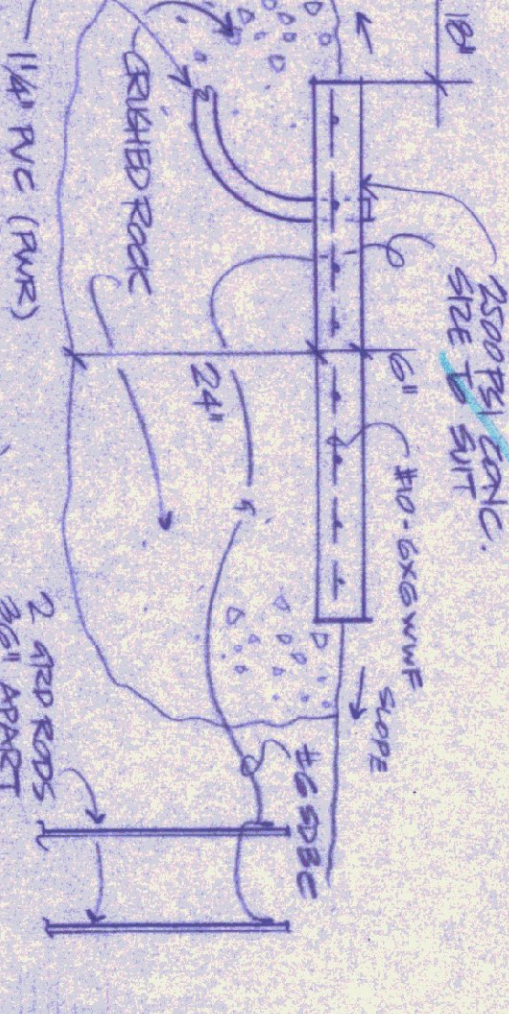


5 GEN'RL PADDET
 E2 NTS

TYPE	DESCRIPTION	REQ. TO
A	REPTD. FLUOR. INDUSTRIAL 10% 120V LIGHT 120V BALLAST & LAMPS	110/110V
B	1-LAMP 4W 85 WATT-ACCORD W/ 1-KW/HR. REFR. UNIT, LOW BALLAST	110/110V
C	1-LAMP 20WATT FLUOR. VANDAL PROOF	110/110V
D	2-LAMP TUBEM. 85W 40W 85 WATT FLUOR. 120V 2-WIRE/2-PRST	110/110V
E	INDUSTRIAL 10% 120V BALLAST	110/110V

1 1/2" 100ft x 7 1/2" minimum w/ 100ft conduit for each end

2 MEZZ. ELECT. PLAN
 E-1 SCALE

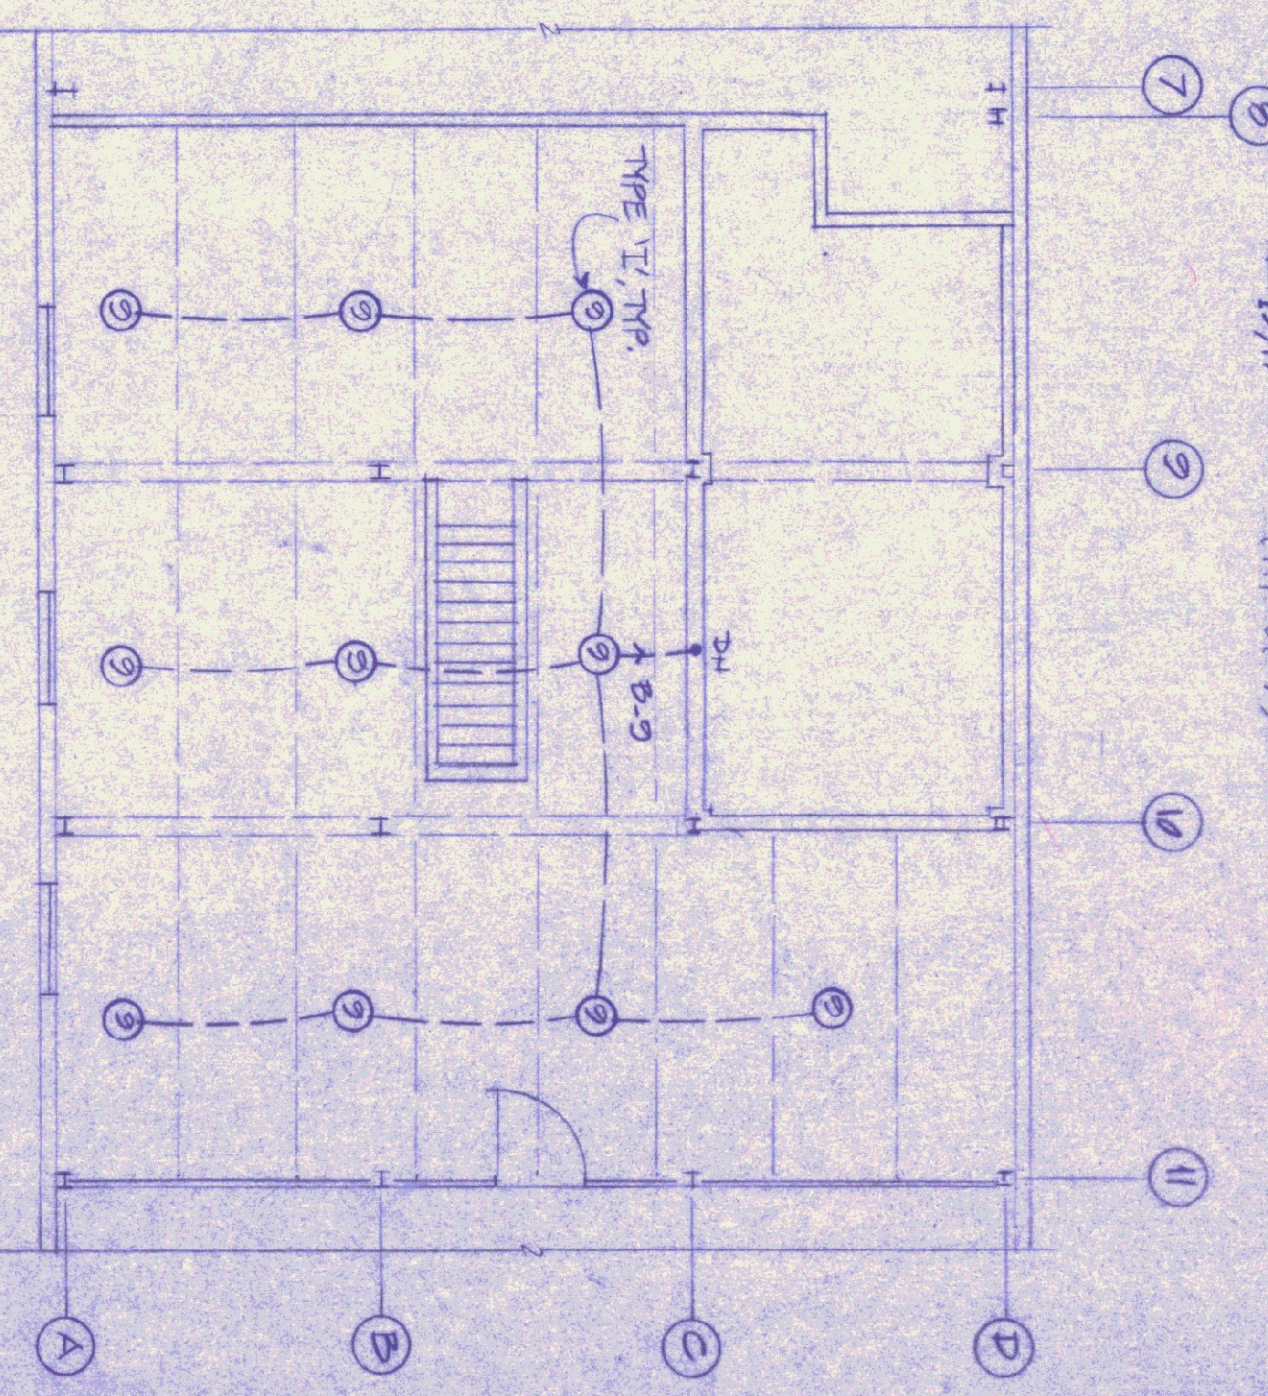

Wakefield Ward & Associates
 Consulting Electrical Engineer
 Swanton, Vermont

STATE OF VERMONT
 PROFESSIONAL ENGINEER
 ROBERT WARD
 No. 3814
 EXPIRES 12/31/2004

STATE OF VERMONT
 DEPARTMENT OF STATE BUILDINGS
 AGENCY OF ADMINISTRATION
 MONTPELIER, VERMONT

ELECTRICAL PLANS & DETAILS

DATE: 9-22-95
 SCALE: AS NOTED
 DRAWN BY: [Signature]
 APPROVED BY: [Signature]

REVISIONS:

DWG NO. E-2