
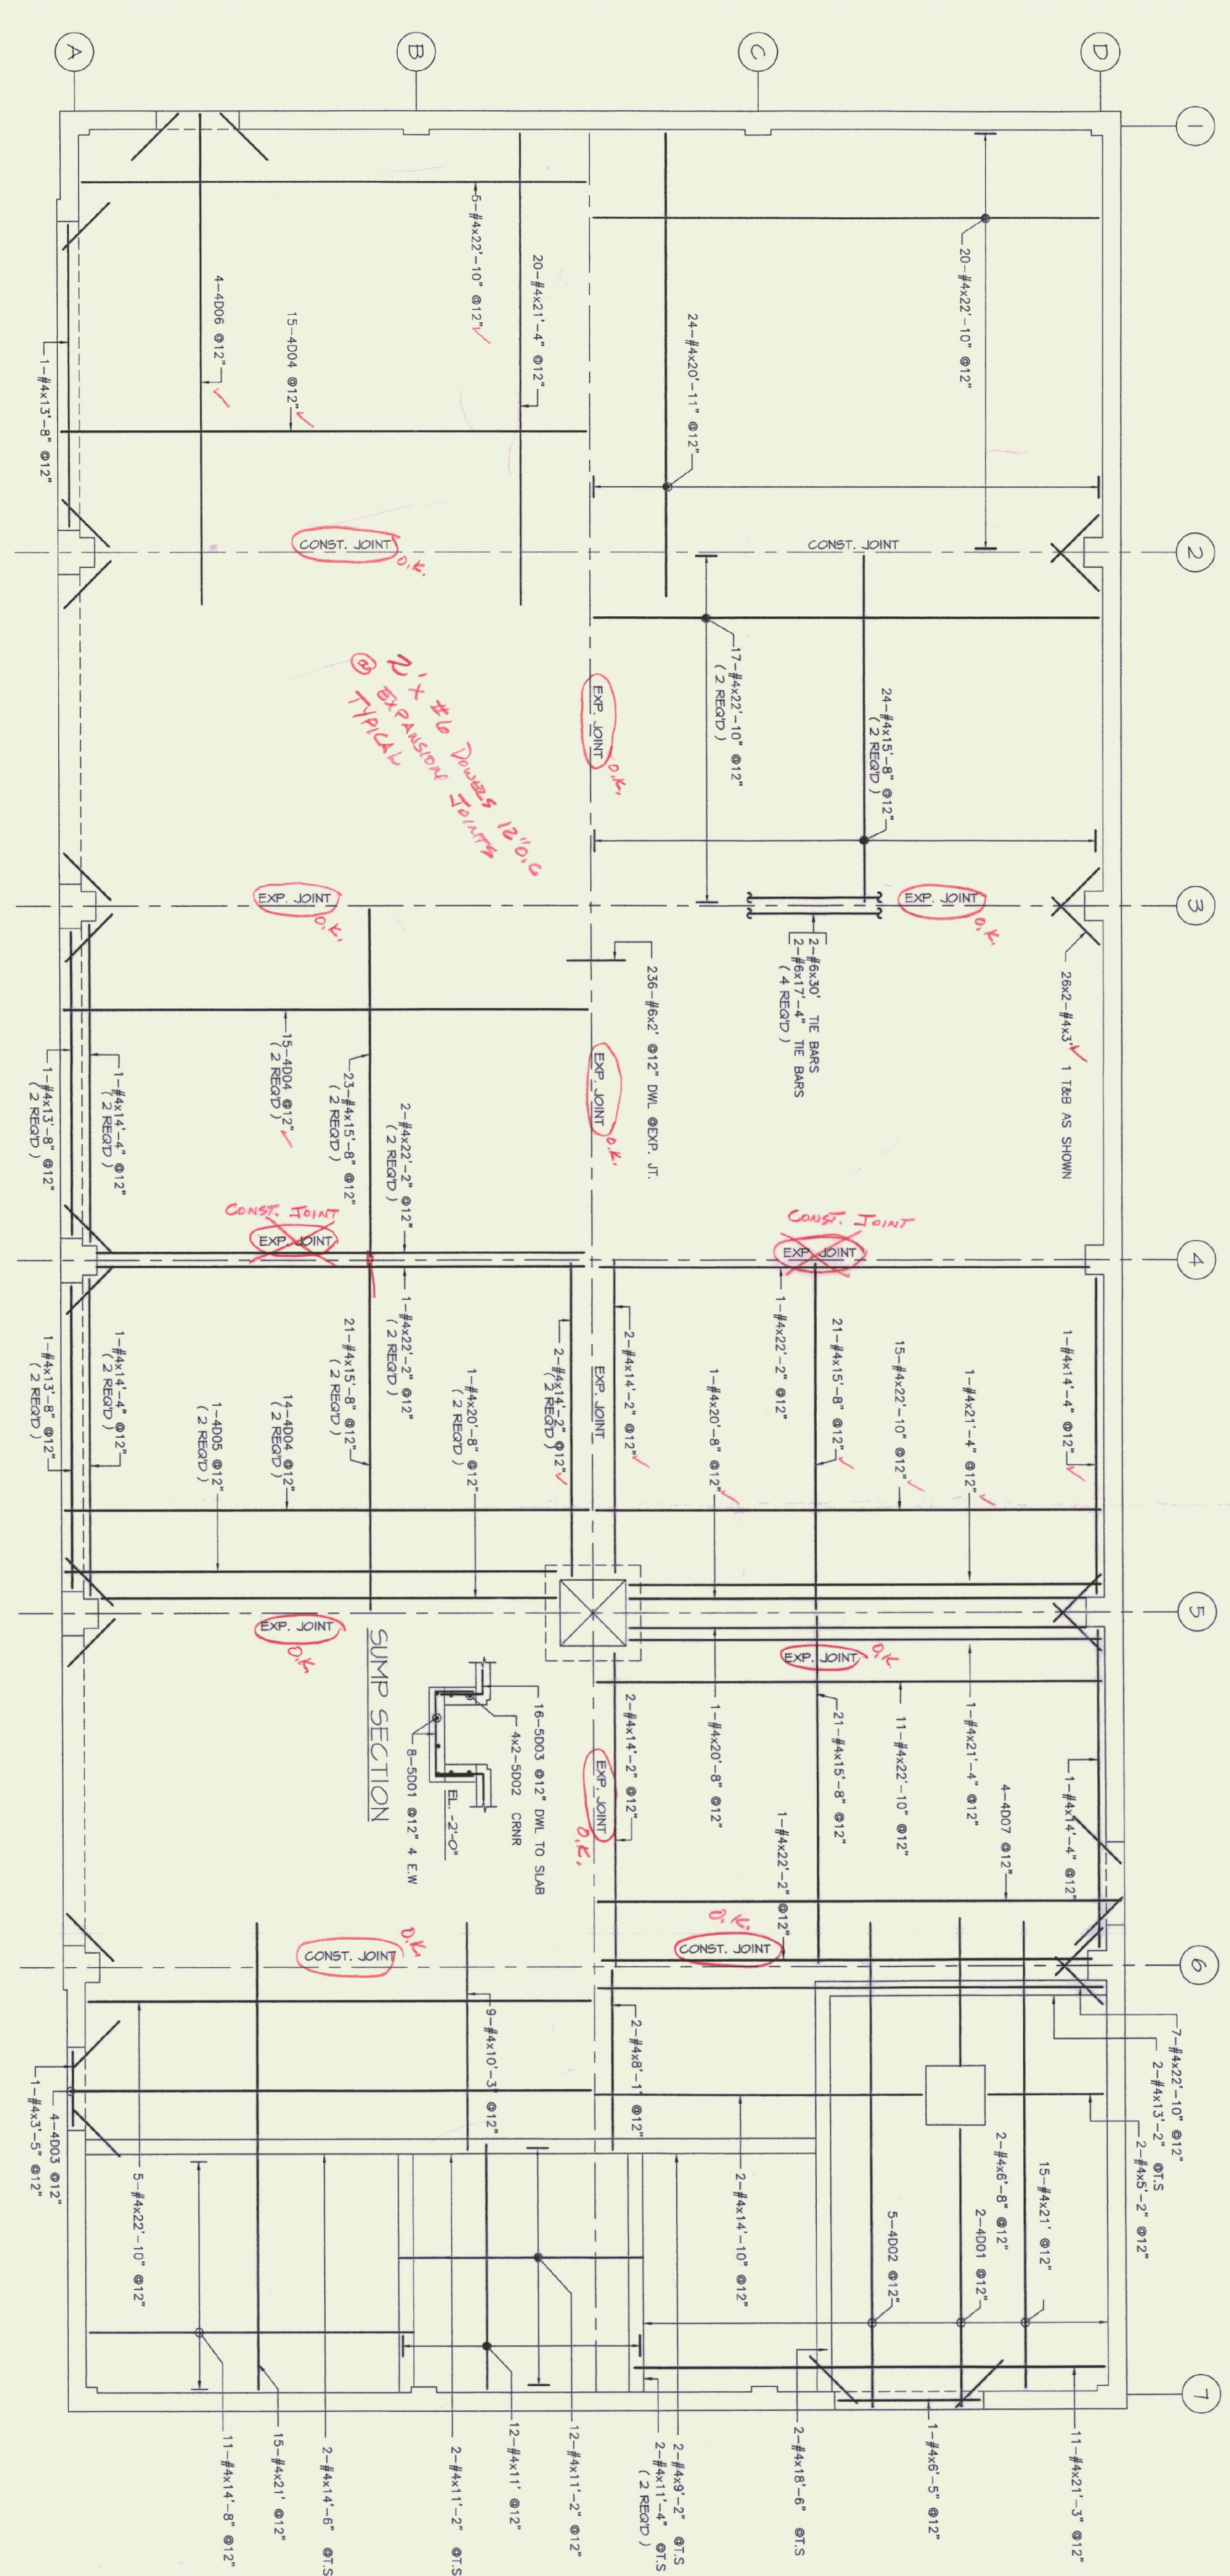



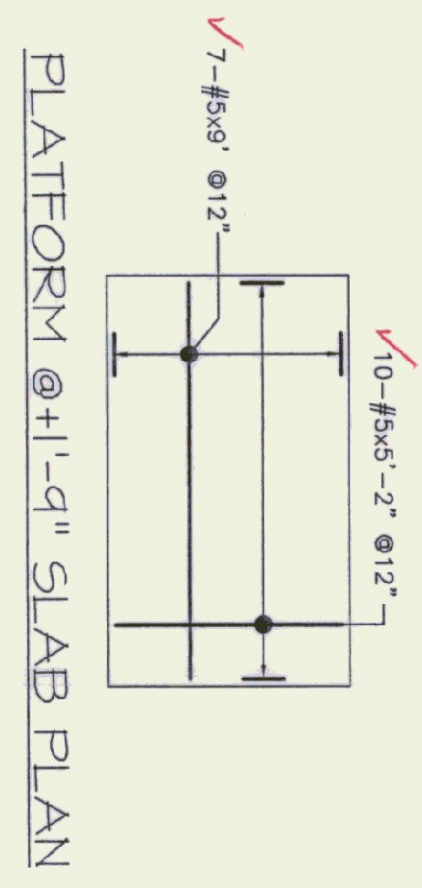

GARAGE SLAB ON GRADE REIN. PLAN

REFERENCE DIMS.
 REINFORCING BARS 60
 ASTM A615 GRADE 60
 LWP ALL CONCRETE FINISHES BARS
 #3 = #3
 #4 = #4
 #5 = #5
 #8 = #8
 #10 = #10
 #11 = #11

NOTICE
 Shortages, improper fabrication or claims for any other reason must be reported to this company within a period of 15 days of delivery. This company reserves the right to field inspect prior to replacement or reconditioning of nonconforming material, and will not honor charges for work done in the field without specific authorization from this company.

LEBANON
 OFFICE
 MAINTENANCE GARAGE & SHEDS
 OFF SITE 100
 LUDLOW, VT

STATE OF VT-AOT
 NAYLOR & BRENN BUILDERS

PROJECT: MAINTENANCE GARAGE & SHEDS
 DRAWING NO: 05490444
 DATE: 4-27-99
 REIN. PLAN

DATE: 4-27-99
 DESCRIPTION: MAINTENANCE GARAGE & SHEDS
 DRAWING NO: 05490444
 REIN. PLAN