PROPOSED BUILDING LOCATIONS

ID #	STATION #	OFFSET	DESCRIPTION
①	5+98.1	L 171.0	SE CORNER OF STORAGE SHED "A"
②	6+43.6	L 155.5	NE CORNER OF STORAGE SHED "A"
③	6+49.0	L 126.4	SW CORNER OF SALT SHED "A"
④	6+56.5	L 87.2	SE CORNER OF SALT SHED "A"
⑤	6+60.3	L 67.5	SW CORNER OF SALT SHED "B"
⑥	6+67.9	L 28.3	SE CORNER OF SALT SHED "B"
⑦	6+67.8	R 18.2	SW CORNER OF GARAGE FACILITY
⑧	6+50.3	R 120.7	SE CORNER OF GARAGE FACILITY
⑨	6+36.7	R 191.1	SE CORNER OF STORAGE SHED "B"
⑩	5+89.4	R 200.3	NE CORNER OF STORAGE SHED "B"

NOTES:

1. CONTRACTOR TO TRANSFER BENCHMARK PRIOR TO REMOVING CURRENT BENCH ON 12" PINE.
2. THE EXISTING FEATURES AND PROPOSED BUILDING LAYOUTS WERE TAKEN FROM A PLAN TITLED "SITE PLAN" BY THE VERMONT DEPARTMENT OF STATE BUILDINGS DATED APRIL 21, 1995.
3. PARTIAL CONTOUR INFORMATION WAS SURVEYED BY CHARLIE ROCKWELL L.S. ON OCTOBER 31, 1997.
4. ABANDON WELL AT STATION 3+06 IN ACCORDANCE WITH SECTION 12.3.5 IN CHAPTER 21 OF THE WATER SUPPLY RULES BY THE AGENCY OF NATURAL RESOURCES.
5. UTILITY LINES SERVING THIS PARCEL SHALL BE RELOCATED BY THE LUDLOW ELECTRIC LIGHT DEPARTMENT. CONTRACTOR SHALL COORDINATE AND PAY FOR REMOVAL OF EXISTING UTILITY LINES AND INSTALLATION OF NEW UTILITY LINES WITH LUDLOW ELECTRIC LIGHT DEPARTMENT.

   CONTACT PERSON: HOWARD BARTON (SUPERINTENDENT)
   TELEPHONE: 802-228-3721

6. CONTRACTOR SHALL BE RESPONSIBLE FOR THE REMOVAL AND RECYCLING OR DISPOSAL OF THE HOUSE TRAILER CURRENTLY LOCATED AT THE REAR OF THE PROJECT SITE. (APPROX. 12'w 40')

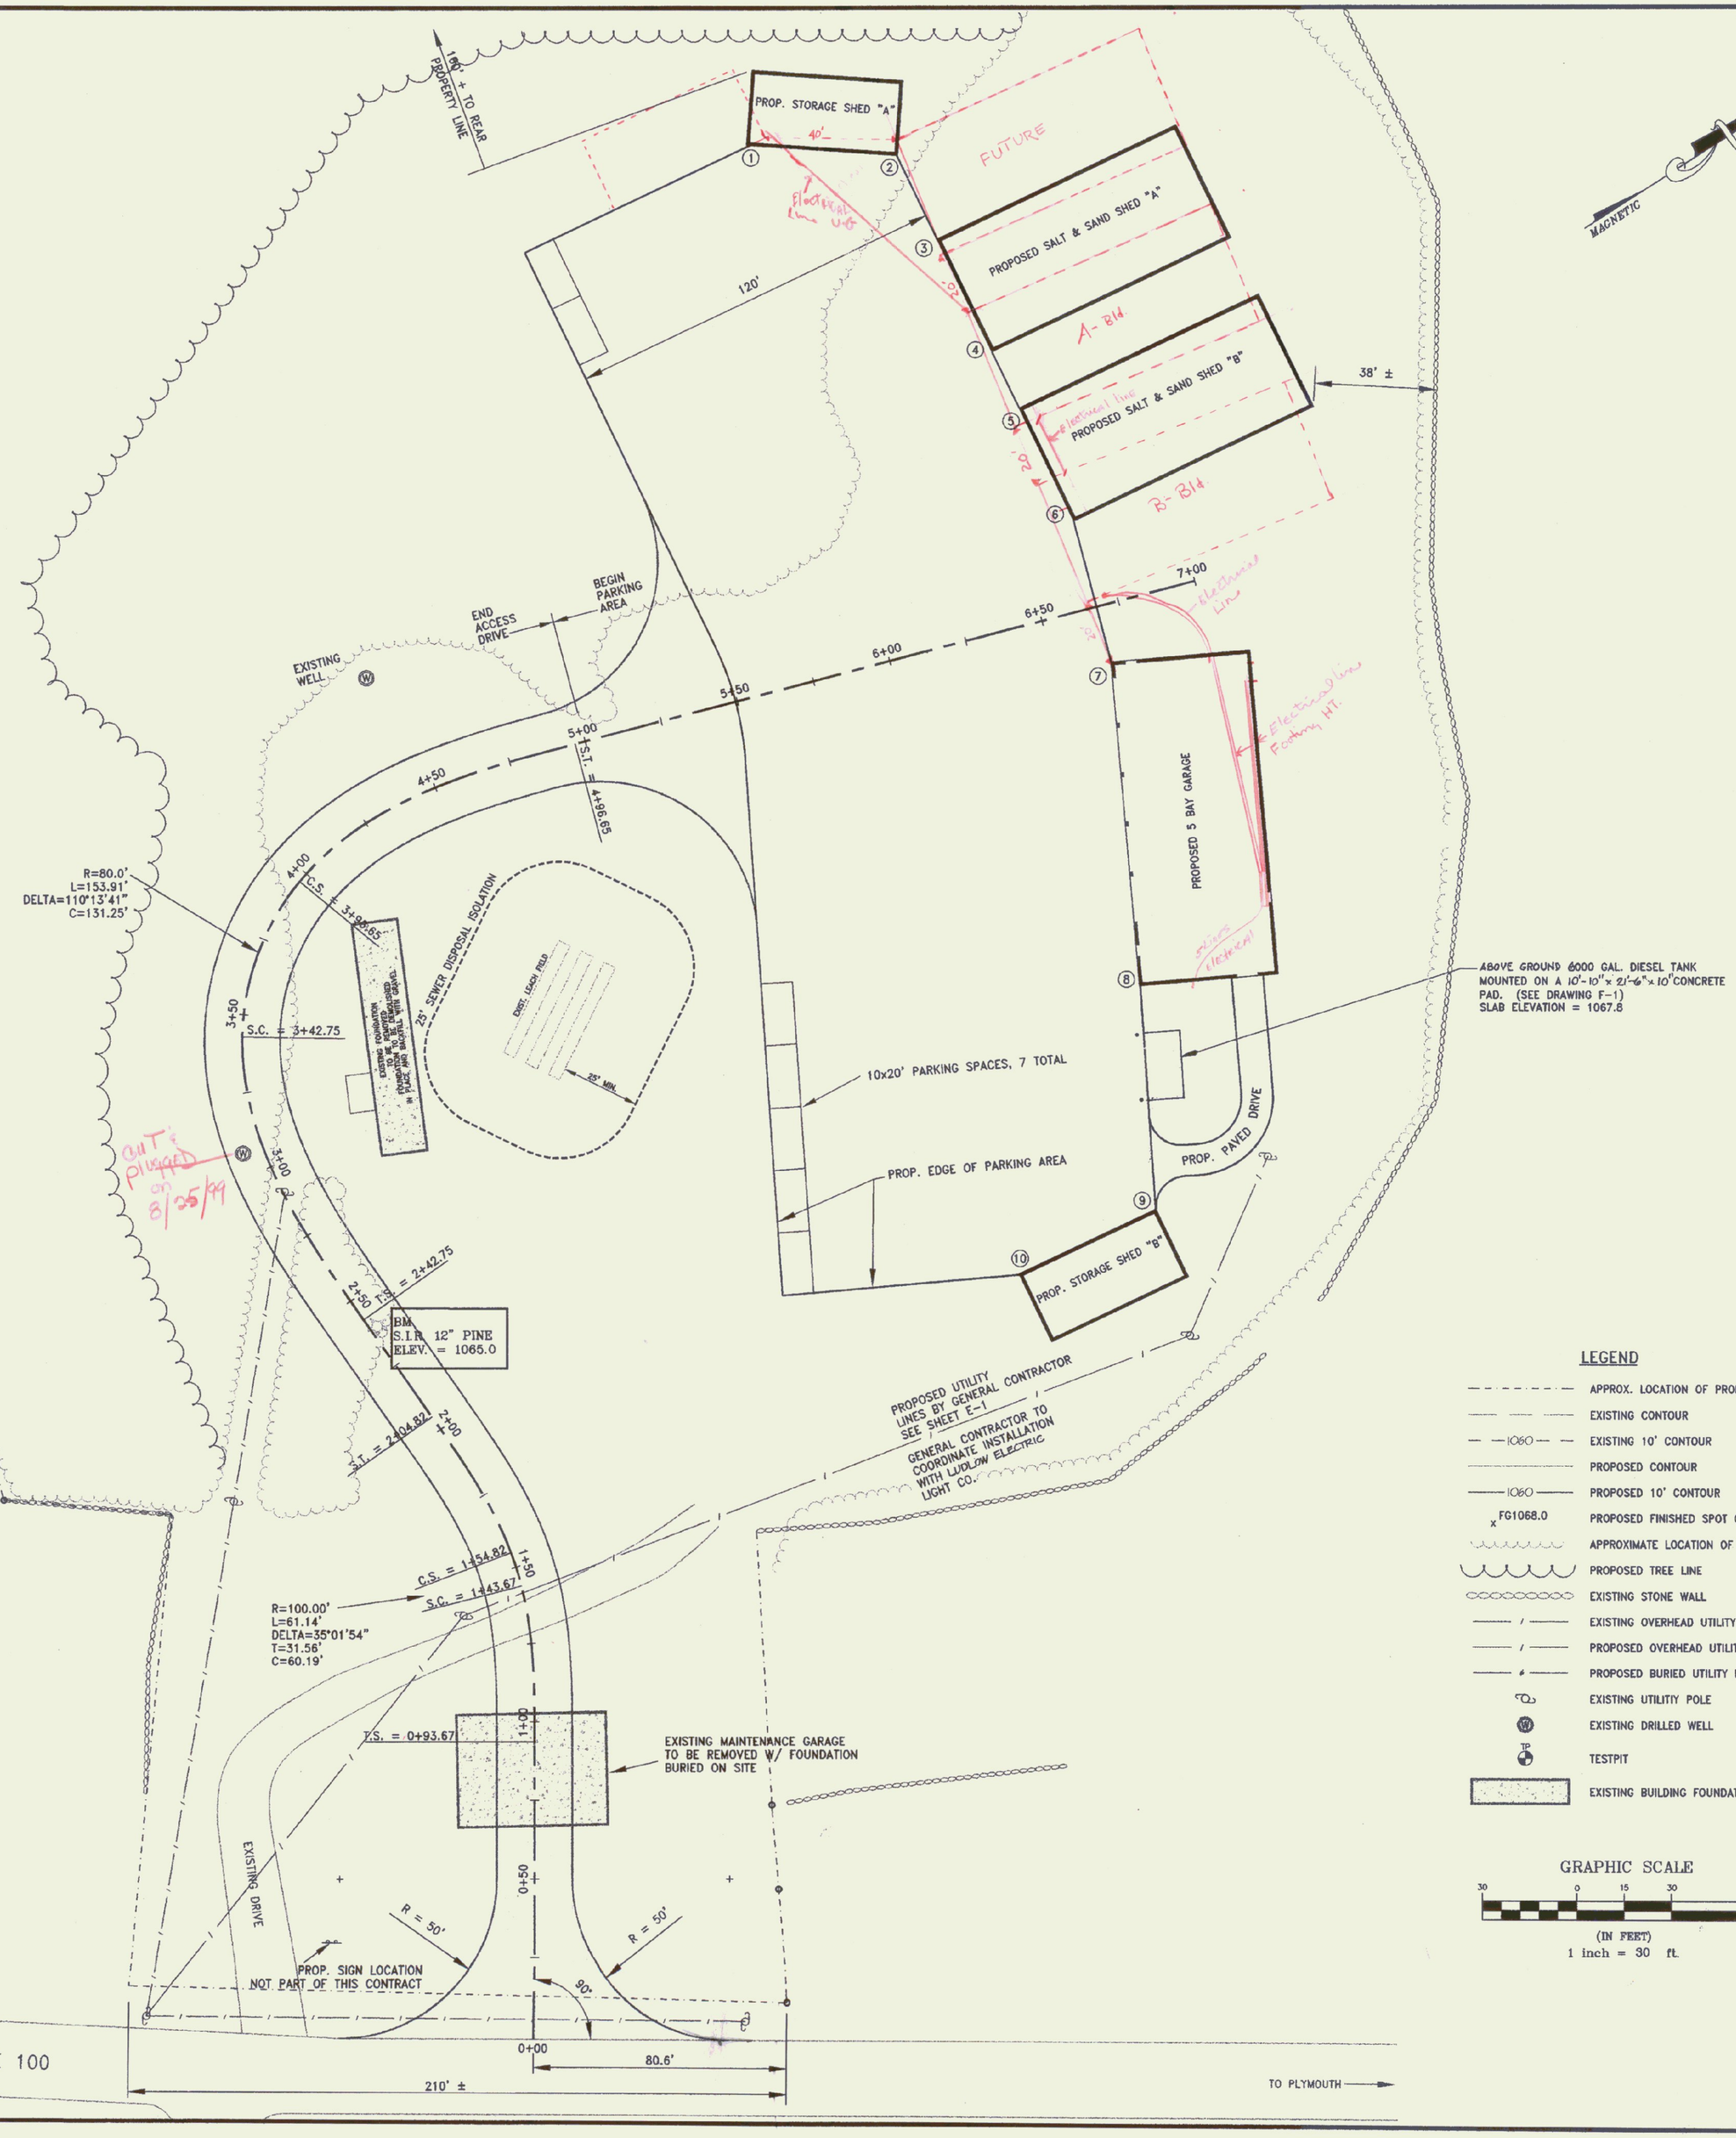

LEGEND

- APPROX. LOCATION OF PROPERTY LINE
- EXISTING CONTOUR
- 1080 EXISTING 10' CONTOUR
- PROPOSED CONTOUR
- 1080 PROPOSED 10' CONTOUR
- x FG1068.0 PROPOSED FINISHED SPOT GRADE
- APPROXIMATE LOCATION OF EXISTING TREE LINE
- PROPOSED TREE LINE
- EXISTING STONE WALL
- EXISTING OVERHEAD UTILITY LINES
- PROPOSED OVERHEAD UTILITY LINES
- PROPOSED BURIED UTILITY LINES
- EXISTING UTILITY POLE
- EXISTING DRILLED WELL
- TP TESTPIT
- EXISTING BUILDING FOUNDATION

GRAPHIC SCALE

30 0 15 30 60

(IN FEET)
1 inch = 30 ft.

C:\ACAD\DWGS\9411.DWG R14

1 OF 30

REVISIONS:

6/25/98
ADDED TO NOTES & PROPOSED UTILITY LINE
ADDED PARKING SPACES

7/29/98
REVISED MISC. NOTES
REVISED PROP. ELEC.

VERMONT
AGENCY OF TRANSPORTATION

HIGHWAY MAINTENANCE STORAGE FACILITY

VT RTE. 100 LUDLOW, VT

THESE PLANS ARE FOR THIS PROJECT ONLY AND ARE NOT FOR REUSE ON THIS PROJECT OR ANY OTHER PROJECT WITHOUT WRITTEN CONSENT OF ENMAN ENGINEERING, P.C.

Enman Engineering
Environmental ■ Civil ■ Sanitary
230 North Main Street
Rutland, Vermont 05701
(802)775-3437
Copyright © 1998
All rights reserved.

BRIAN J. ENMAN No. 9558 REGISTERED PROFESSIONAL ENGINEER STATE OF VERMONT

REGULATORY APPROVAL STAMP

SITE PLAN

SCALE:	AS SHOWN
DATE:	06/08/98
DESIGN BY:	BJE
DRAWN BY:	JBT
SHEET NO:	R-1
PROJECT NO:	9411