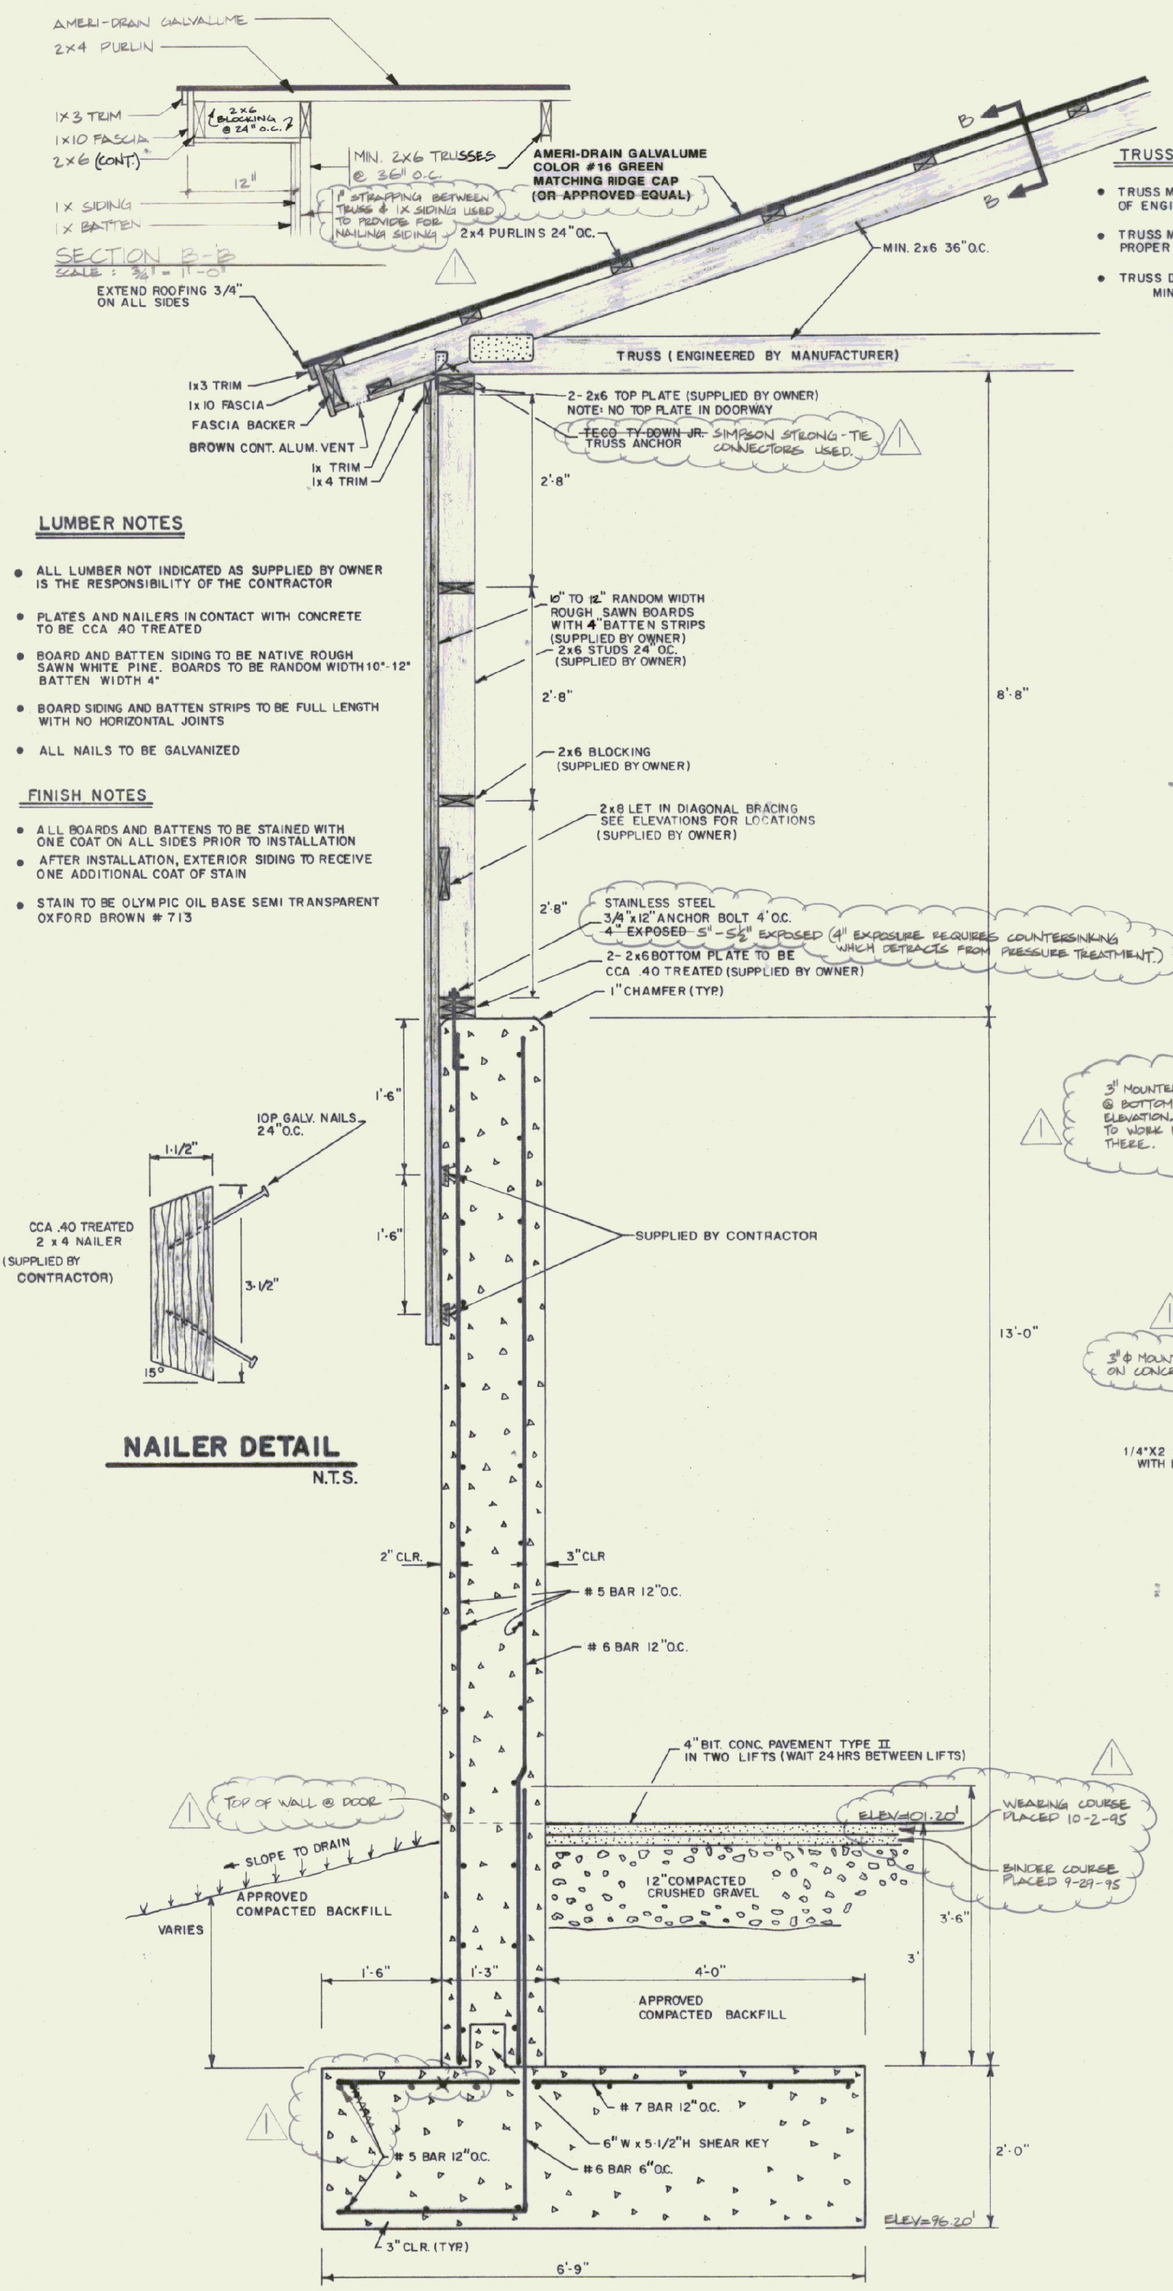

LUMBER NOTES

- ALL LUMBER NOT INDICATED AS SUPPLIED BY OWNER IS THE RESPONSIBILITY OF THE CONTRACTOR
- PLATES AND NAILERS IN CONTACT WITH CONCRETE TO BE CCA 40 TREATED
- BOARD AND BATTEN SIDING TO BE NATIVE ROUGH SAWN WHITE PINE. BOARDS TO BE RANDOM WIDTH 10"-12" BATTEN WIDTH 4"
- BOARD SIDING AND BATTEN STRIPS TO BE FULL LENGTH WITH NO HORIZONTAL JOINTS
- ALL NAILS TO BE GALVANIZED

FINISH NOTES

- ALL BOARDS AND BATTENS TO BE STAINED WITH ONE COAT ON ALL SIDES PRIOR TO INSTALLATION
- AFTER INSTALLATION, EXTERIOR SIDING TO RECEIVE ONE ADDITIONAL COAT OF STAIN
- STAIN TO BE OLYMPIC OIL BASE SEMI TRANSPARENT OXFORD BROWN # 713

TRUSS NOTES

- TRUSS MANUFACTURER TO PROVIDE THE DEPT. OF STATE BUILDINGS ENGINEER A SET OF ENGINEERED & STAMPED DRAWINGS FOR APPROVAL PRIOR TO TRUSS MANUFACTURE
- TRUSS MANUFACTURER TO PROVIDE THE CONTRACTOR WITH ALL NECESSARY INSTRUCTIONS FOR PROPER TRUSS INSTALLATION, ANCHORAGE, BRACING, LIFTING ETC.
- TRUSS DESIGN LOADS IN ACCORDANCE WITH THE 1987 BOCA FOR VERMONT MINIMUM LOADS:
  - LIVE — PER 1987 B.O.C.A. FOR VT. (50 PSF MIN.)
  - DEAD — AS CALCULATED FROM TRUSS & ROOF MATERIALS & IN ADDITION 5 lb psf ON BOTTOM CHORD.
  - WIND — 25 P.S.F.
  - DIAGONAL WIND BRACING PER TRUSS MANUFACTURER

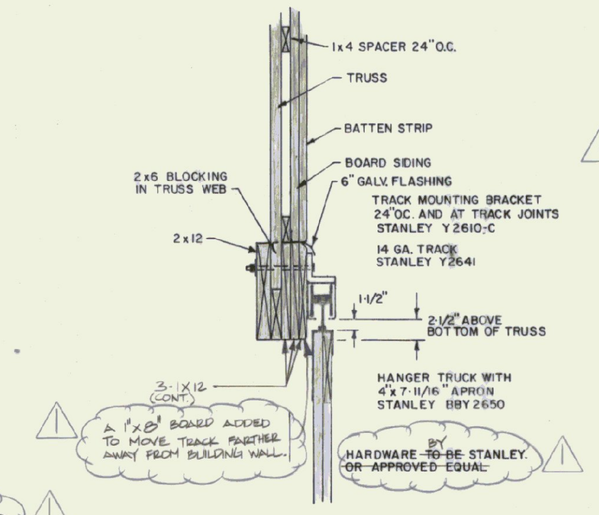

TRACK MOUNT DETAIL
N.T.S.

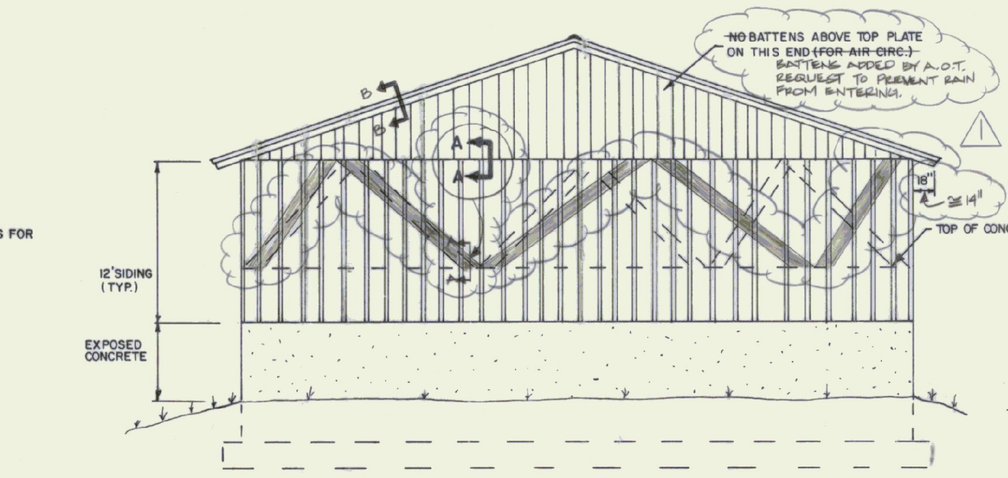

BACK ELEVATION
1/8" = 1'-0"

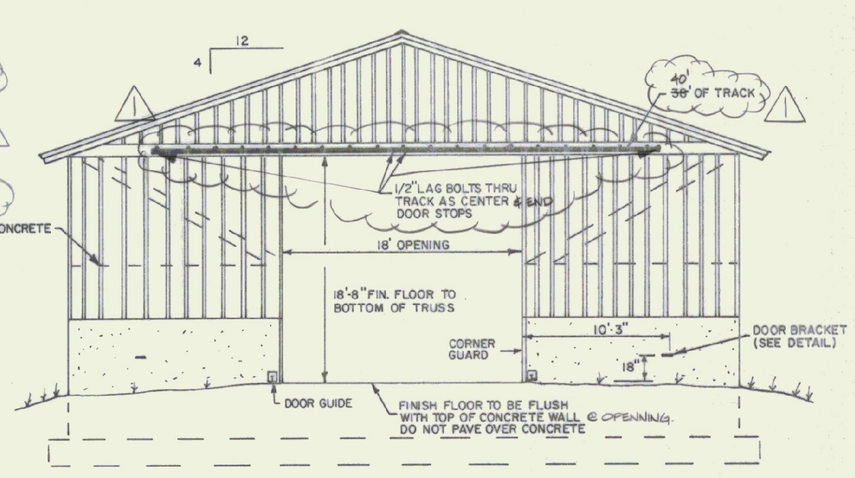

FRONT ELEVATION
1/8" = 1'-0"

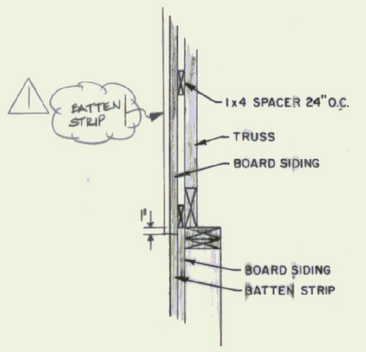

SECTION A A
N.T.S.

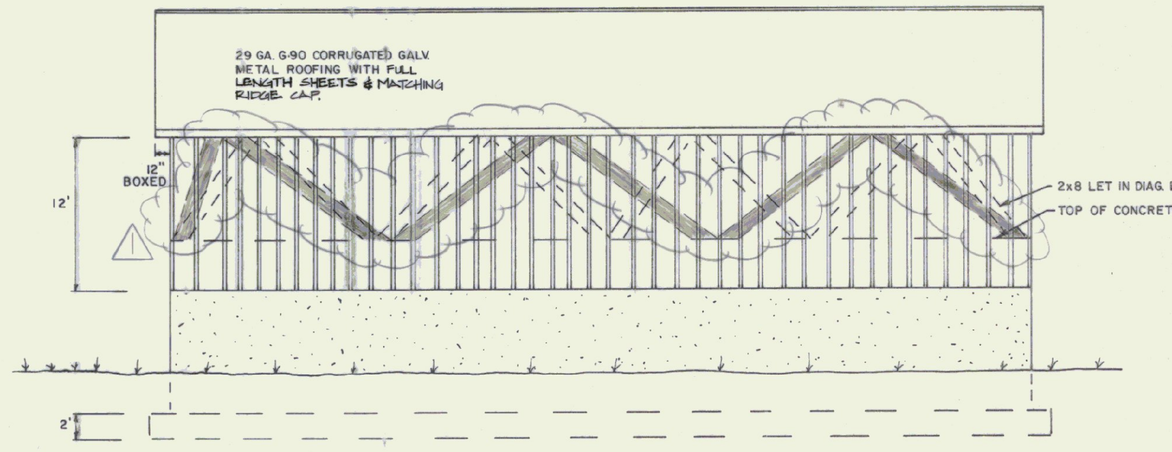

SIDE ELEVATION
1/8" = 1'-0"

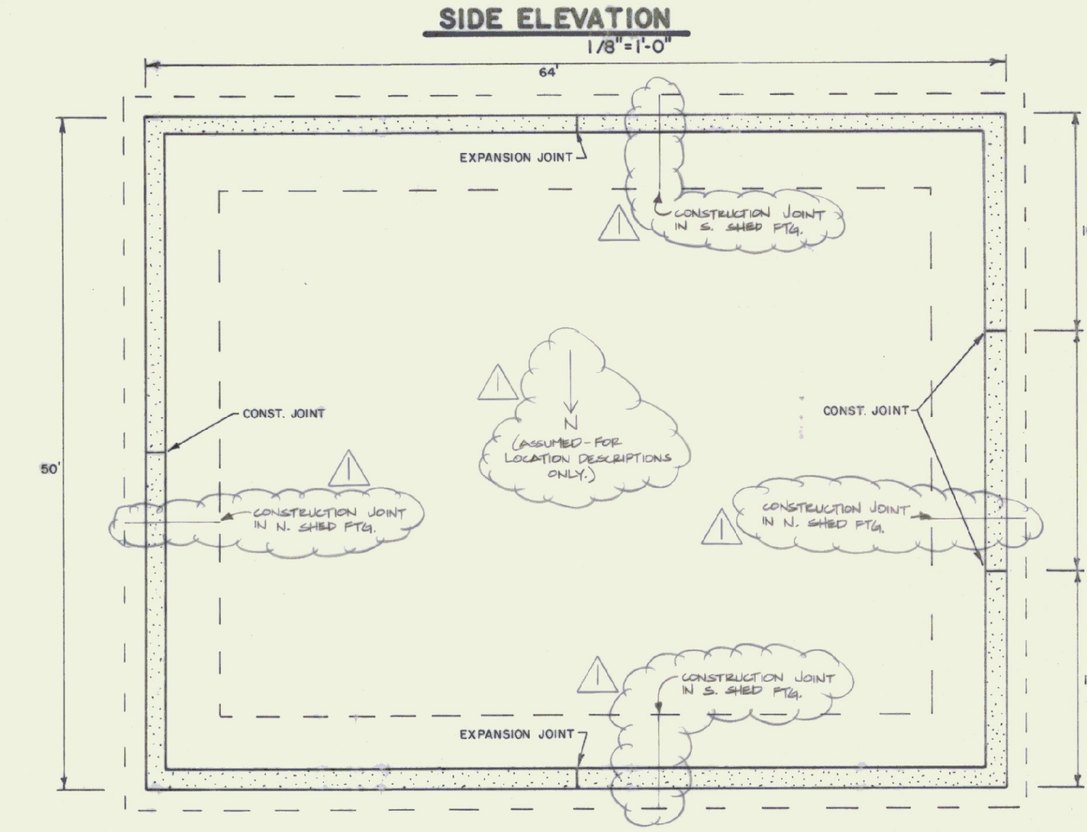

FOUNDATION PLAN
1/8" = 1'-0"

SOUTH SHED CONCRETE PLACEMENT SCHED.

8-17-95 W. SECTION OF PTG. BETWEEN CONST. JOINTS.
8-21-95 E. SECTION OF PTG. BETWEEN CONST. JOINTS.
8-22-95 W. WALL UNDER DOORWAY BETWEEN CONST. JOINTS.
8-25-95 N.E. WALLS BETWEEN CONST. JOINT & EXPANSION JOINT.
8-29-95 S.E. WALLS BETWEEN CONST. JOINT & EXPANSION JOINT.
8-31-95 N.W. WALLS BETWEEN CONST. JOINT & EXPANSION JOINT.

NORTH SHED CONCRETE PLACEMENT SCHED.

7-20-95 N. SECTION OF PTG. BETWEEN CONST. JOINT.
7-25-95 S. SECTION OF PTG. BETWEEN CONST. JOINT.
8-1-95 N.E. WALLS BETWEEN CONST. JOINT & EXPANSION JOINT.
8-2-95 W. WALL UNDER DOORWAY BETWEEN CONST. JOINTS.
8-4-95 S.E. WALLS BETWEEN CONST. JOINT & EXPANSION JOINT.
8-8-95 N.W. WALLS BETWEEN CONST. JOINT & EXPANSION JOINT.
8-10-95 S.W. WALLS BETWEEN CONST. JOINT & EXPANSION JOINT.

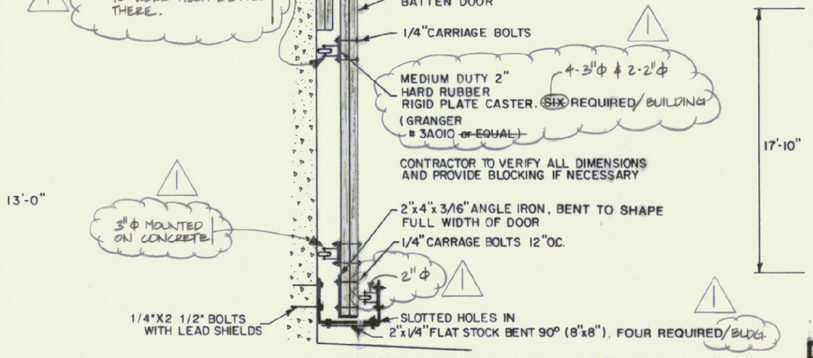

DOOR GUIDE DETAIL
N.T.S.

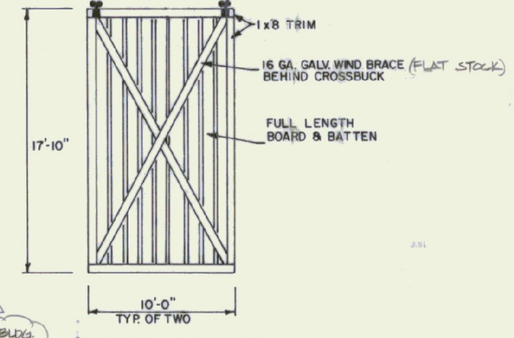

DOOR DETAIL
N.T.S.

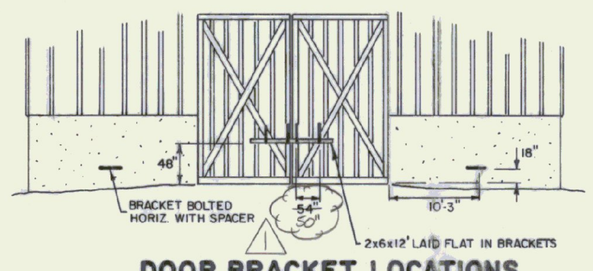

DOOR BRACKET LOCATIONS
N.T.S.

CONCRETE NOTES

- ALL CONCRETE TO BE 3500 PSI AT 28 DAYS WITH MAXIMUM SLUMP OF 4"
- EXPOSED WALLS TO BE DRESS FINISHED PER A.O.T. SPEC.
- 1/2" V-JOINTS IN EXPOSED FACE OF CONST JOINTS
- 3/4" CHAMFER ON EACH FACE OF EXPANSION JOINTS
- L-IRON CAST INTO WALL CORNERS AT DOOR OPENINGS
- RE-BAR TO BE CONTINUOUS THROUGH CONST. JOINTS
- NO HORIZONTAL CONST. JOINTS IN WALLS, CONTINUOUS POUR.
- NO CONST. OR EXP. JOINTS REQUIRED IN FOOTINGS
- ALL RE-BAR TO BE GRADE 60
- CONTRACTOR TO LEAVE NO METAL WITHIN 1" OF SURFACE. USE 1" DEEP PLASTIC CONES AT ALL TIES AND PLUG ALL TIE HOLES WITH AN APPROVED NON-SHRINK GROUT
- RE-BAR TO BE STORED ON BLOCKING 4" MIN. ABOVE GROUND
- CONCRETE SUPPLIER TO PROVIDE TEST CYLINDERS FOR TESTING BY OWNER
- CONCRETE SUPPLIER TO CONDUCT ON SITE AIR TESTS
- 6-8% AIR ENTRAINMENT

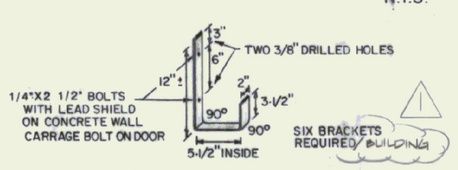

1/4"x2"x 22"± HOT ROLLED STEEL, BENT TO SHAPE PAINTED FLAT BLACK (2 MILS THICK, DRY, MIN.) OVER RUST INHIBITING PRIMER

DOOR BRACKET DETAIL
N.T.S.

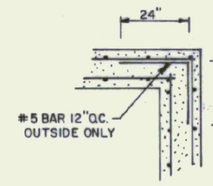

CORNER DETAIL
N.T.S.

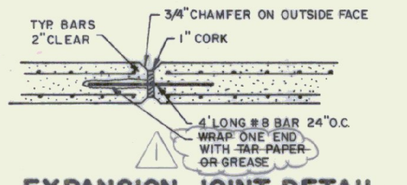

EXPANSION JOINT DETAIL
N.T.S.

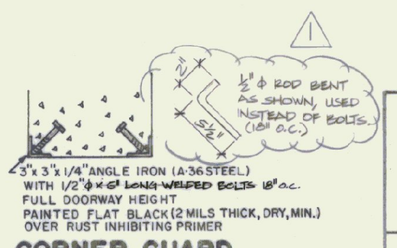

CORNER GUARD
N.T.S.

NOTE:

ALL 2x6 AND 2x8 FRAMING LUMBER AND BOARD AND BATTEN SIDING WILL BE ROUGH SAWN AND SUPPLIED BY OWNER. (STATE OF VERMONT)

CONTRACTOR TO SUPPLY ALL OTHER MATERIAL INCLUDING BOARD AND BATTEN FOR DOORS

STATE OF VERMONT
DEPARTMENT OF STATE BUILDINGS
AGENCY OF ADMINISTRATION
MONTPELIER, VERMONT

50'x 64' SALT/SAND SHED

MENDON, VERMONT

DATE:	SCALE:	REVISIONS:	DWG. NO.
MAY 3, 1995	AS NOTED	3-24-94 V.B.	A-1
DRAWN BY: J. CABES	APPROVED BY: R. FONTAULT	AS BUILTS 12-18-95 J.G.	2 OF 2