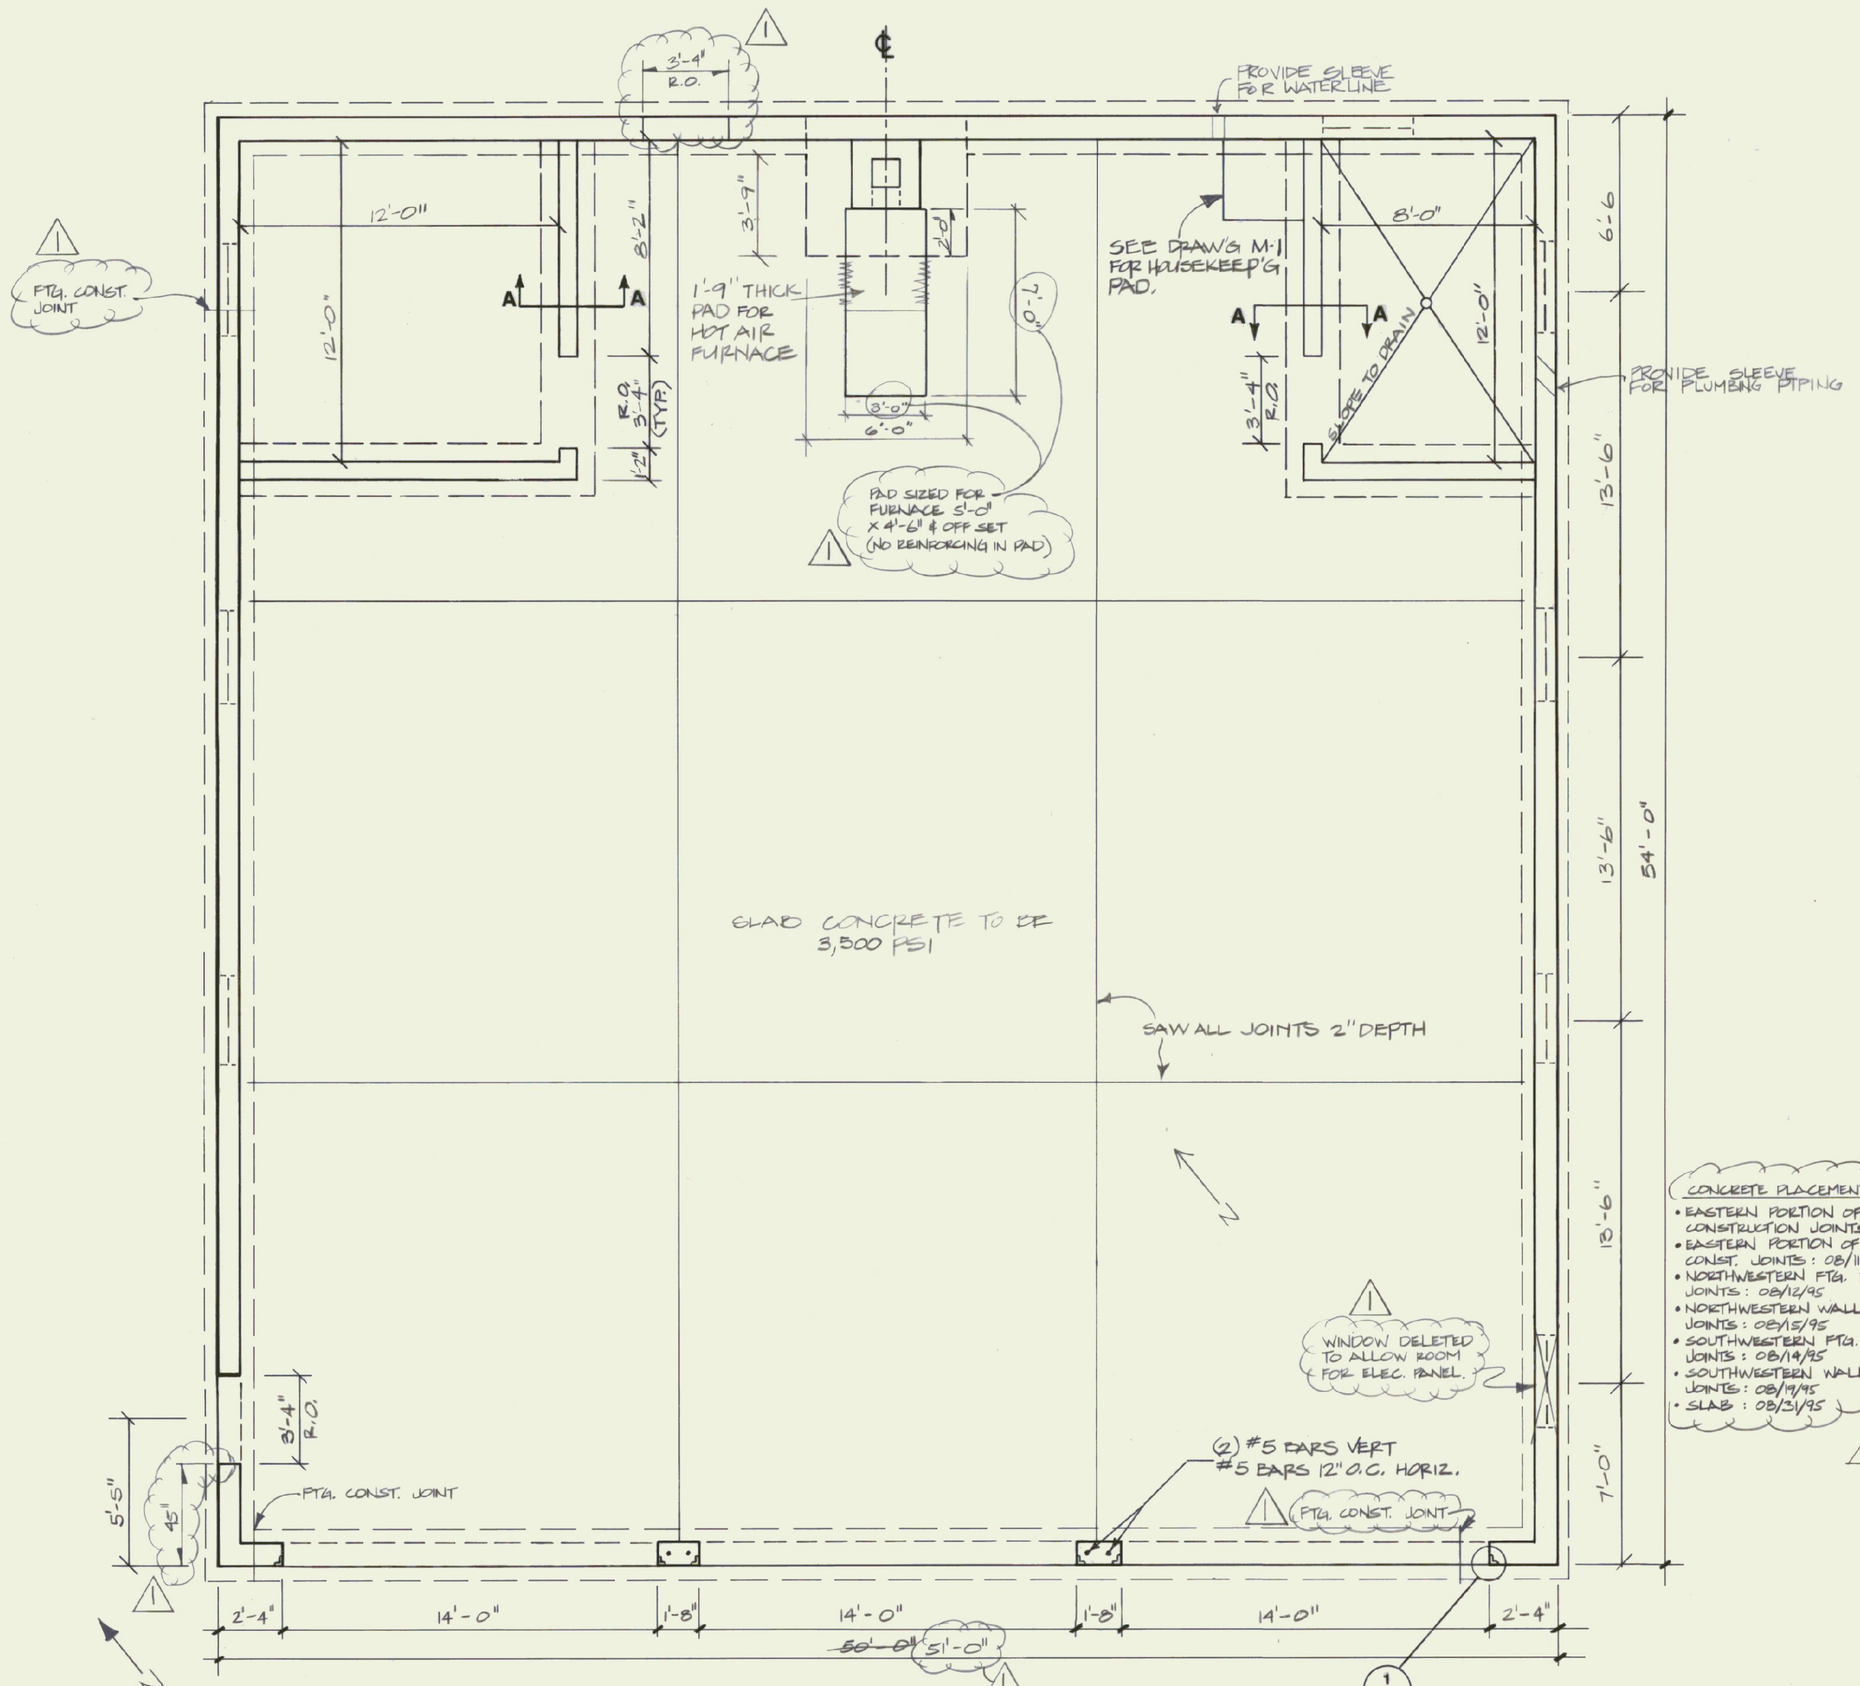

FOUNDATION PLAN

SCALE: 1/4" = 1'-0"

CONCRETE PLACEMENT

- EASTERN PORTION OF PTG. BETWEEN CONSTRUCTION JOINTS : 08/09/95
- EASTERN PORTION OF WALLS BETWEEN CONST. JOINTS : 08/11/95
- NORTHWESTERN PTG. BETWEEN CONST. JOINTS : 08/12/95
- NORTHWESTERN WALL BETWEEN CONST. JOINTS : 08/15/95
- SOUTHWESTERN PTG. BETWEEN CONST. JOINTS : 08/14/95
- SOUTHWESTERN WALL BETWEEN CONST. JOINTS : 08/17/95
- SLAB : 08/31/95

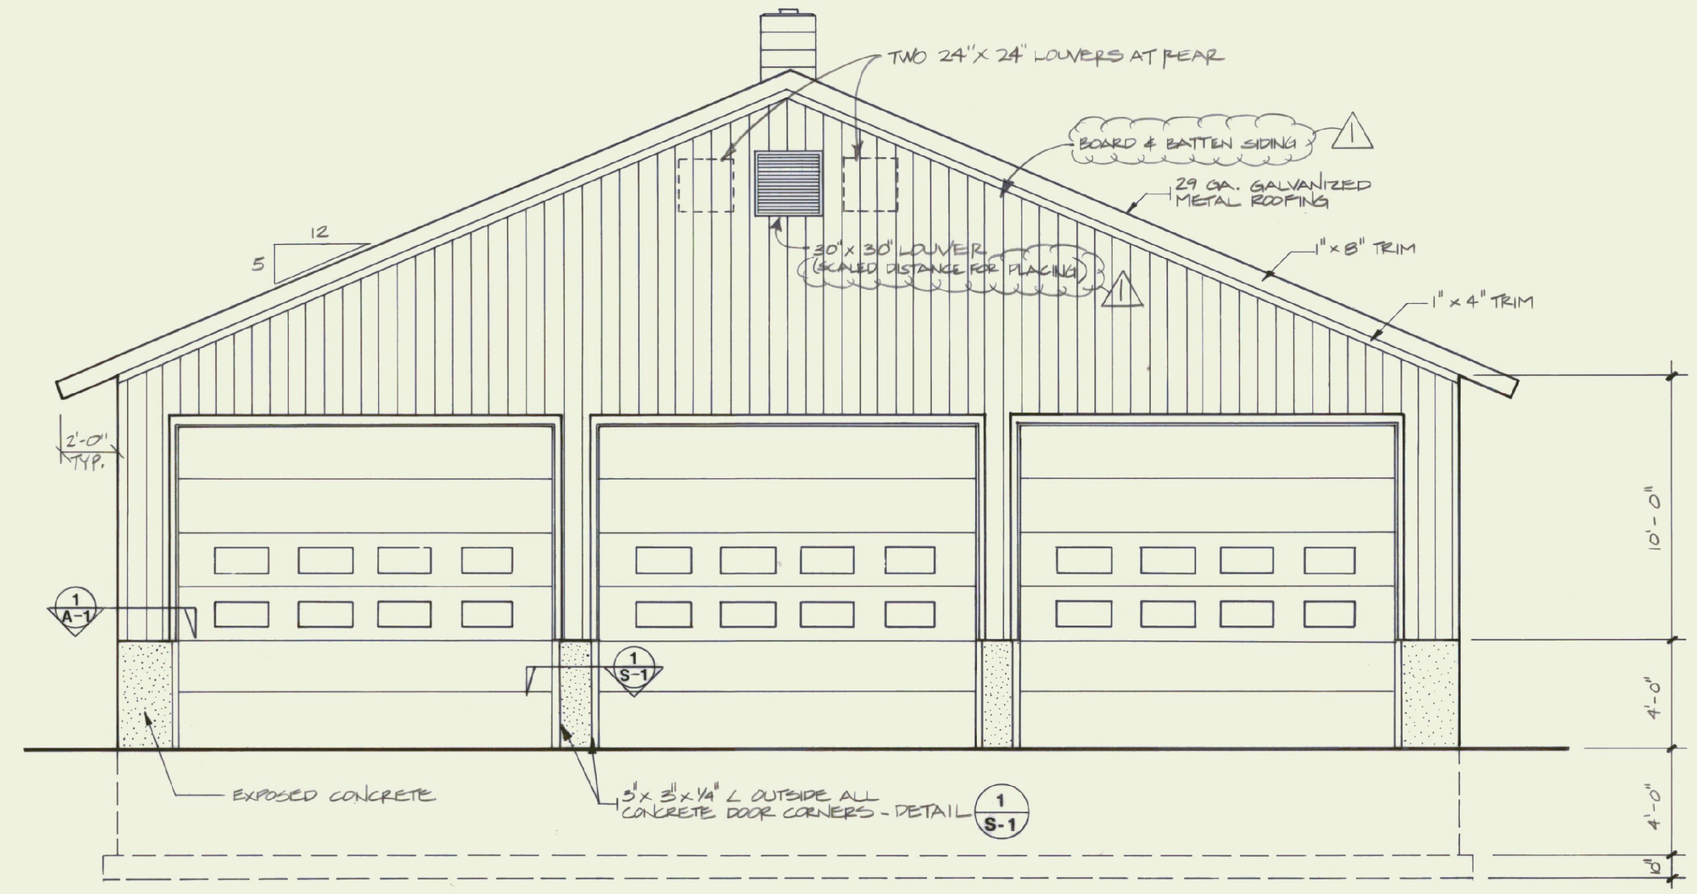

FRONT ELEVATION

SCALE: 1/4" = 1'-0"

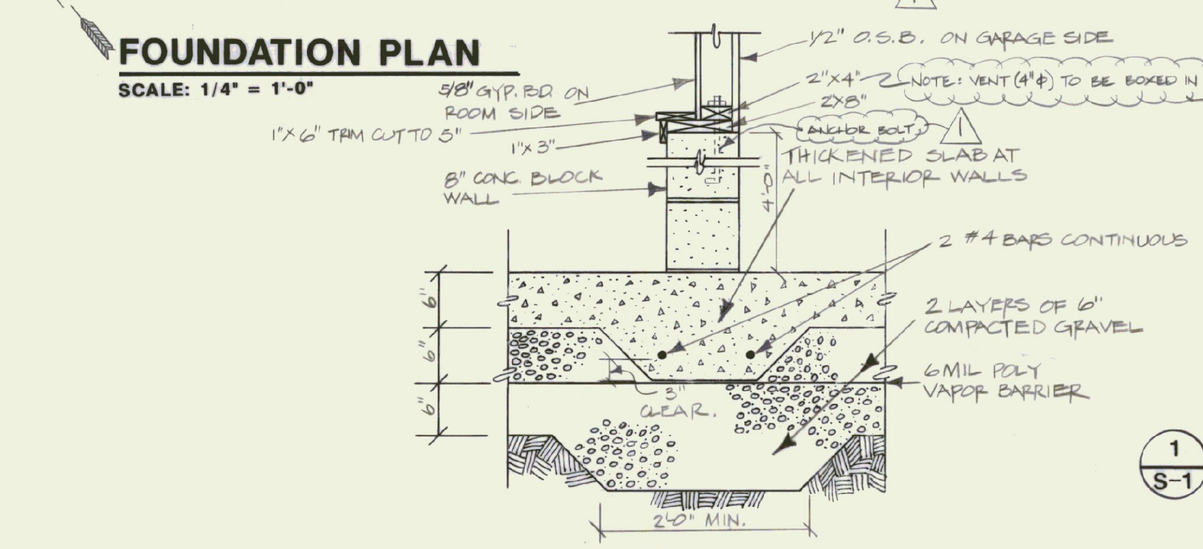

SECTION A-A

SCALE: 1" = 1'-0"

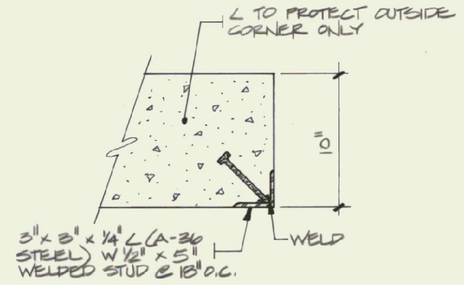

1/S-1 CORNER DETAIL

SCALE: 1 1/2" = 1'-0"

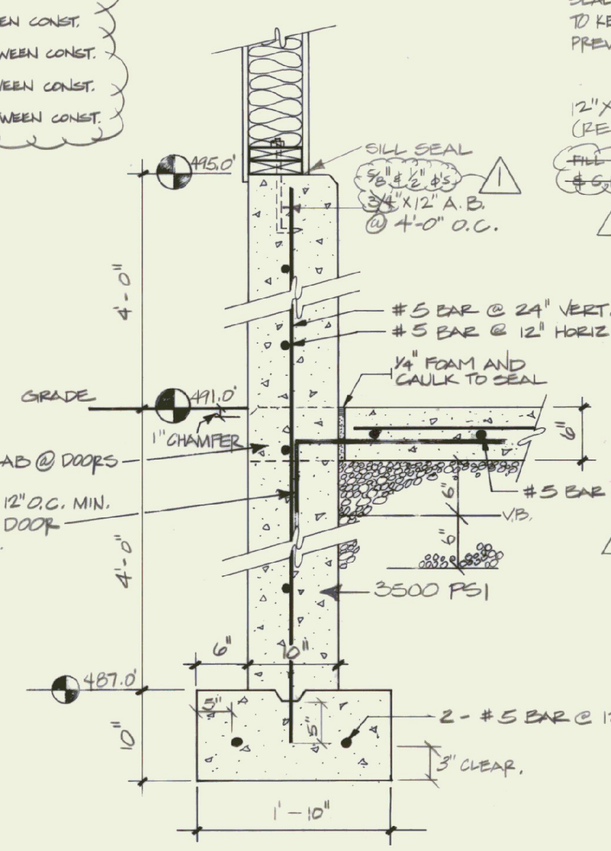

TYPICAL WALL/SLAB SECTION

SCALE: 1" = 1'-0"

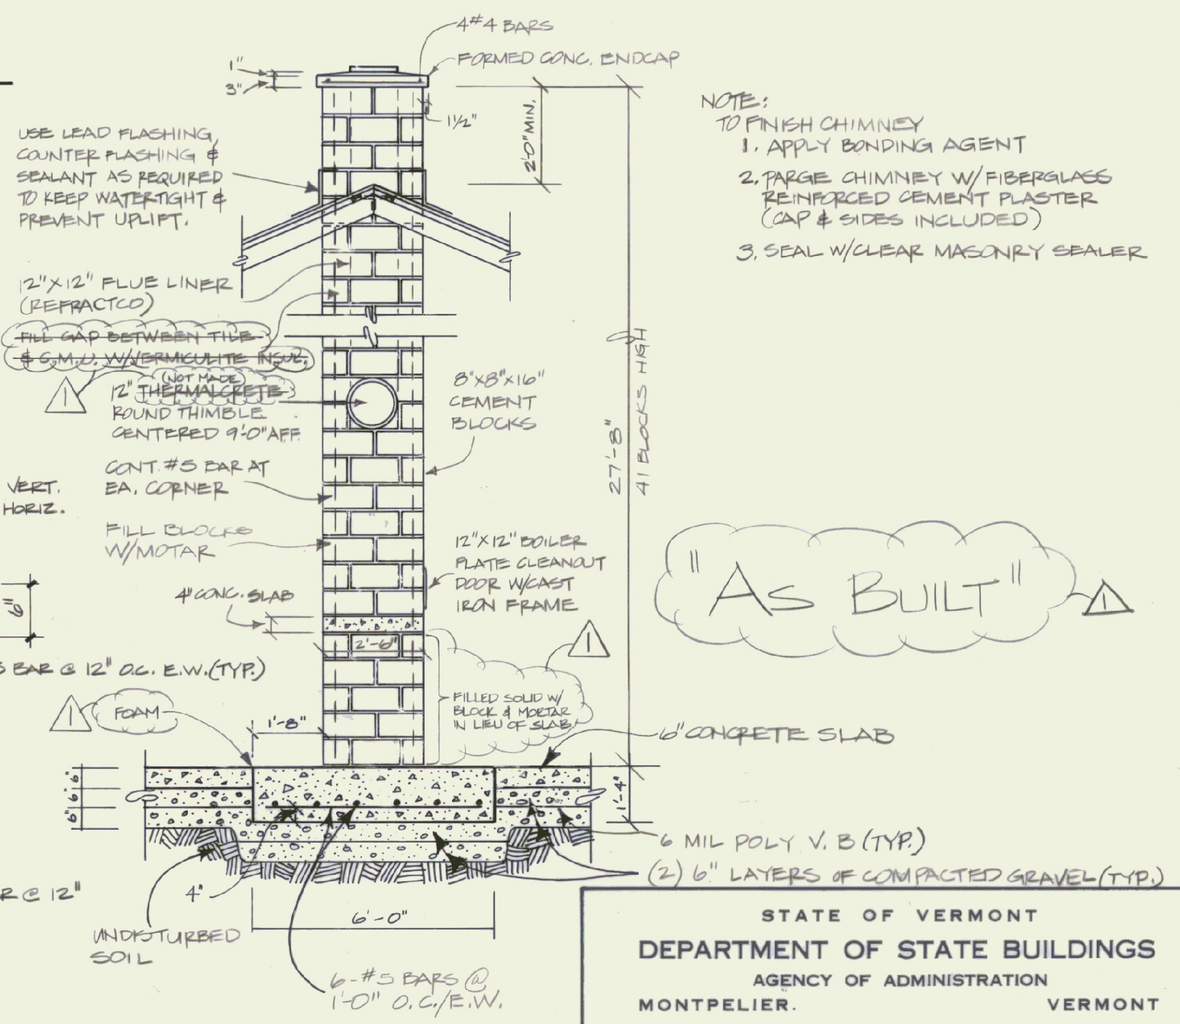

CHIMNEY ELEVATION

SCALE: 3/8" = 1'-0"

NOTE:
TO FINISH CHIMNEY
1. APPLY BONDING AGENT
2. PARGE CHIMNEY W/ FIBERGLASS REINFORCED CEMENT PLASTER (CAP & SIDES INCLUDED)
3. SEAL W/ CLEAR MASONRY SEALER

"AS BUILT"

STATE OF VERMONT
DEPARTMENT OF STATE BUILDINGS
AGENCY OF ADMINISTRATION
MONTPELIER, VERMONT

AGENCY OF TRANSPORTATION
FOUND. DETAILS & ELEVATION
SUDBURY MAINTENANCE FACILITY
3 BAY GARAGE

SUDBURY VERMONT

DATE:	SCALE:	REVISIONS:	DWG. NO.
April 21, 1995	AS NOTED	09/22/95 J.G.	S-1
DRAWN BY: A. POULIN	APPROVED BY: R. TETREAULT		4 OF 8