


NOTE: ALL DUCTWORK 24 GA.

NOTES:
 CONSTRUCT FURNACE FILTER BRACKETS
 FROM EXPANDED METAL TO HOLD 2-16"x25"x1"
 FILTERS (FILTERS TO BE EASILY REMOVABLE)

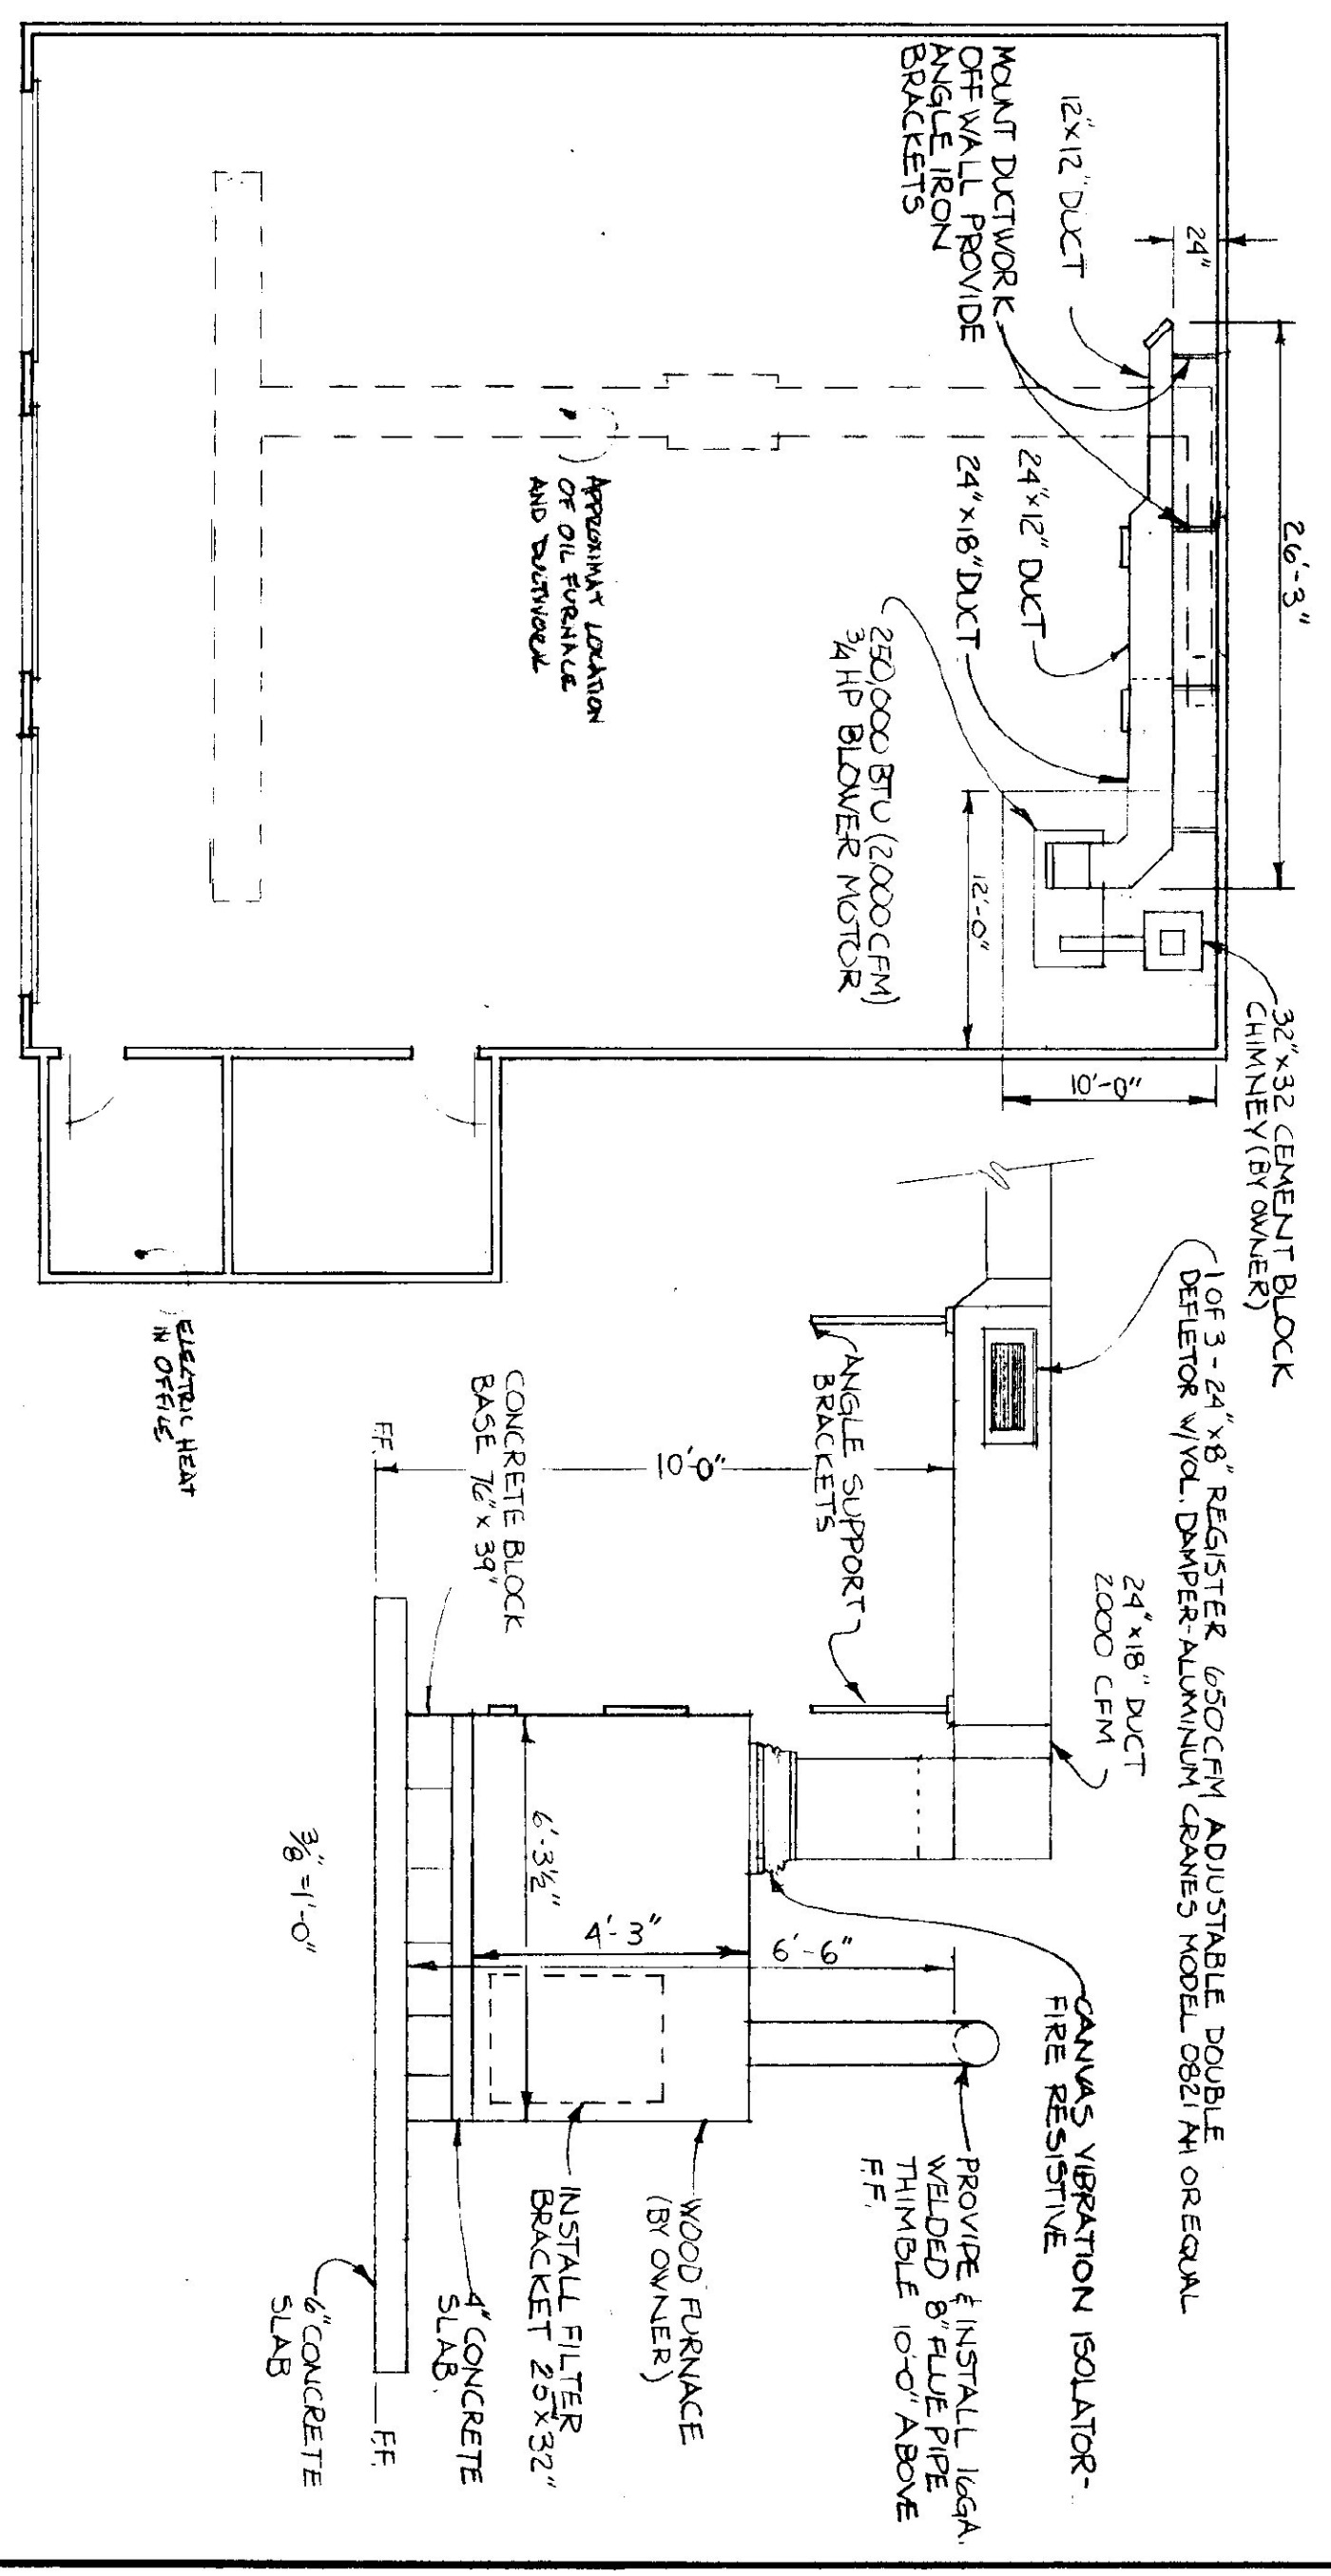

Plan 1/8" = 1'-0"

STATE OF VERMONT DIVISION OF STATE BUILDINGS AGENCY OF ADMINISTRATION MONTPELIER, VERMONT			
AGENCY OF TRANSPORTATION GARAGE ROCHESTER, VERMONT			
DATE:	SCALE:	REVISIONS:	DWG. NO.
MARCH 20, 1982	AS SHOWN	Sept 27, 1982	
DRAWN BY:	APPROVED BY:		
HANSON, PAR	FP		1 of 1