



116'-8"
 5 STAYS @ 16'-8" = 100'-0"
 5 SPANS @ 16'-8" = 83'-4"


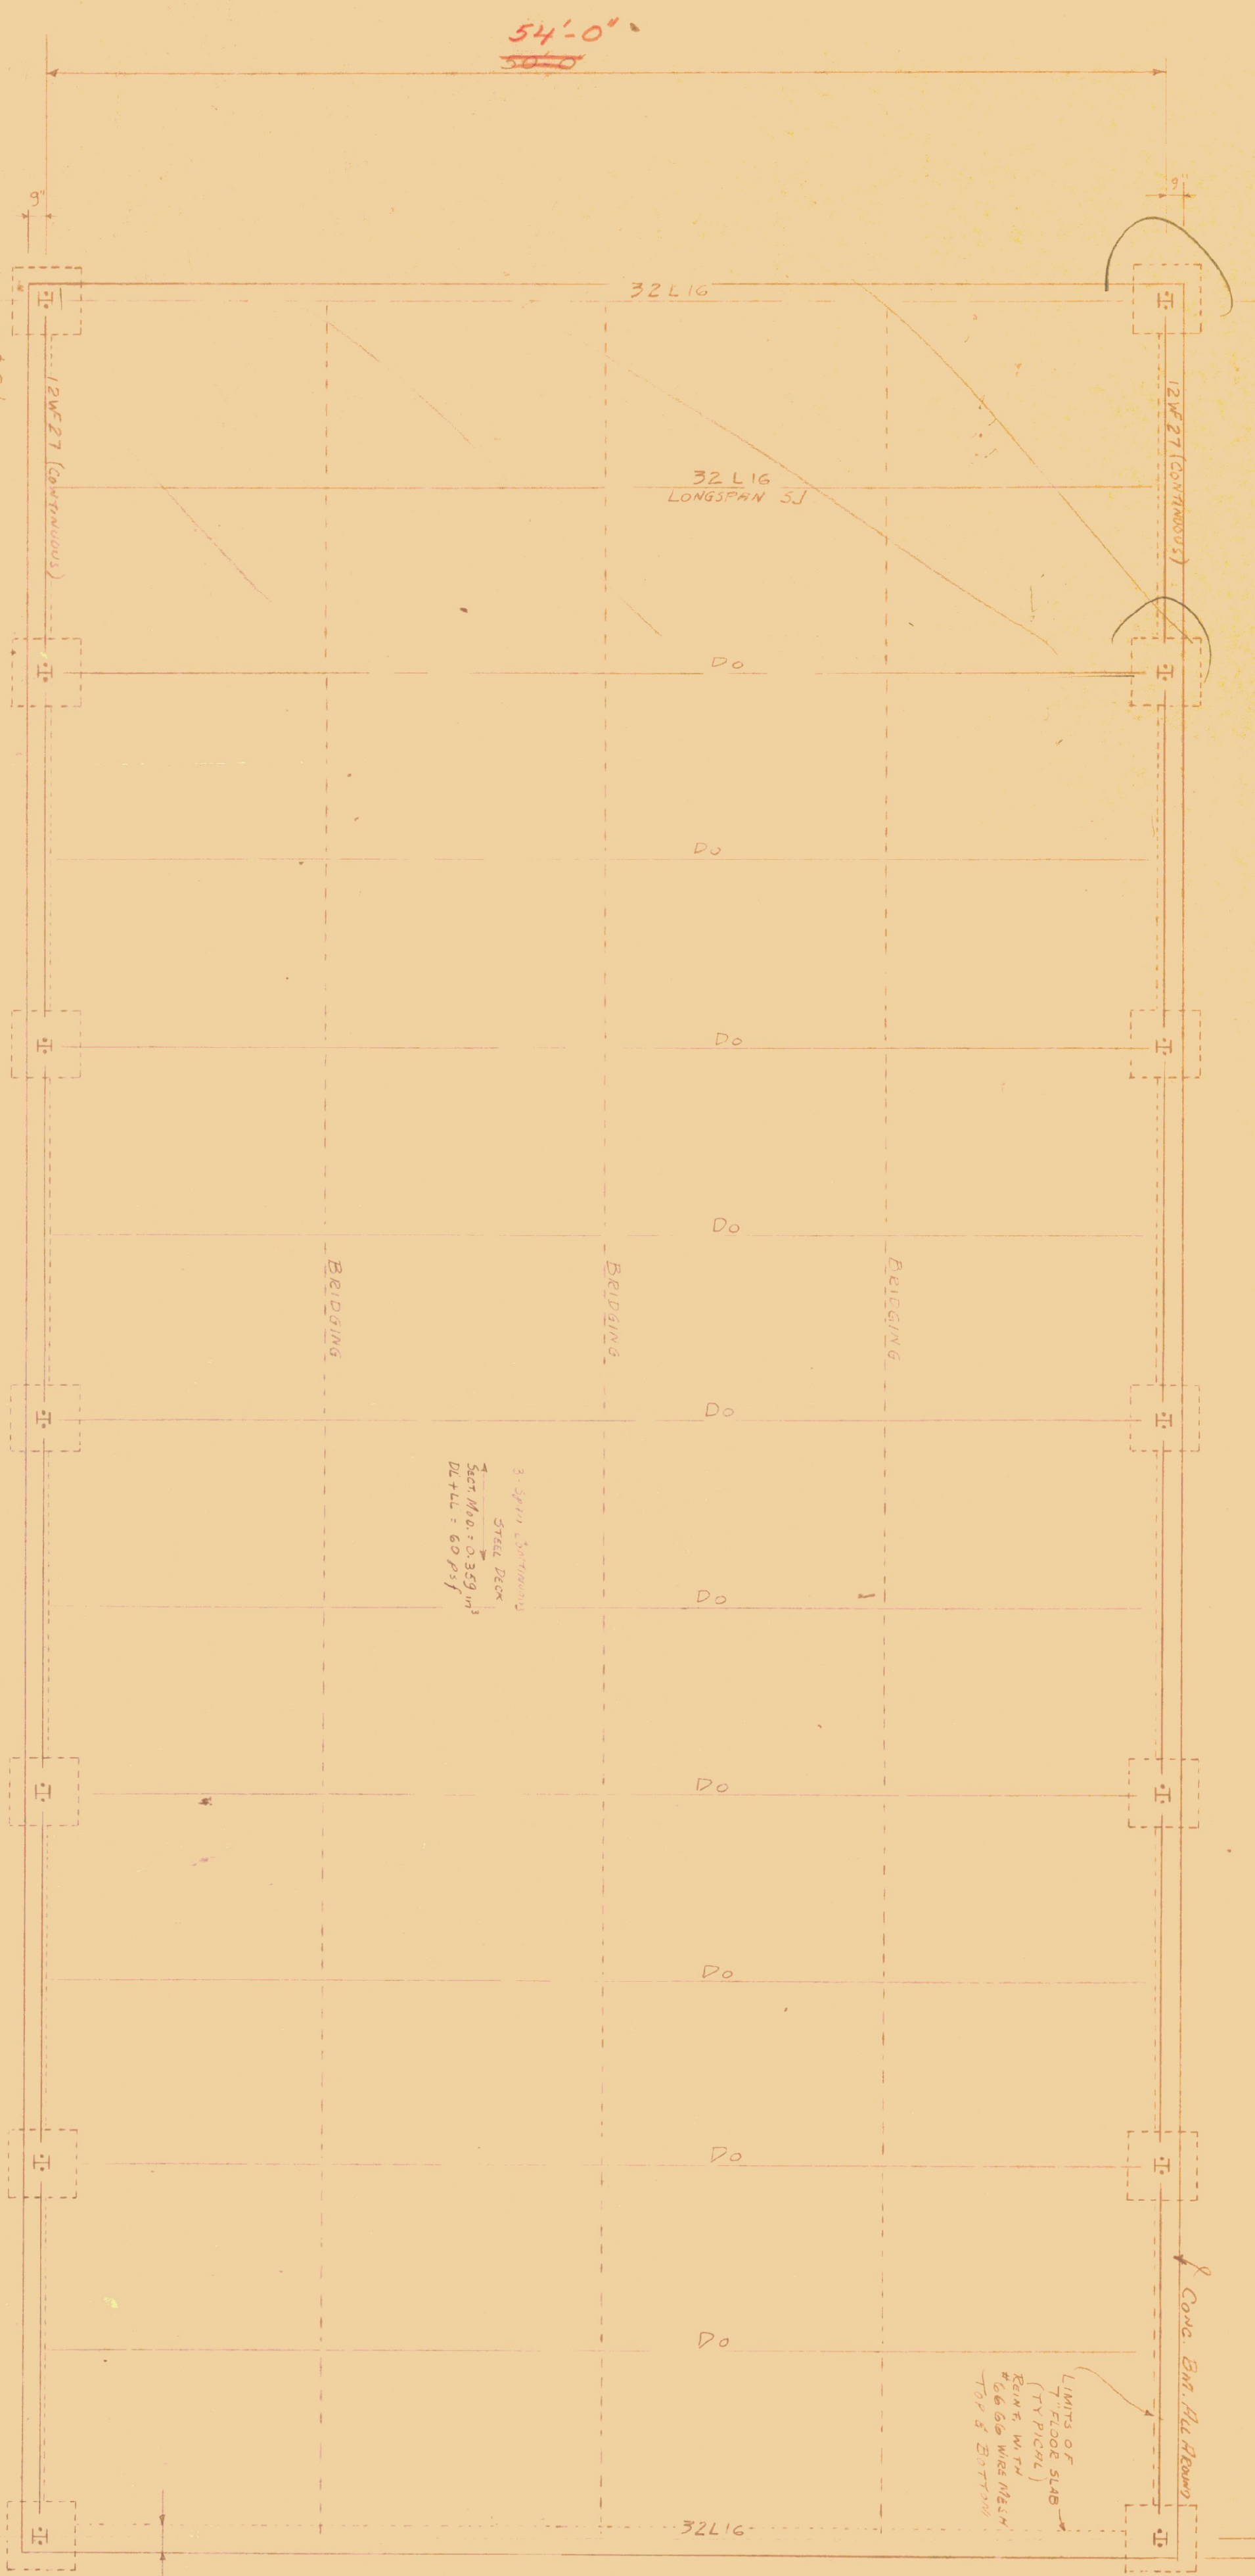


FIN. FLOOR ASSUMED EL. 100.0

PLAN
 Scale: 1/4" = 1'-0"

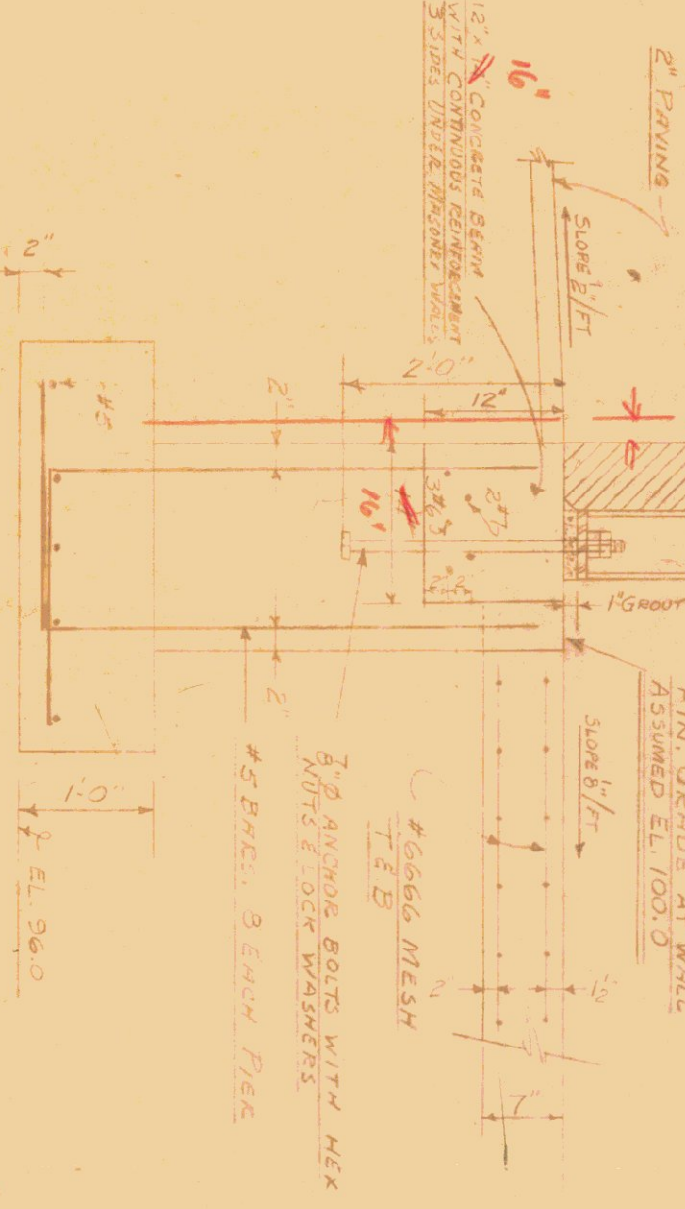

TYPICAL FRONT
 Scale: 1/4" = 1'-0"

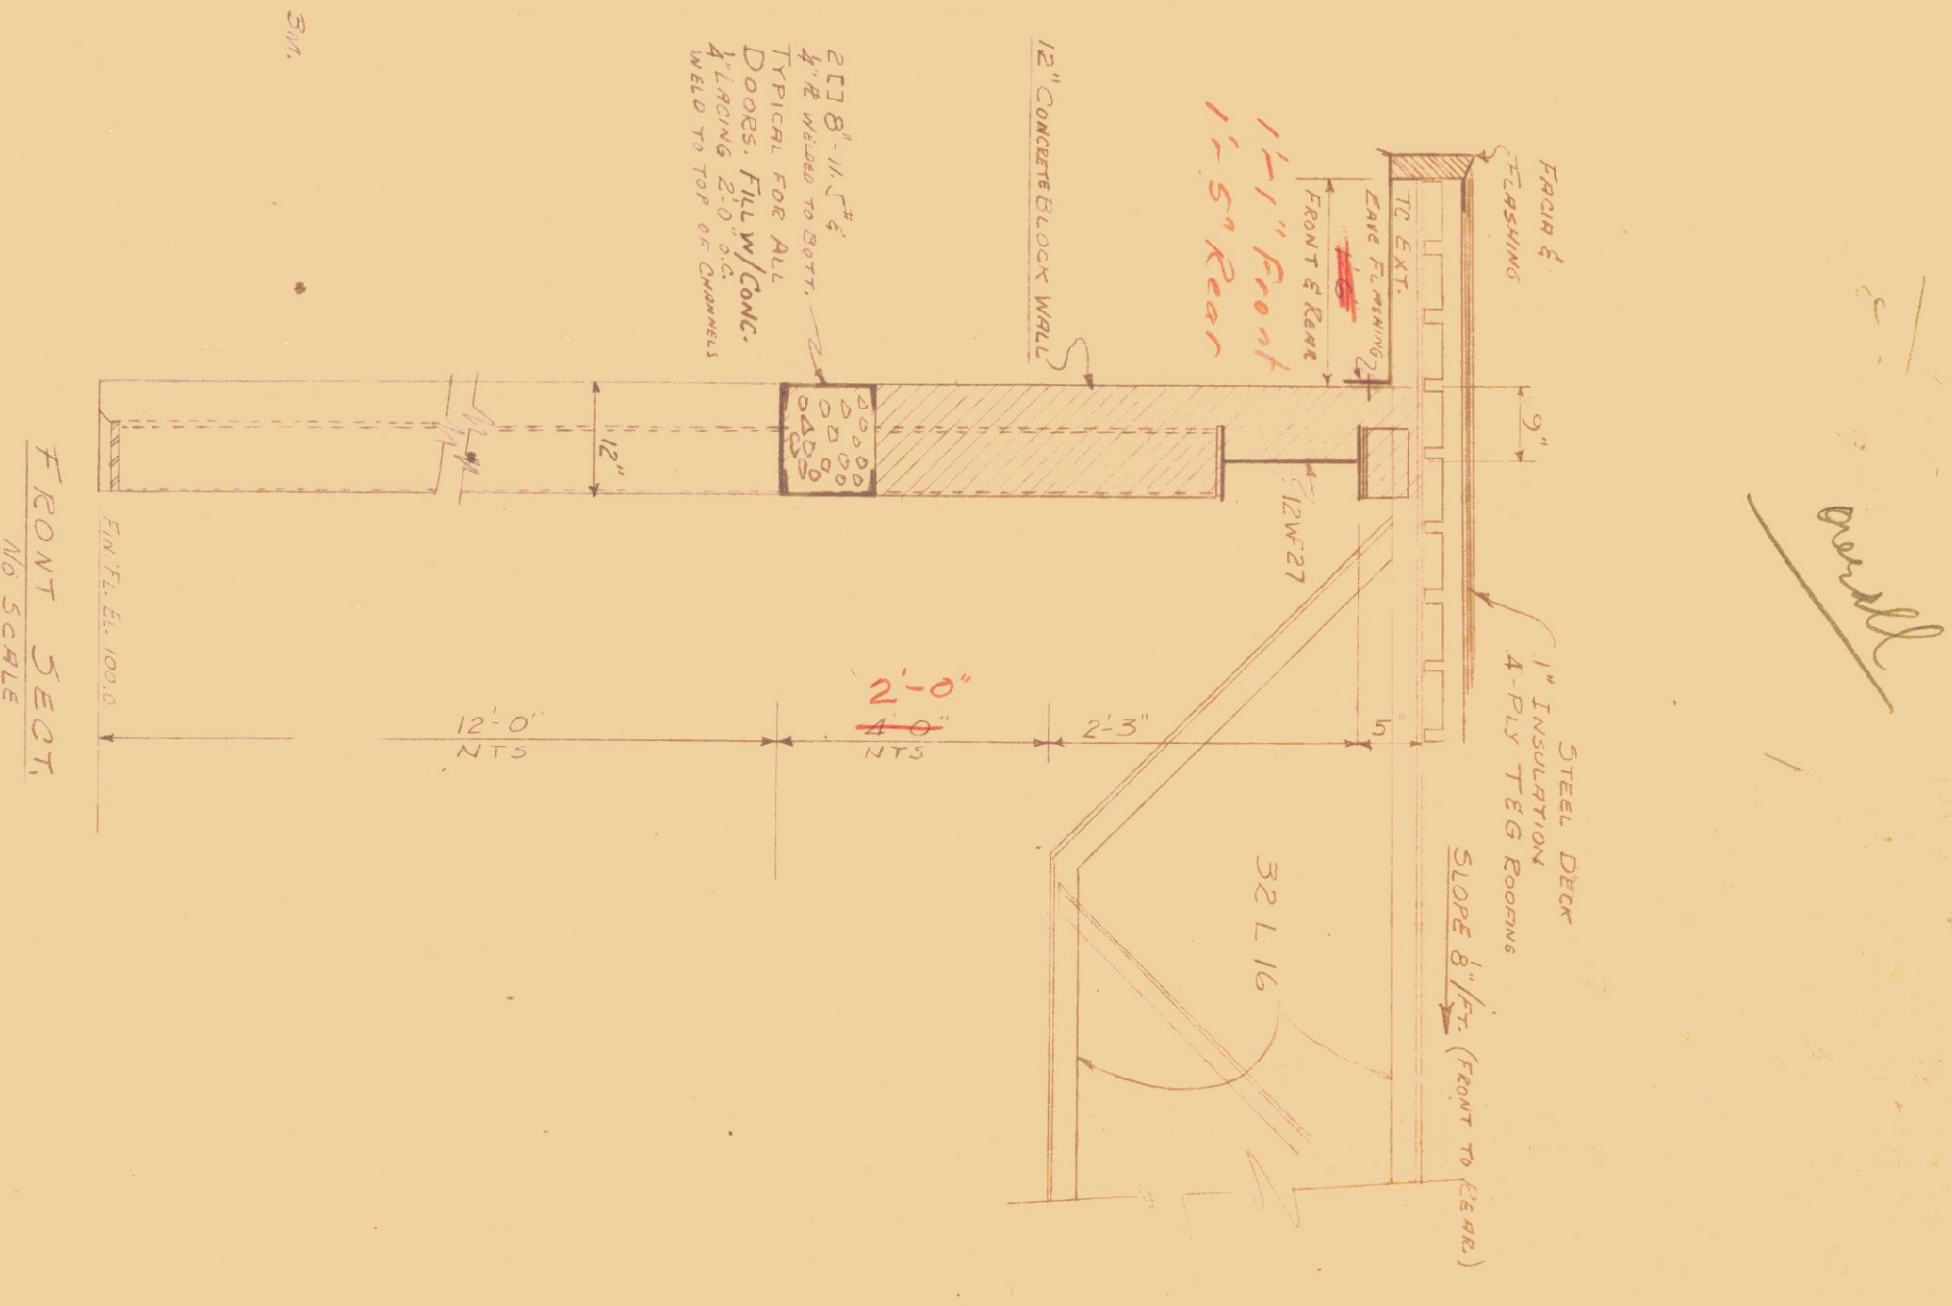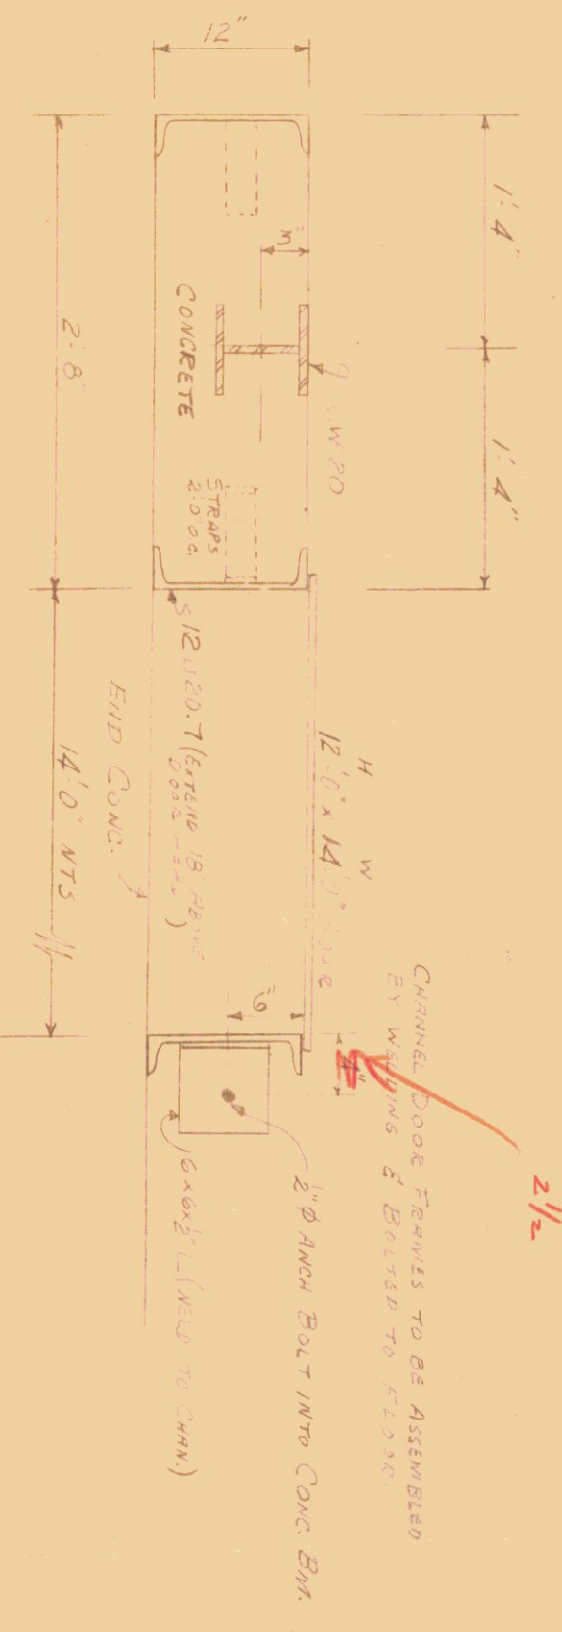

FRONT SECT
 1/2" SCALE

REINFORCING STEEL

