




FOUNDATION PLAN  
SCALE: 1/8" = 1'-0"

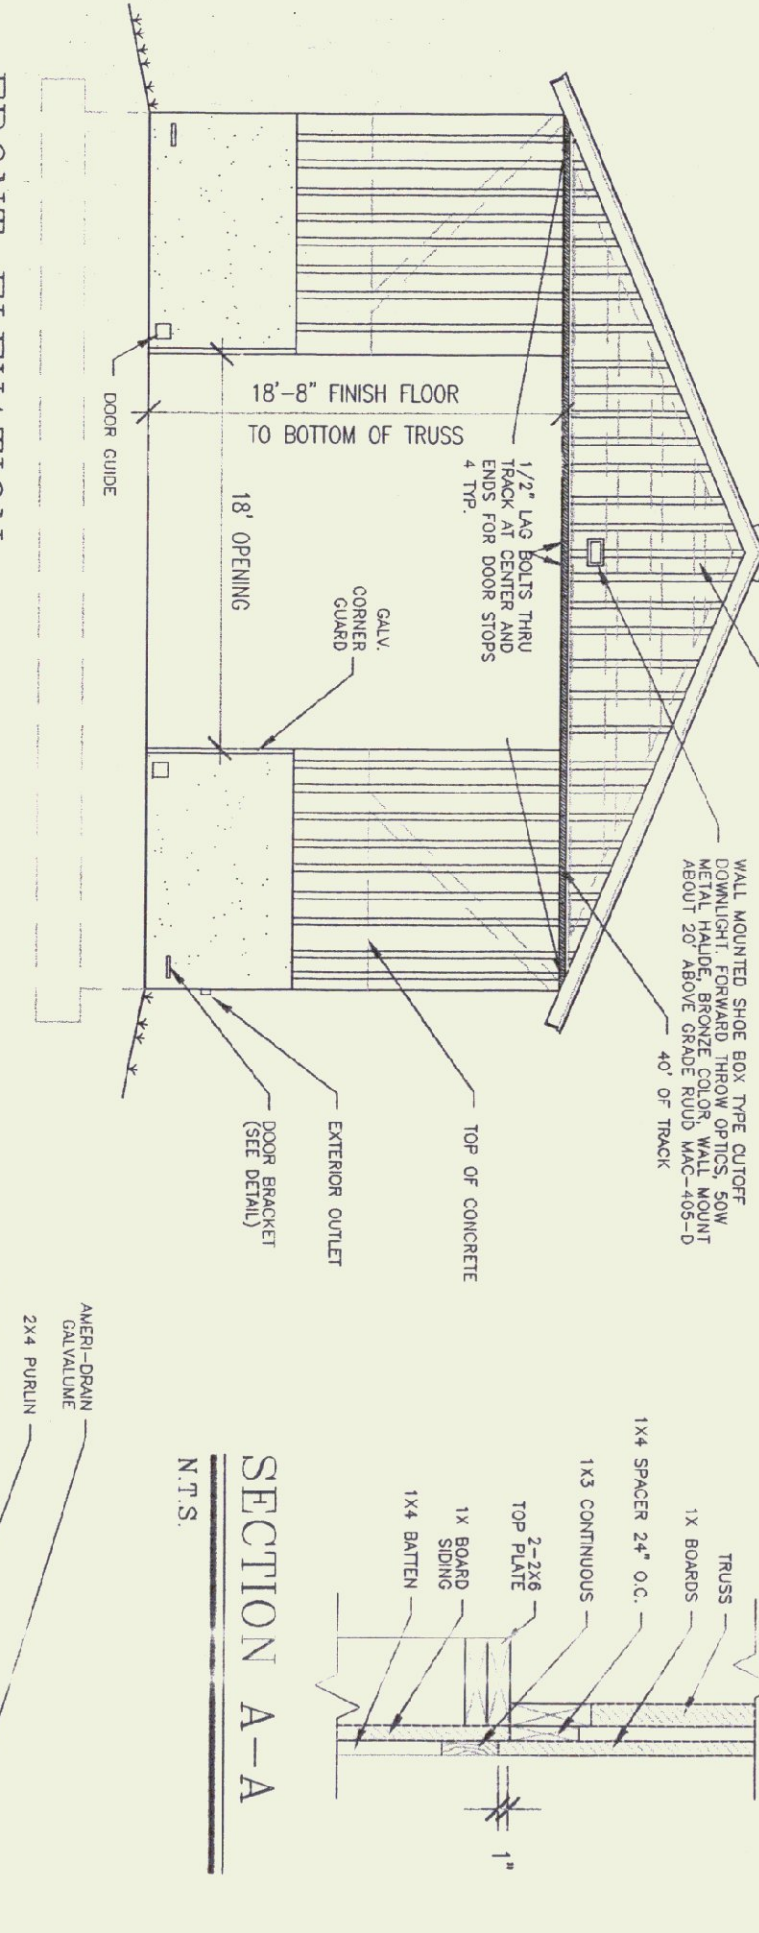


FRONT ELEVATION  
SCALE: 1/8" = 1'-0"

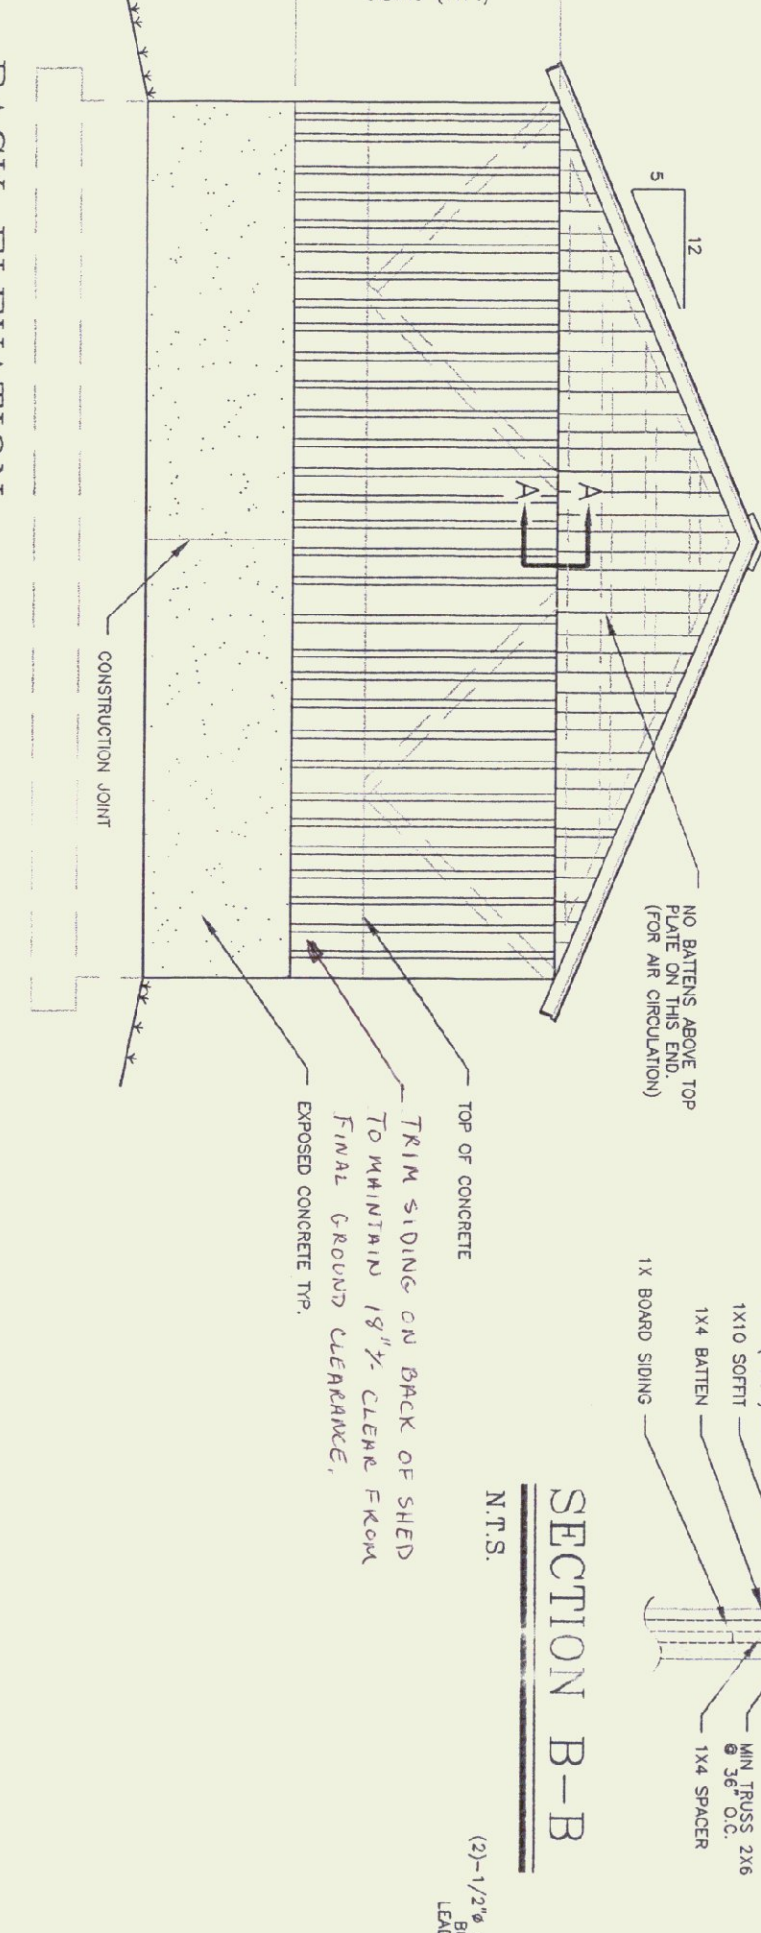


BACK ELEVATION  
SCALE: 1/8" = 1'-0"

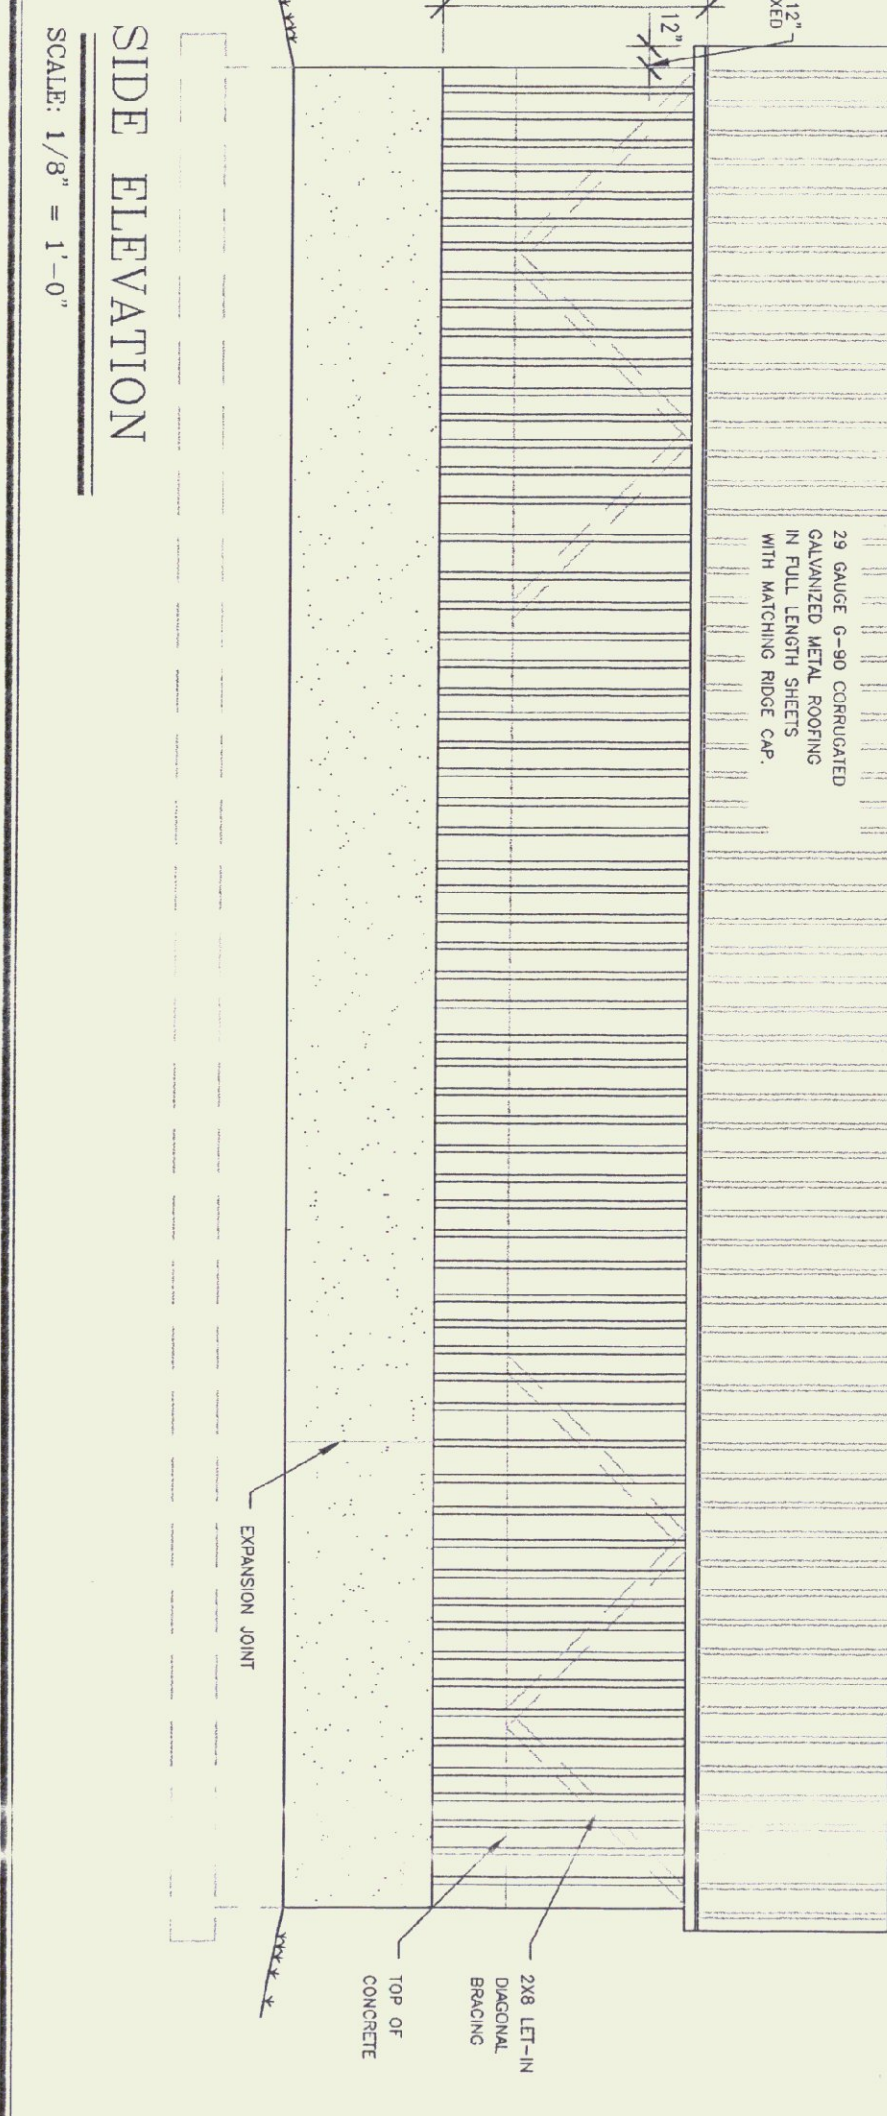


SIDE ELEVATION  
SCALE: 1/8" = 1'-0"

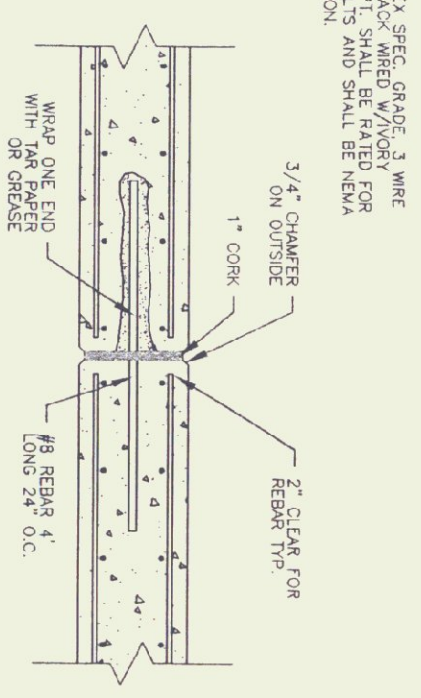


EXPANSION JOINT DETAIL  
N.T.S.

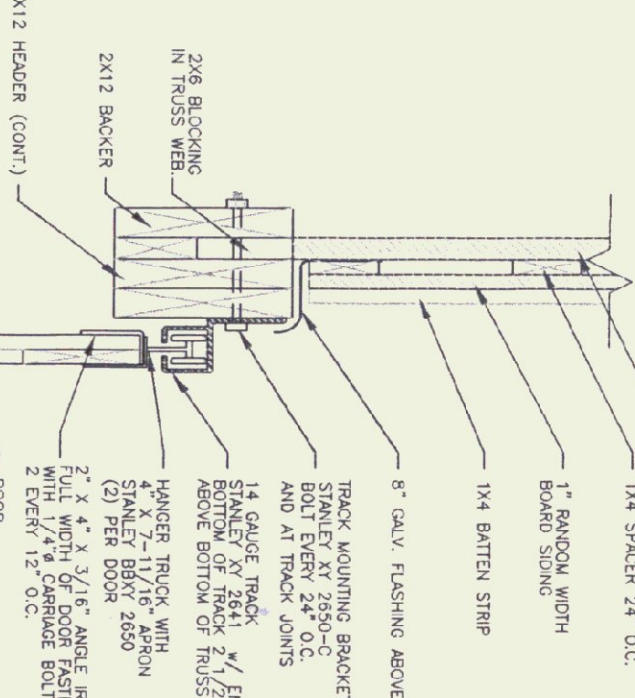


CORNER DETAIL  
N.T.S.

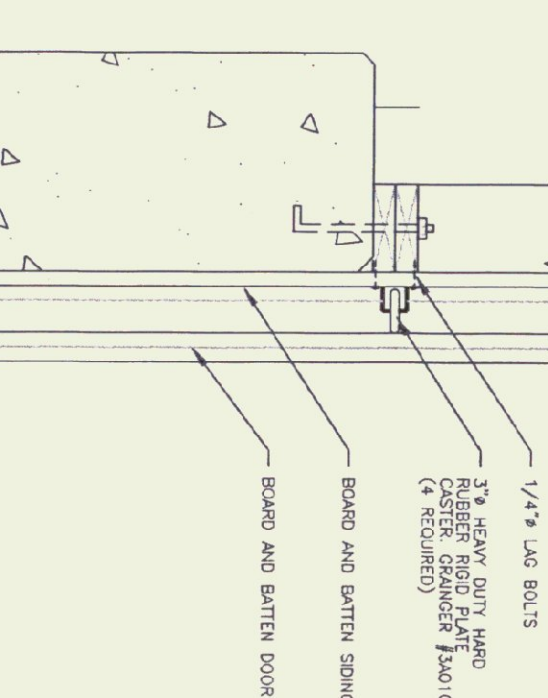


CORNER GUARD  
N.T.S.

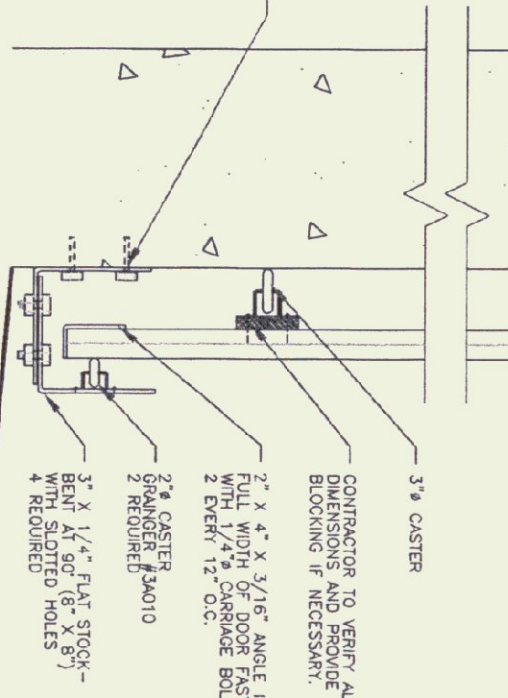


DOOR TRACK & GUIDE DETAIL  
N.T.S.

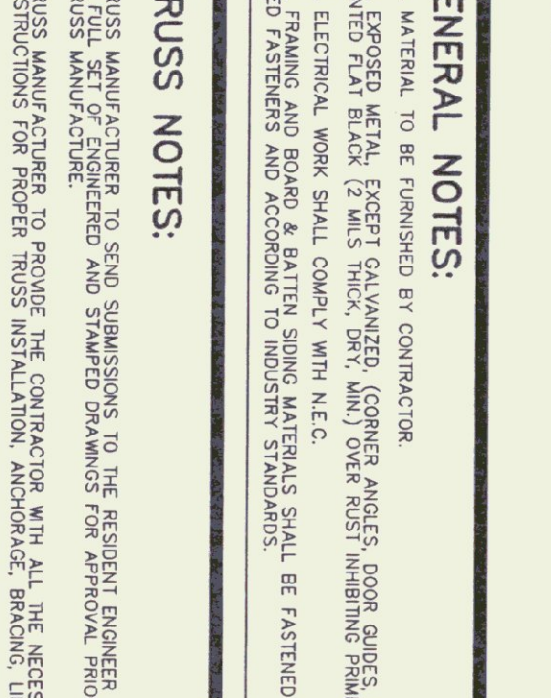


DOOR BRACKET LOCATION  
N.T.S.

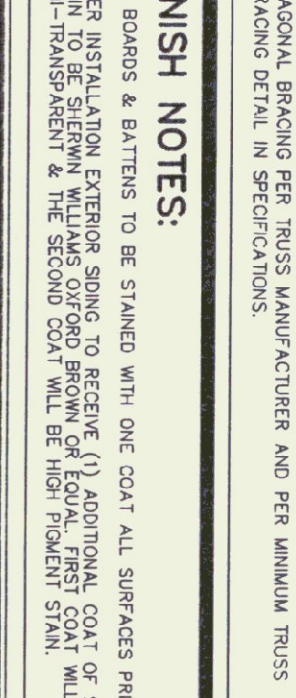


EXT. DOOR DETAIL  
N.T.S.

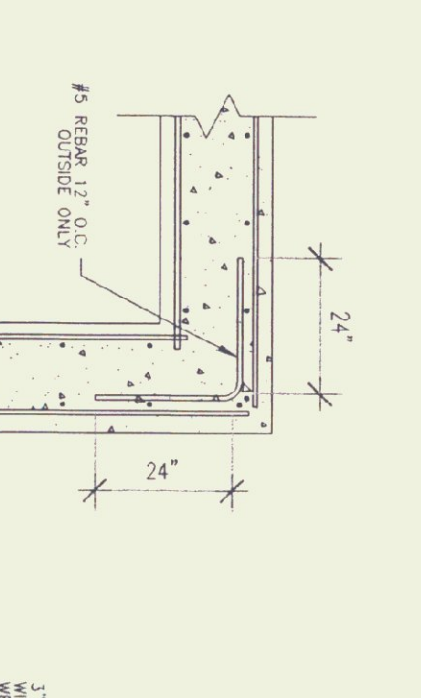


DOOR BRACKET DETAIL  
N.T.S.

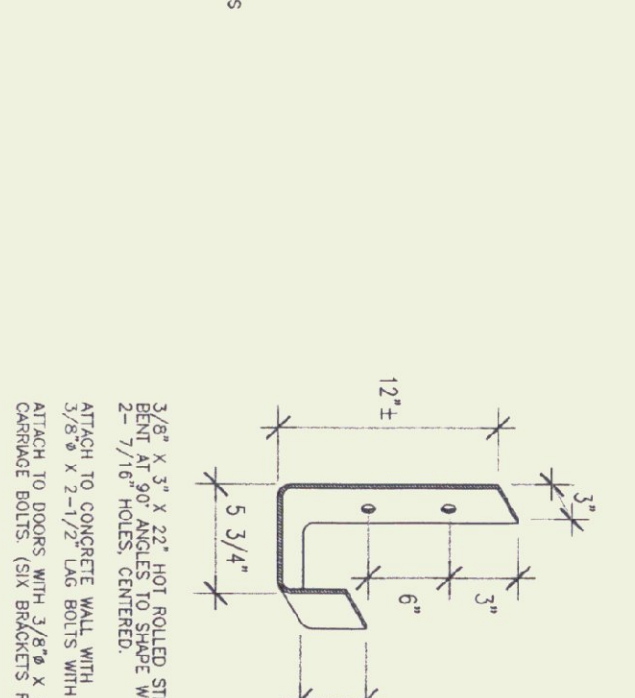

NAILER DETAIL  
N.T.S.

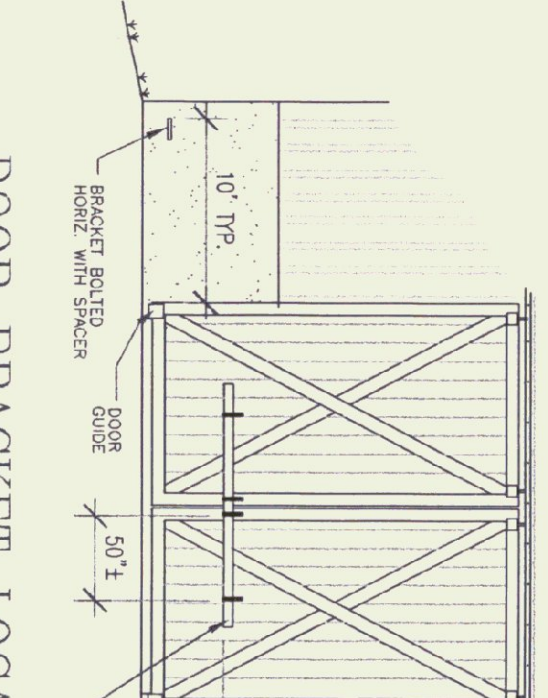

WALL SECTION (TYP.)  
SCALE: 3/4" = 1'-0"

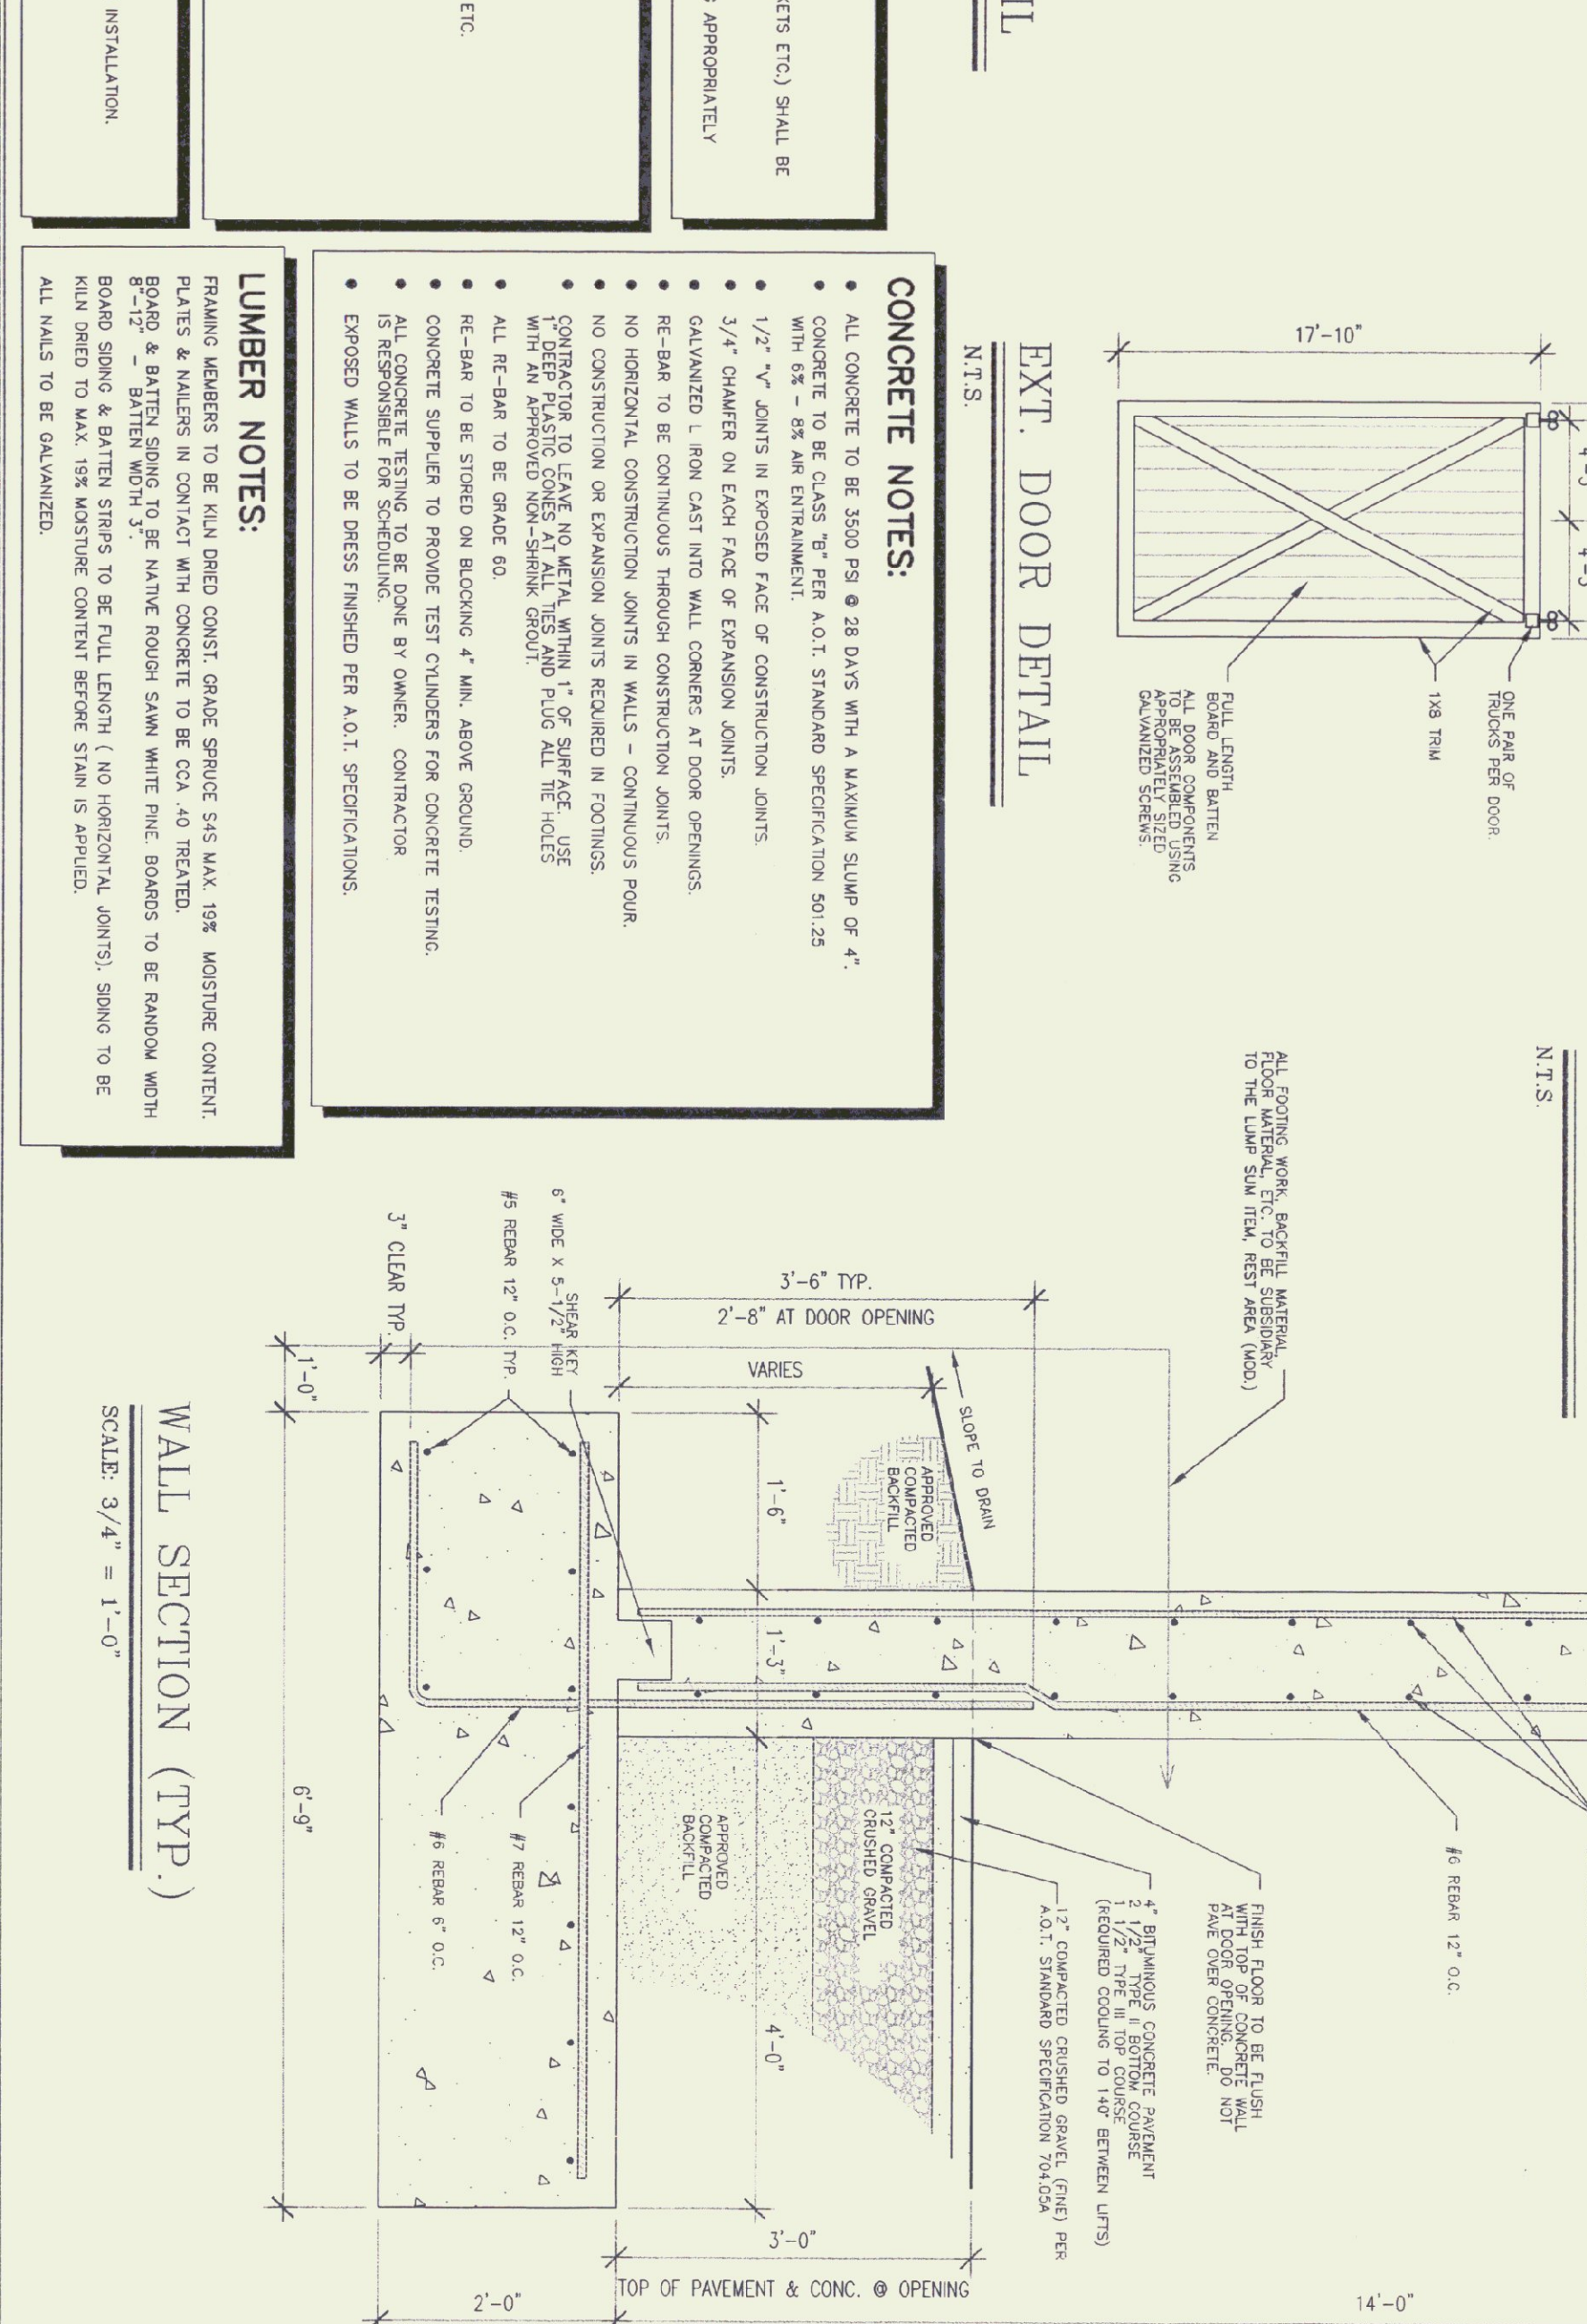

<p>STATE OF VERMONT DEPARTMENT OF BUILDINGS AND GENERAL SERVICES AGENCY OF ADMINISTRATION MONTPELIER, VERMONT</p>		<p>LOCATION &amp; BUILDING 40' X 84' SALT SHED</p>	<p>REVISIONS 12-29-91 GDN. 7-5-95 BDN. 2-10-99 BTM.</p>
		<p>TOWN, VERMONT</p>	<p>SCALE: AS NOTED DATE: JAN 1997 DRAWN BY: G. D. NORWOOD APPR. BY:</p>