White River Jct.

District No. 4
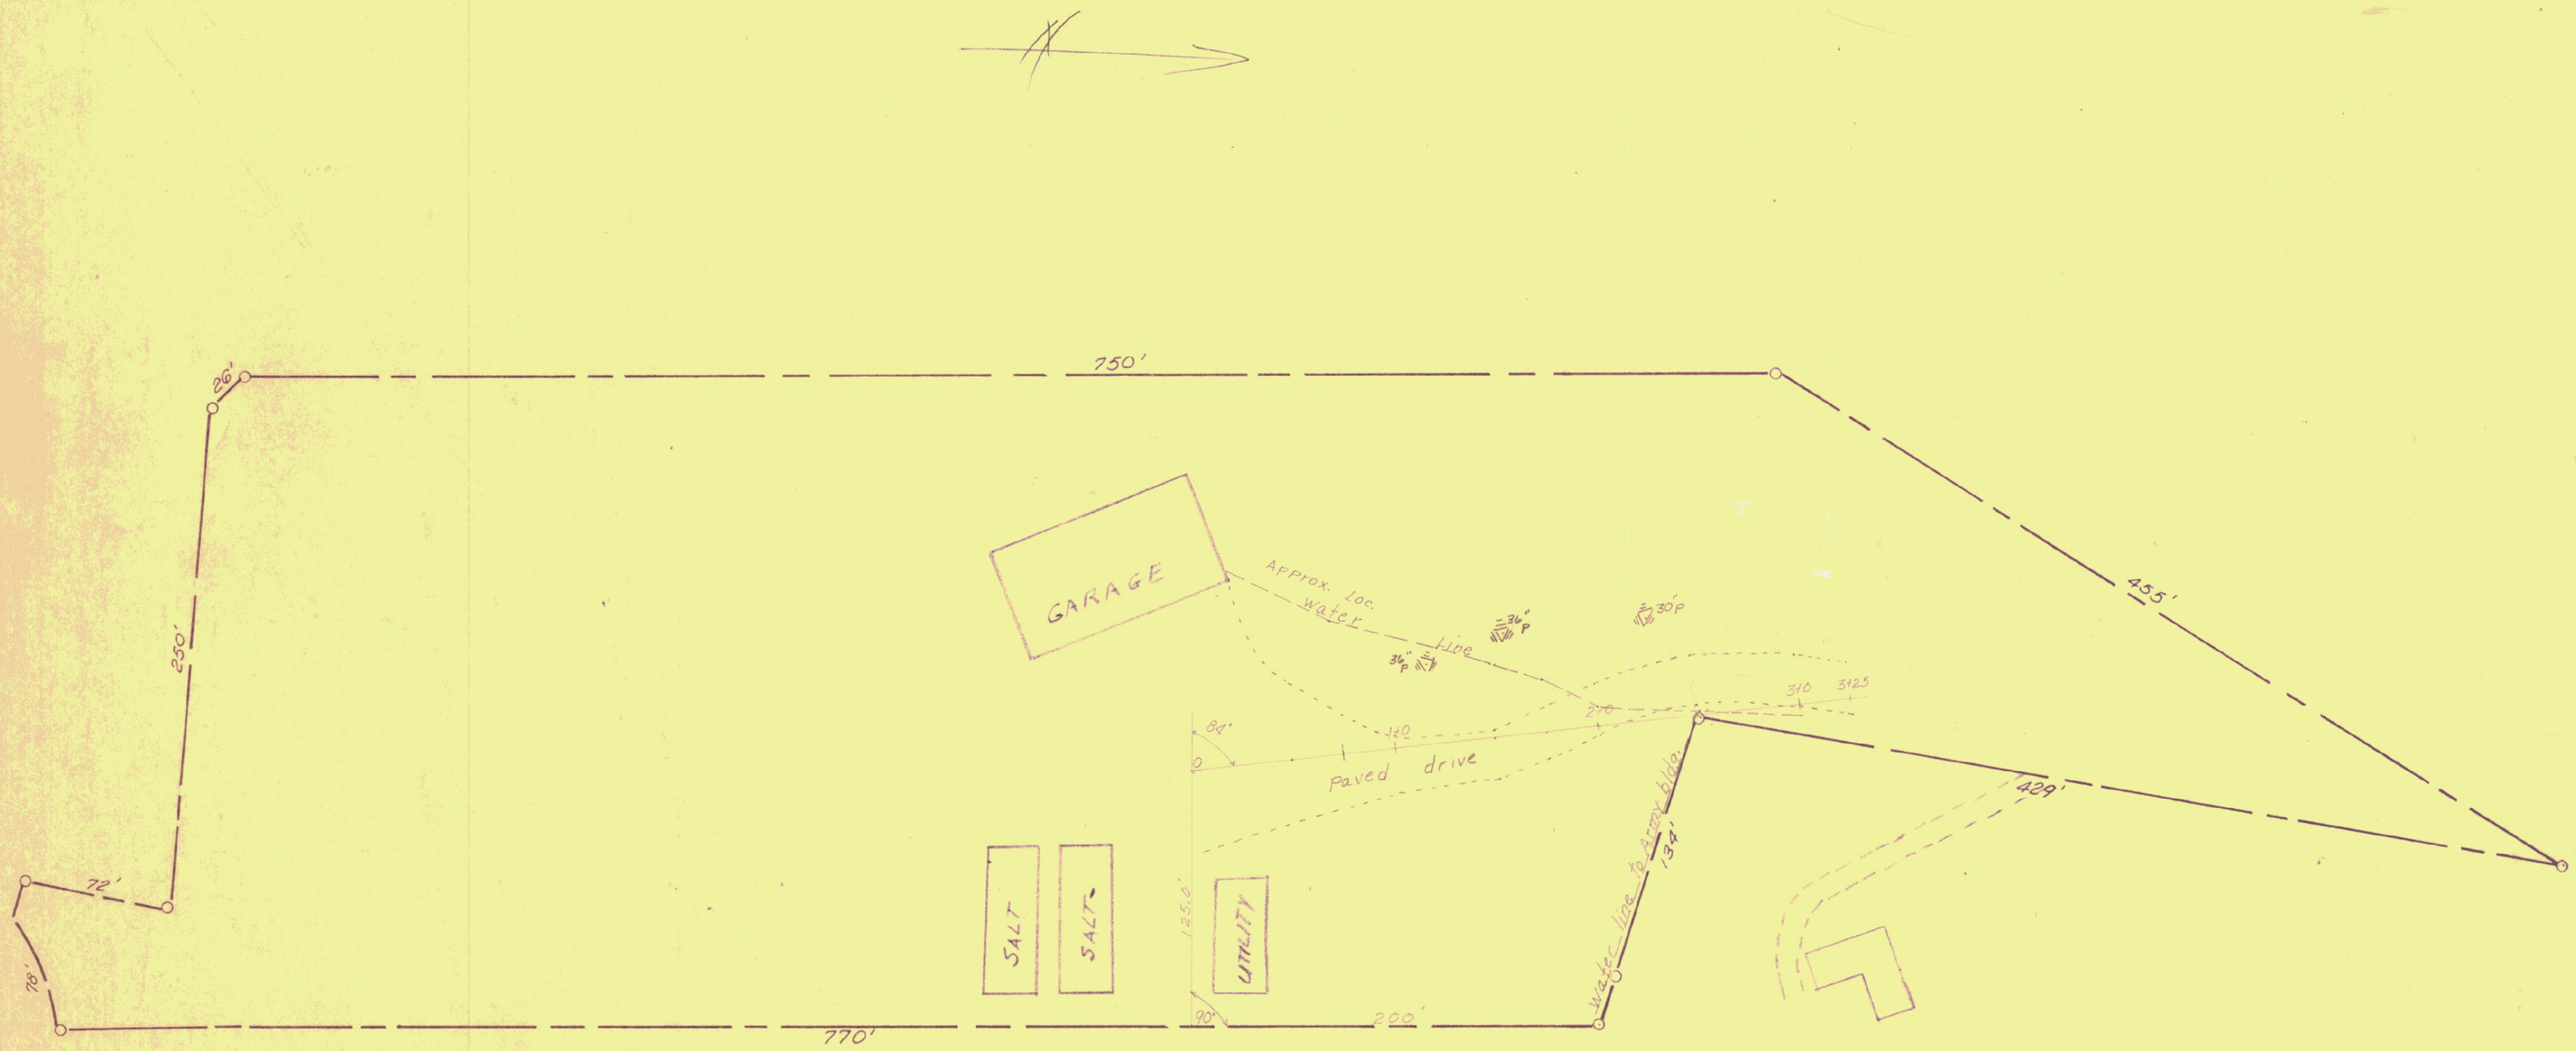
Scale 1"=50'