


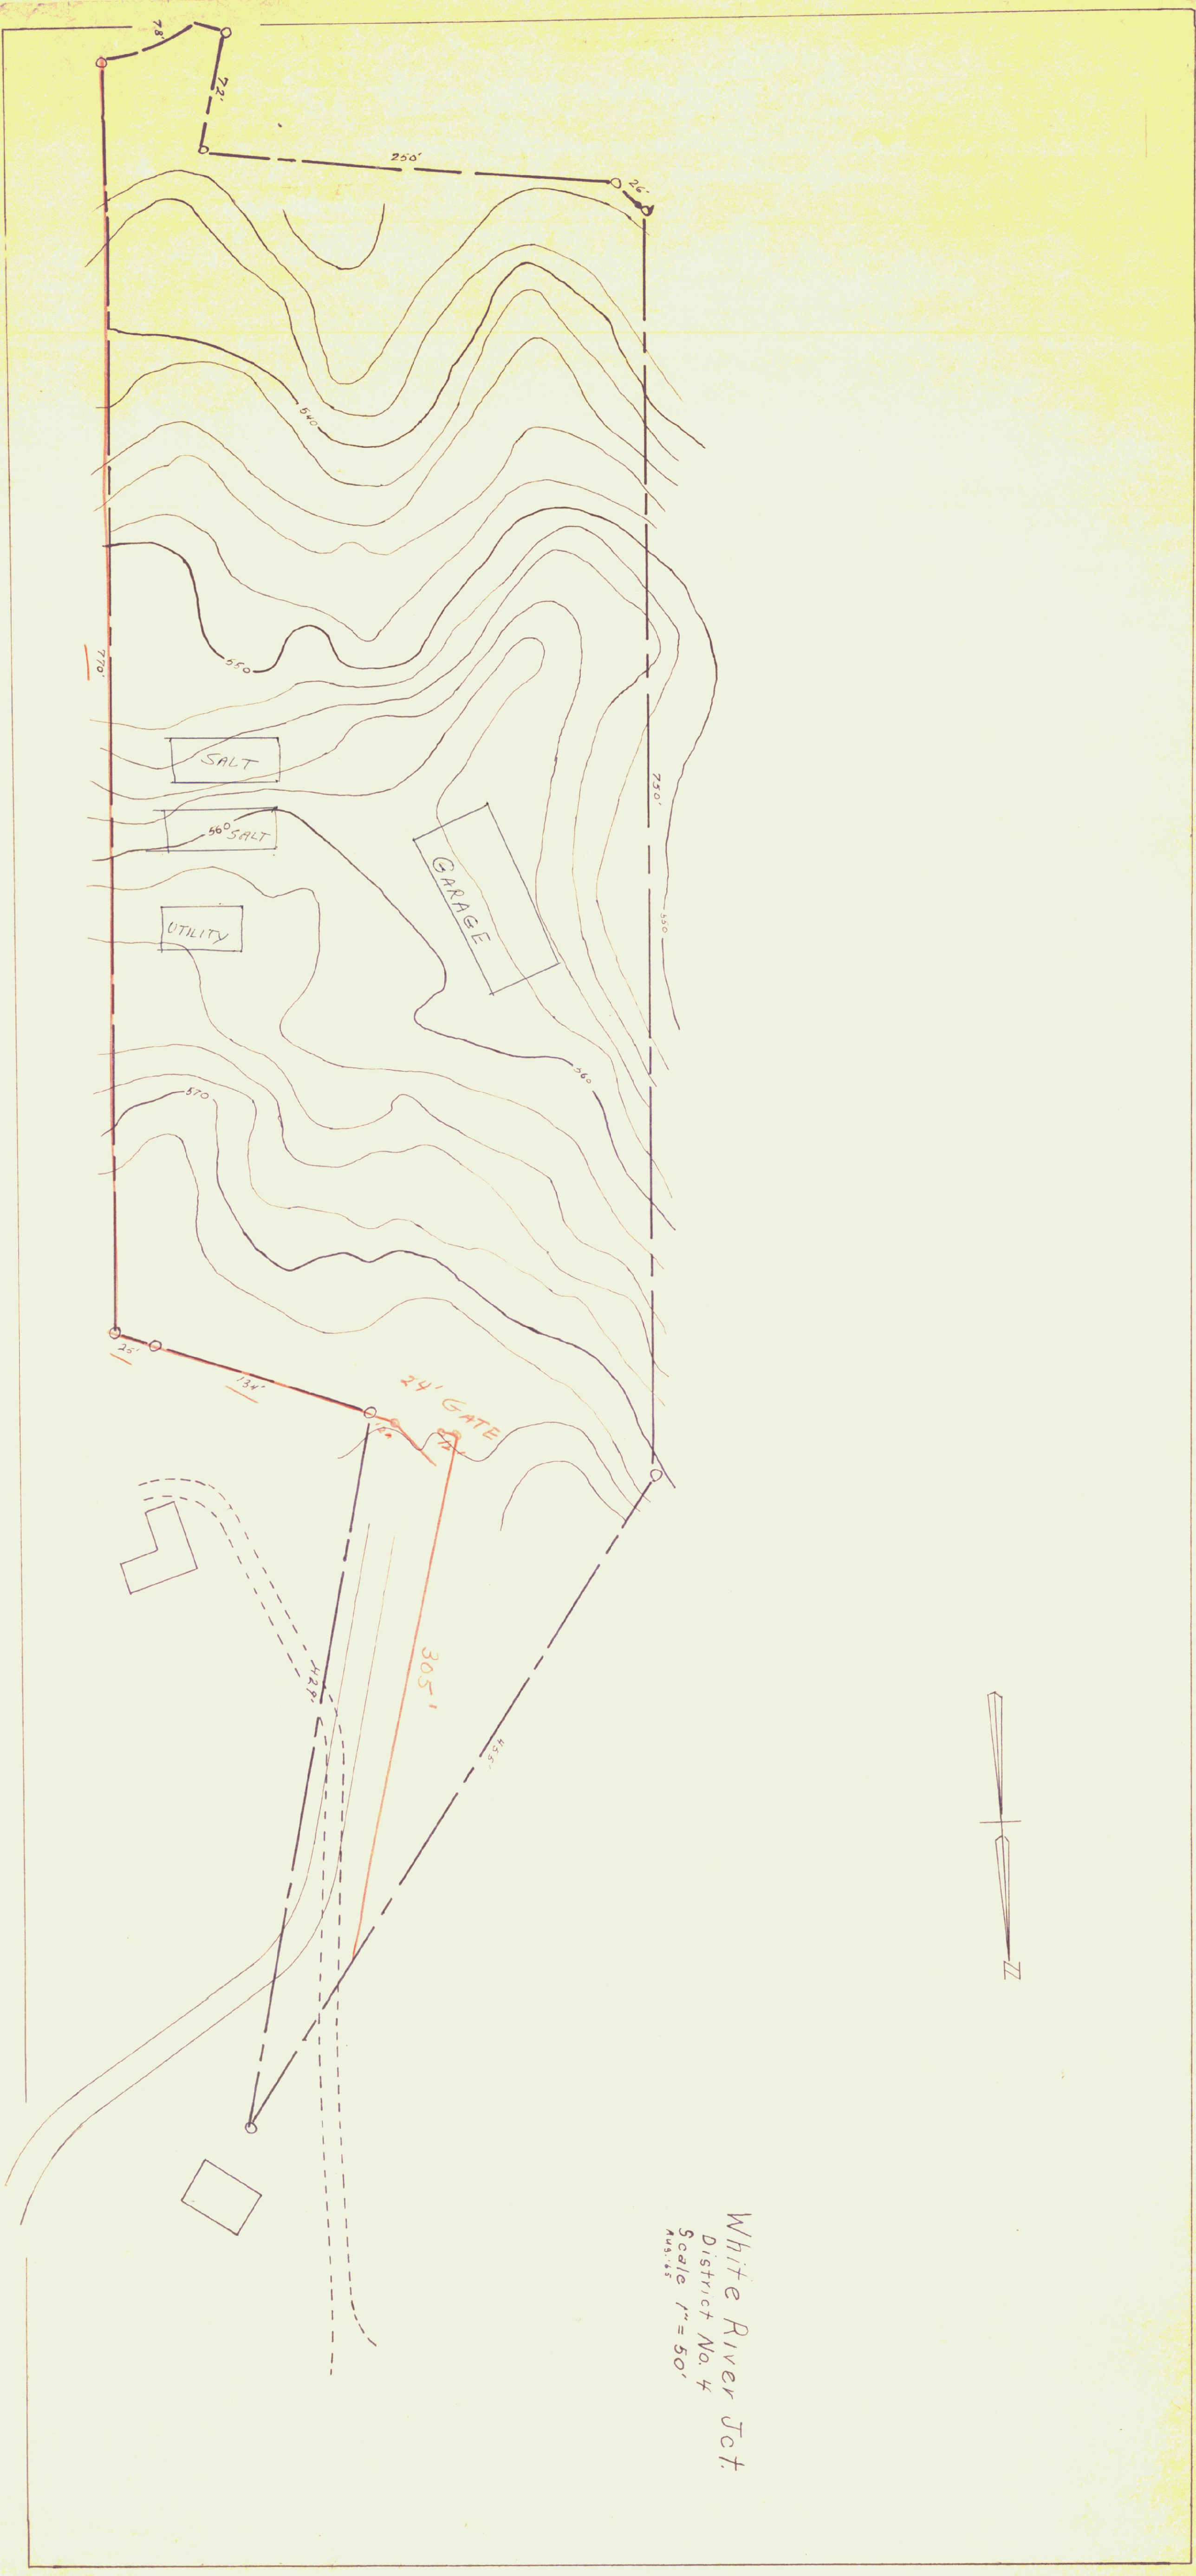

White River Jct.
District No. 4
Scale 1" = 50'
Aug. 45

1259 ± LIN. FT. 6' HIGH CHAIN LINK FENCE
1 - 24' GATE CHAIN LINK FENCE