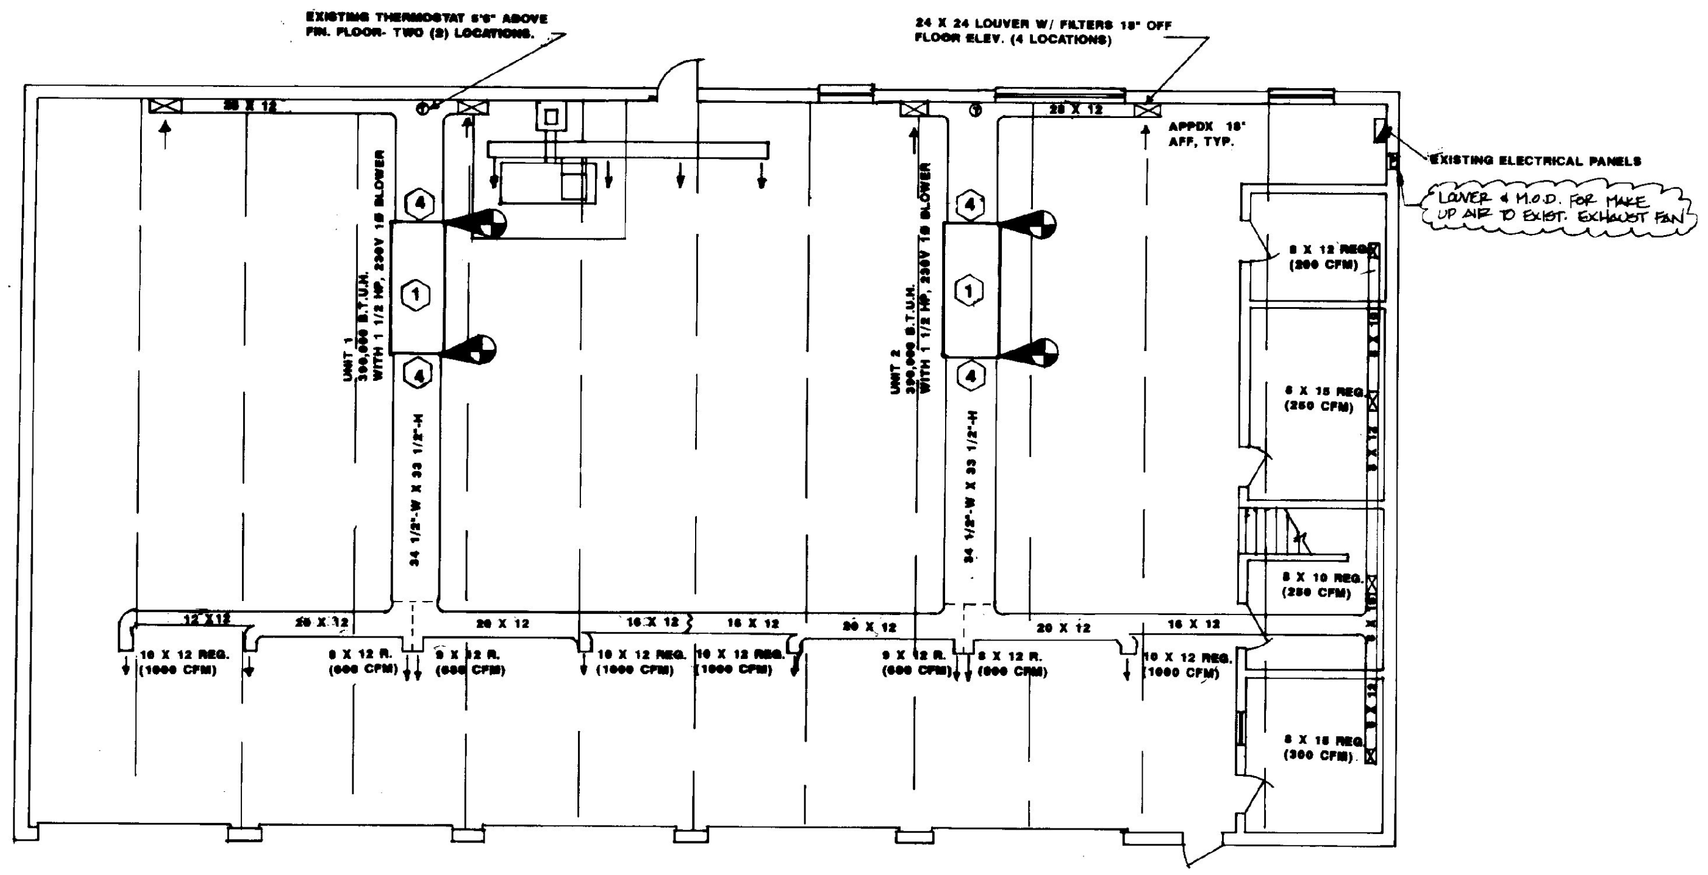

PLAN- WHITE RIVER JCT. GARAGE

SCALE: 1/8" = 1'-0"

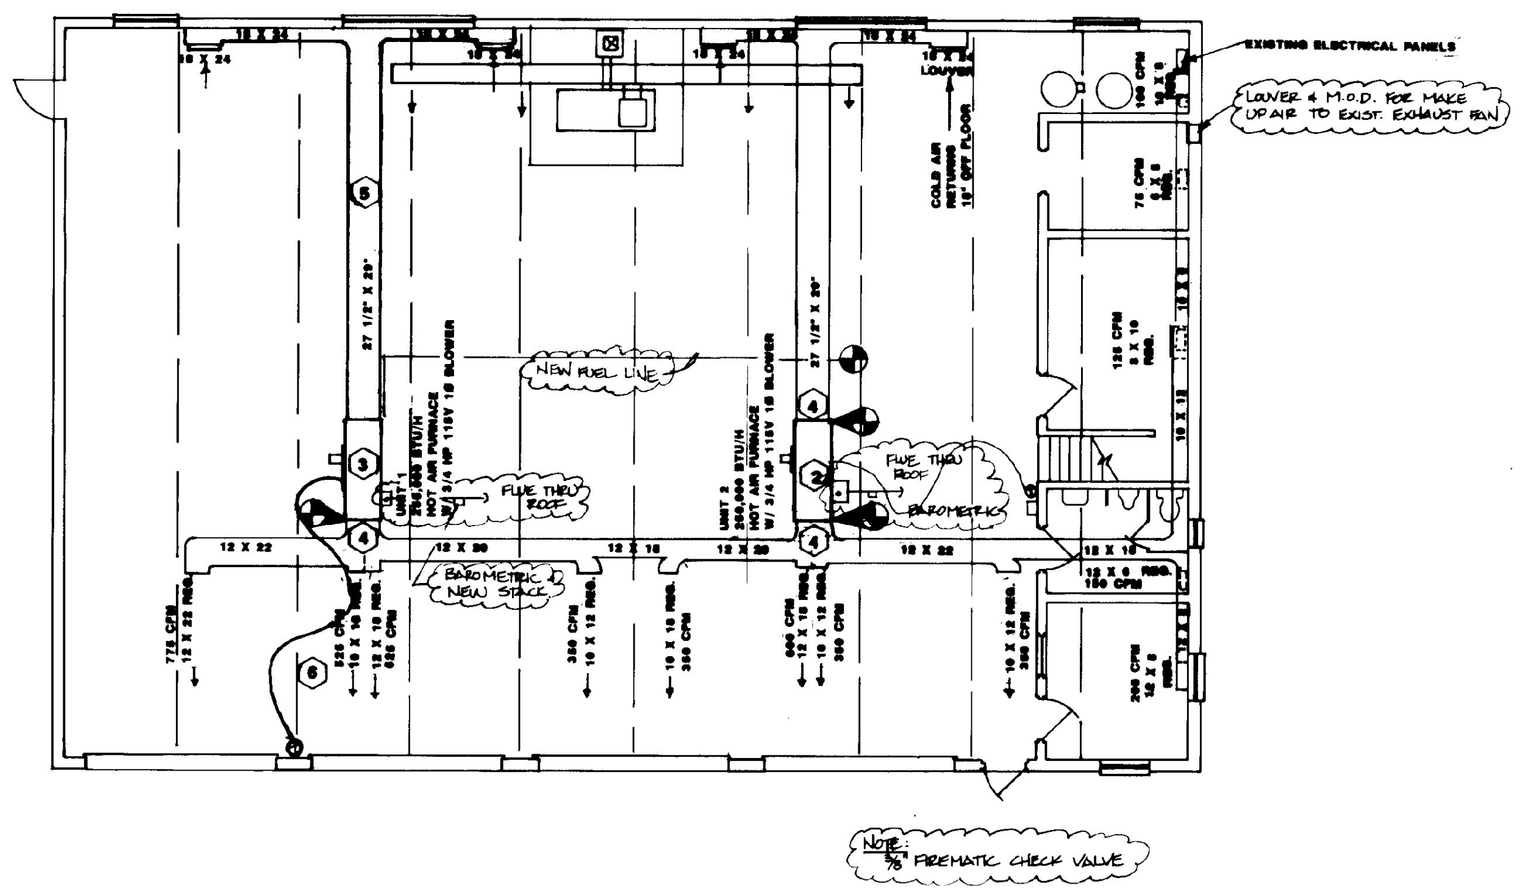

PLAN- THETFORD GARAGE

SCALE: 1/8" = 1'-0"

NOTES:

- CONNECTION BETWEEN NEW & EXISTING
- (1) REPLACE EXISTING FURNACE WITH NEW JACKSON CHURCH MODEL OL560S390RH FURNACE, REUSE EXISTING CONTROLS, ELECTRICAL, FUEL AND VENT PIPING.
- (2) REPLACE EXISTING LENNOX MODEL CVF20590 FURNCE WITH NEW JACKSON CHURCH MODEL OL280S23RH FURNACE. REUSE EXISTING ELECTRICAL, CONTROLS, FUEL AND VENT PIPING.
- (3) PROVIDE NEW JACKSON CHURCH MODEL OL280S23RH FURNACE. REUSE EXISTING ELECTRICAL AND FUEL PIPING. PROVIDE NEW CONTROLS AND VENT PIPING WITH NEW ROOF PENETRATOR. NOTE: VENT MAY EXIST ABOVE SEALED ROOF PENETRATION. IF IN GOOD SHAPE, REUSE.
- (4) MODIFY EXISITING DUCTWORK TO FIT NEW FURNACE, PROVIDE VIBRATION ISOLATOR.
- (5) PROVIDE NEW DUCTWORK, PAINT TO MATCH EXISTING. PROVIDE NEW RETURN AIR GRILLS TO MATCH EXISTING.
- (6) PROVIDE NEW THERMOSTAT, AND WIRING.

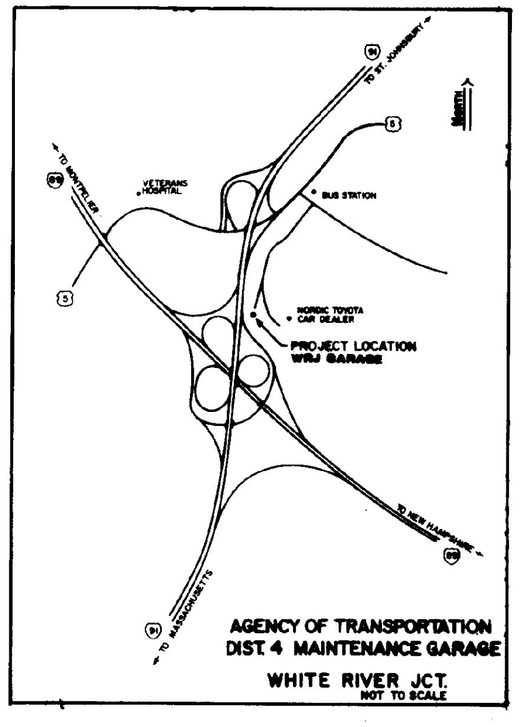

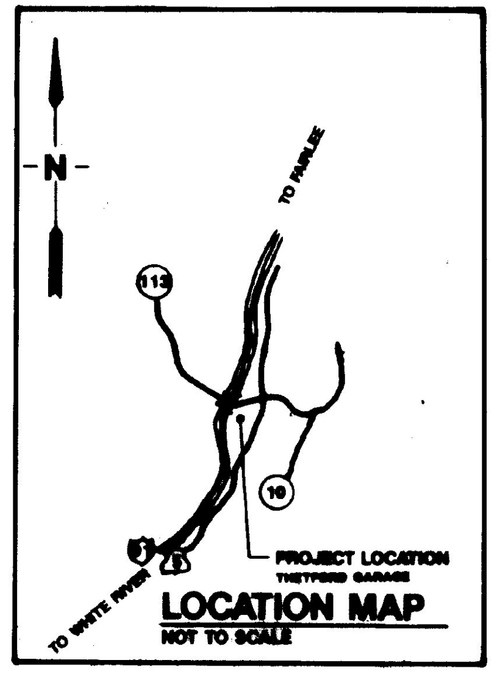

STATE OF VERMONT
DEPARTMENT OF STATE BUILDINGS
AGENCY OF ADMINISTRATION
MONTPELIER. VERMONT

REPLACE FURNACES
THETFORD & WHITE RIVER JCT.
HIGHWAY GARAGE

DATE: JULY 25, 1996	SCALE: AS NOTED	REVISIONS: — AS-BUILT 12/4/97	DWG. NO. 1
DRAWN BY: C. S. FOSTER	APPROVED BY: TEIGH		1 OF 1