




WEST ELEVATION
SCALE: 1/8" = 1'-0"

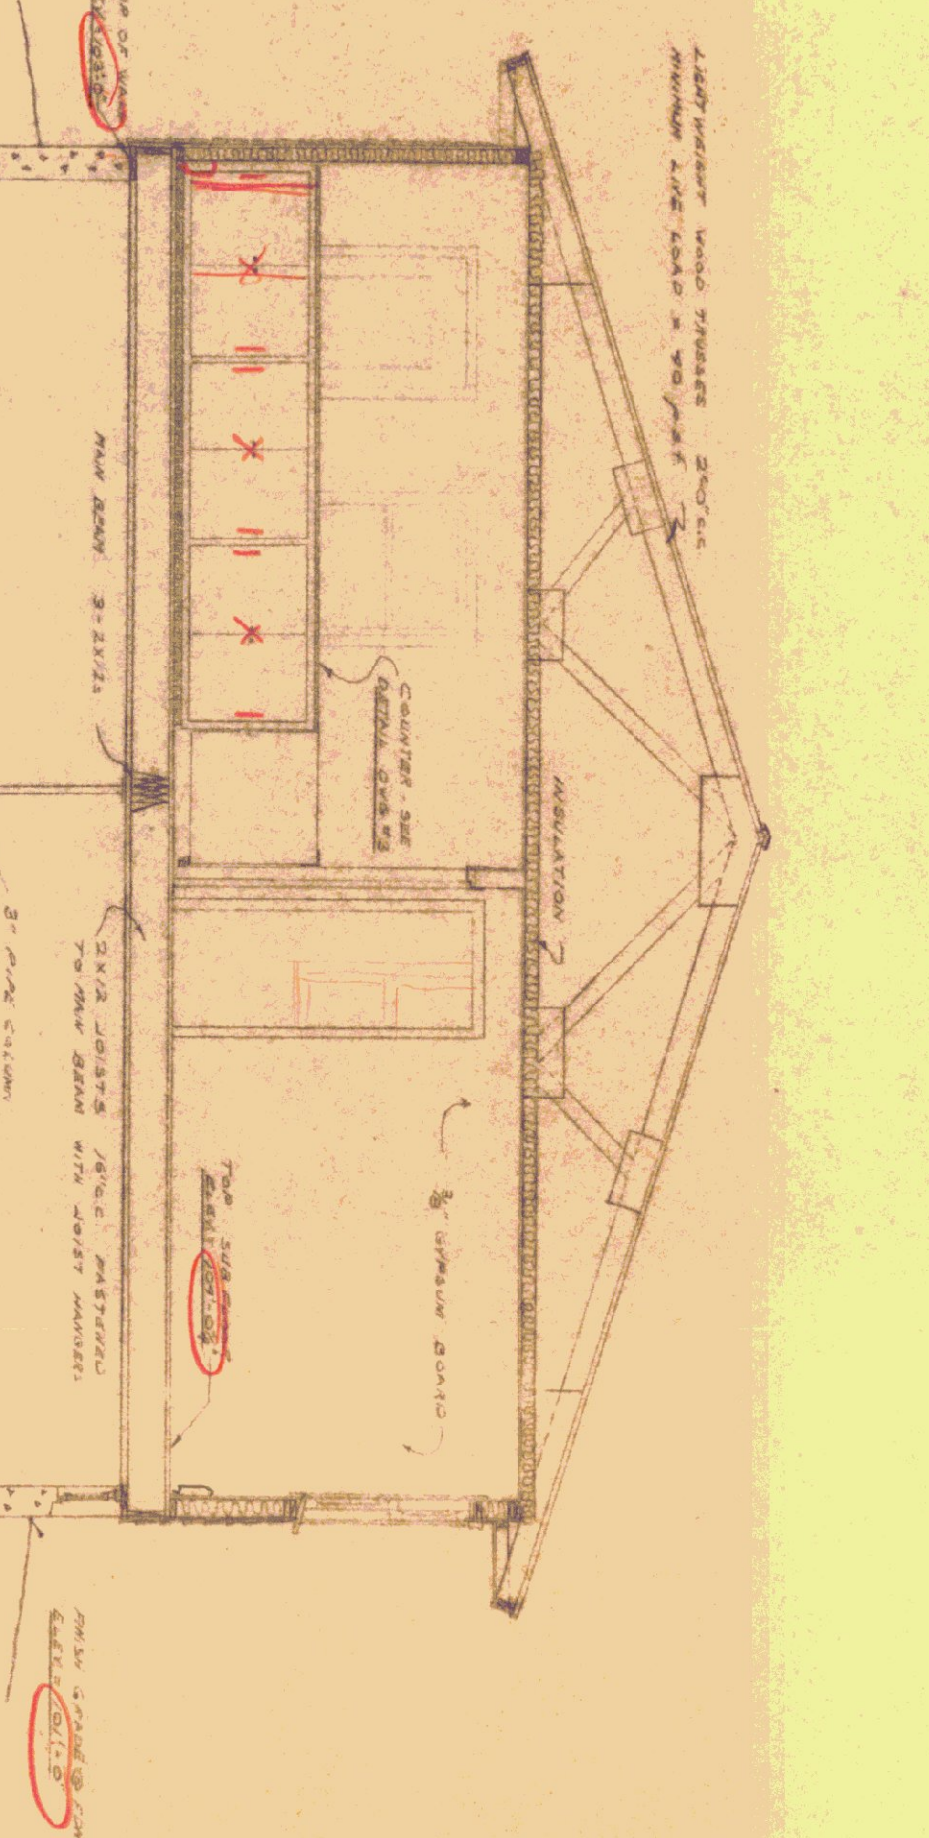


EAST ELEVATION
SCALE: 1/8" = 1'-0"

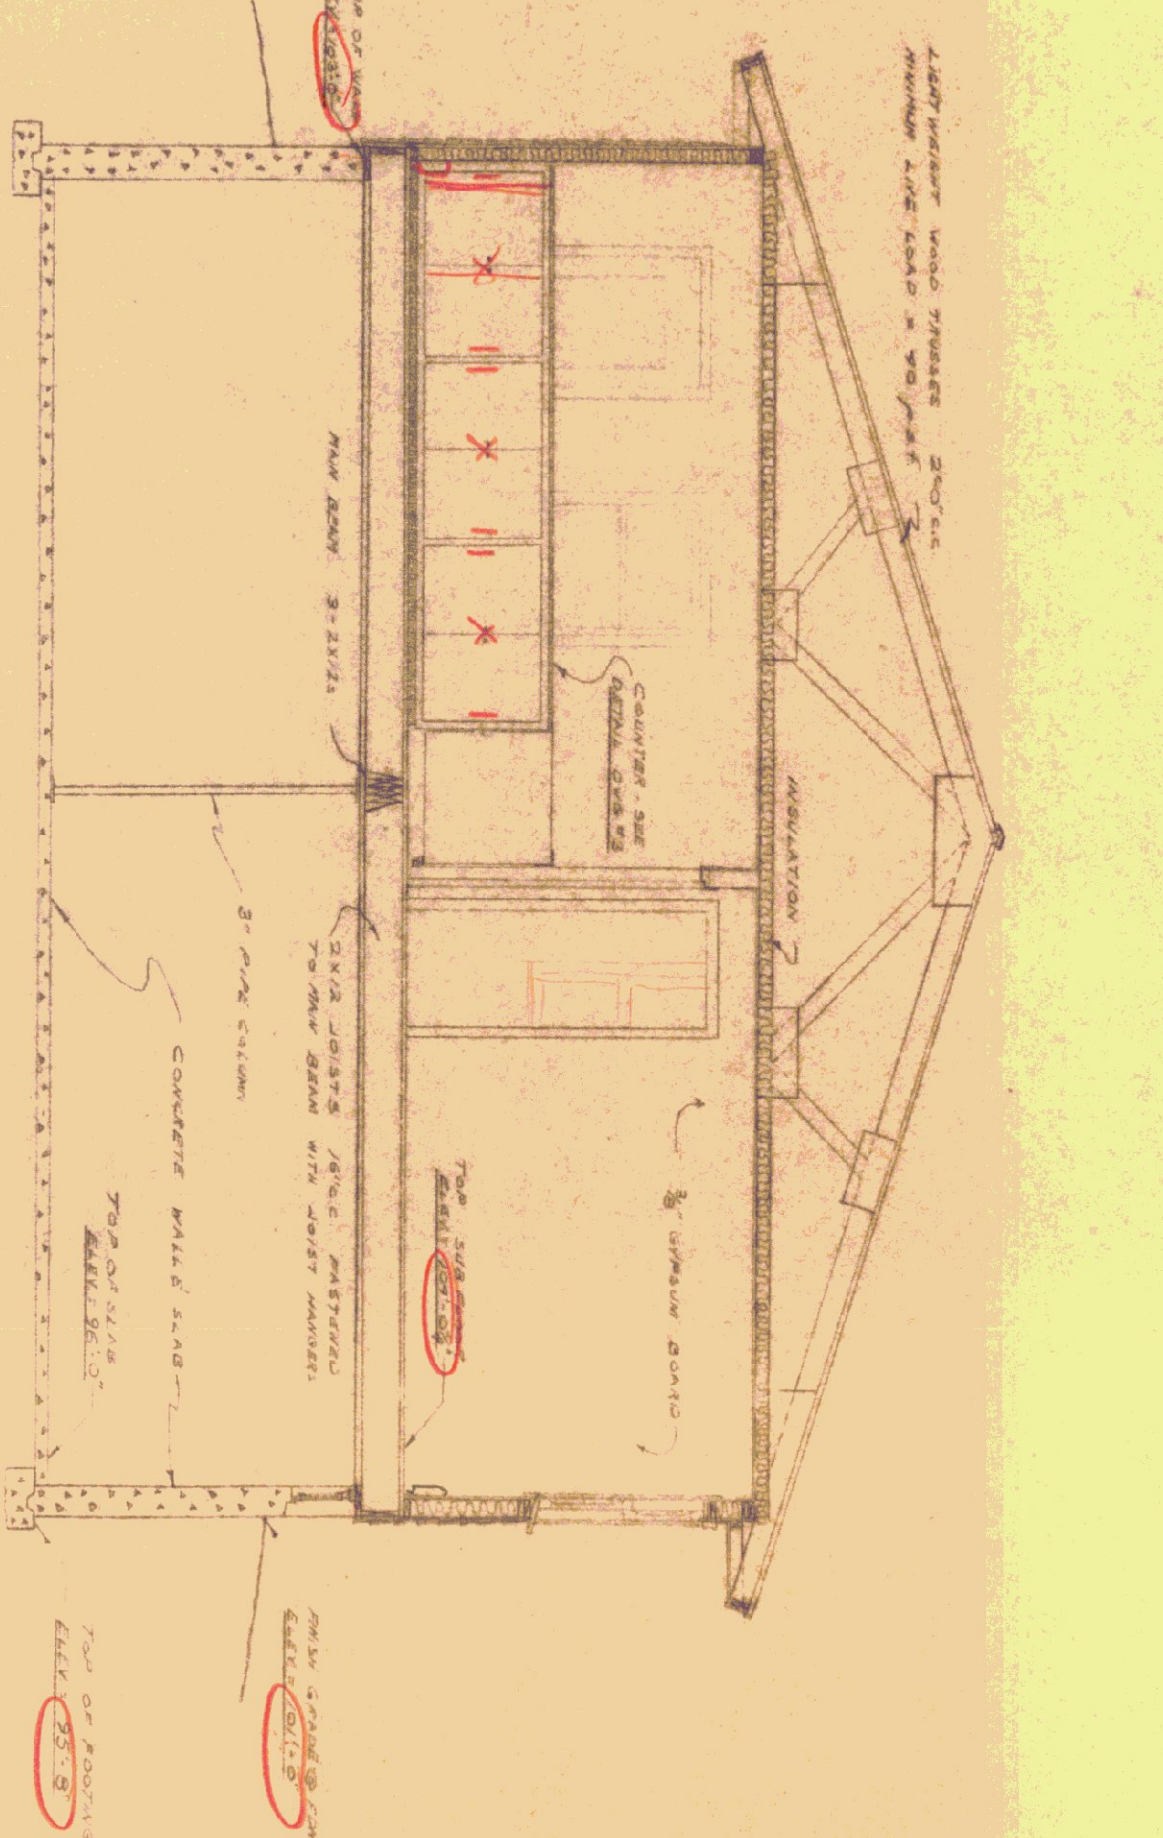


SECTION A-A
SCALE: 1/8" = 1'-0"

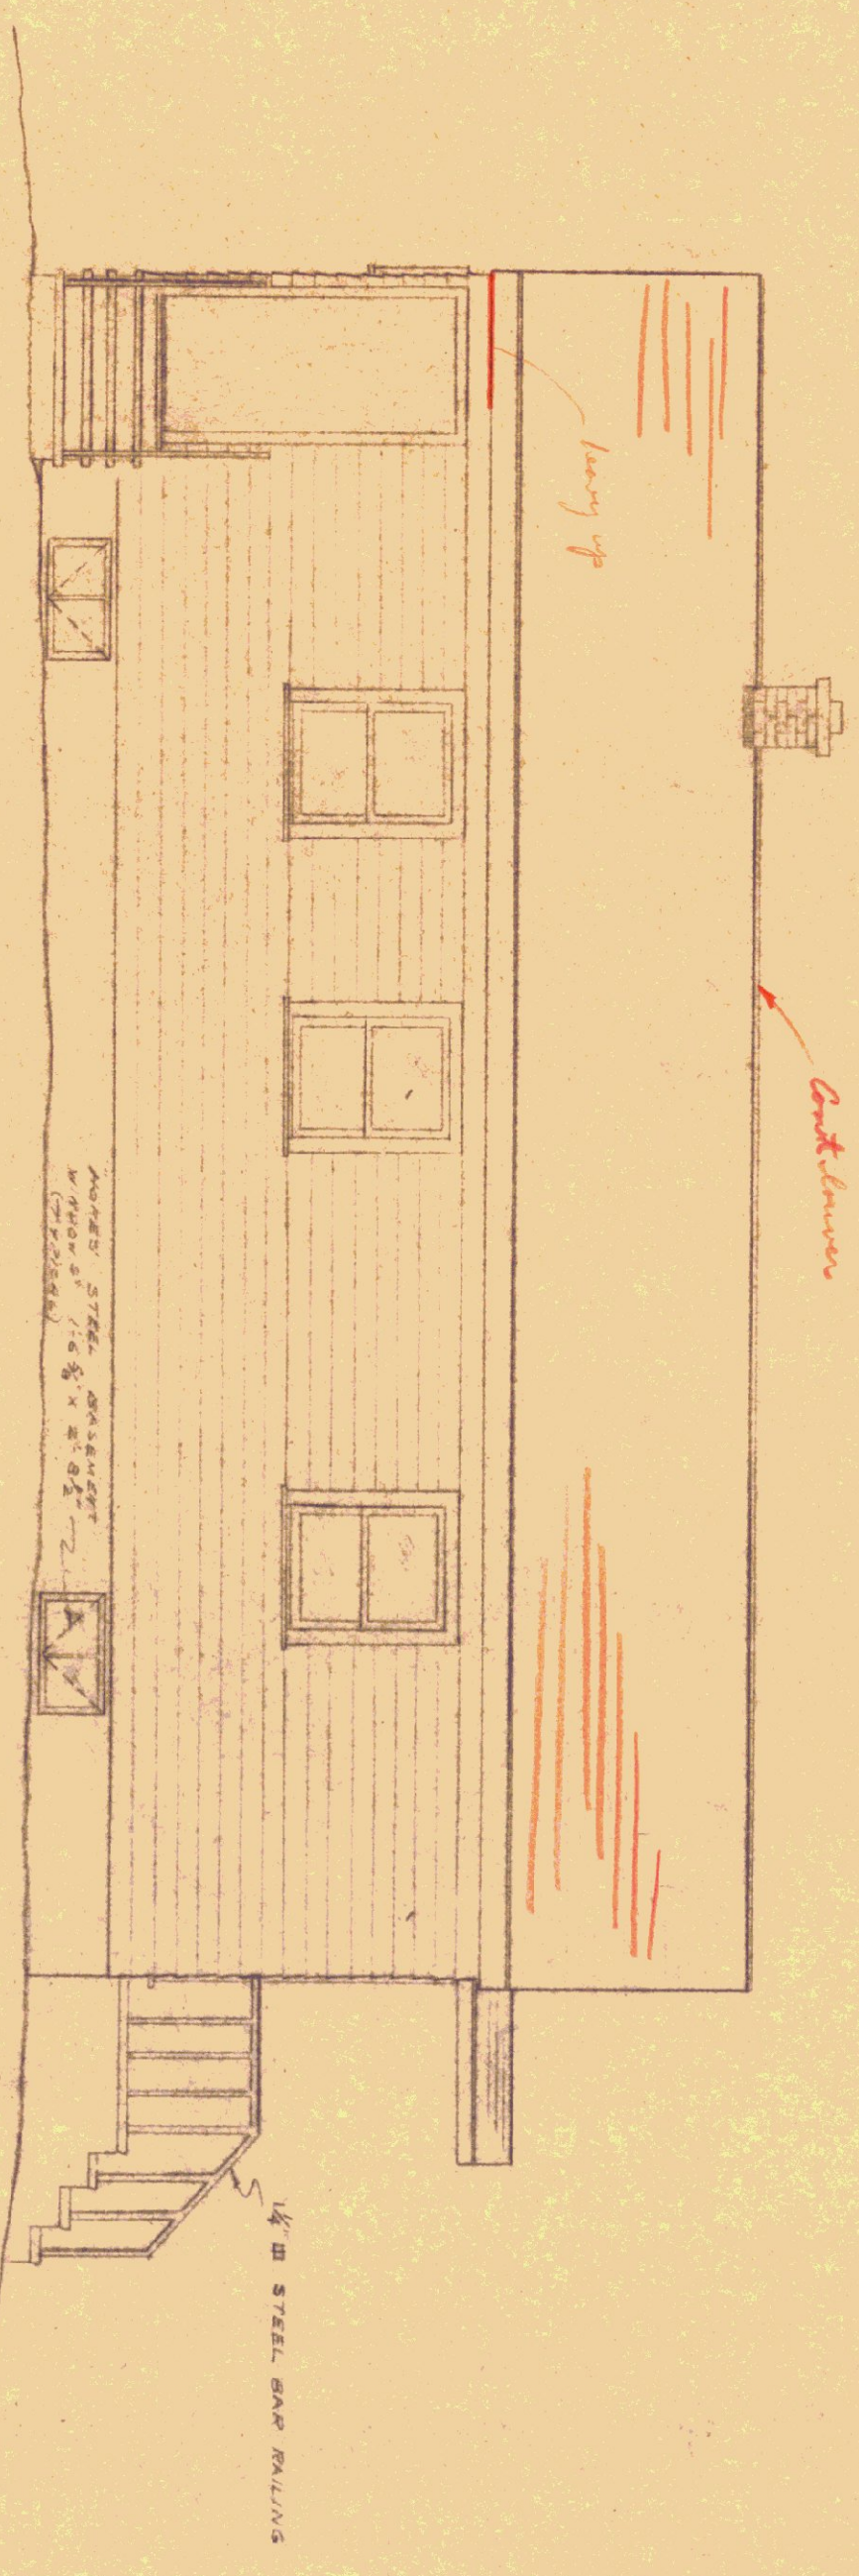

NORTH ELEVATION
SCALE: 1/8" = 1'-0"

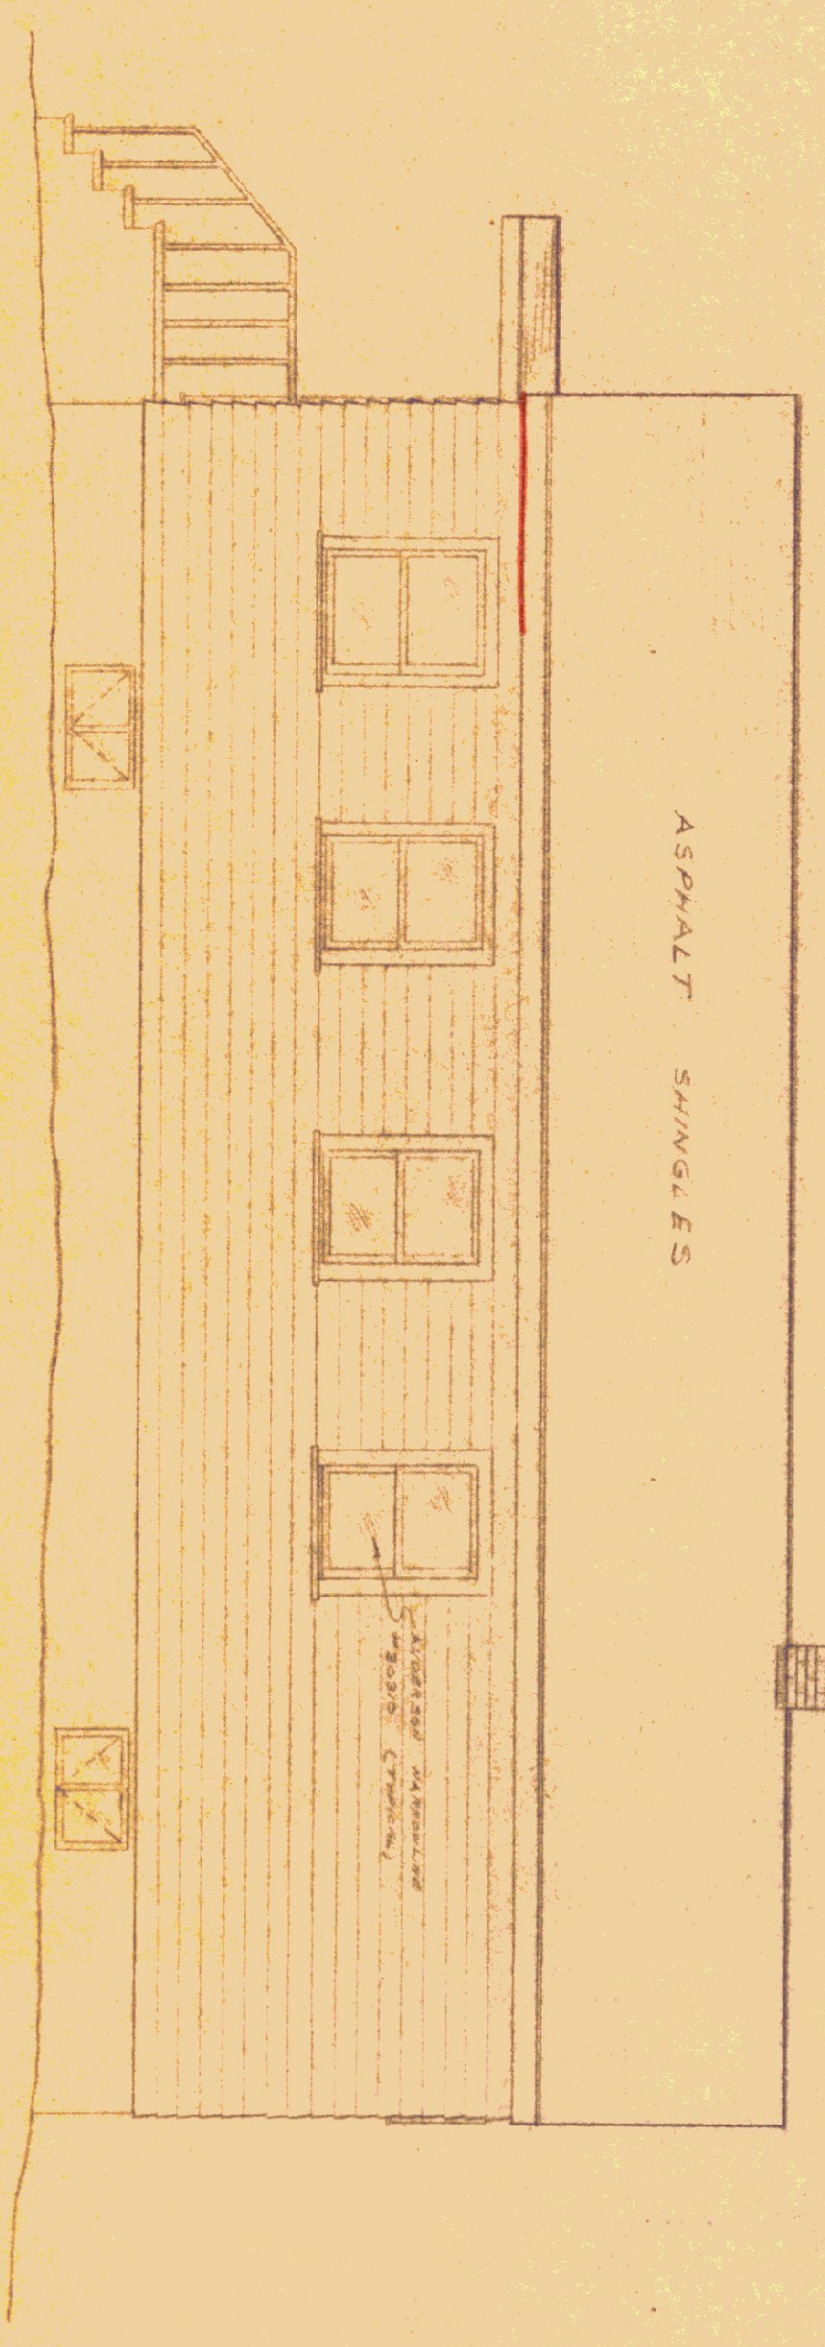

SOUTH ELEVATION
SCALE: 1/8" = 1'-0"

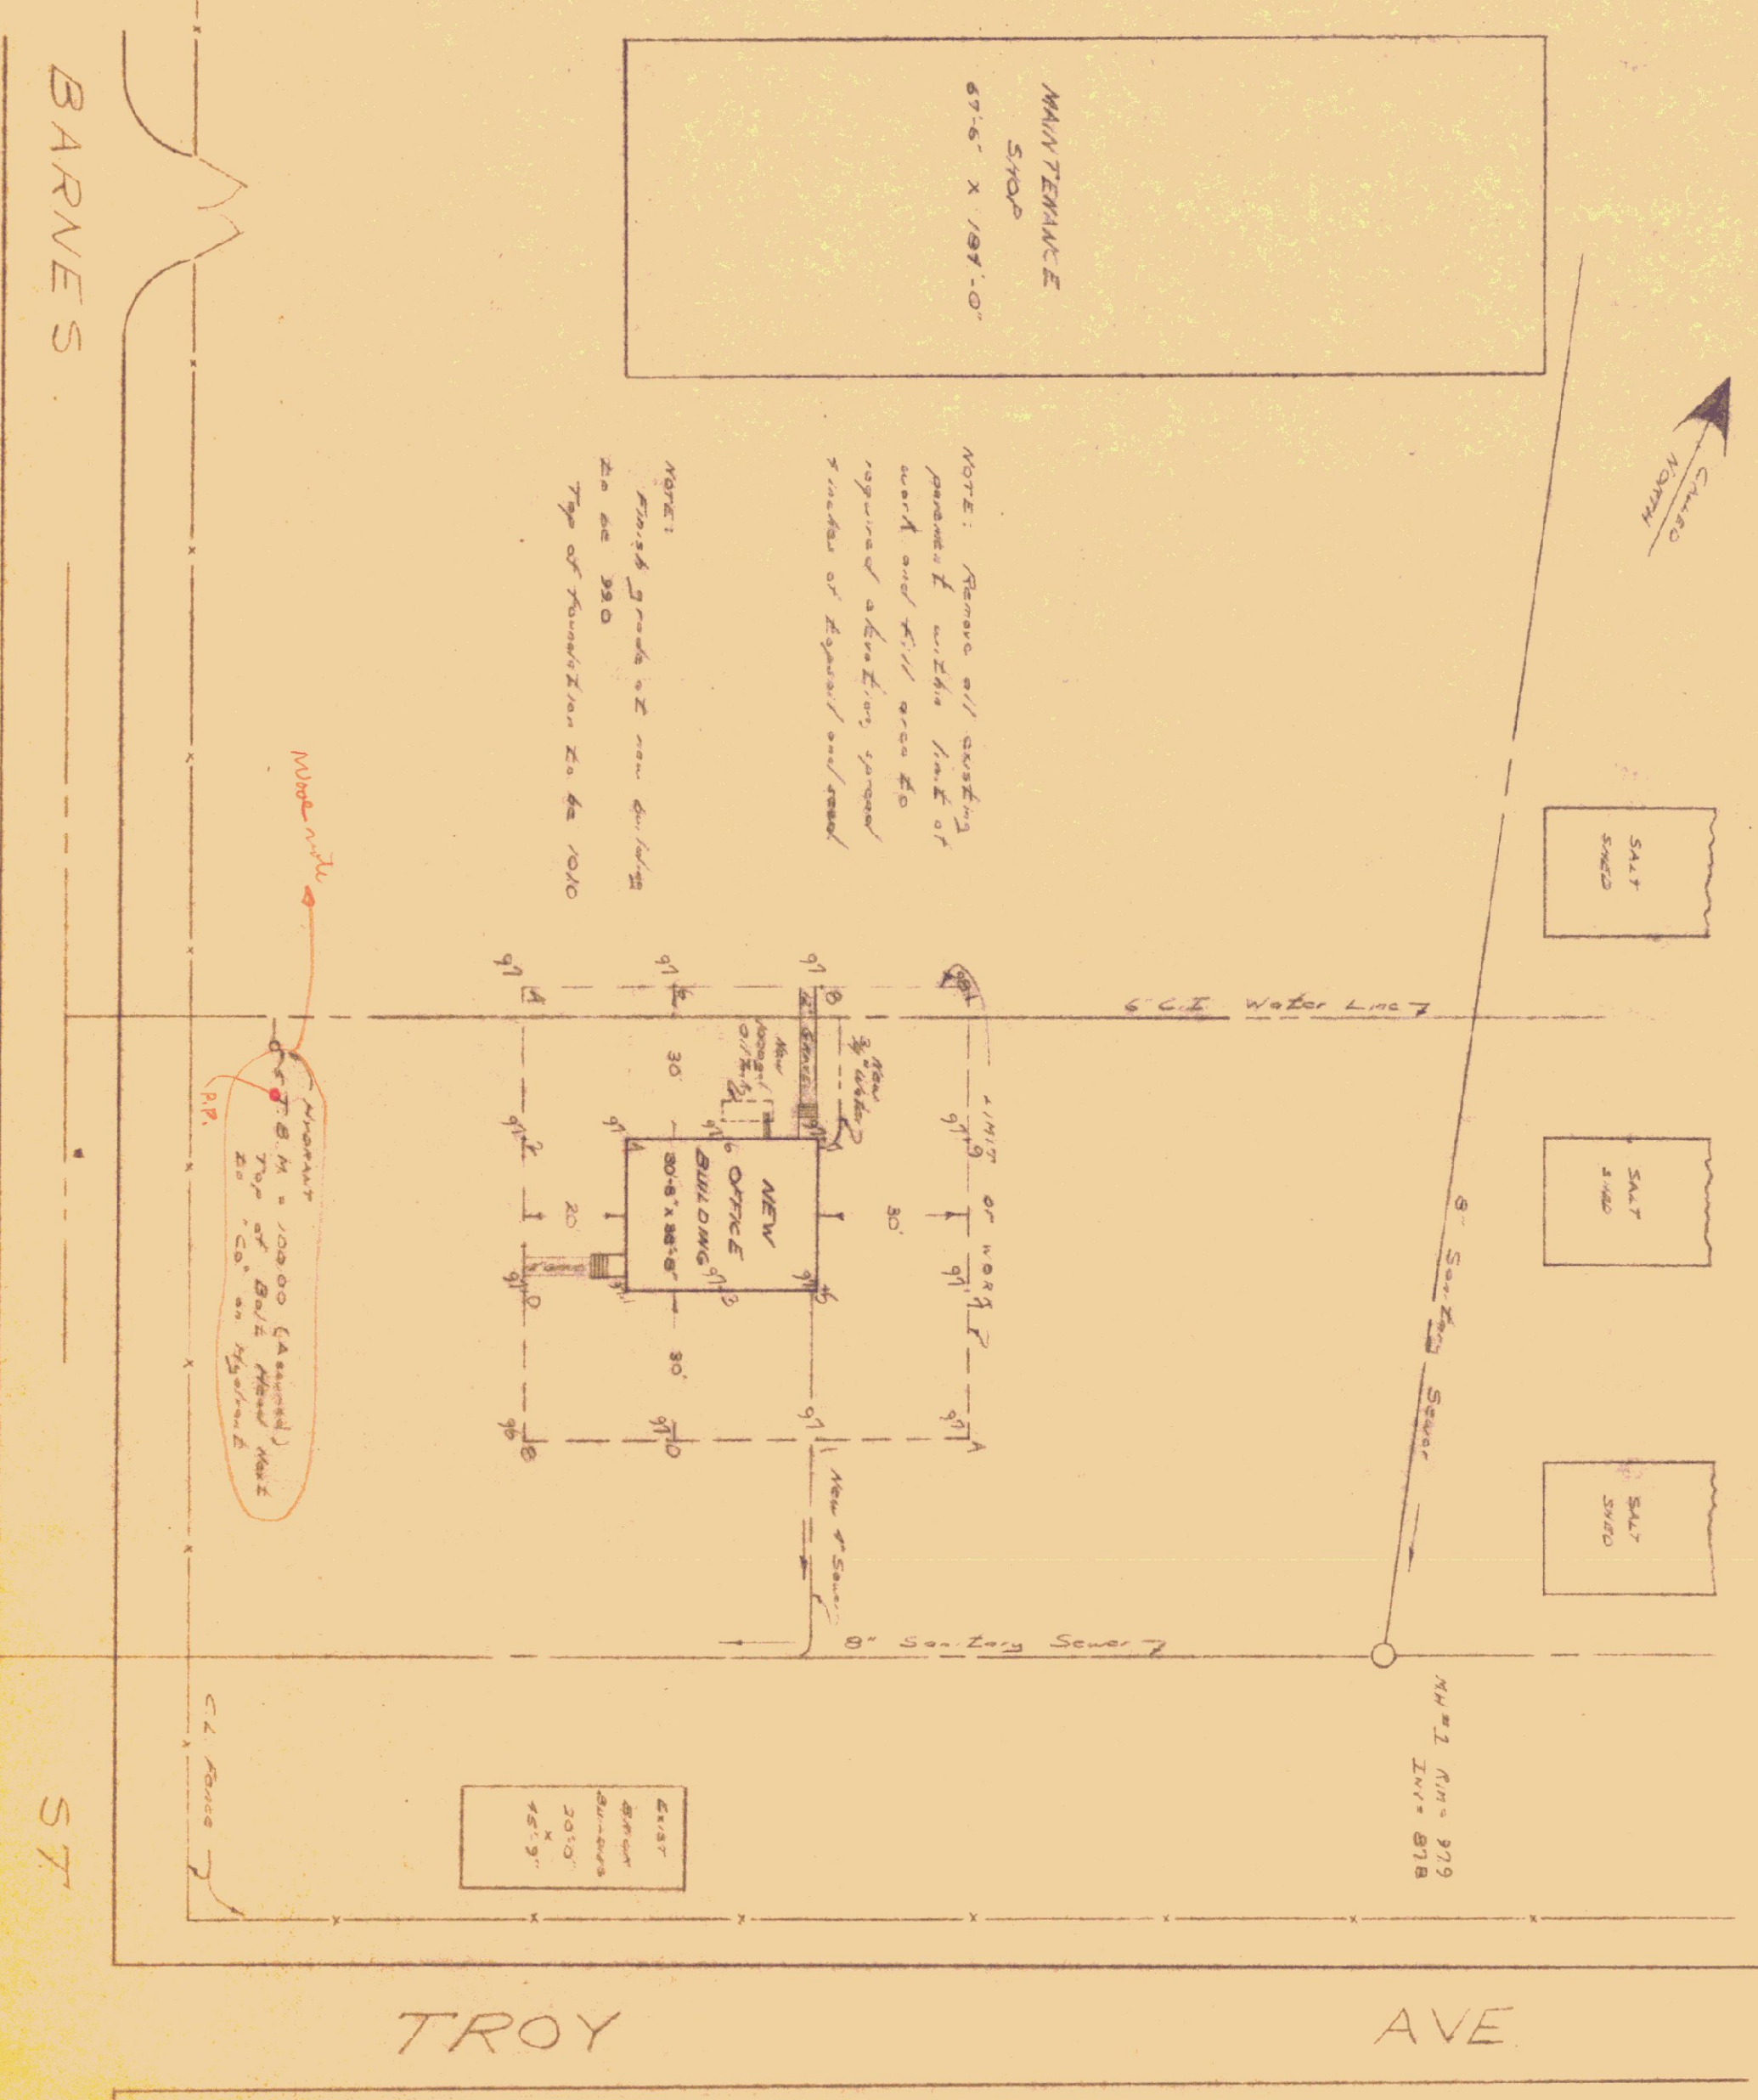



10' Section South of the
OFFICE
1/4" CHECK SET

SITE PLAN
SCALE: 1/4" = 30'