
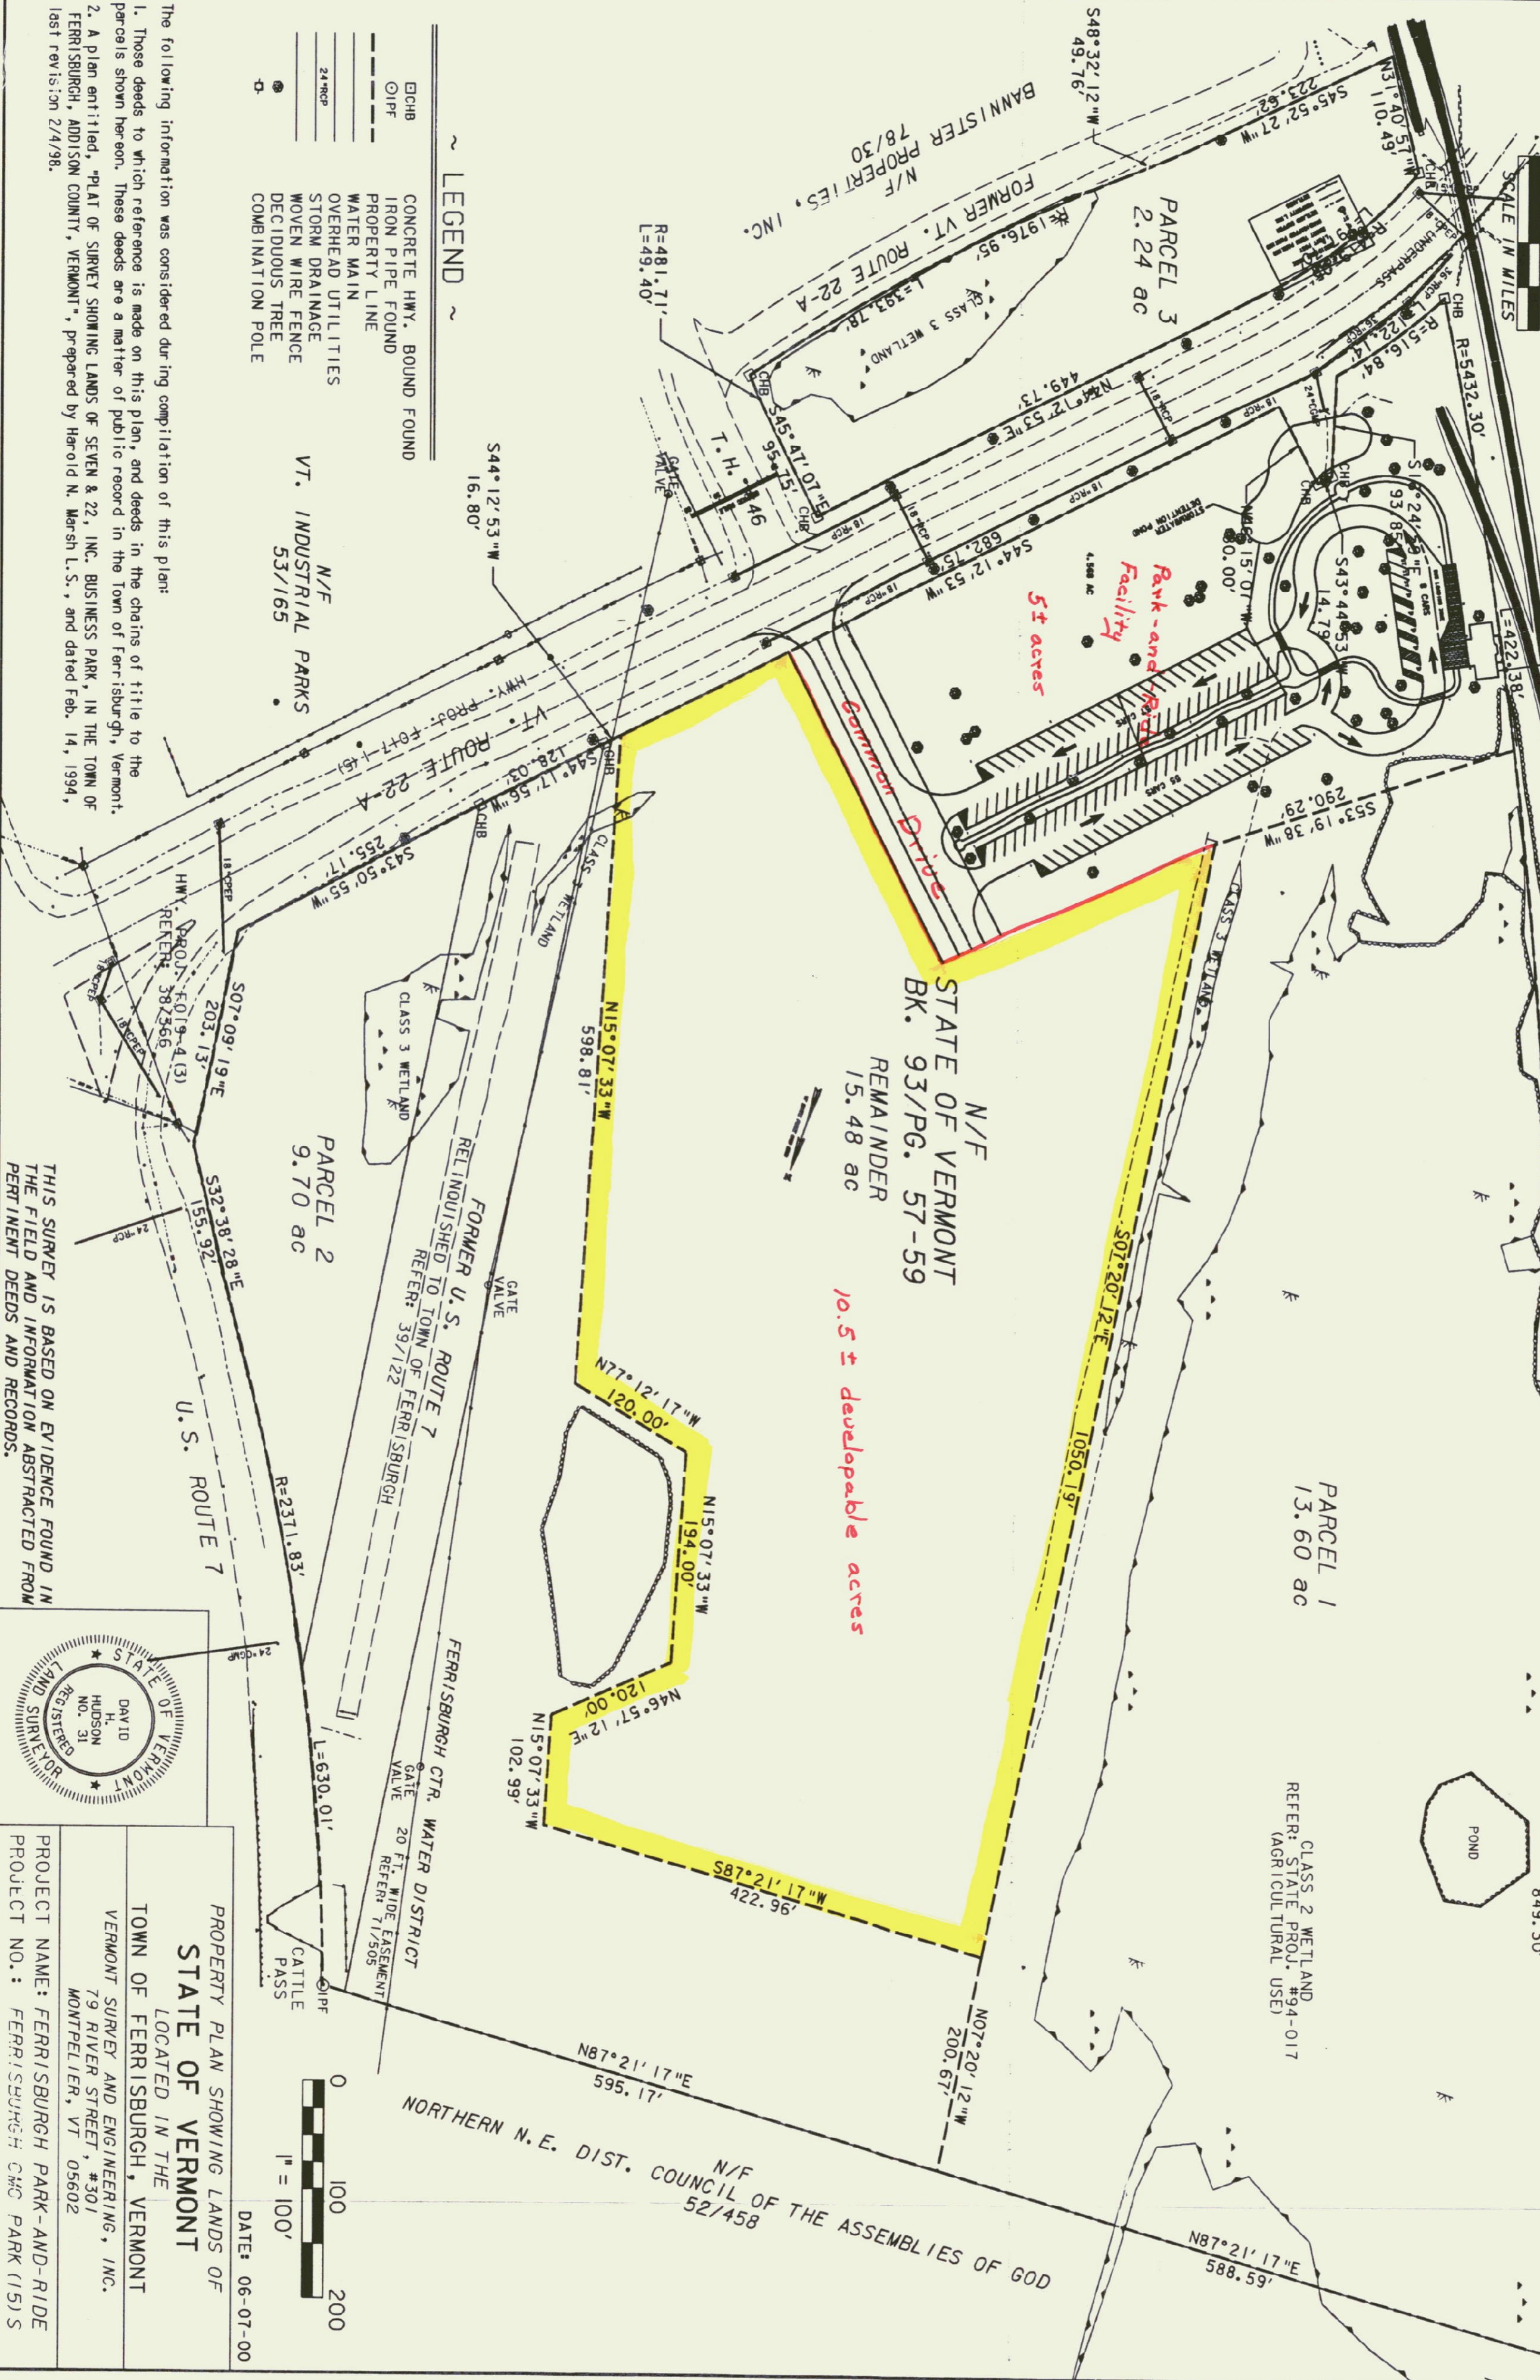


PROJECT LOCATION

N/F VT. INDUSTRIAL PARKS 63/483

VERMONT RAILWAY INC. - STATE OF VERMONT  
REFER: 6/30/1917 SURVEY

N/F VANDER-WEY 49/284

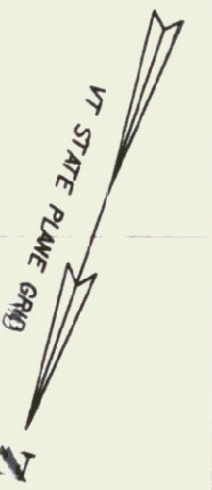


LEGEND

- CHB CONCRETE HWY. BOUND FOUND
- O/PF IRON PIPE FOUND
- PROPERTY LINE
- WATER MAIN
- OVERHEAD UTILITIES
- STORM DRAINAGE
- WOVEN WIRE FENCE
- DECIDUOUS TREE
- COMBINATION POLE


N/F VT. INDUSTRIAL PARKS 53/165

The following information was considered during compilation of this plan:  
 1. Those deeds to which reference is made on this plan, and deeds in the chains of title to the parcels shown hereon. These deeds are a matter of public record in the Town of Ferrisburgh, Vermont.  

THIS SURVEY IS BASED ON EVIDENCE FOUND IN THE FIELD AND INFORMATION ABSTRACTED FROM PERTINENT DEEDS AND RECORDS.

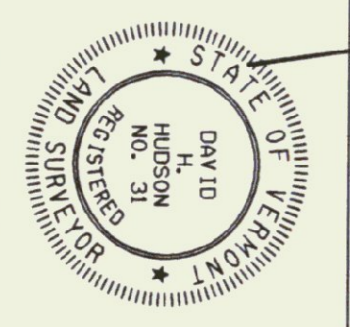

PROPERTY PLAN SHOWING LANDS OF  
**STATE OF VERMONT**  
 LOCATED IN THE  
 TOWN OF FERRISBURGH, VERMONT  
 VERMONT SURVEY AND ENGINEERING, INC.  
 79 RIVER STREET, #30  
 MONTPELIER, VT 05602  
 PROJECT NAME: FERRISBURGH PARK-AND-RIDE  
 PROJECT NO.: FERRISBURGH CMC PARK (15)S  
 DATE: 06-07-00

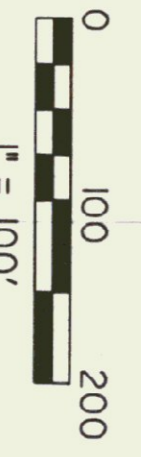

N/F NORTHERN N. E. DIST. COUNCIL OF THE ASSEMBLIES OF GOD 52/458