
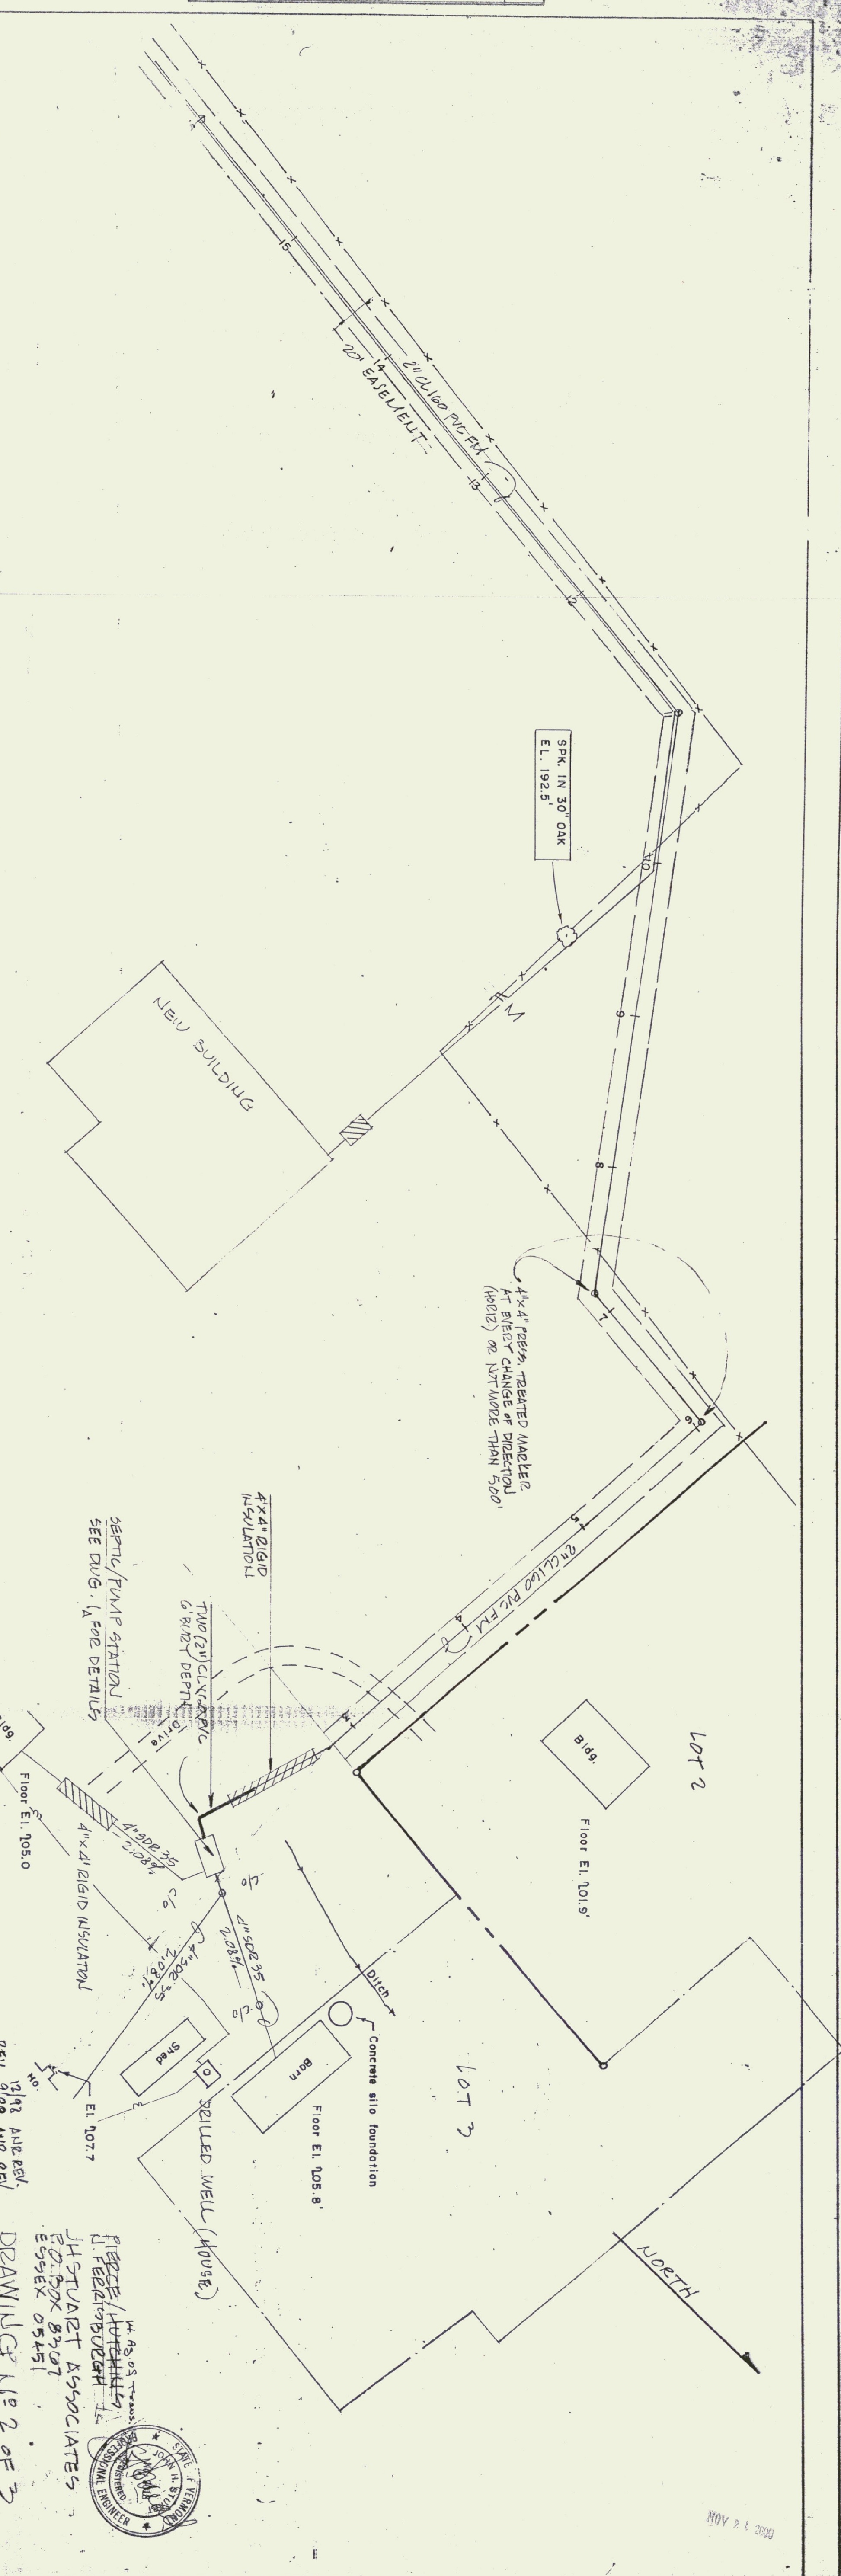


PROFILE NOTE BOOK No.	SURVEYED	BY	DATE
	PLOTTED		
	GRADES CHECKED		
	STRUCTURE NOTATIONS CHECKED		

PLAN NOTE BOOK No.	SURVEYED	BY	DATE
	PLOTTED		
	ALIGNMENT CHECKED		
	RT. OF WAY CHECKED		

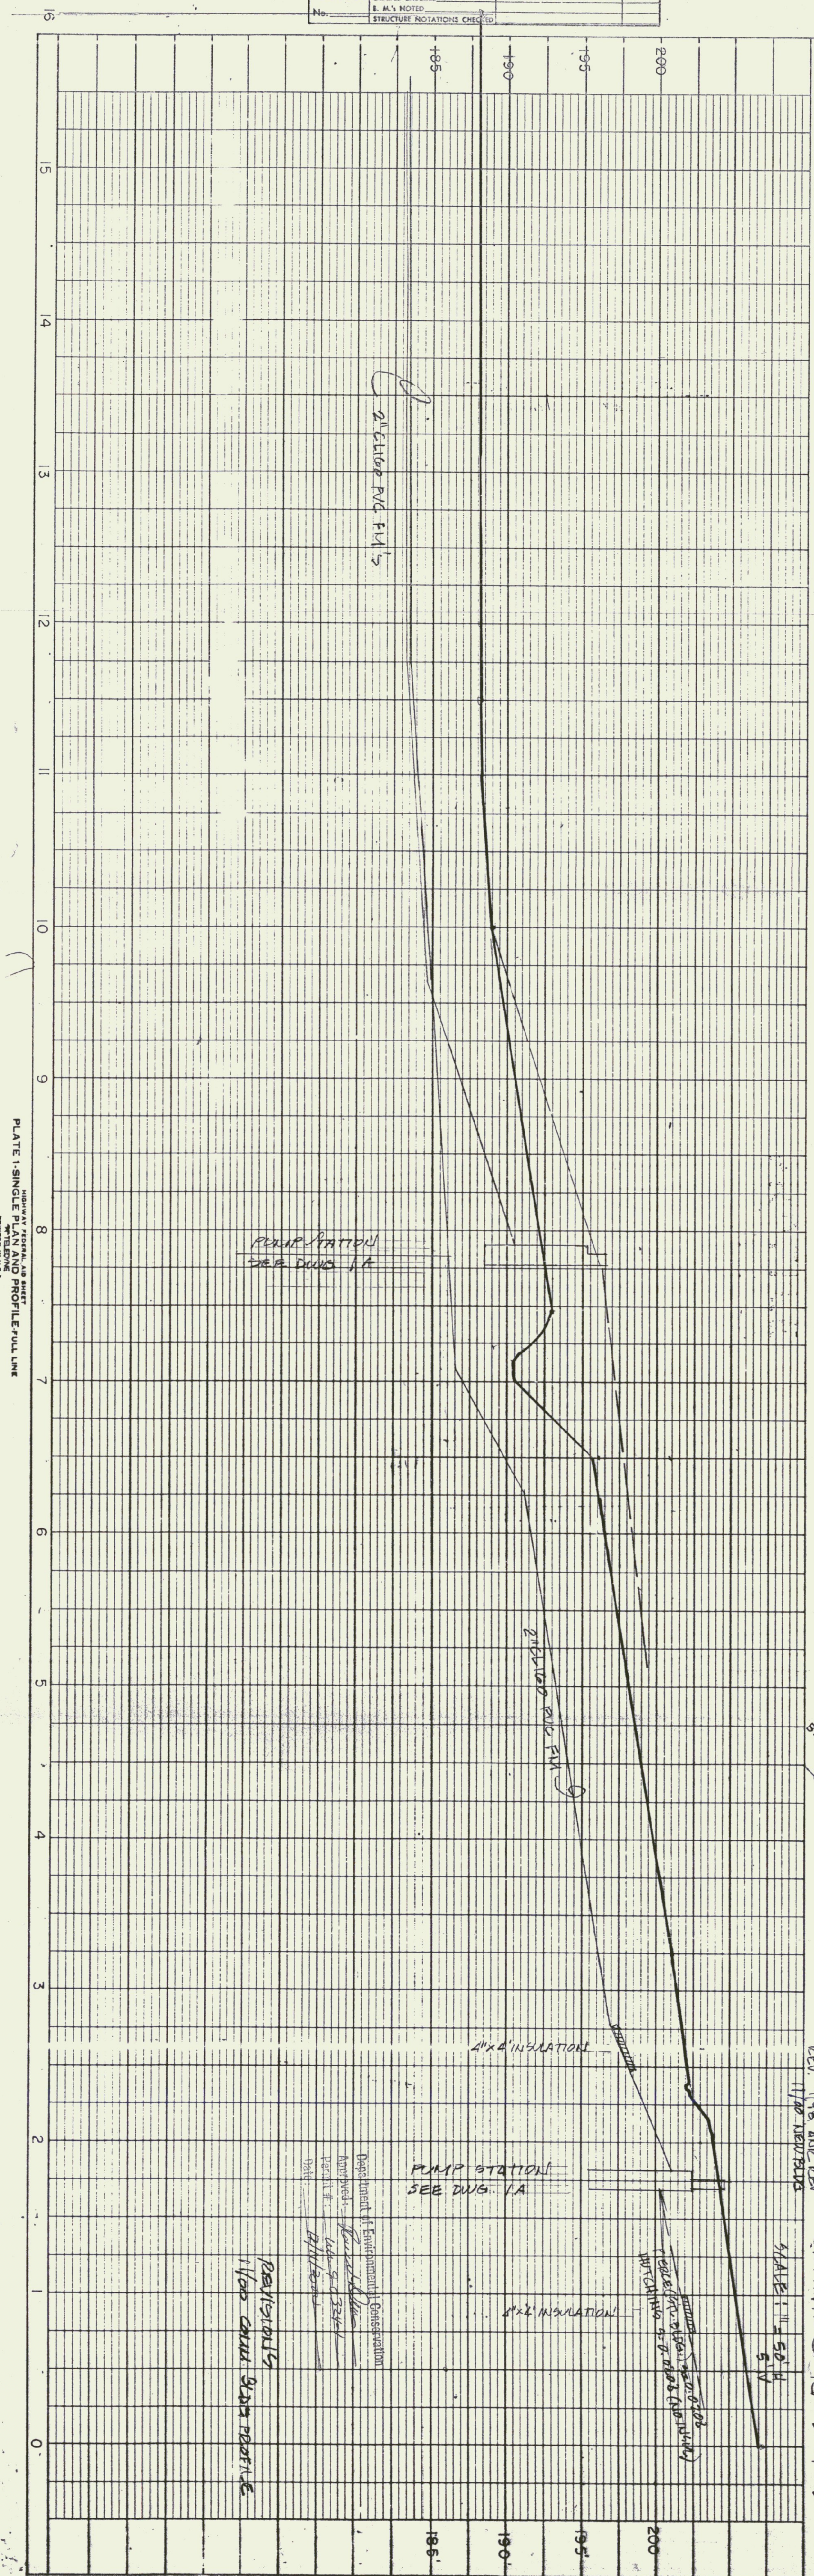

HIGHER FEDERAL AB SHEET
 PLATE 1 SINGLE PLAN AND PROFILE FULL LINE
 PRINTED IN U.S.A.


DRAWING NO 2 OF 3

PIERCE/HUTCHINS



001 1 2 300